


REV 2 OUTSIDE STEEL APPROX  
REV 41 GROUNDING ADDED

CIRCLE ELECTRIC, INC.  
CONTRACTOR  
PD BOX 130  
PORTAGE IND. 46-160

EVERETT J. BROWN CO. ARCH. & ENG.  
BRUMMITT ACRES ELEMENTARY SCHOOL E-20-SDB  
LIBERTY ELEMENTARY SCHOOL E-20-SDB

70-WE-06

DISTRIBUTION-MOTORS-FIRE ALARM-PROGRAM-RECEPT  
UNIT B

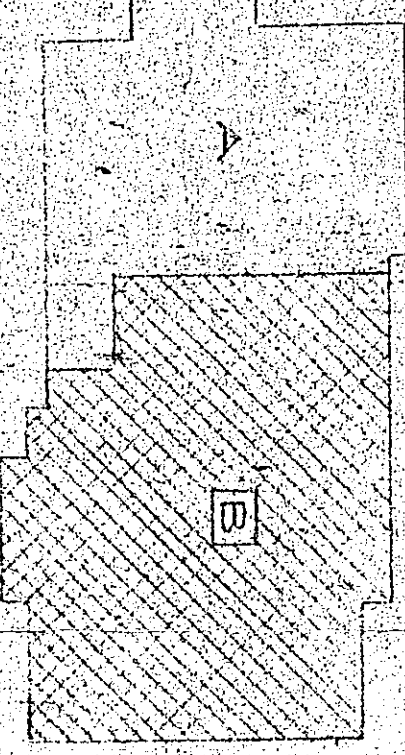

4/17/74

