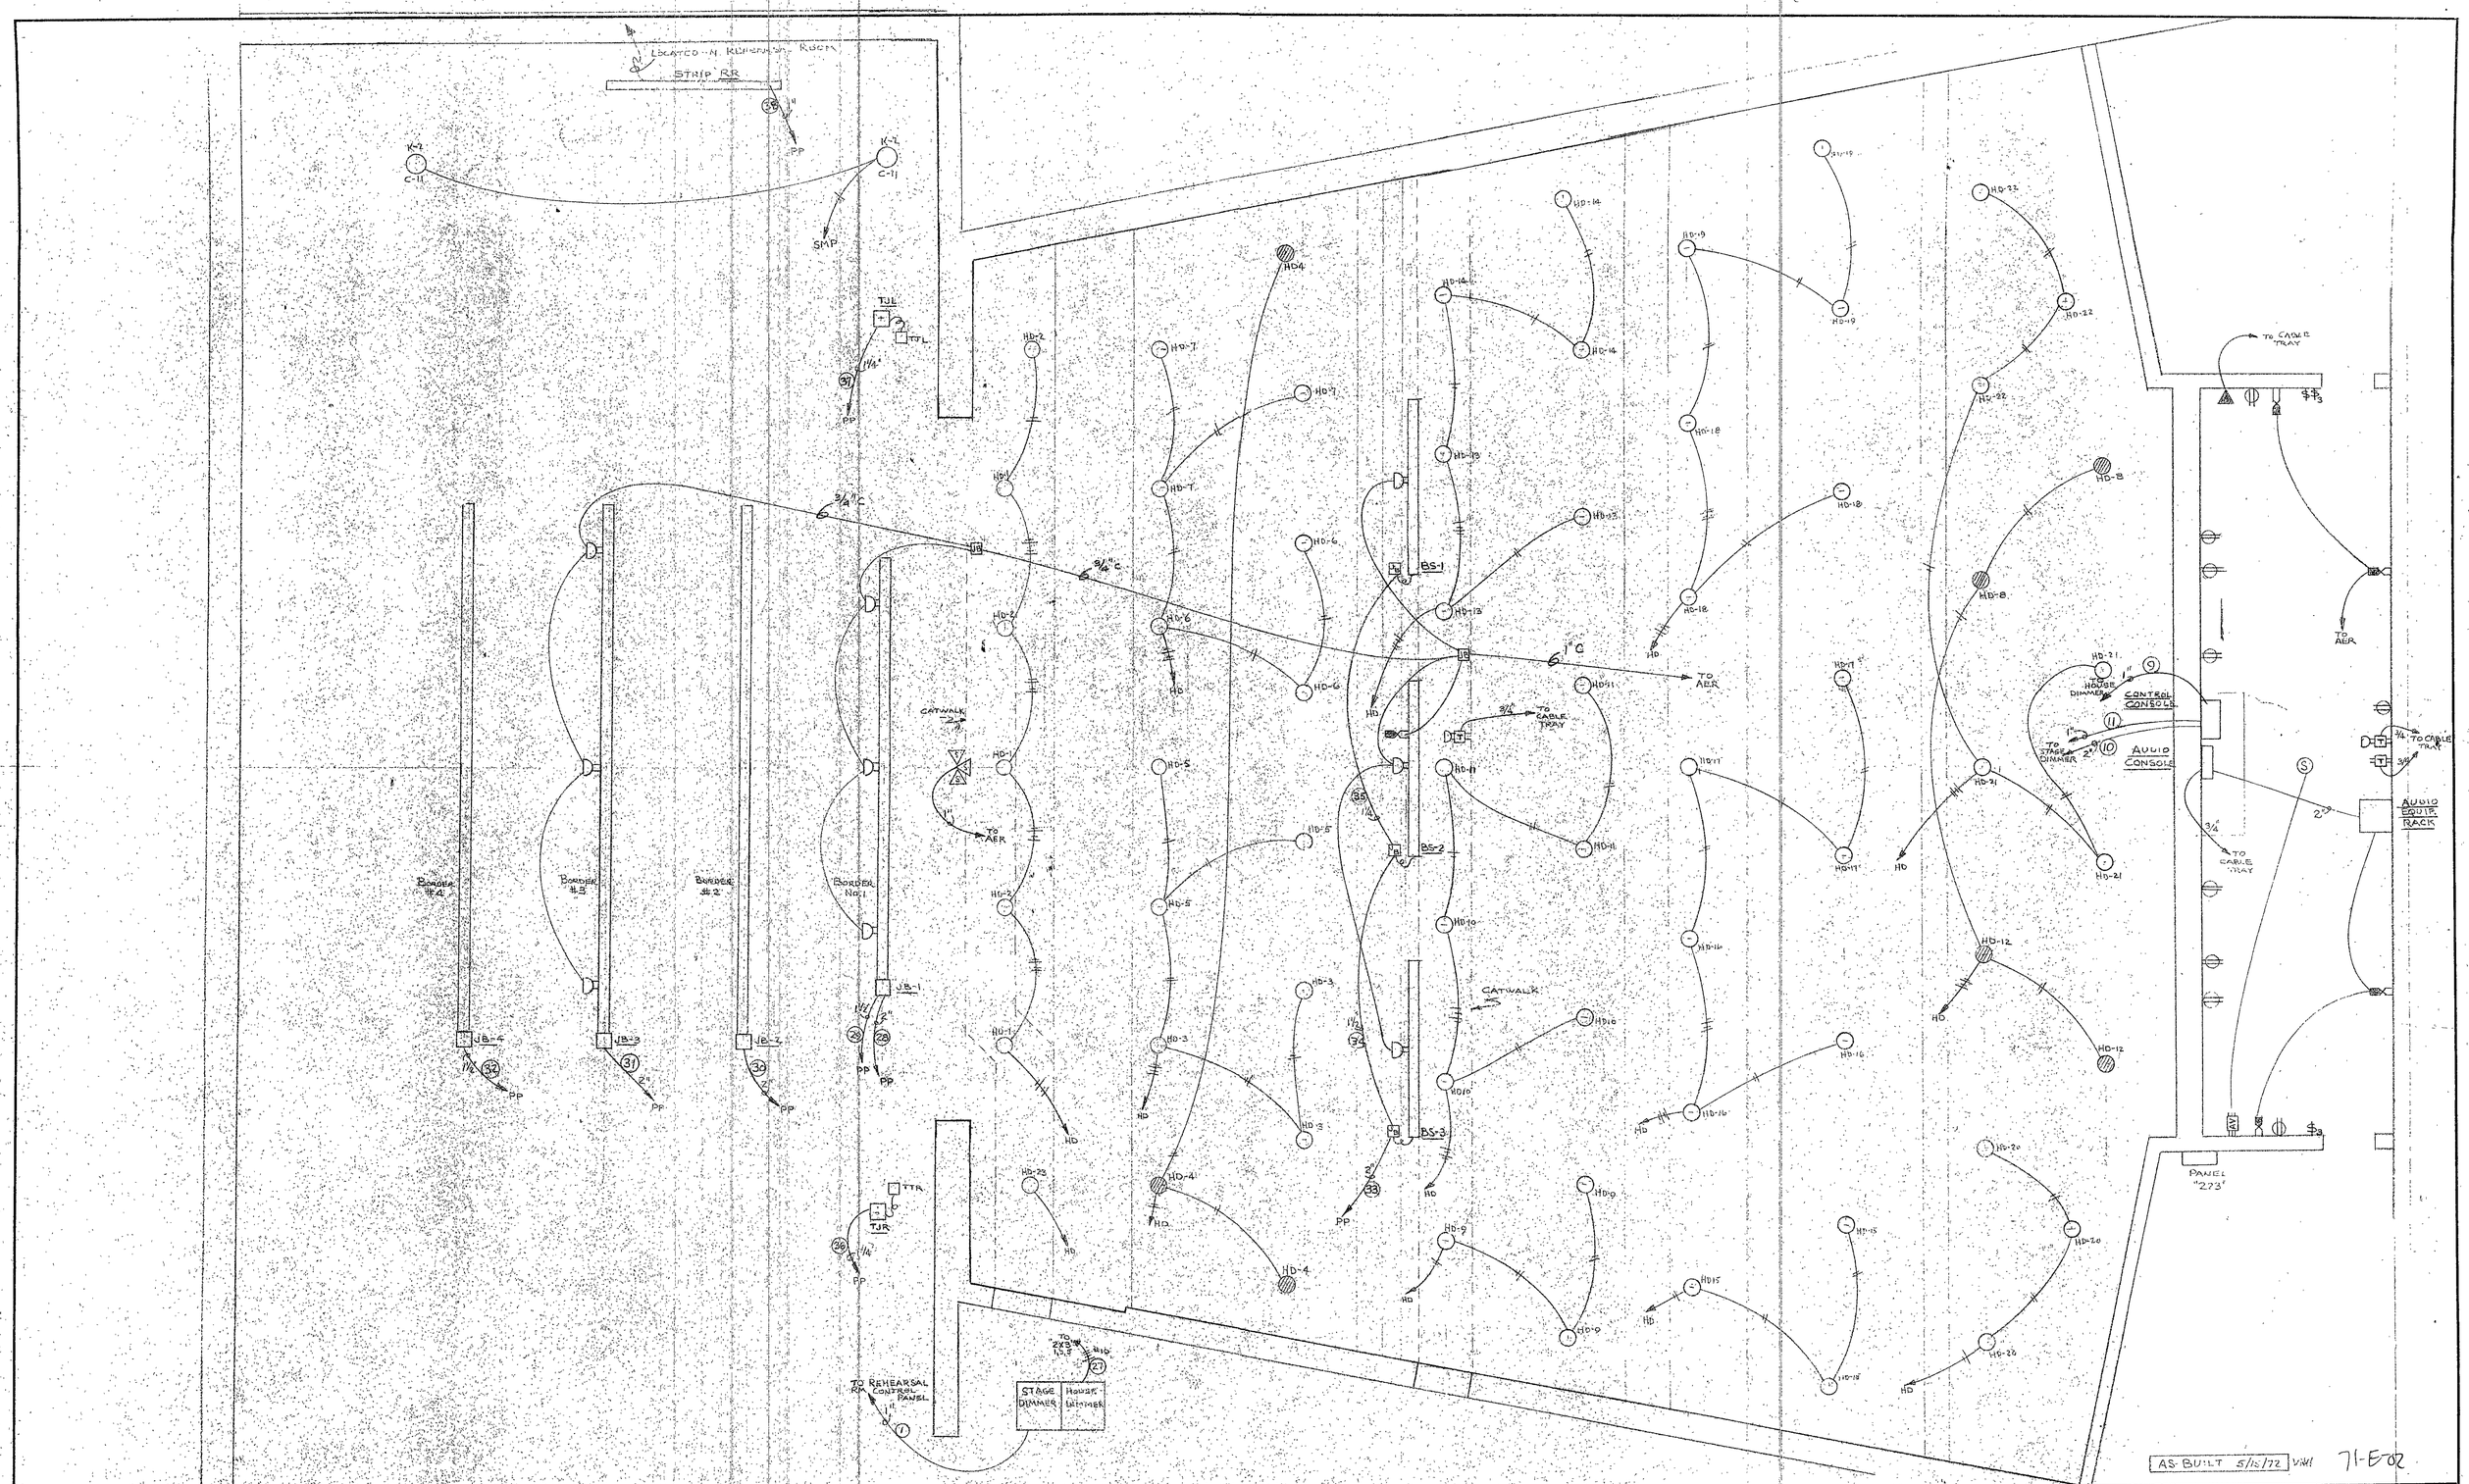

8X8S6 PRINTED ON NO. 1000H CLEARPRINT