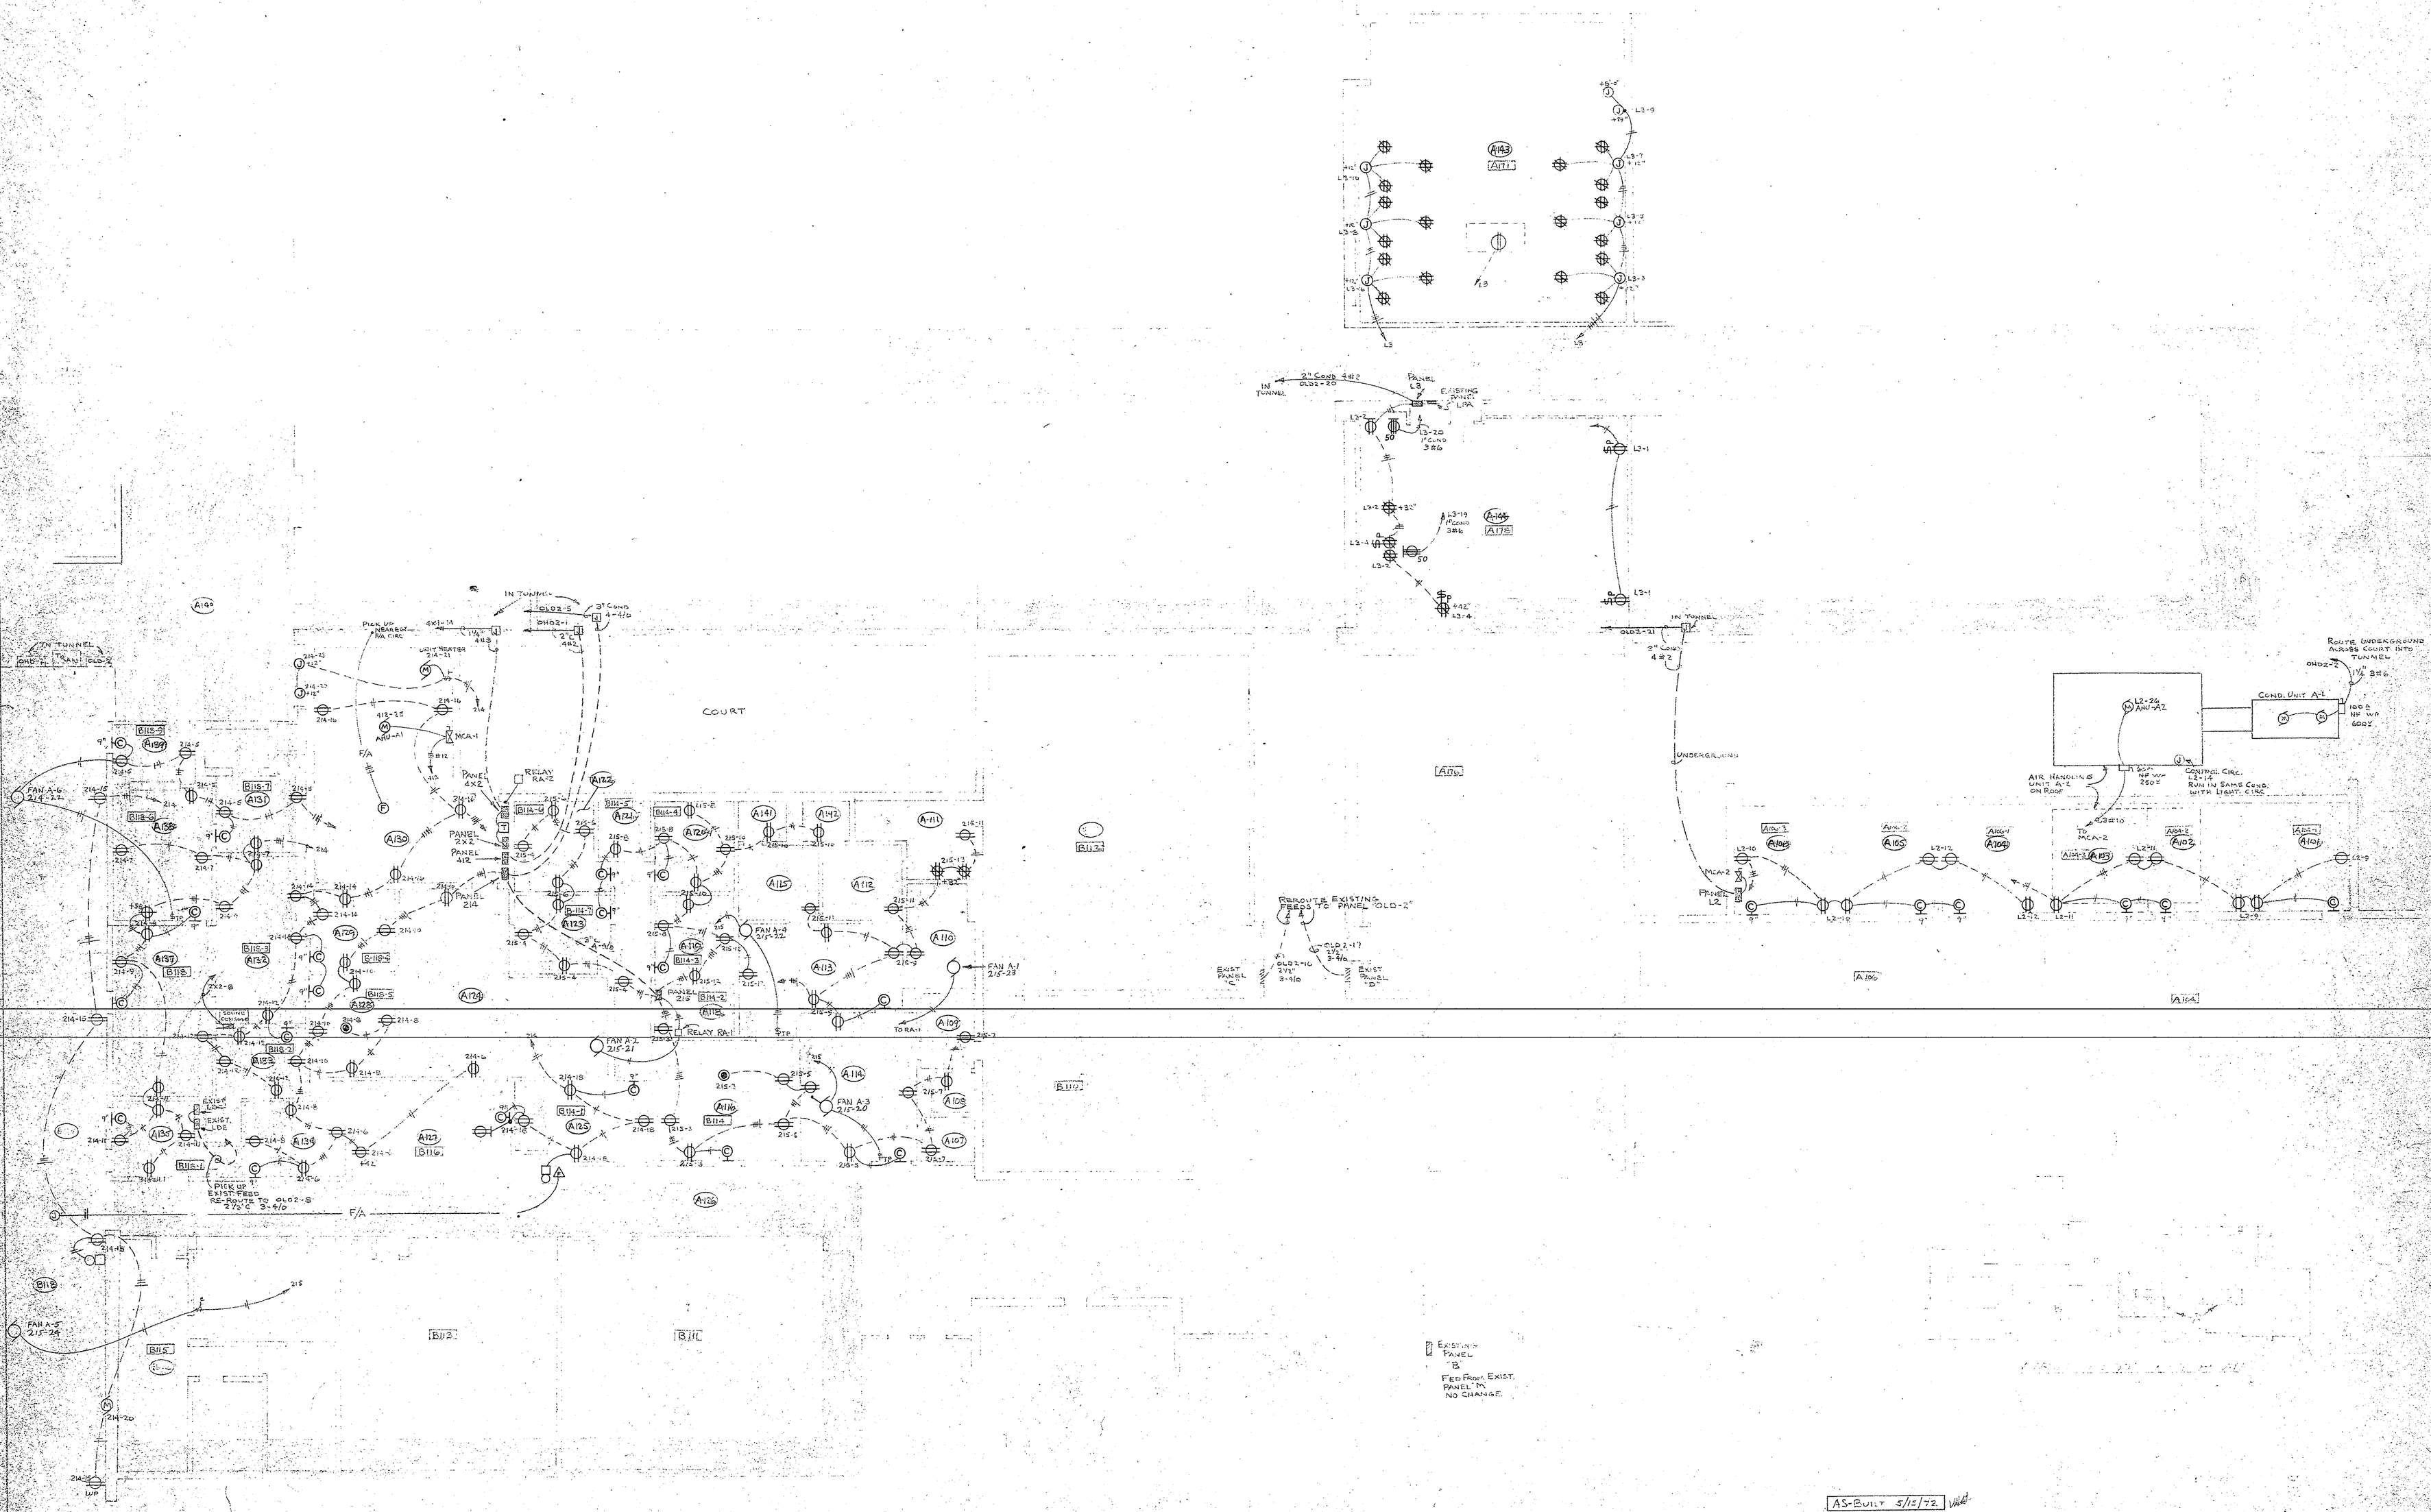

AS-BUILT 5/15/72

CIRCLE ELECTRIC, INC. CONTRACTOR P.O. BOX 130 PORTAGE, IND.	REV: REV: REV: DATE: 5/28/76 DR. BY: VWW 1/8" = 1'-0"	EVERETT I. BROWN CO. ARCH. & ENG. CHESTERTON SENIOR HIGH SCHOOL	SHOP DRWG. NO. E-3-SDE

71-506