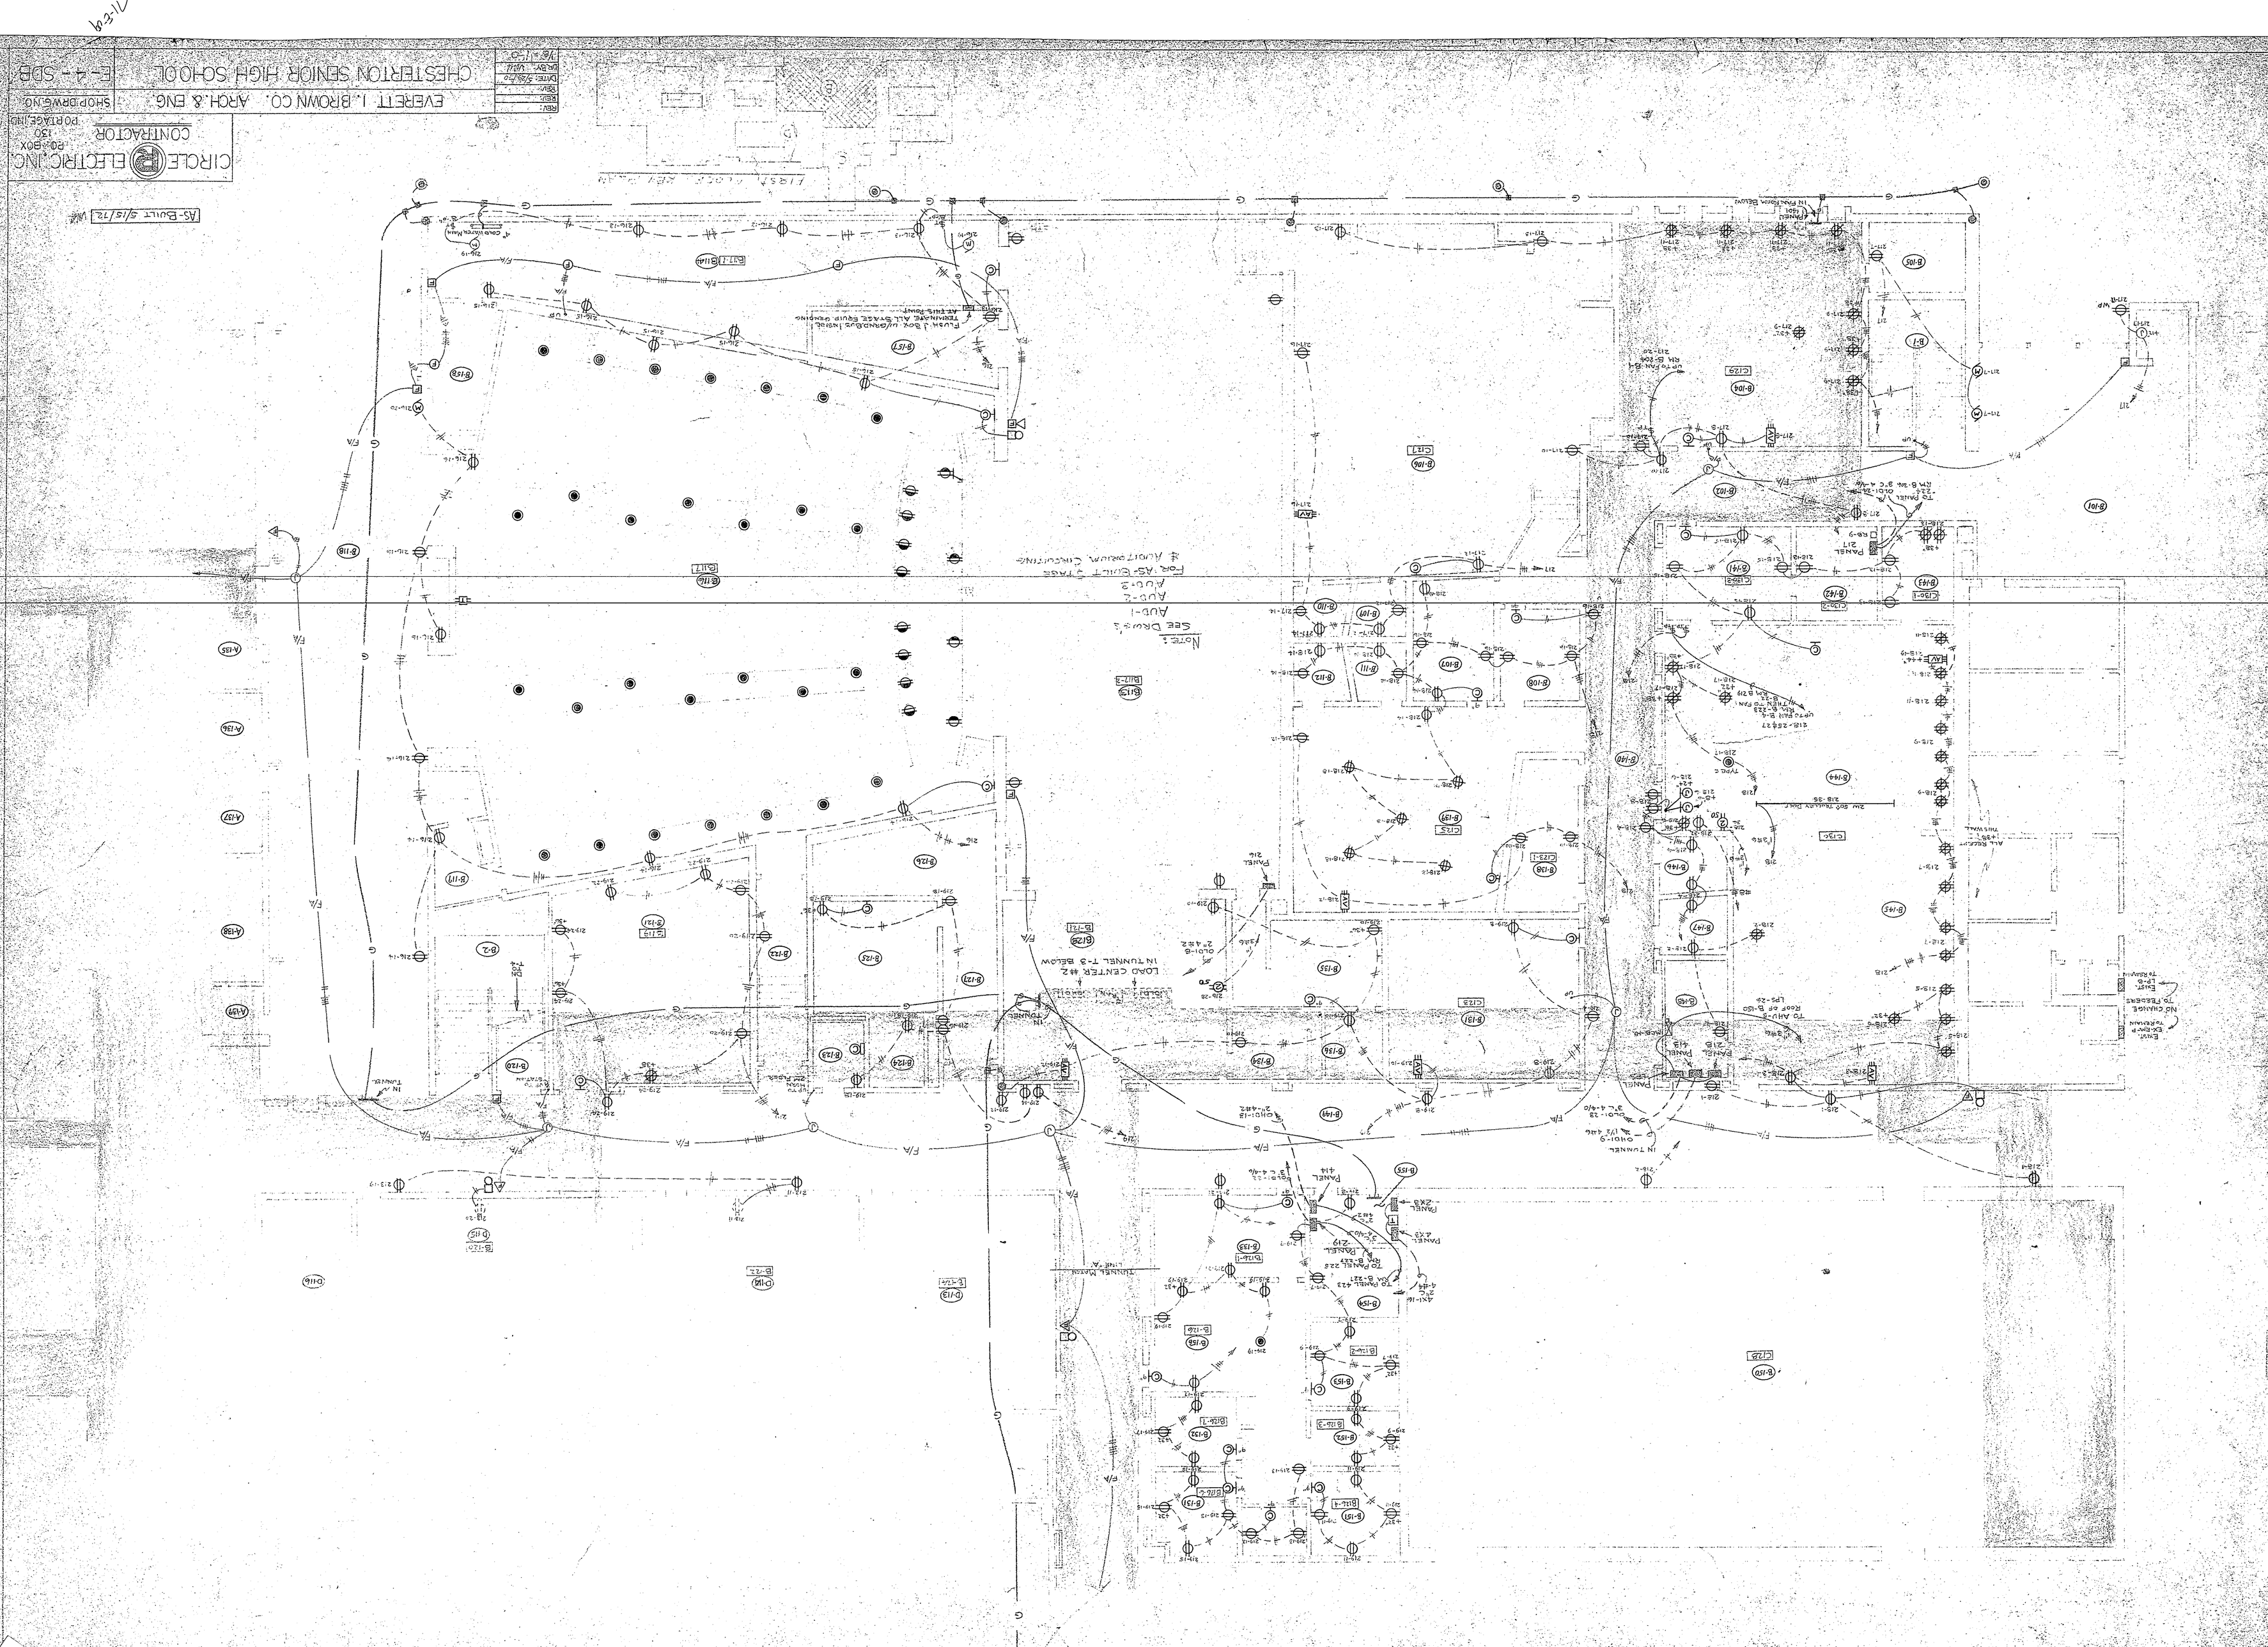
CIRCLE EF ELECTRIC, INC.
CONTRACTOR
PO BOX 130
PORTAGE, IND
EVERETT I. BROWN CO. ARCH. & ENG.
SHOP DRWG NO.
CHESTERTON SENIOR HIGH SCHOOL
E-4-SDB
AS-BUILT 5/15/12
Note:
See Dwg's
AUD-1
AUD-2
AUD-3
For AS-Built Image
& Auditorium Circuiting
Load Center #2
in Tunnel T-3 Below
Panel 216
Panel 414
Panel 413
Panel 213
Panel 211
Panel 212
Panel 215
Panel 217
Panel 219
Panel 423
Panel 421
Panel 422
Panel 424
Panel 425
Panel 426
Panel 427
Panel 428
Tunnel Motor
Tunnel "A"
Exit Ramp
No Chaise
To Freeses
Exit Ramp
To Roof
Exit Ramp
Walkway
Ex-Emer
Ramp
Exit Ramp
Exit Ramp
Exit