


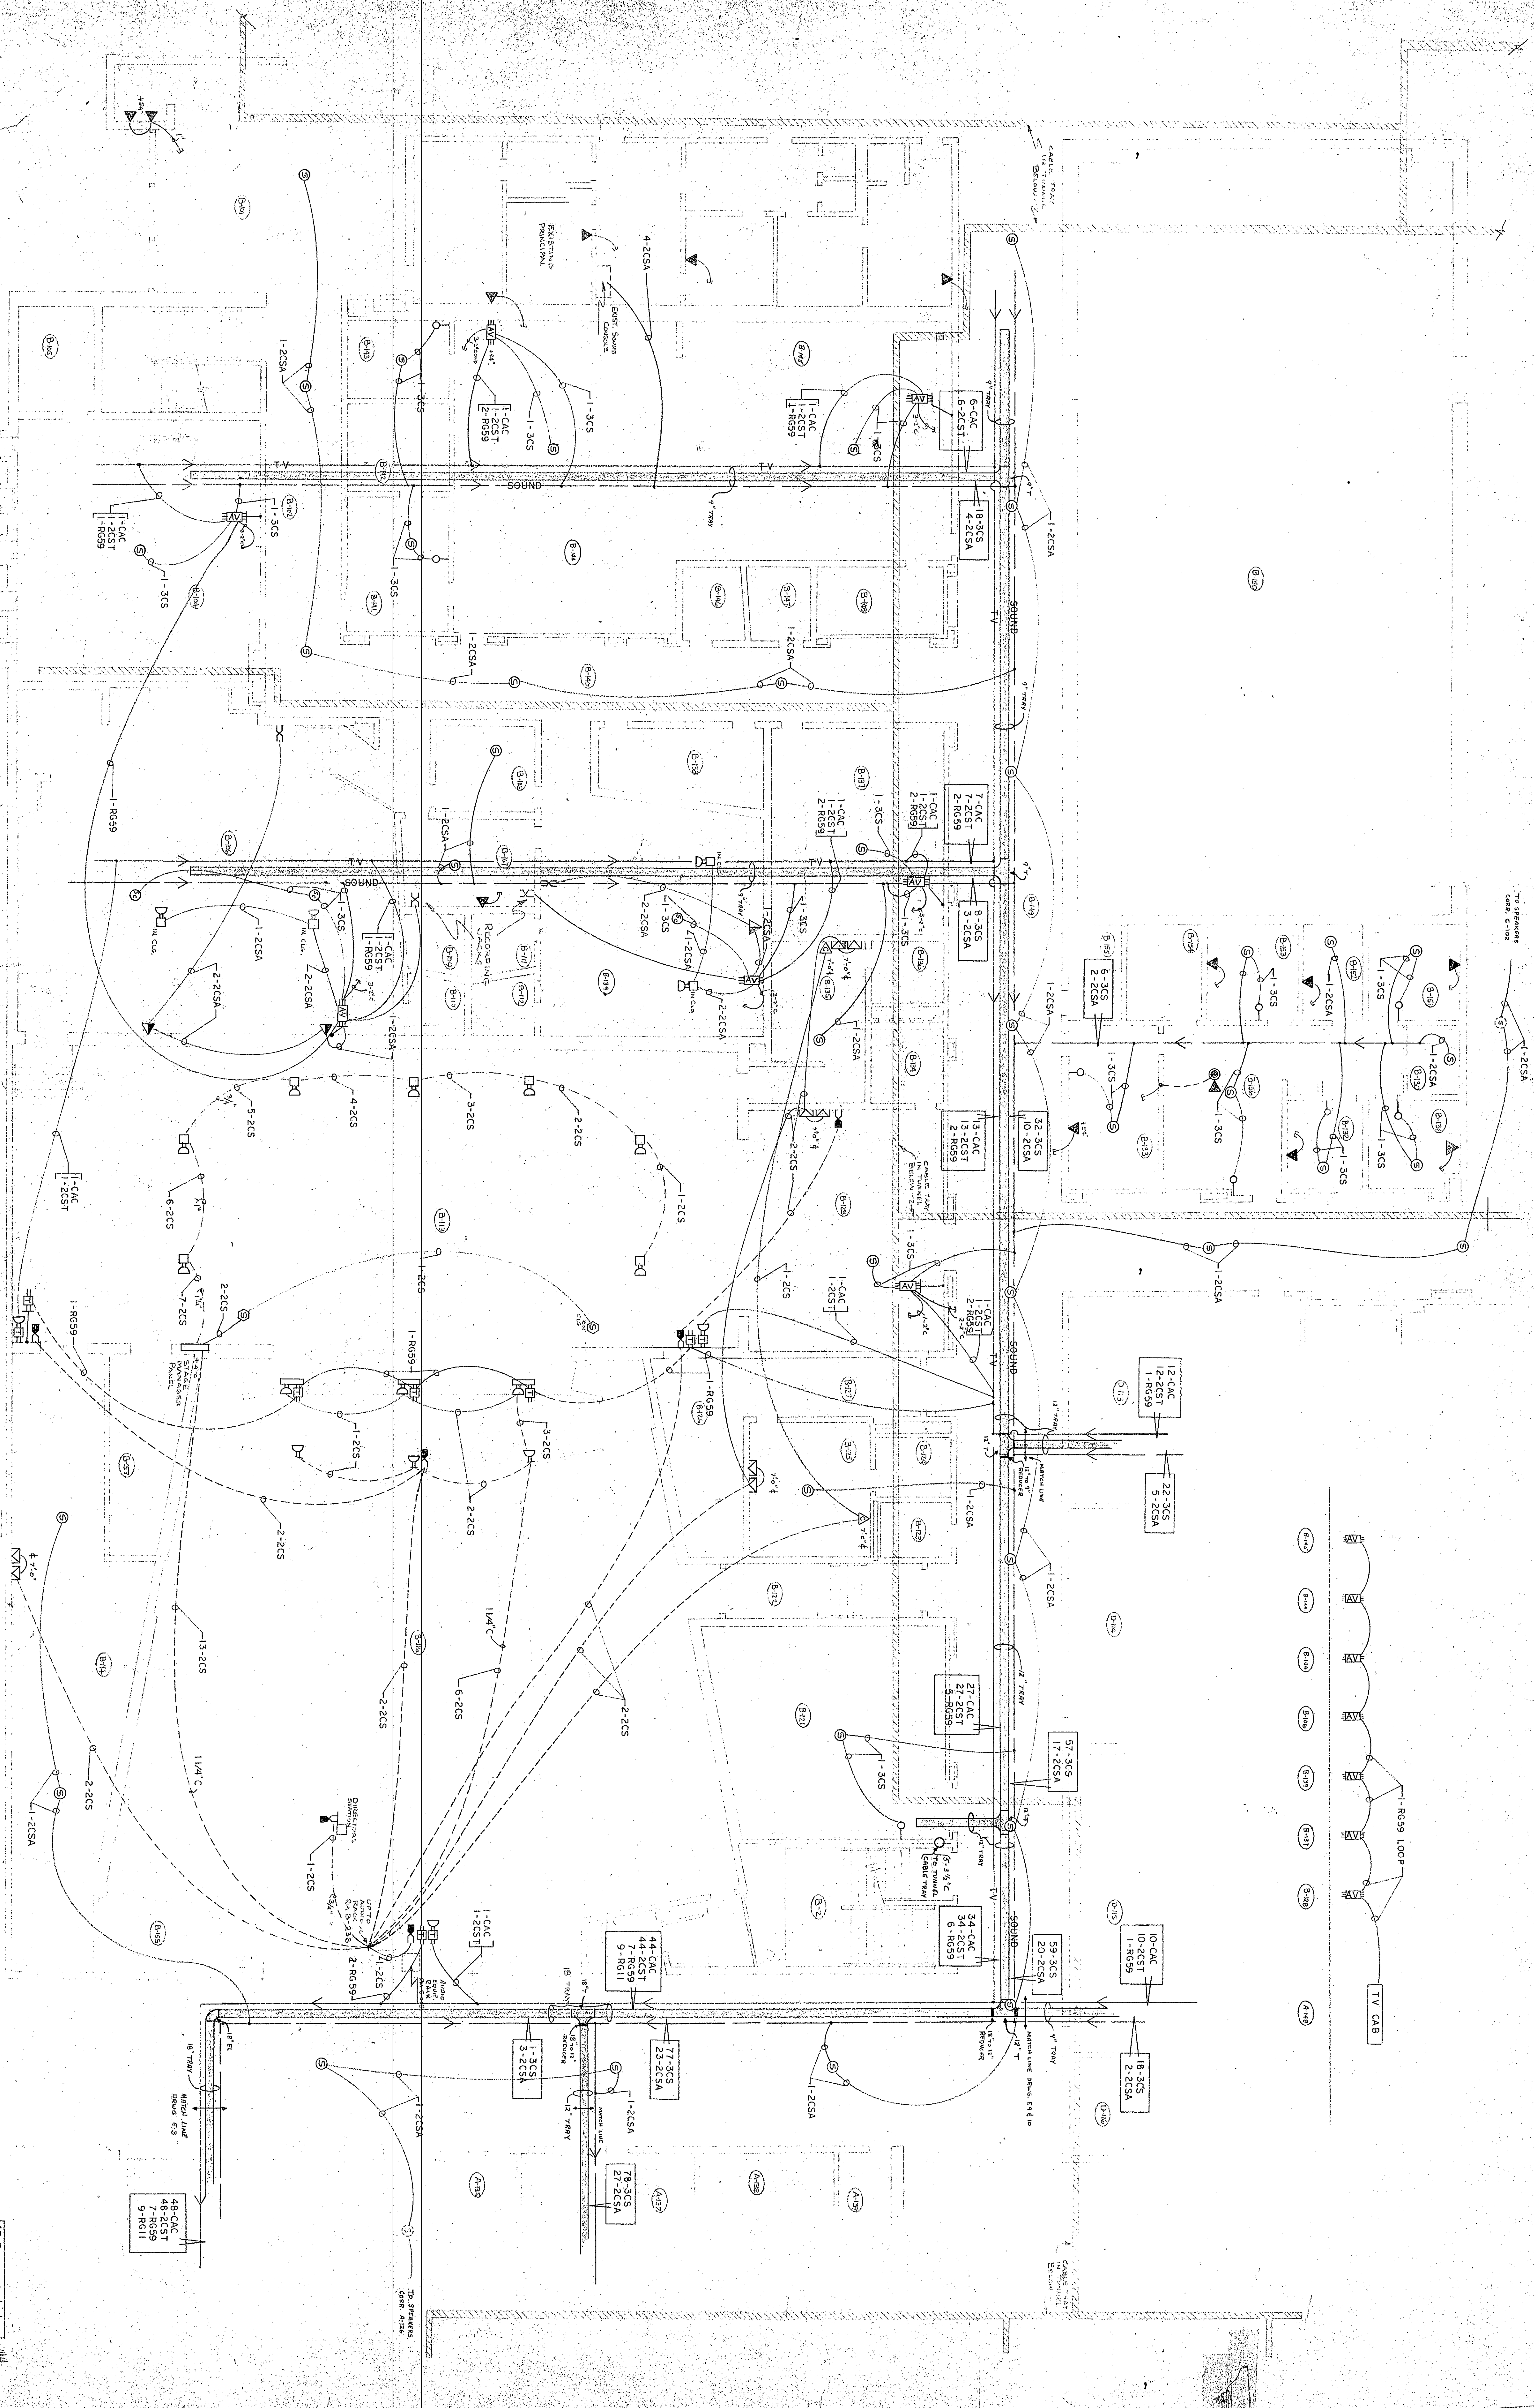

REVISIONS

REV	DATE	BY	DESCRIPTION
1	10/1/77	JLB	RE ROUTE CABLE TRAY & CABLE DIAGRAM

PROJECT INFORMATION

CHESTERTON SENIOR HIGH SCHOOL

EVERETT I. BROWN CO. ARCH. & ENG.

SHOEBRING, IND.

COMPANY INFORMATION

CIRCLE ELECTRIC, INC.

CONTRACTOR

P.O. BOX 130

SHOEBRING, IND.

PROJECT NUMBER

E-41-SDC