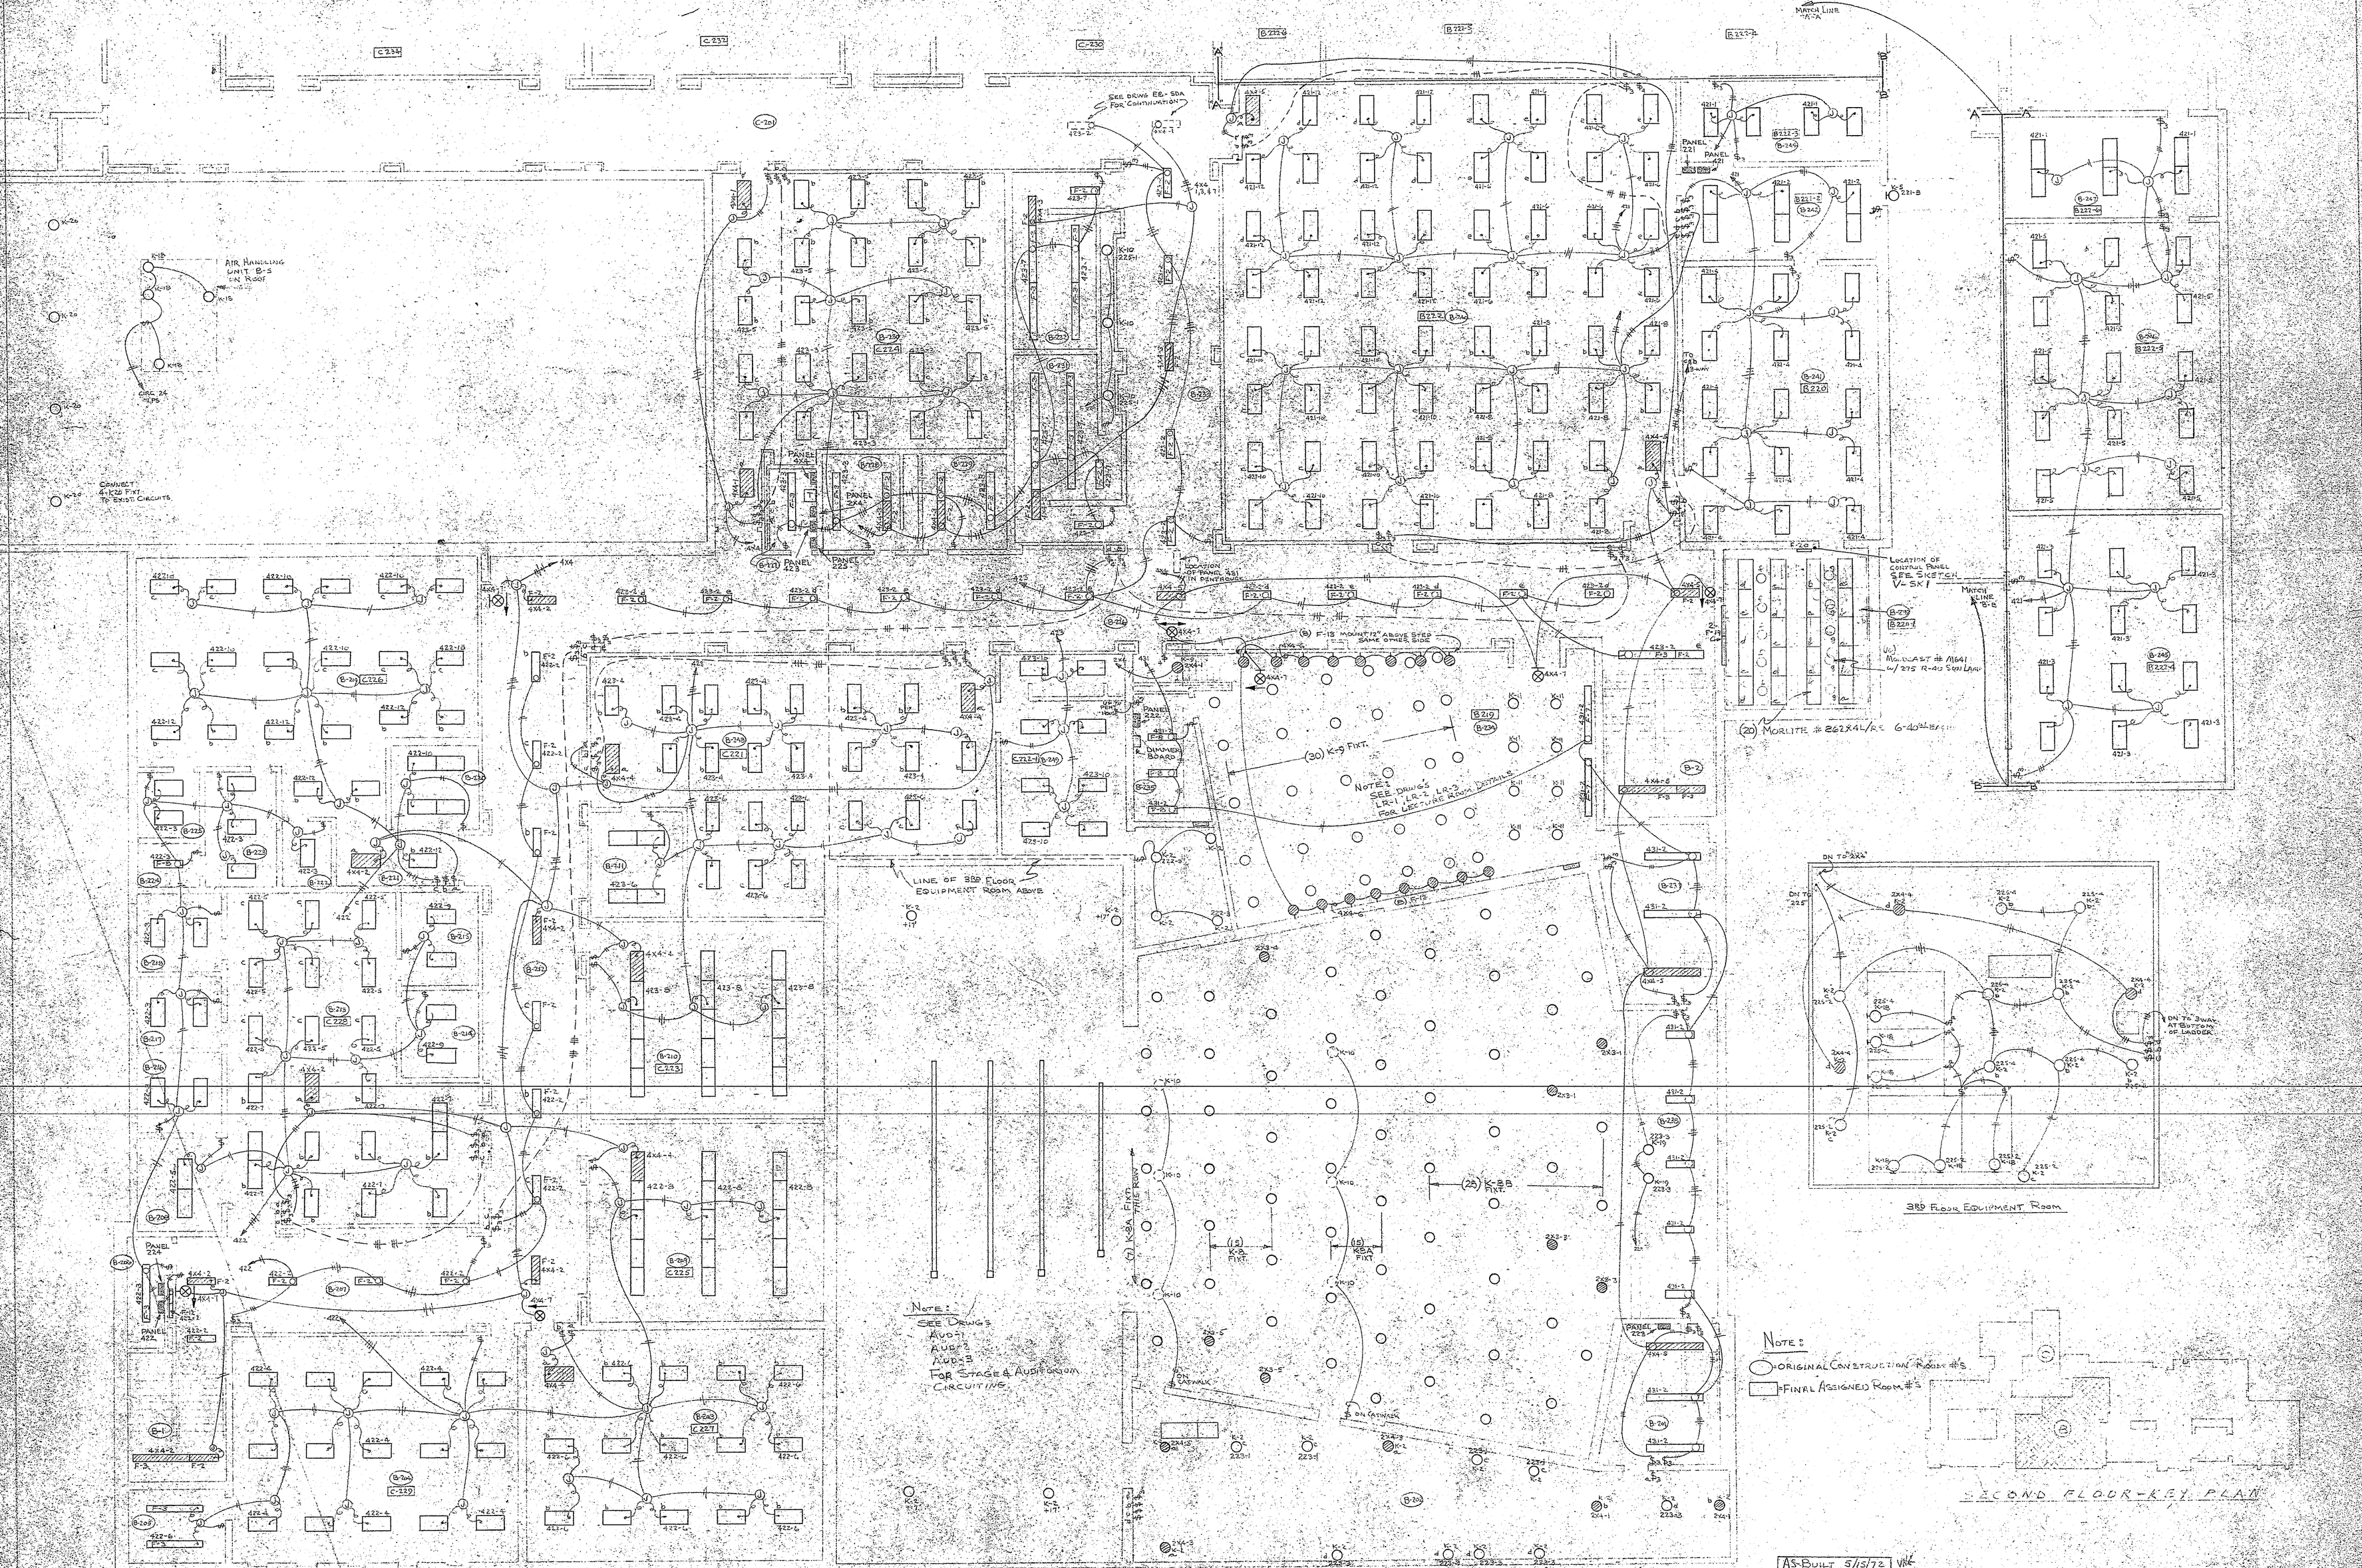

AS-BUILT 5/15/72 WK

CIRCLE ELECTRIC, INC. CONTRACTOR, P.O. BOX 150 PORTAGE, IND.	REV.: REV.: REV.: DATE: 6/1/70 DR. BY: WKK 1/8" = 1'-0"	EVERETT I. BROWN CO. ARCH. & ENG. CHESTERTON SENIOR HIGH SCHOOL	SHOP DRWG. NO. E-5-SDA

11-4-71