


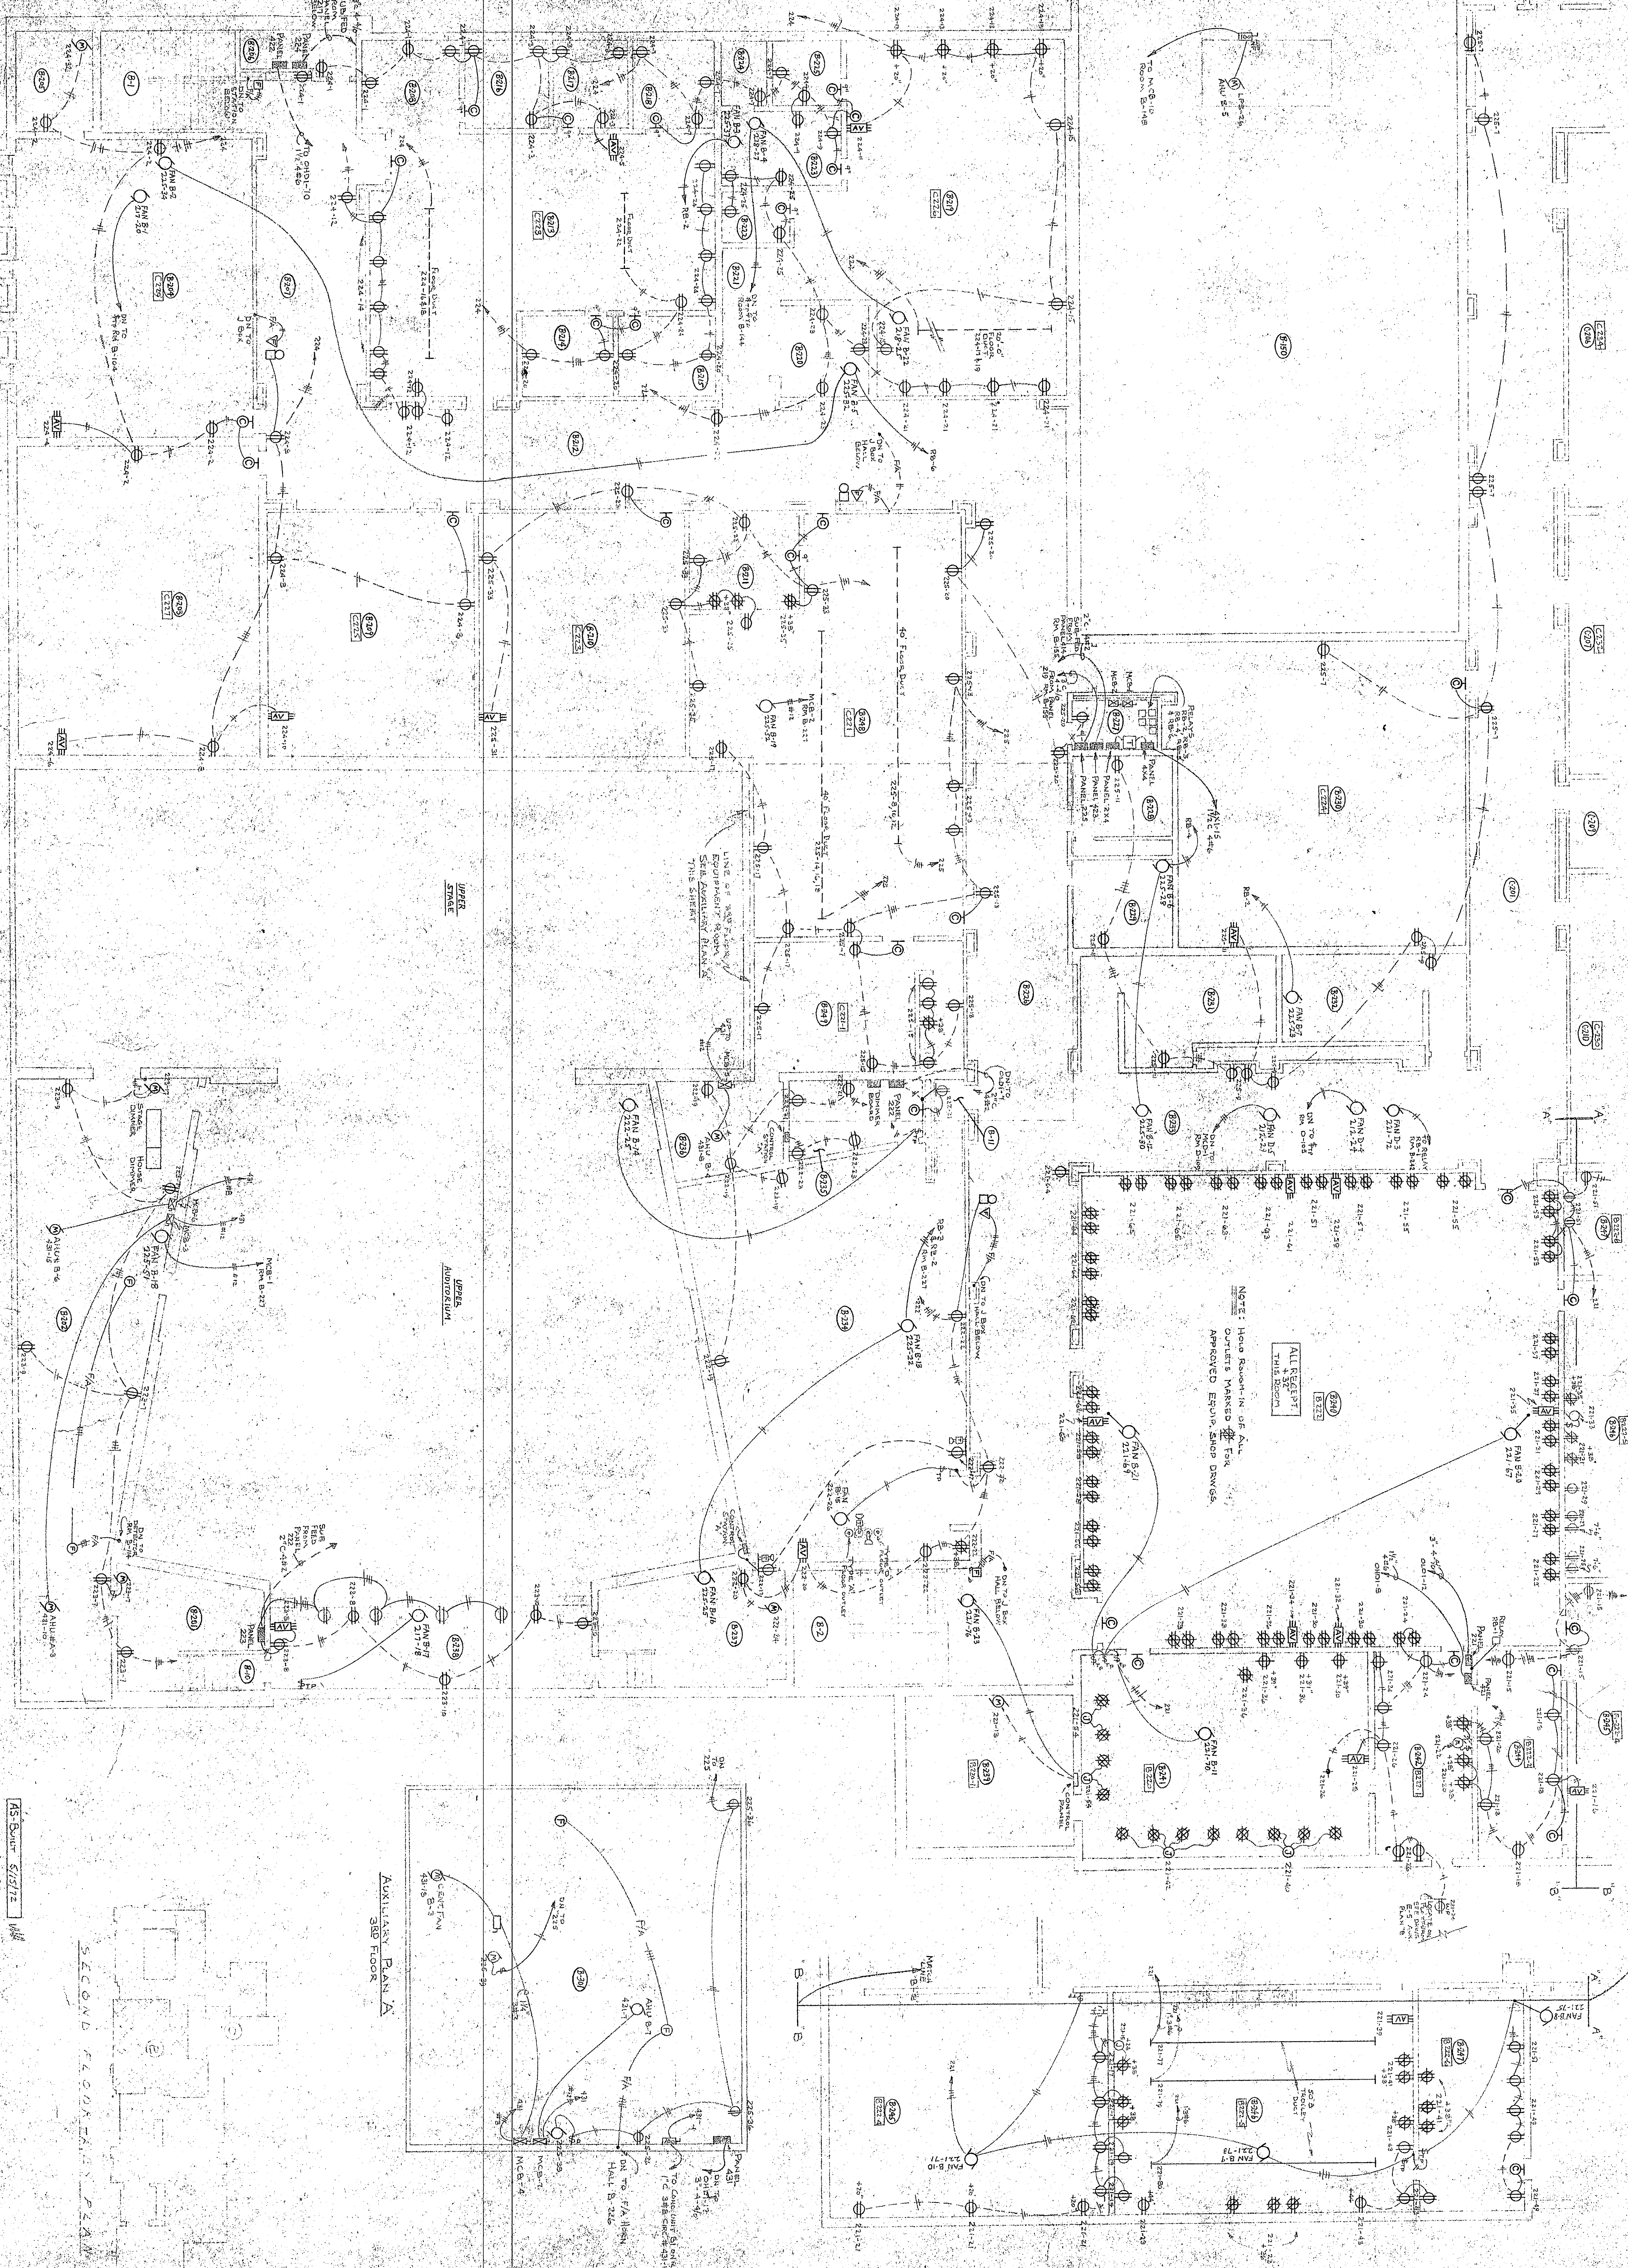

NOTE: HALL LIGHTS IN ALL
CORRIDORS MARKED FOR
APPROVED EQUIP. SHOP DRIVES.

ALL EQUIP. IN
THIS ROOM

CIRCLE ELECTRIC, INC. CONTRACTOR	REV.	EVERETT J. BROWN CO. ARCH. & ENG.	SHOP DRAWING
	PO BOX		
	DATE 6/6/72		
	PROJECT	CHESTERION SENIOR HIGH SCHOOL	
FLOOR PLAN			

15 Butler 5/17/72

SECOND FLOOR PLAN

Auxiliary Room A
3RD FLOOR