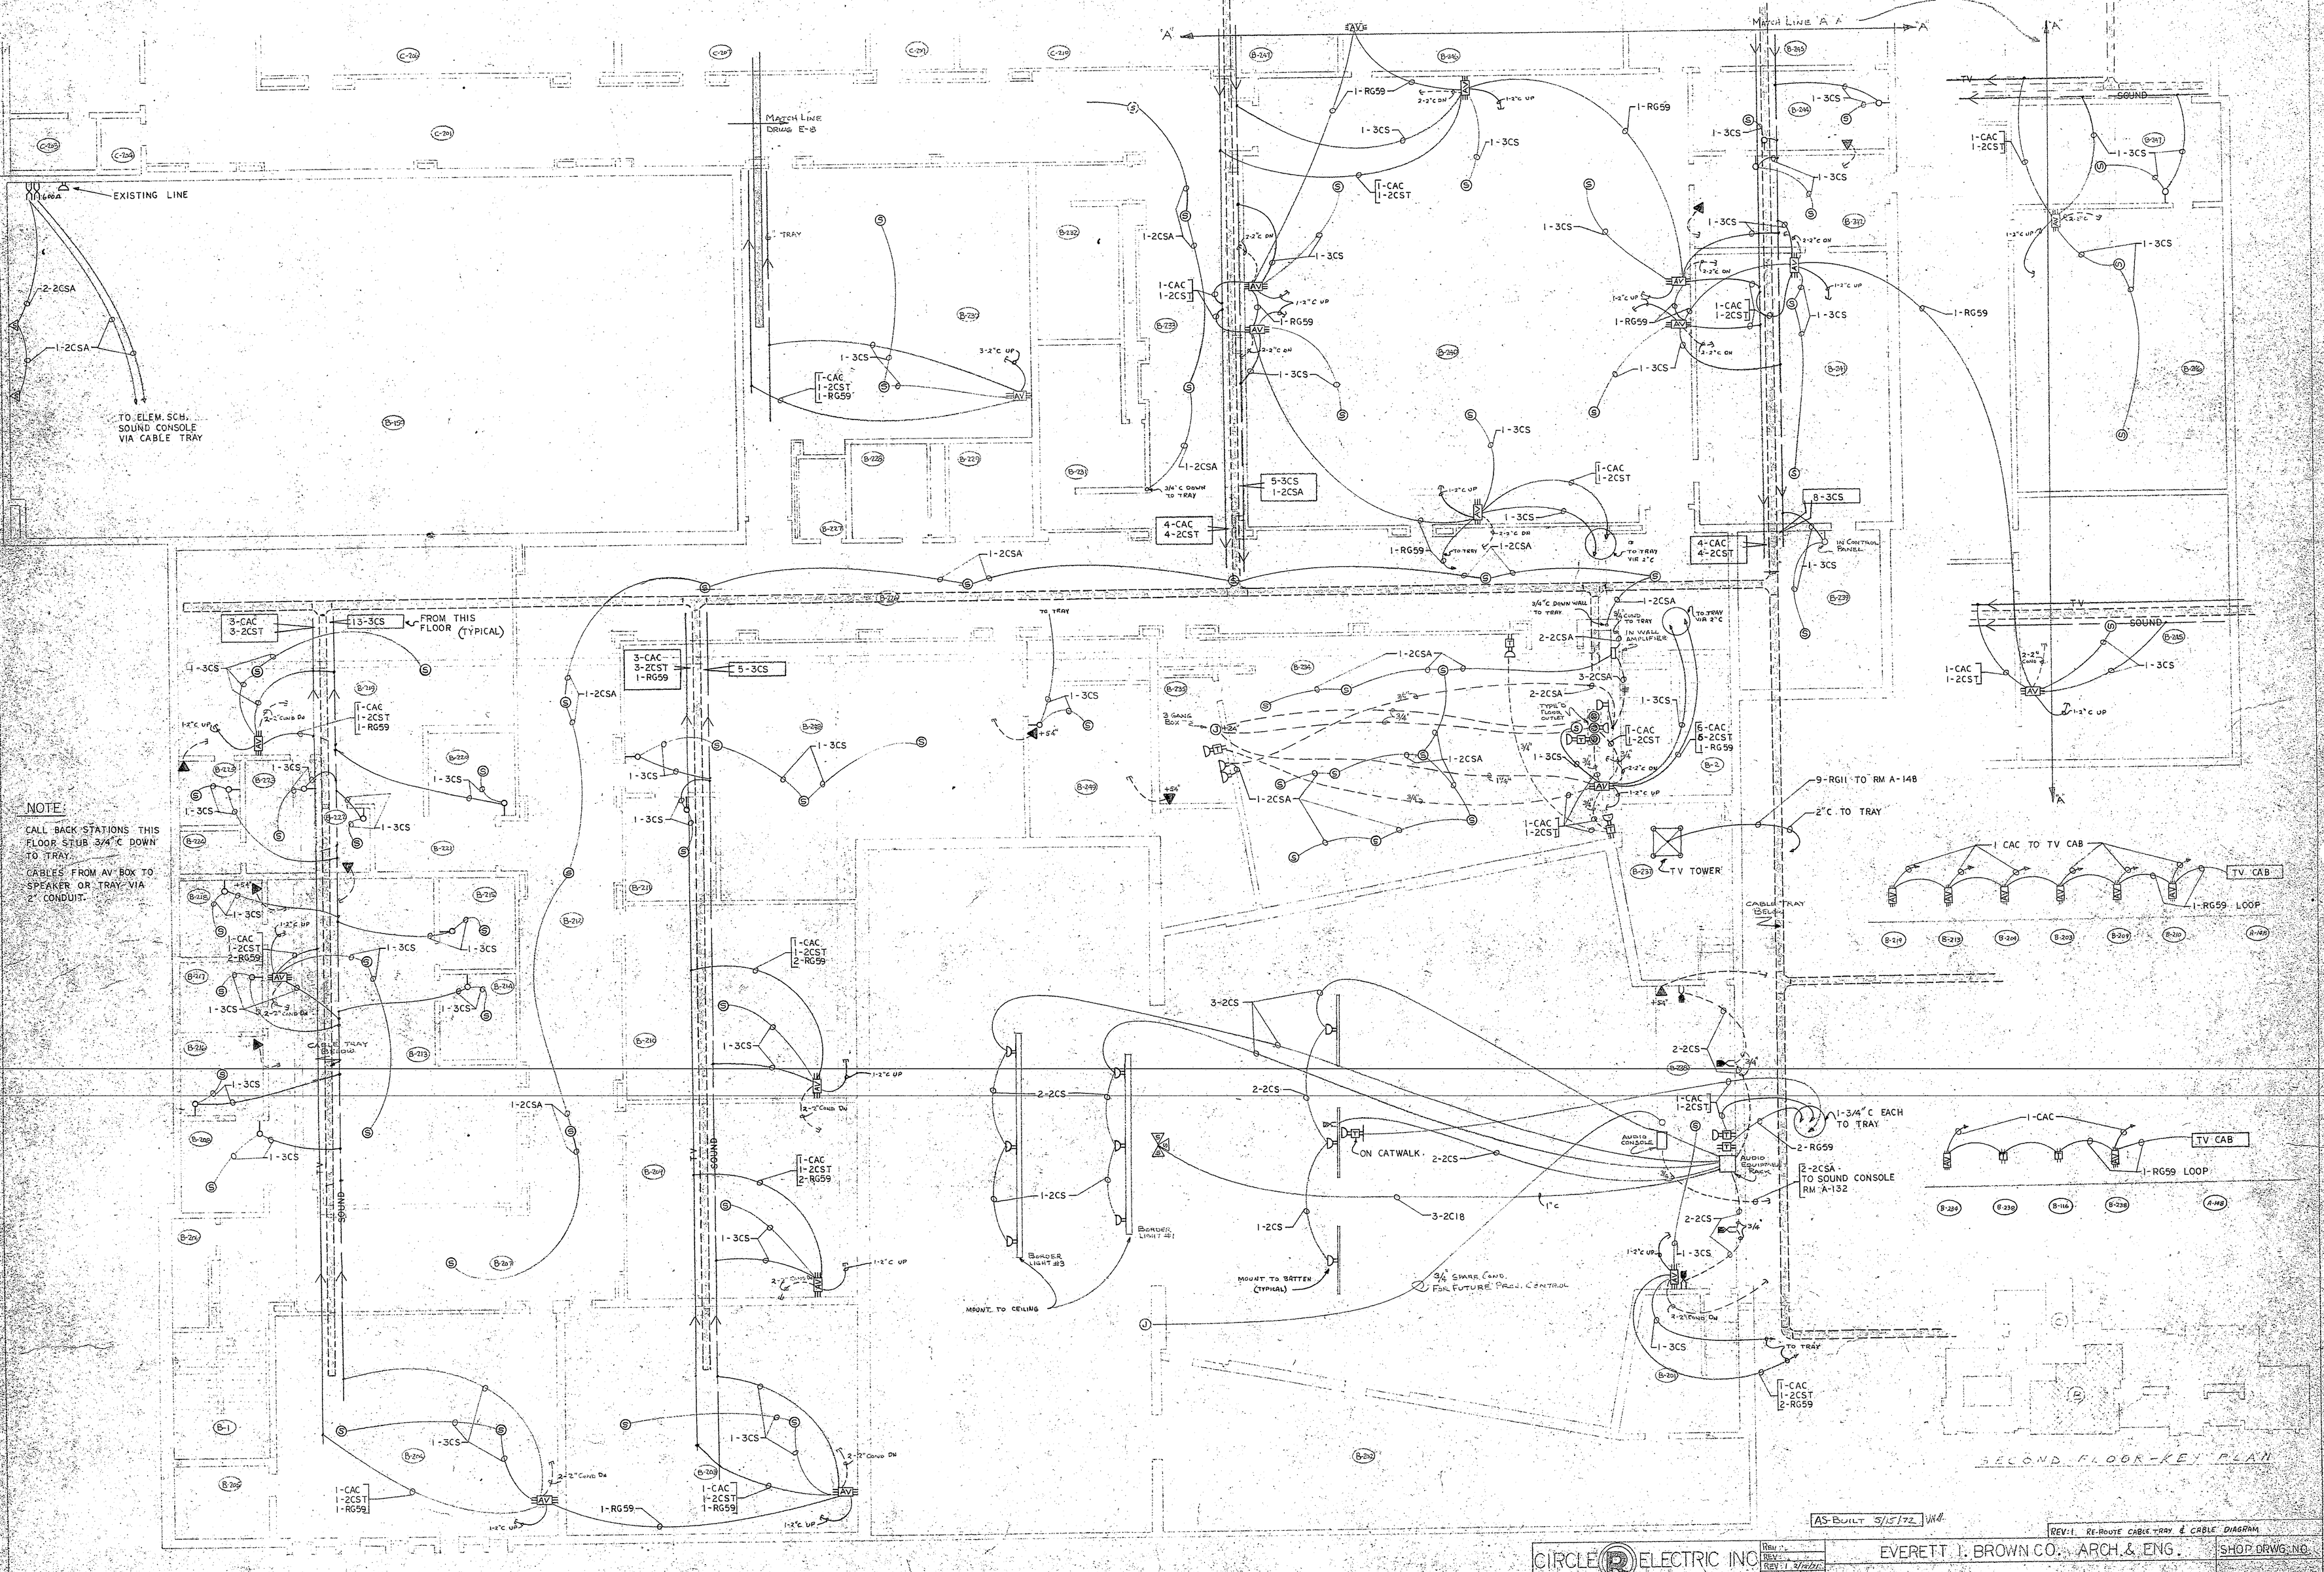

AS-BUILT 5/15/72

REV:1 RE-ROUTE CABLE TRAY & CABLE DIAGRAM

CIRCLE R ELECTRIC INC. CONTRACTOR P.O. BOX 130 PORTAGE, IND.	REV: REV:1 3/16/72 DATE: 6/16/70 DR. BY: 1/8=1'-0"	EVERETT I. BROWN CO. ARCH. & ENG. CHESTERTON SENIOR HIGH SCHOOL	SHOP DRWG. NO. E-5-SDO

71873