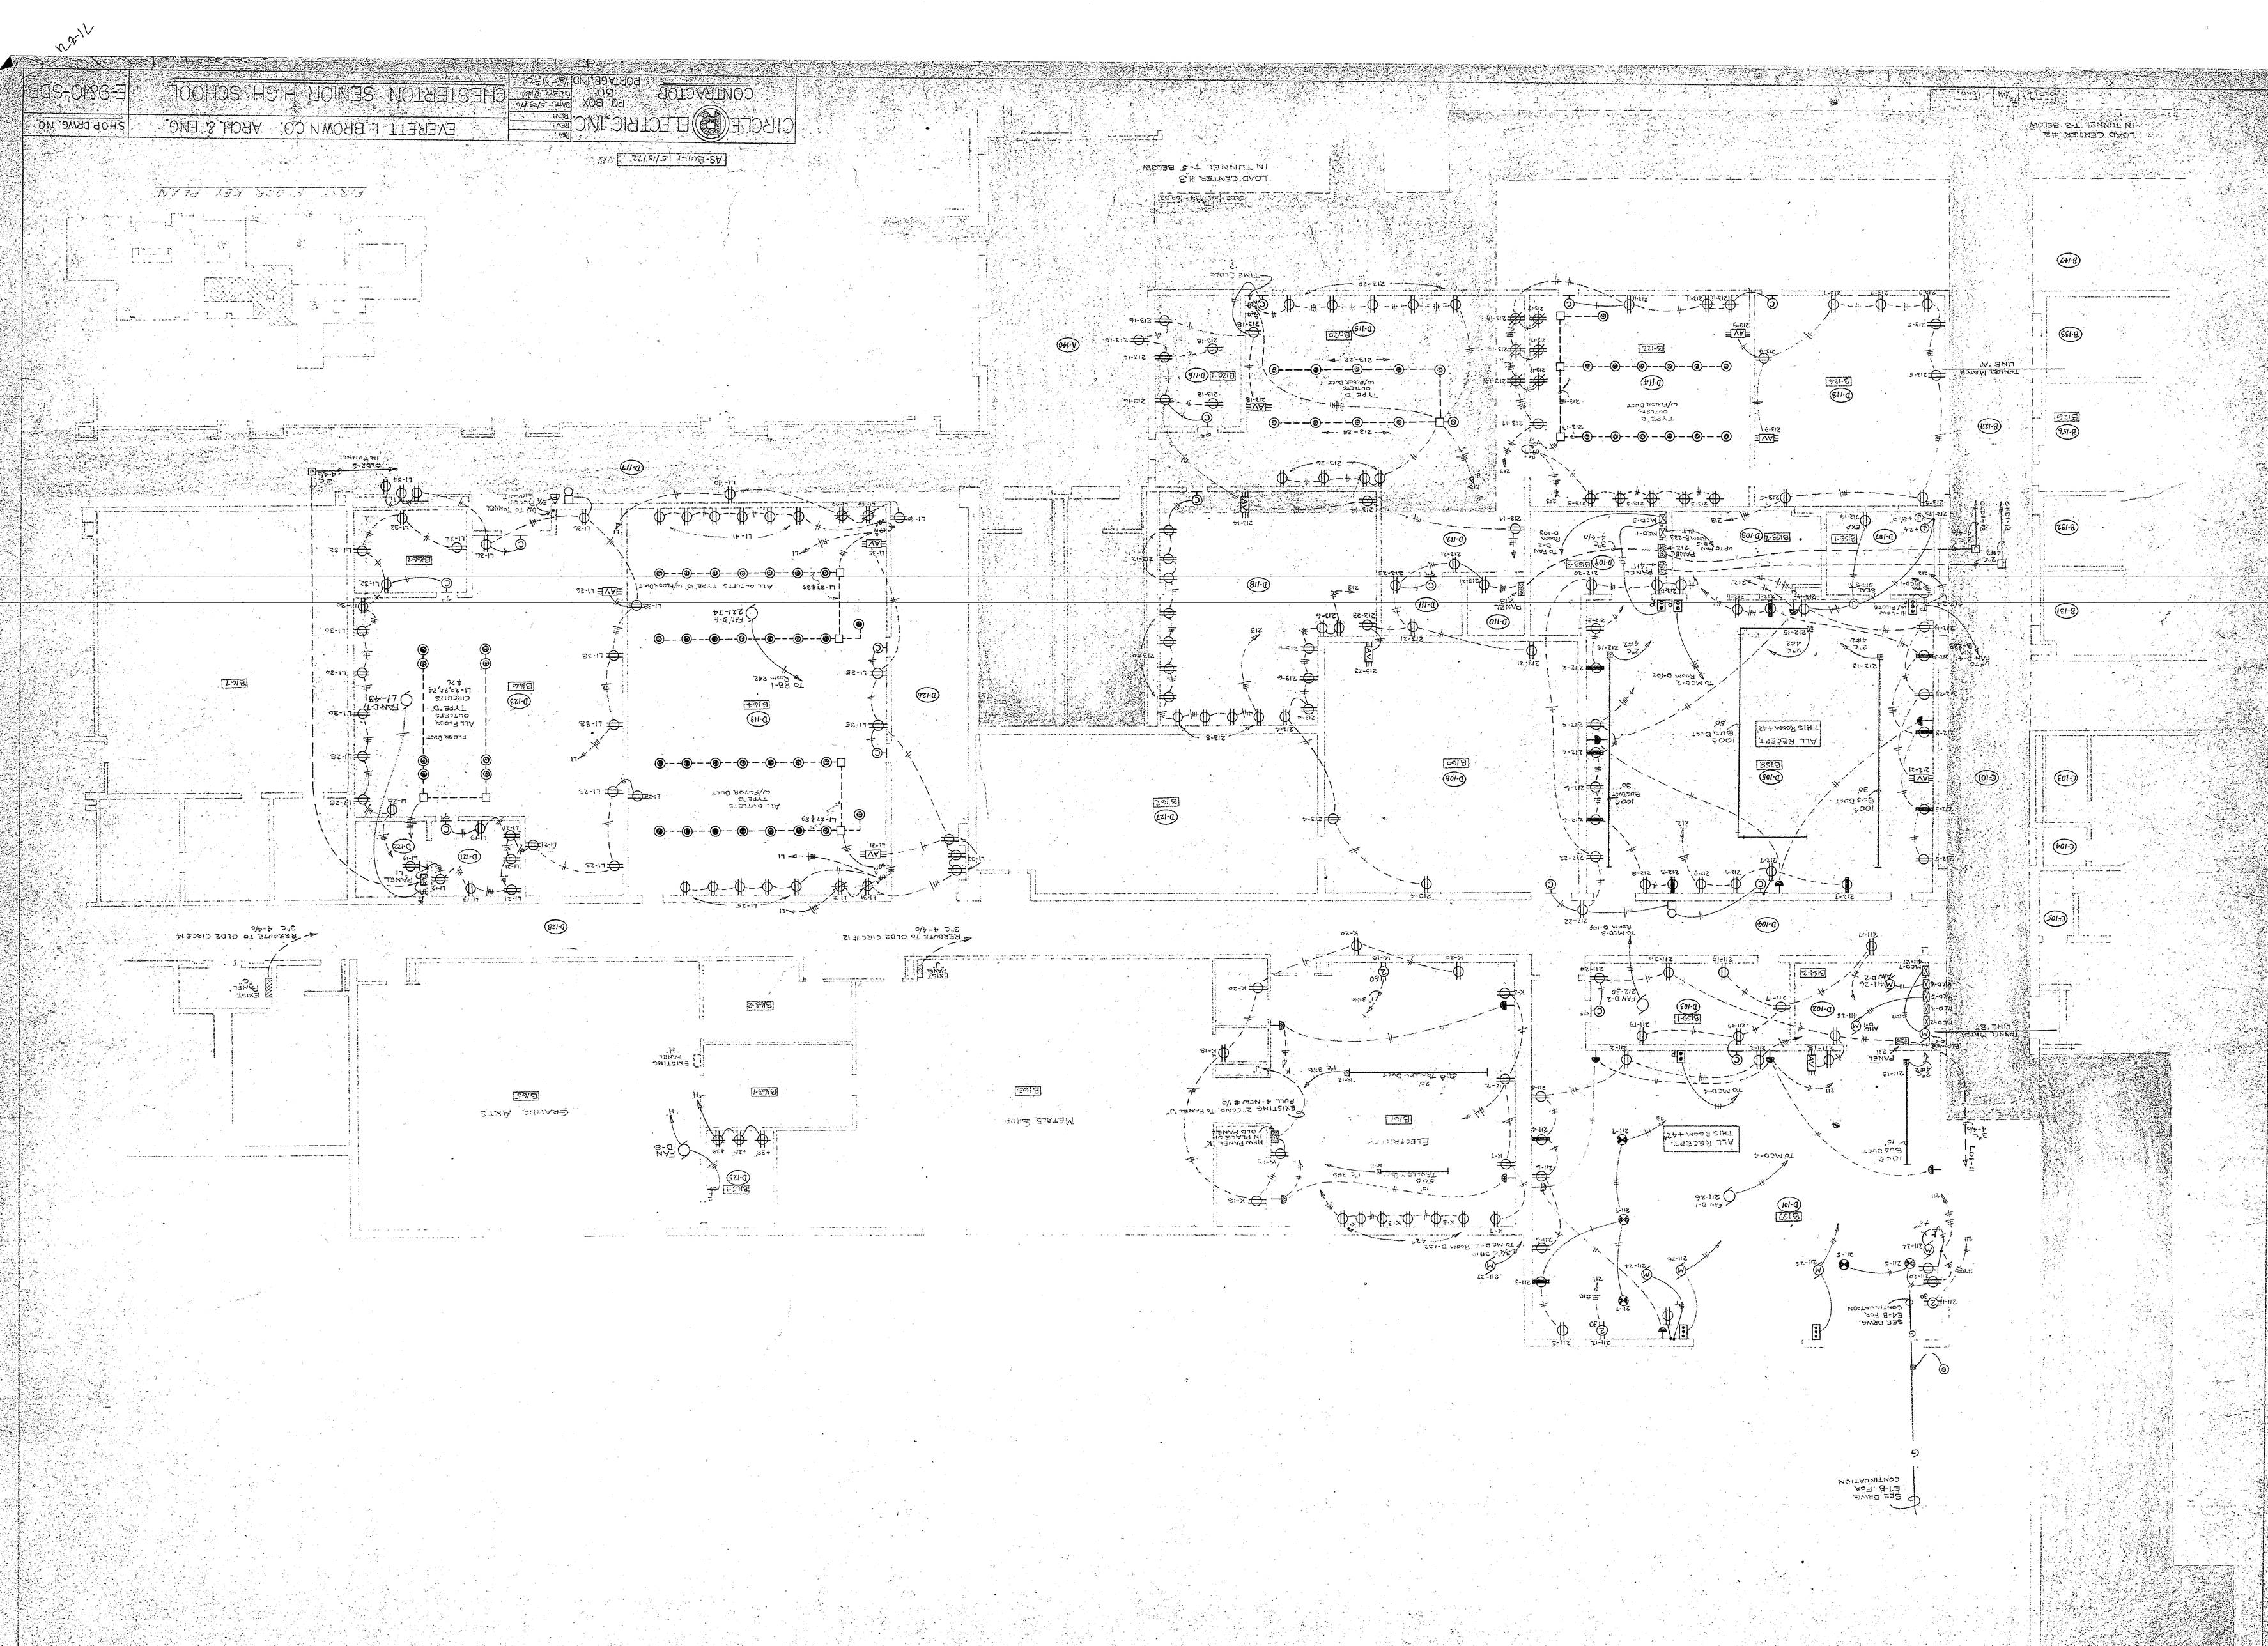
CIRCLE ELECTRIC, INC
CONTRACTOR
P.O. BOX 130
PORTAGE, IND.
EVERETT L. BROWN CO. ARCH. & ENG.
CHESTERTON SENIOR HIGH SCHOOL
E-9810-SDB
SHOP DRWG. NO
AS-Built 5/15/72
FIRST FLOOR KEY PLAN
LOAD CENTER #3
IN TUNNEL T-5 BELOW
LOAD CENTER #2
IN TUNNEL T-3 BELOW
TUNNEL MATCH LINE A
TUNNEL MATCH LINE B
ALL RECEPT. THIS ROOM #42
ALL RECEPT. THIS ROOM #43
ELECTRICITY
METALS SHOP
GENERAL SHOP
SEE DRWG. E-1-B FOR CONTINUATION
SEE DRWG. E-1-B FOR CONTINUATION
REROUTE TO OLD2 CIRC #12
REROUTE TO OLD2 CIRC #14
EXISTING PANEL H
EXIST. PANEL G
NEW PANEL K IN PLACE OF OLD PANEL
EXISTING 2"CONV. TO PANEL J. PULL 4-NEW #10
TO MCD-4
TO MCD-3 ROOM D-109
TO MCD-2 ROOM D-107
TO MCD-1 ROOM D-103
TO MCD-7 ROOM D-102
TO MCD-6 ROOM D-105
TO MCD-5 ROOM D-106
TO MCD-8 ROOM D-108
