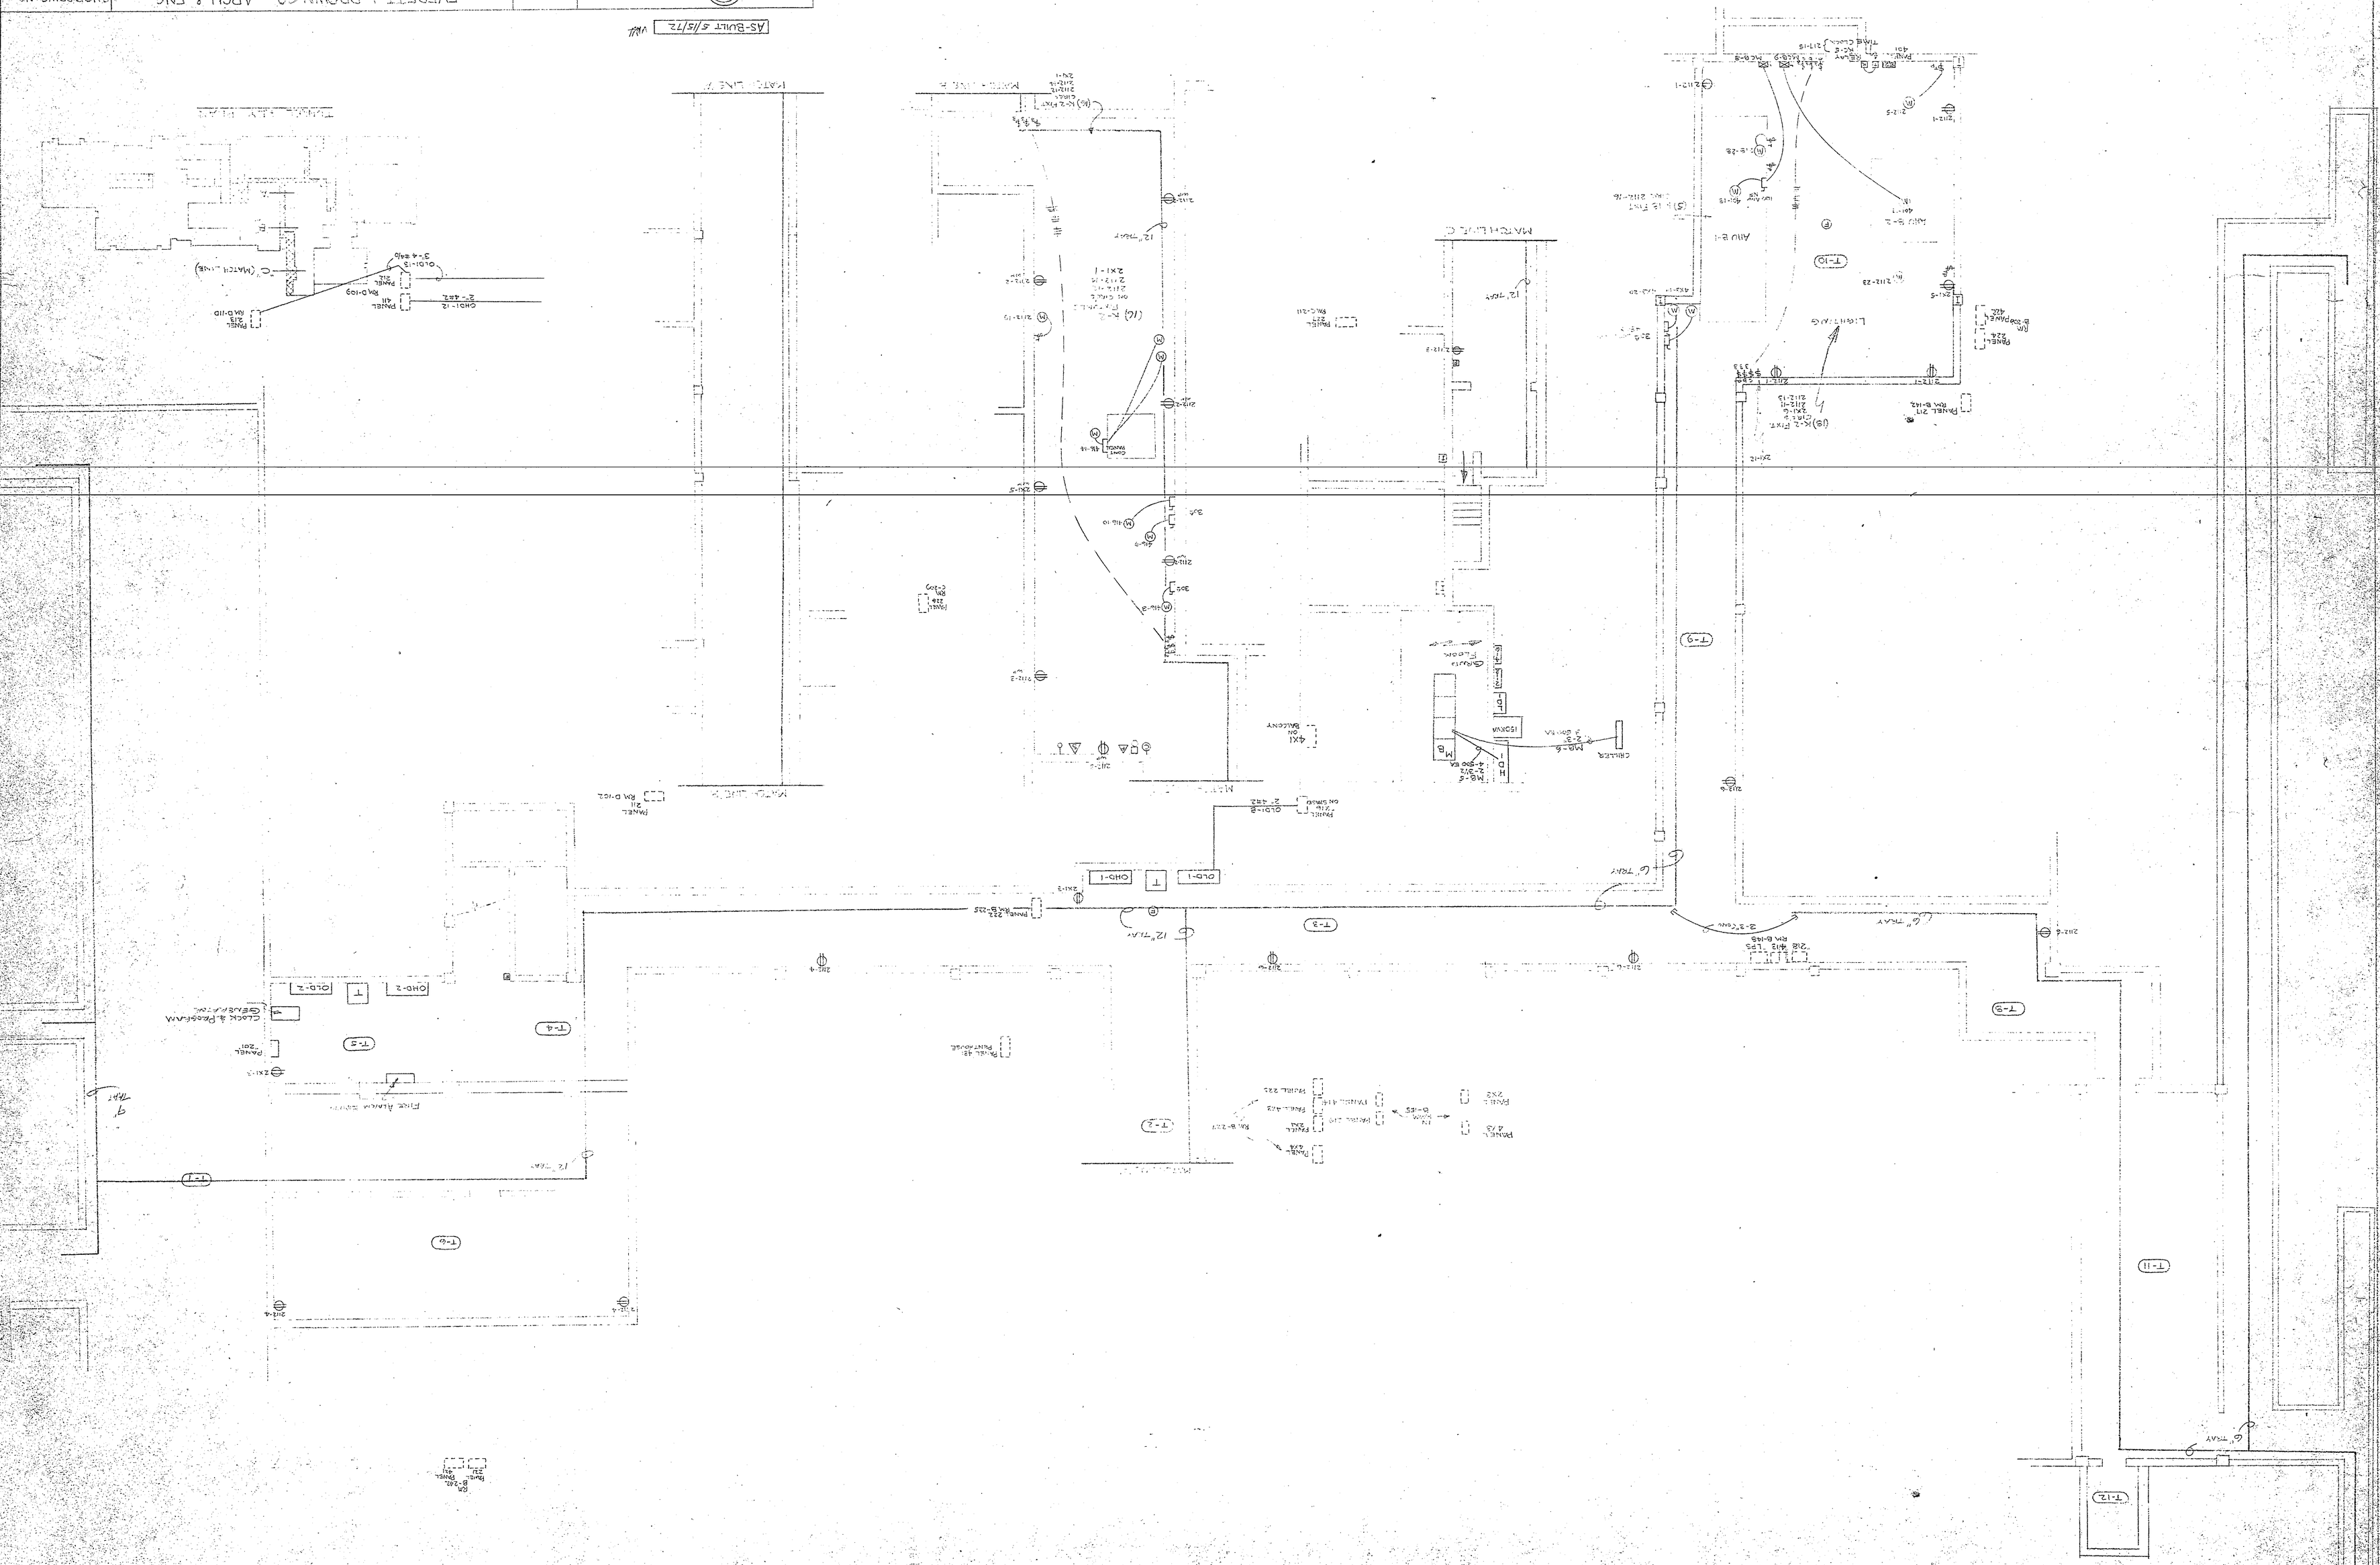
CIRCLE ELECTRIC, INC
CONTRACTOR
PO BOX 130
PORTAGE, IND
1/8" = 1'-0"
DATE: 5/25/70
DRAWN: VWW
AS-BUILT 5/15/72 VWW
EVERETT I. BROWN CO. ARCH. & ENG.
CHESTERTON SENIOR HIGH SCHOOL
SHOP DRWG NO
E-11-SDA
MAIN LINE
MAIN LINE
MAIN LINE