


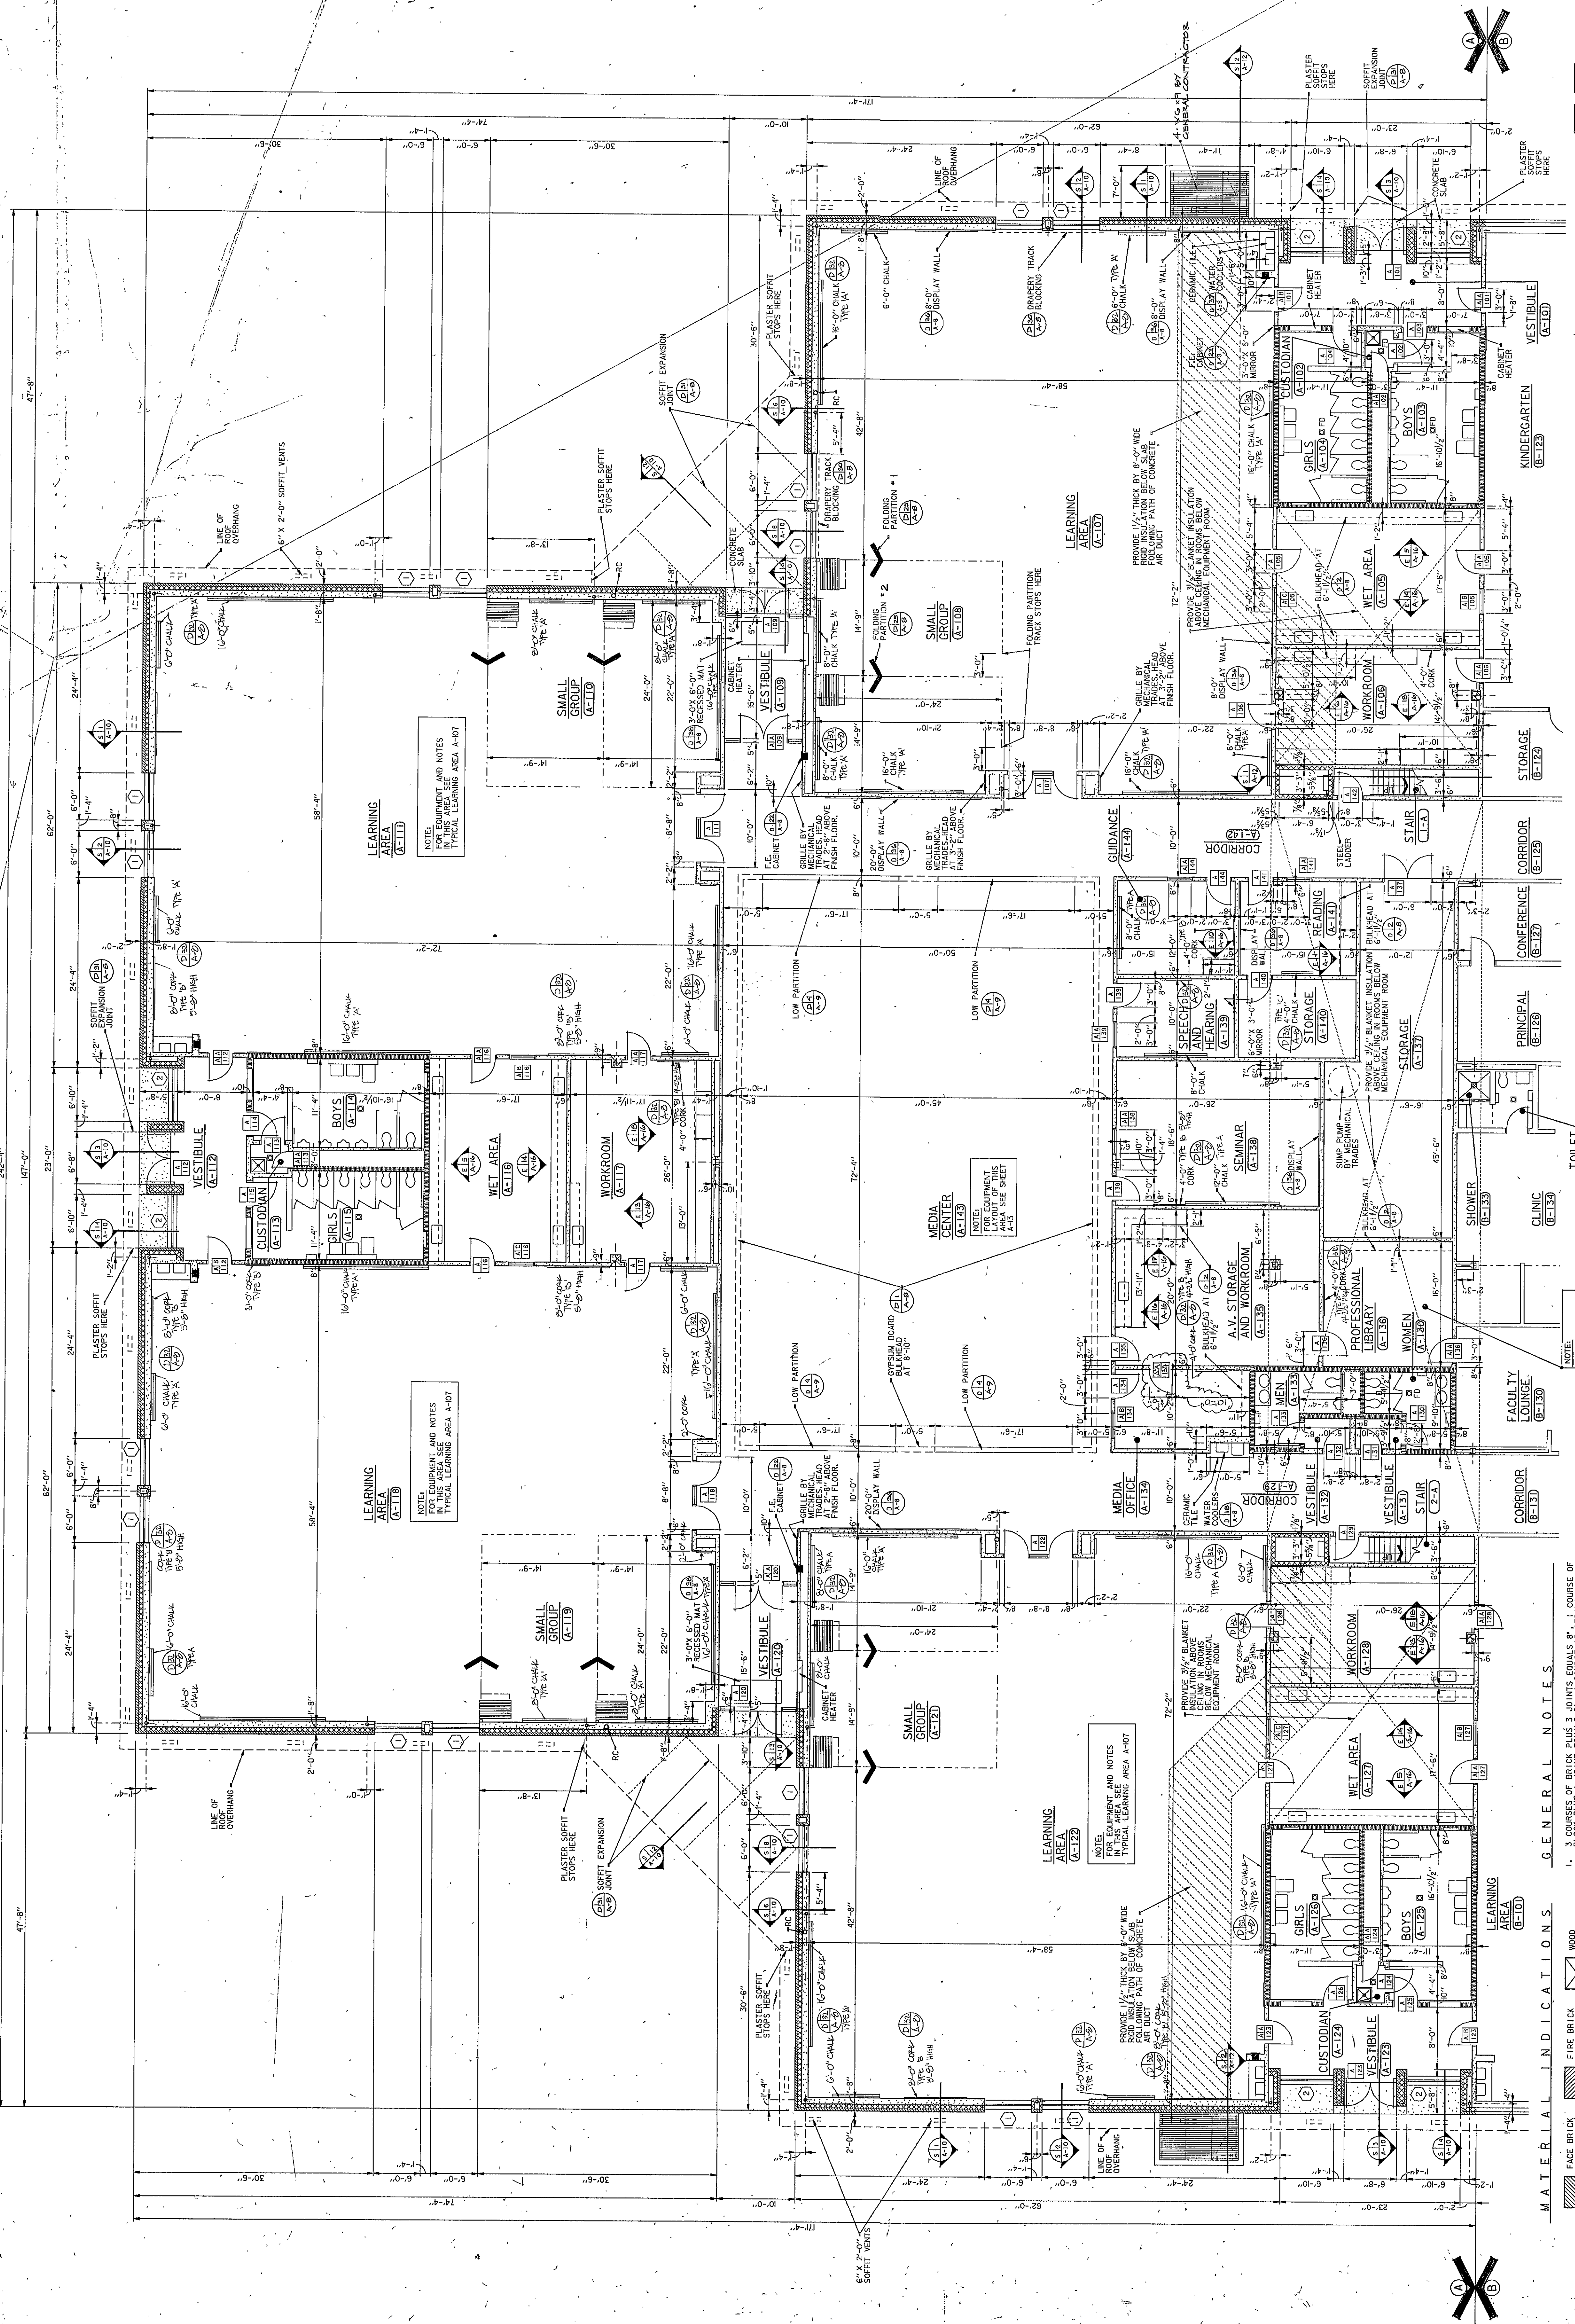

GENERAL NOTES

- 3 COURSES OF BRICK PLUS 3 JOINTS COURSE OF CERAMIC TILE
BLOCK PLUS 3 JOINTS EQUALS 4 1/2" IN. COURSE OF CERAMIC TILE
FINISH FLOOR. JOINTS ARE 1/4" WIDE. JOINTS ARE FORM FINISHED FLOOR
MATERIAL. FINISH FLOOR TILES AND OTHER FINISH FLOOR
MATERIALS SHALL FINISH FLOOR WITH EACH OTHER.
BE 5/4" ABOVE FINISH FLOOR TO EACH OTHER. PANELS ARE TO
PLAN DIMENSIONS TO MATCH WALL DIMENSIONS. BOUGH WALL DIMENSIONS
PARTITIONS ARE FINISH WALL DIMENSIONS. ALL UNIT HANGER RECESSES ARE
ALL CONNECTORS, CAN CLOUT, AND UNIT HANGER RECESSES ARE
ALL CALLED APPROXIMATELY 1/2" ABOVE FINISH FLOOR.
EQUIPMENT SHALL BE 1/2" ABOVE FINISH FLOOR. ALL
CHANGES AND RECESSES REQUIRED FOR MECHANICAL AND ELECTRICAL
EQUIPMENT SHALL BE 1/2" ABOVE FINISH FLOOR. ALL
FOR HUB, DEPTH AND LOCATION. VERTIFIED WITH THE ARCHITECT
MASONRY WALLS BEARING ON A THICKENED SLAB AT SLAB
COURSES BEGINNING AT THE FINISHED FLOOR LINE.

MATERIAL INDICATIONS

- | | | | | | | | | | | | | | | | | | | | | | |
|--|------------|--|----------------|--|----------|--|-------------------------------|--|----------------------------|--|--------------------|--|----------|--|-----------|--|--------|--|-------------|--|-------------------|
| | FACE BRICK | | CONCRETE BLOCK | | CONCRETE | | LIGHTWEIGHT
CONCRETE BLOCK | | PLASTER OR
GYPSUM BOARD | | SOUNDPROOF
WALL | | TERRAZZO | | CUT STONE | | MARBLE | | FINISH WOOD | | WOOD BLOCK LINING |
| | FIRE BRICK | | ELEVATION | | DETAIL | | SECTION | | | | | | | | | | | | | | |