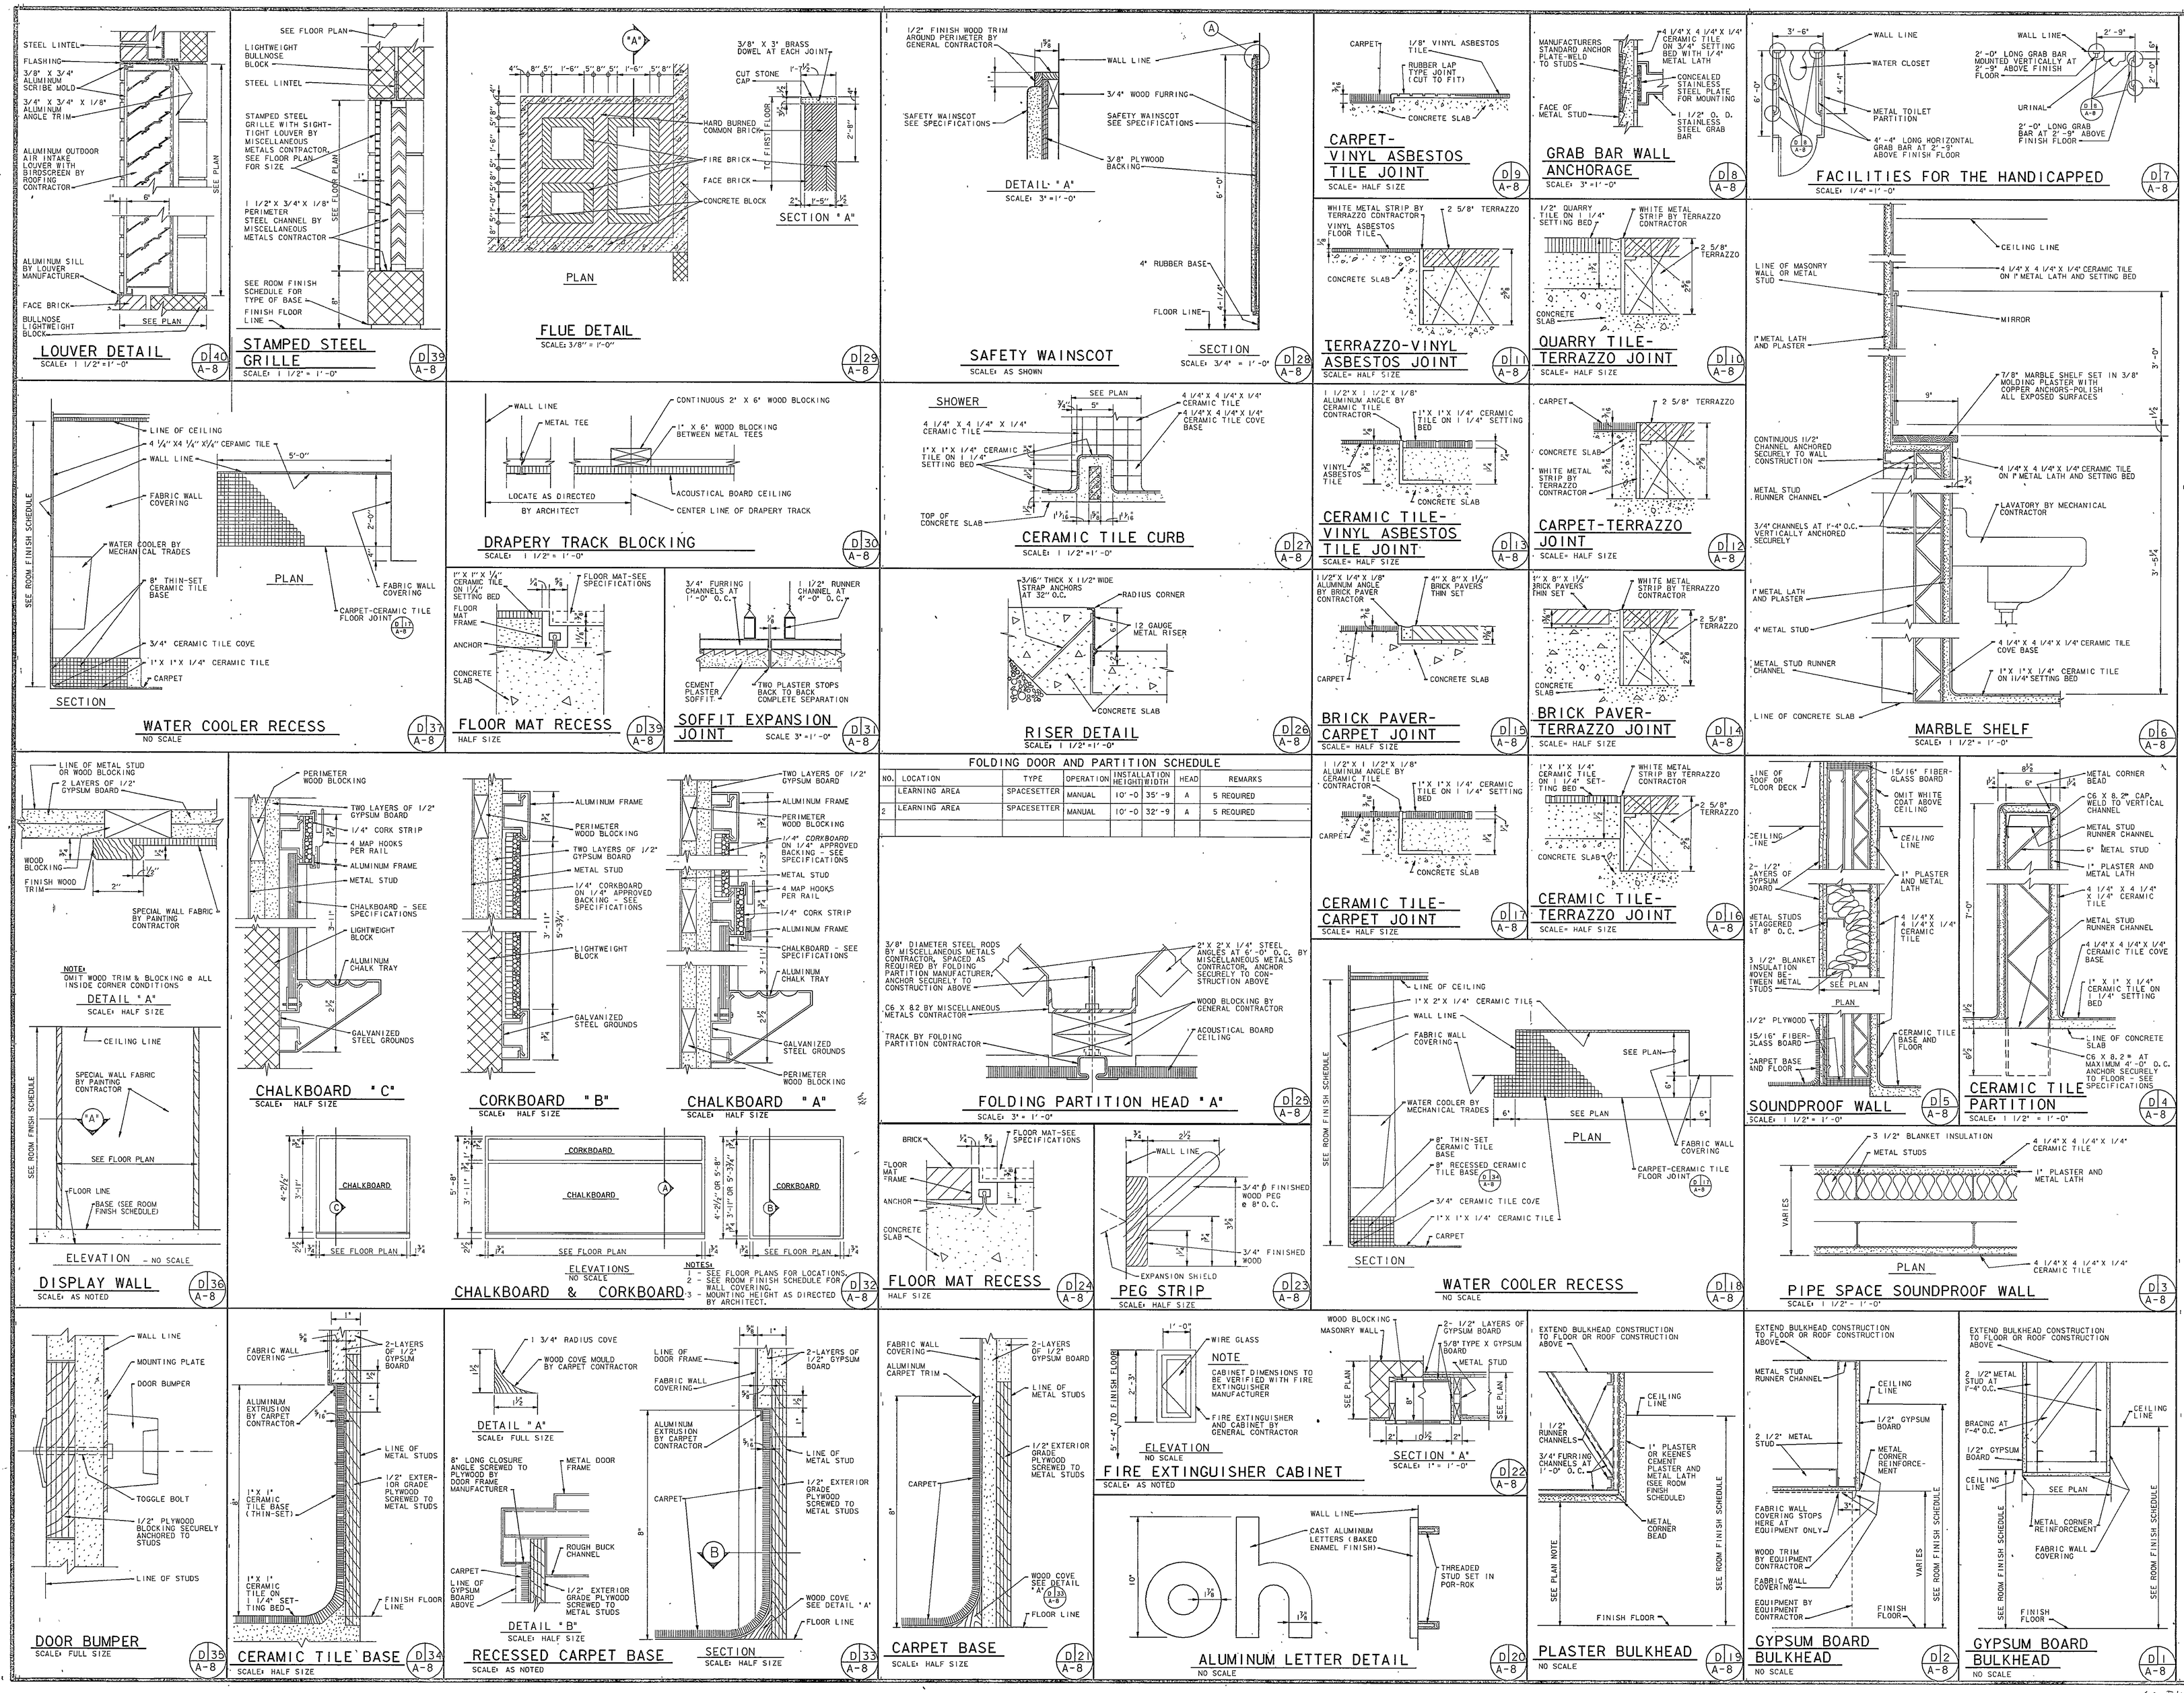

FOLDING DOOR AND PARTITION SCHEDULE

NO.	LOCATION	TYPE	OPERATION	INSTALLATION HEIGHT	WIDTH	HEAD	REMARKS
1	LEARNING AREA	SPACESETTER	MANUAL	10'-0	35'-9	A	5 REQUIRED
2	LEARNING AREA	SPACESETTER	MANUAL	10'-0	32'-9	A	5 REQUIRED

EVERETT I. BROWN COMPANY
ARCHITECTS ENGINEERS
• INDIANAPOLIS, INDIANA • 46241
• PARK FLETCHER •

5500 WEST BRADBURY AVENUE
JACKSON ELEMENTARY SCHOOL

REGISTERED ARCHITECT NO. 2345 STATE OF INDIANA

PROJECT 12513.00	DATE MAY 3, 1982	REVISED

NO. A-8
OF 49

82-A-08

AS BUILTS OCT. 22 1984