

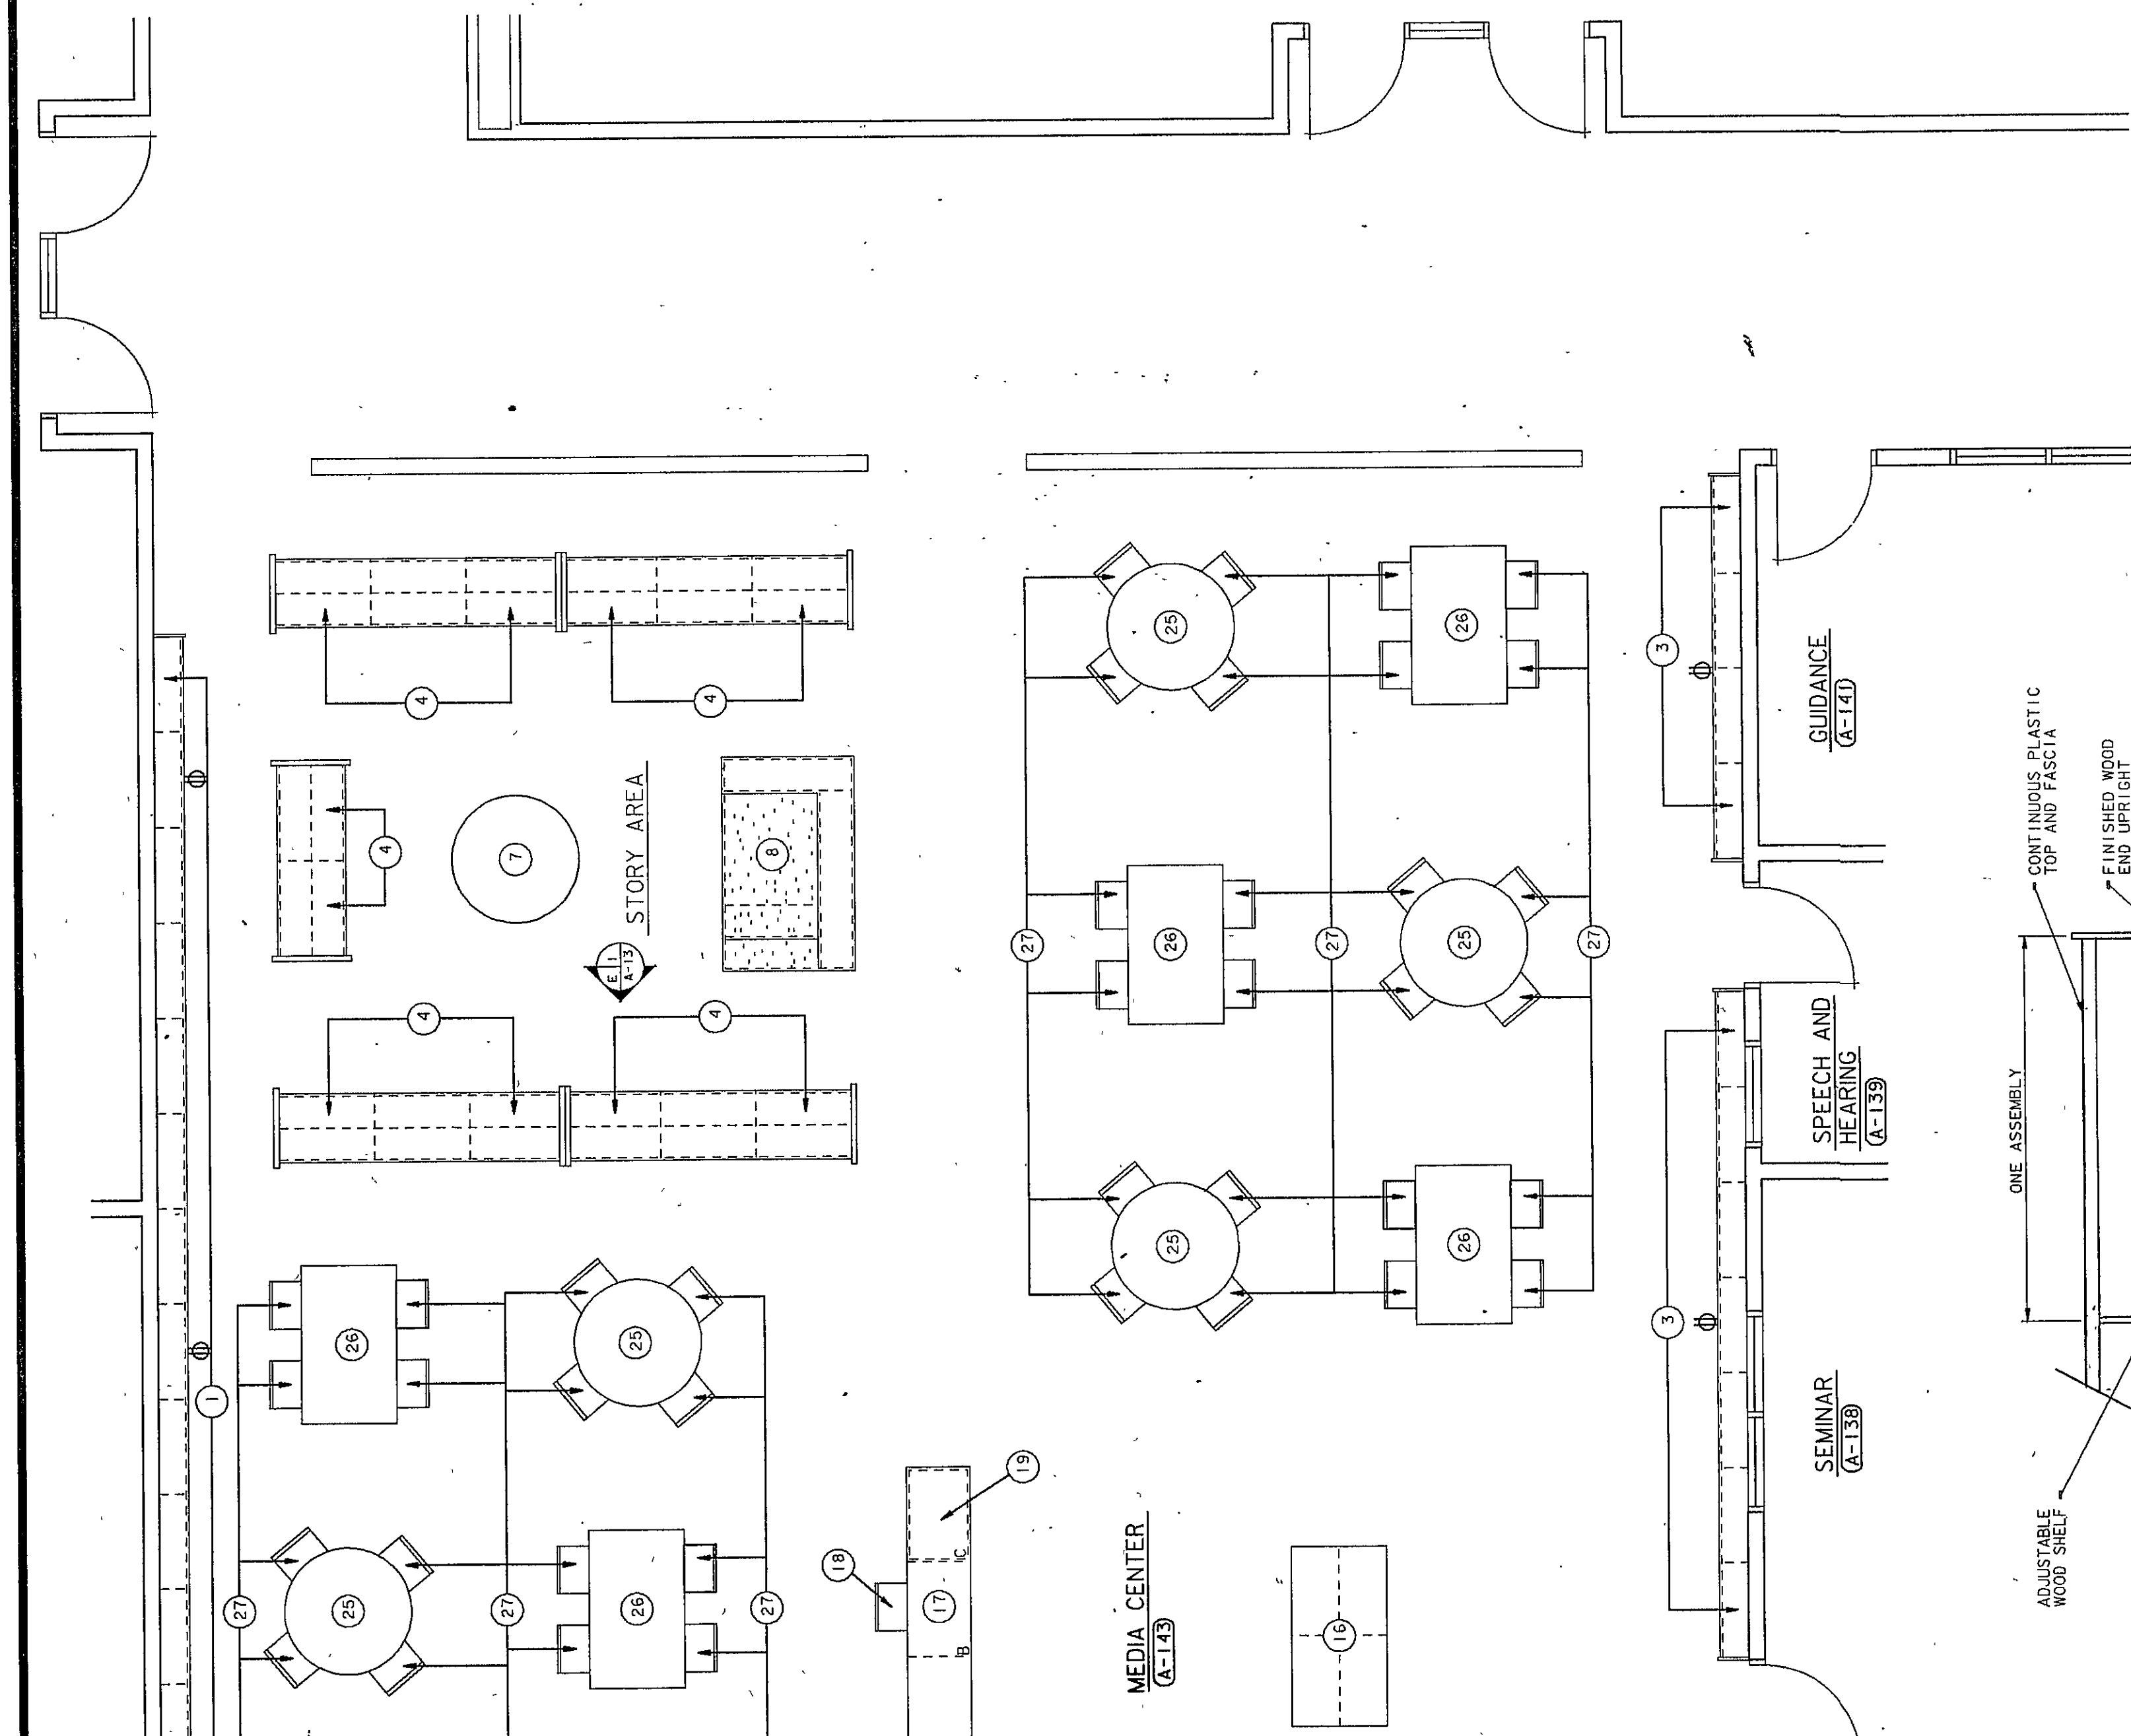


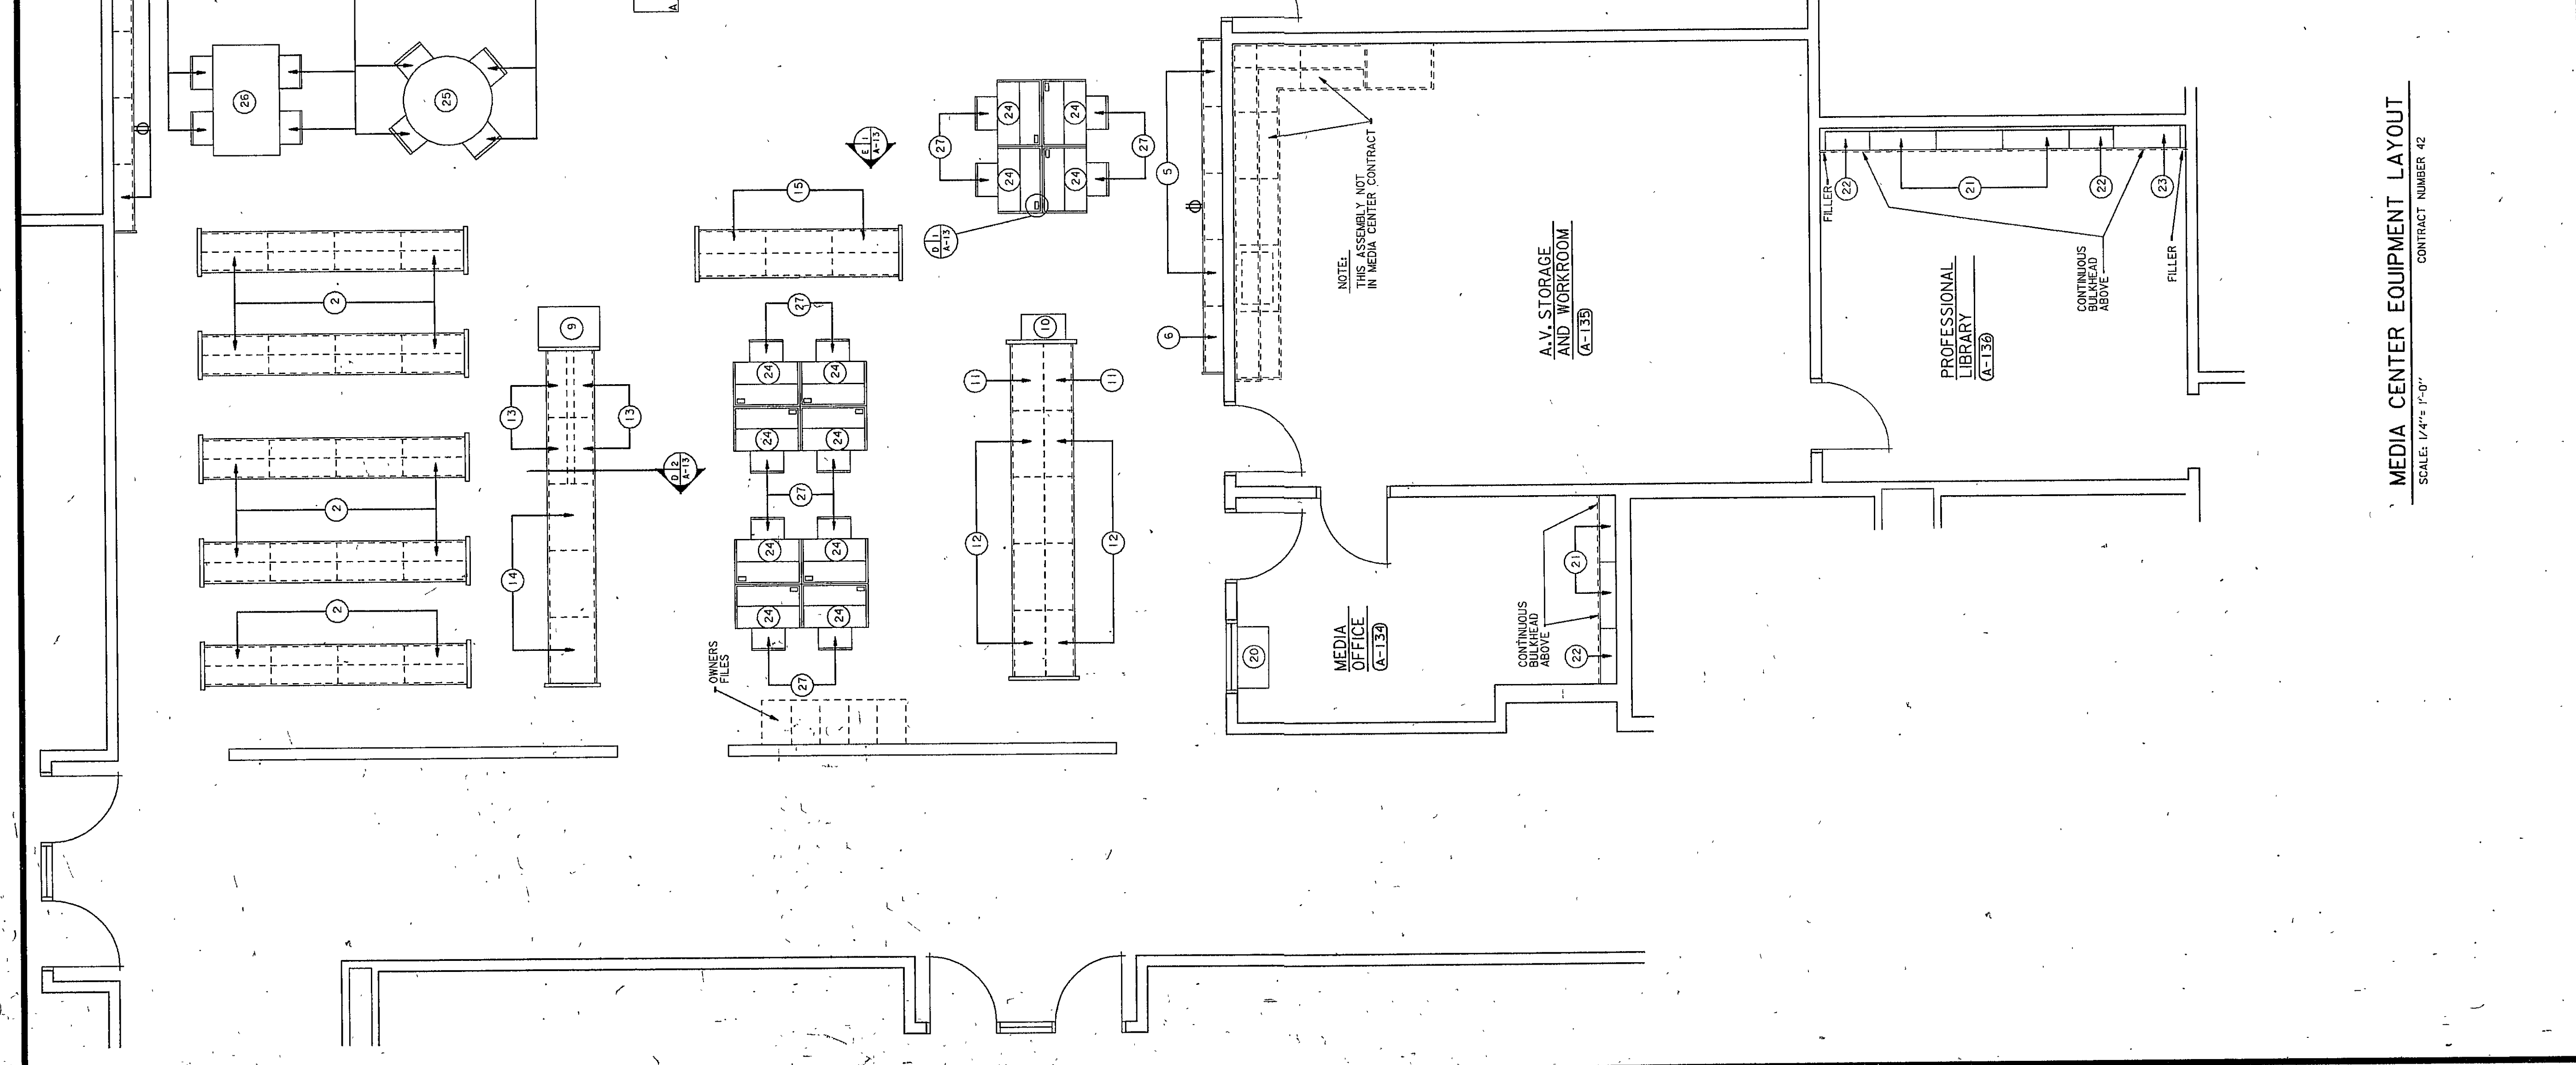

ITEM NO.	CATALOG NUMBER	DESCRIPTION	REQ. NO.
16.		80 TRAY CARD CATALOG WITH	
17.		CHARGING DESK WITH	
18.	77-46	SWIVEL CHAIR WITH WOOD SEAT AND BACK	1
19.	75-46	20 TRAY CARD CATALOG WITH	
20.		A. 30W-26B HIGH BASE B. 30W-26B TEN TRAY UNIT C. 30W-26B PLASTIC TOP	2
21.	C-820	6'-0" HIGH X 10" DEEP WALL BOOKSHELVING	5
22.	C-820 MODIFIED	6'-0" HIGH X 10" DEEP WALL BOOKSHELVING	3
23.	C-822-MB	MODULAR STUDY CARREL 26" HIGH AT WORK SURFACE WITH	12
24.	90W-2436TH	ONE DUPLEX CONVENIENCE OUTLET MOUNTED FLUSH IN EACH UNIT WITH ONE 3'-0" X 4'-0" X 3'-0" COILED CORD AND ONE 3'-0" X 4'-0" X 3'-0" COILED CORD. H. GAUGE TYPE 50.	
25.	90W-48	CONTINUOUS PLASTIC TOP AND FINISHED WOOD EDGE	6
26.	90W-3660	CONTINUOUS PLASTIC LAMINATE TOP AND FINISHED WOOD EDGE	6
27.	93	READING CHAIR WITH WOOD BACK AND 8" HIGH SEAT	52

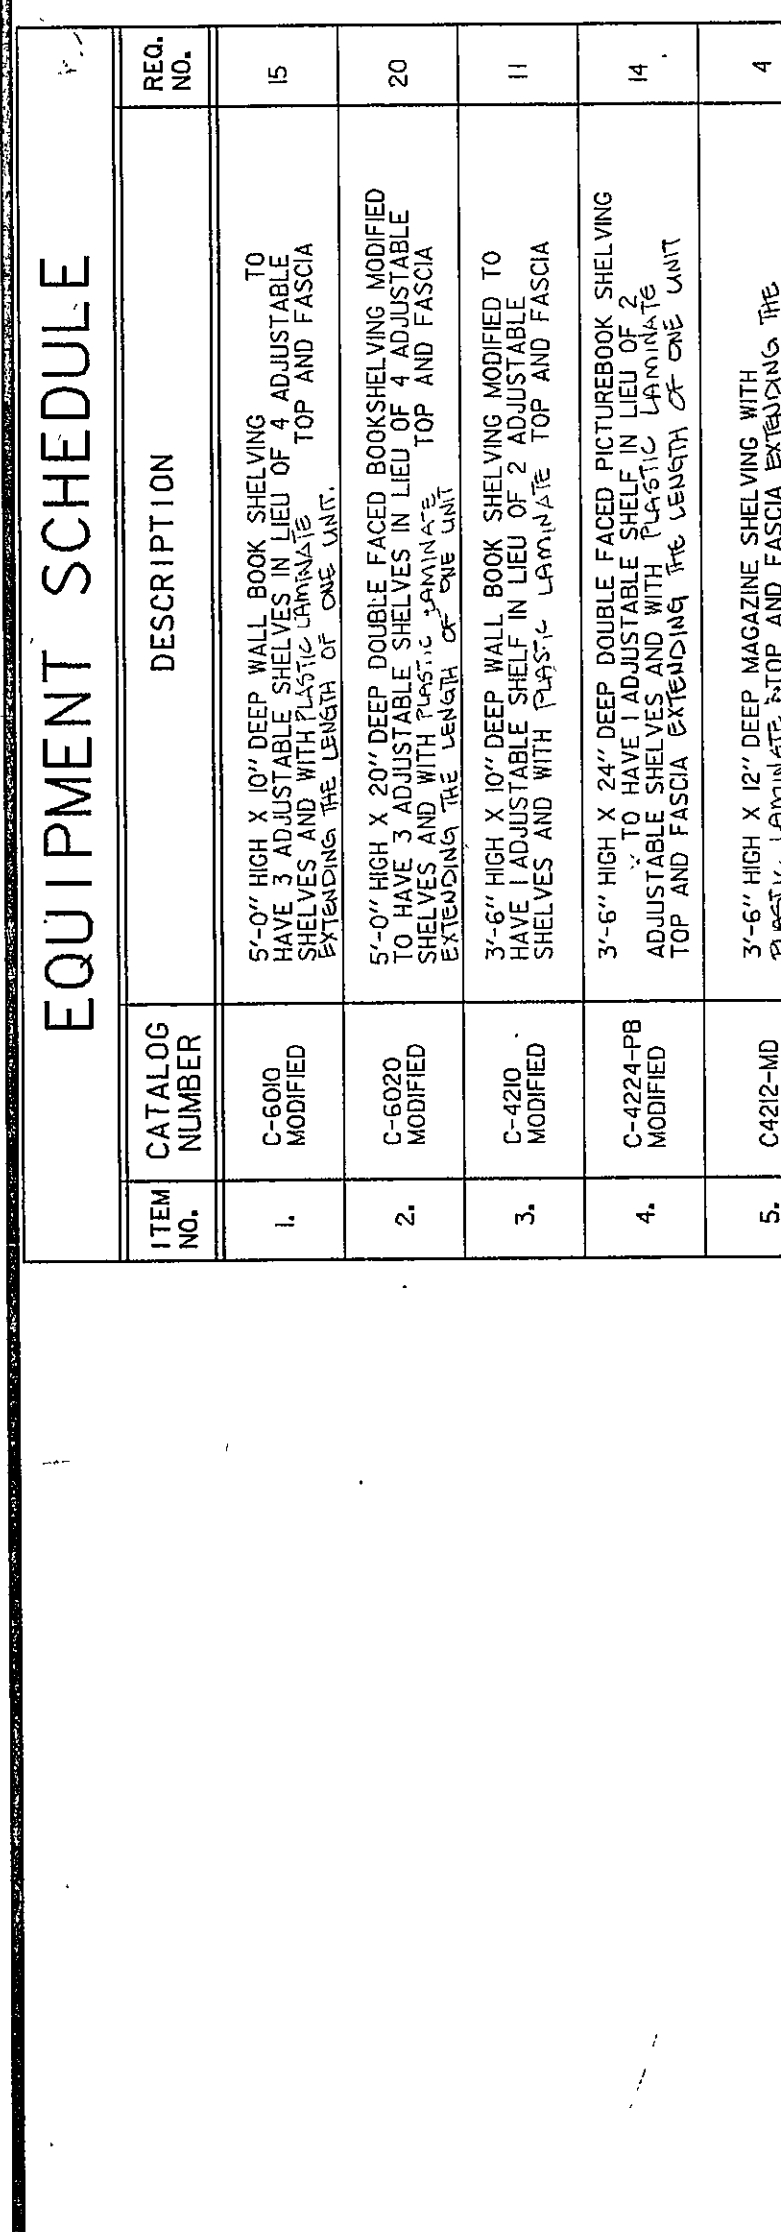

EQUIPMENT SCHEDULE

ARCHITECTS
EVERETT · I · BROWN COMPANY
ENGINEERS
INDIANAPOLIS, INDIANA • 46241

5500 WEST BRADBURY AVENUE • PARK FLETCHER
JACKSON ELEMENTARY SCHOOL

PROJECT 12579.00
DATE MAY 3, 1982
REVISED

NO. A-13
OF 49
92-A-13

KEY PLAN
NO SCALE