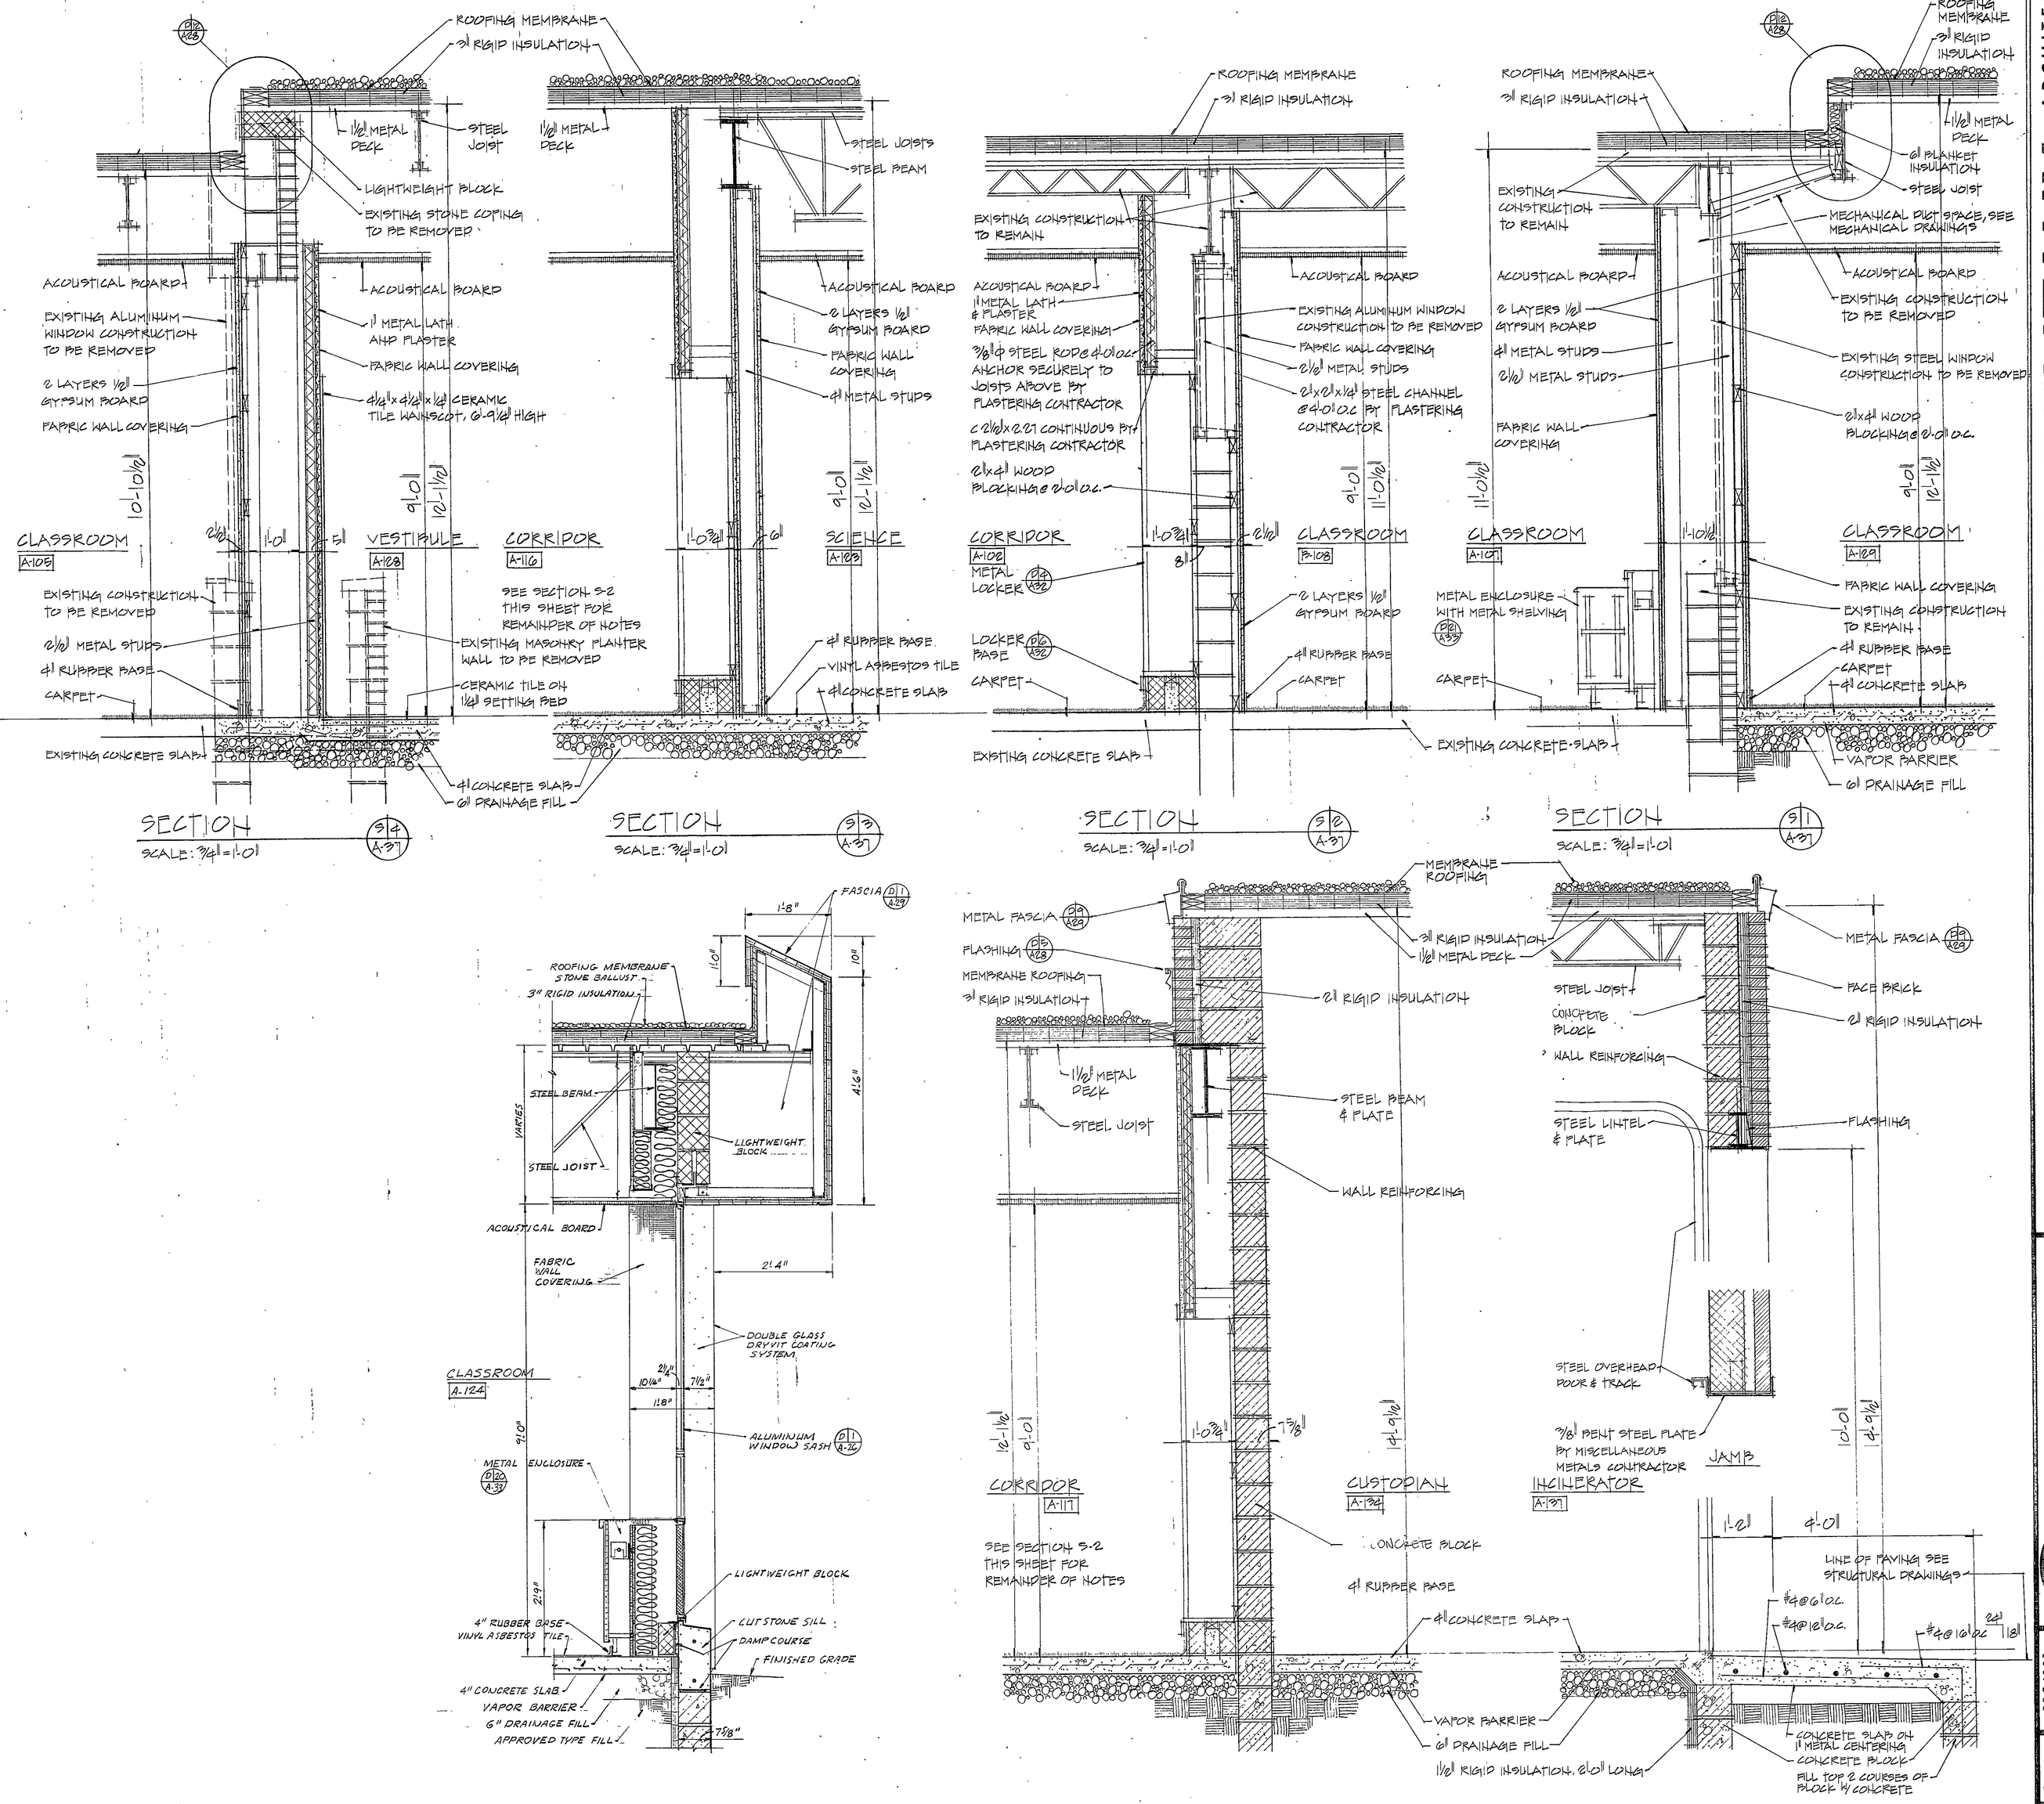

R-25

EVERETT · I · BROWN COMPANY ARCHITECTS ENGINEERS
• PARK FLETCHER • • INDIANAPOLIS, INDIANA • 46241

© EVERETT I. BROWN COMPANY

EVERETT · I · BROWN COMPANY
5500 WEST BRADBURY AVENUE •
ADDITION TO AND RENOVATION OF LIBERTY MIDDLE SCHOOL

REGISTERED ARCHITECT GERALD B. LUDLOW NO. 2345 STATE OF INDIANA

PROJECT	DATE	REVISED
12579.00	MAY 3, 1982	

NO. A-37
OF 49

82-A-21

AS BUILTS OCT 23 1984