



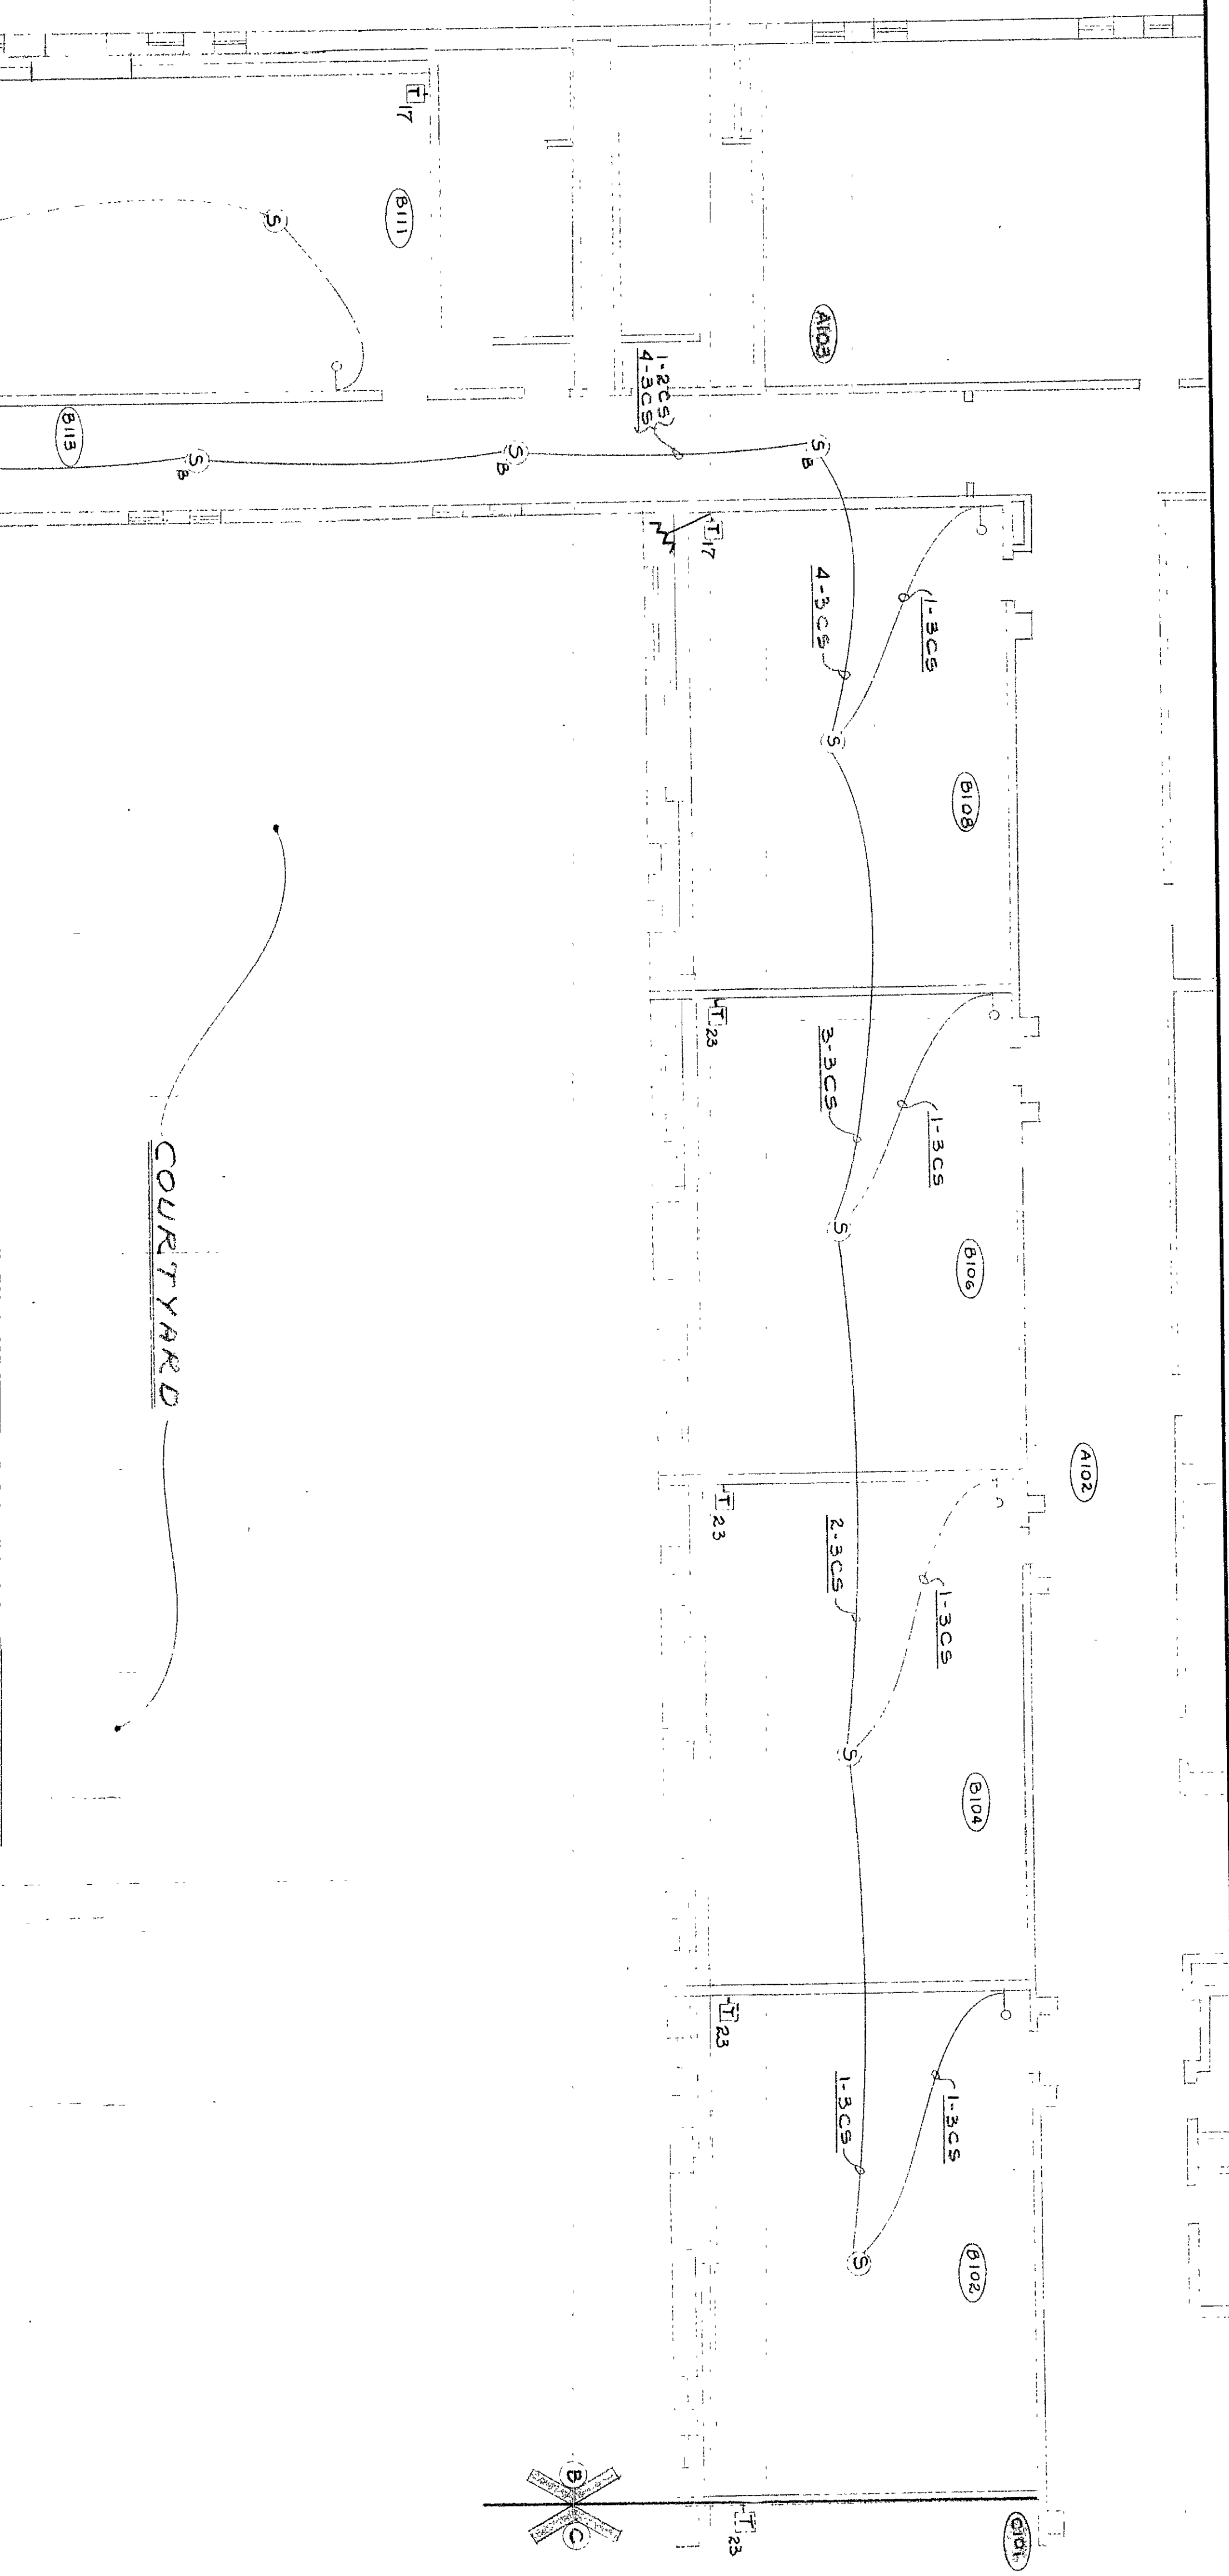

Room Designations

- B113 B127 CORRIDOR
- B114 TEACHERS' LOUNGE
- B126 SEMINAR


FOR GENERAL NOTES, SEE SHEET #1
FOR SYMBOL LEGEND AND CABLE LEGEND, SEE SHEET #3

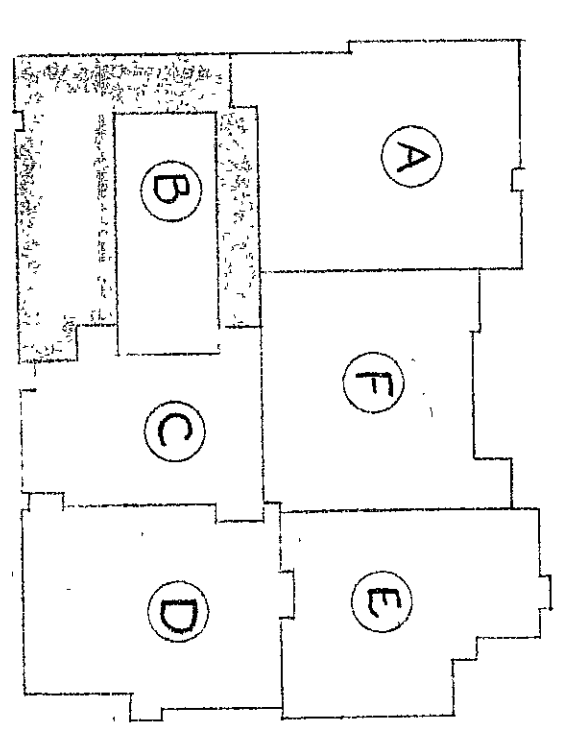

APPROVED
AS NOTED
DEC 08 1982
EVERETT I. BROWN CO.
BY *[Signature]*

B' AREA PLAN

SCALE: 1/8" = 1'-0"

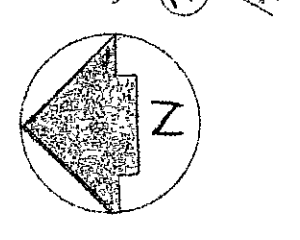

ELECTRONIC SERVICE CO., INC.	
SOUTH BEND, INDIANA	
DATE:	APPROVED BY:
SCALE: AS NOTED	DRAWN BY: JCL
LIBERTY MIDDLE SCHOOL	
CHESTERSTON, INDIANA	
DRAWING NUMBER: H-92038-L	
SOUND / TV SYSTEMS WIRING / CONDUIT	