



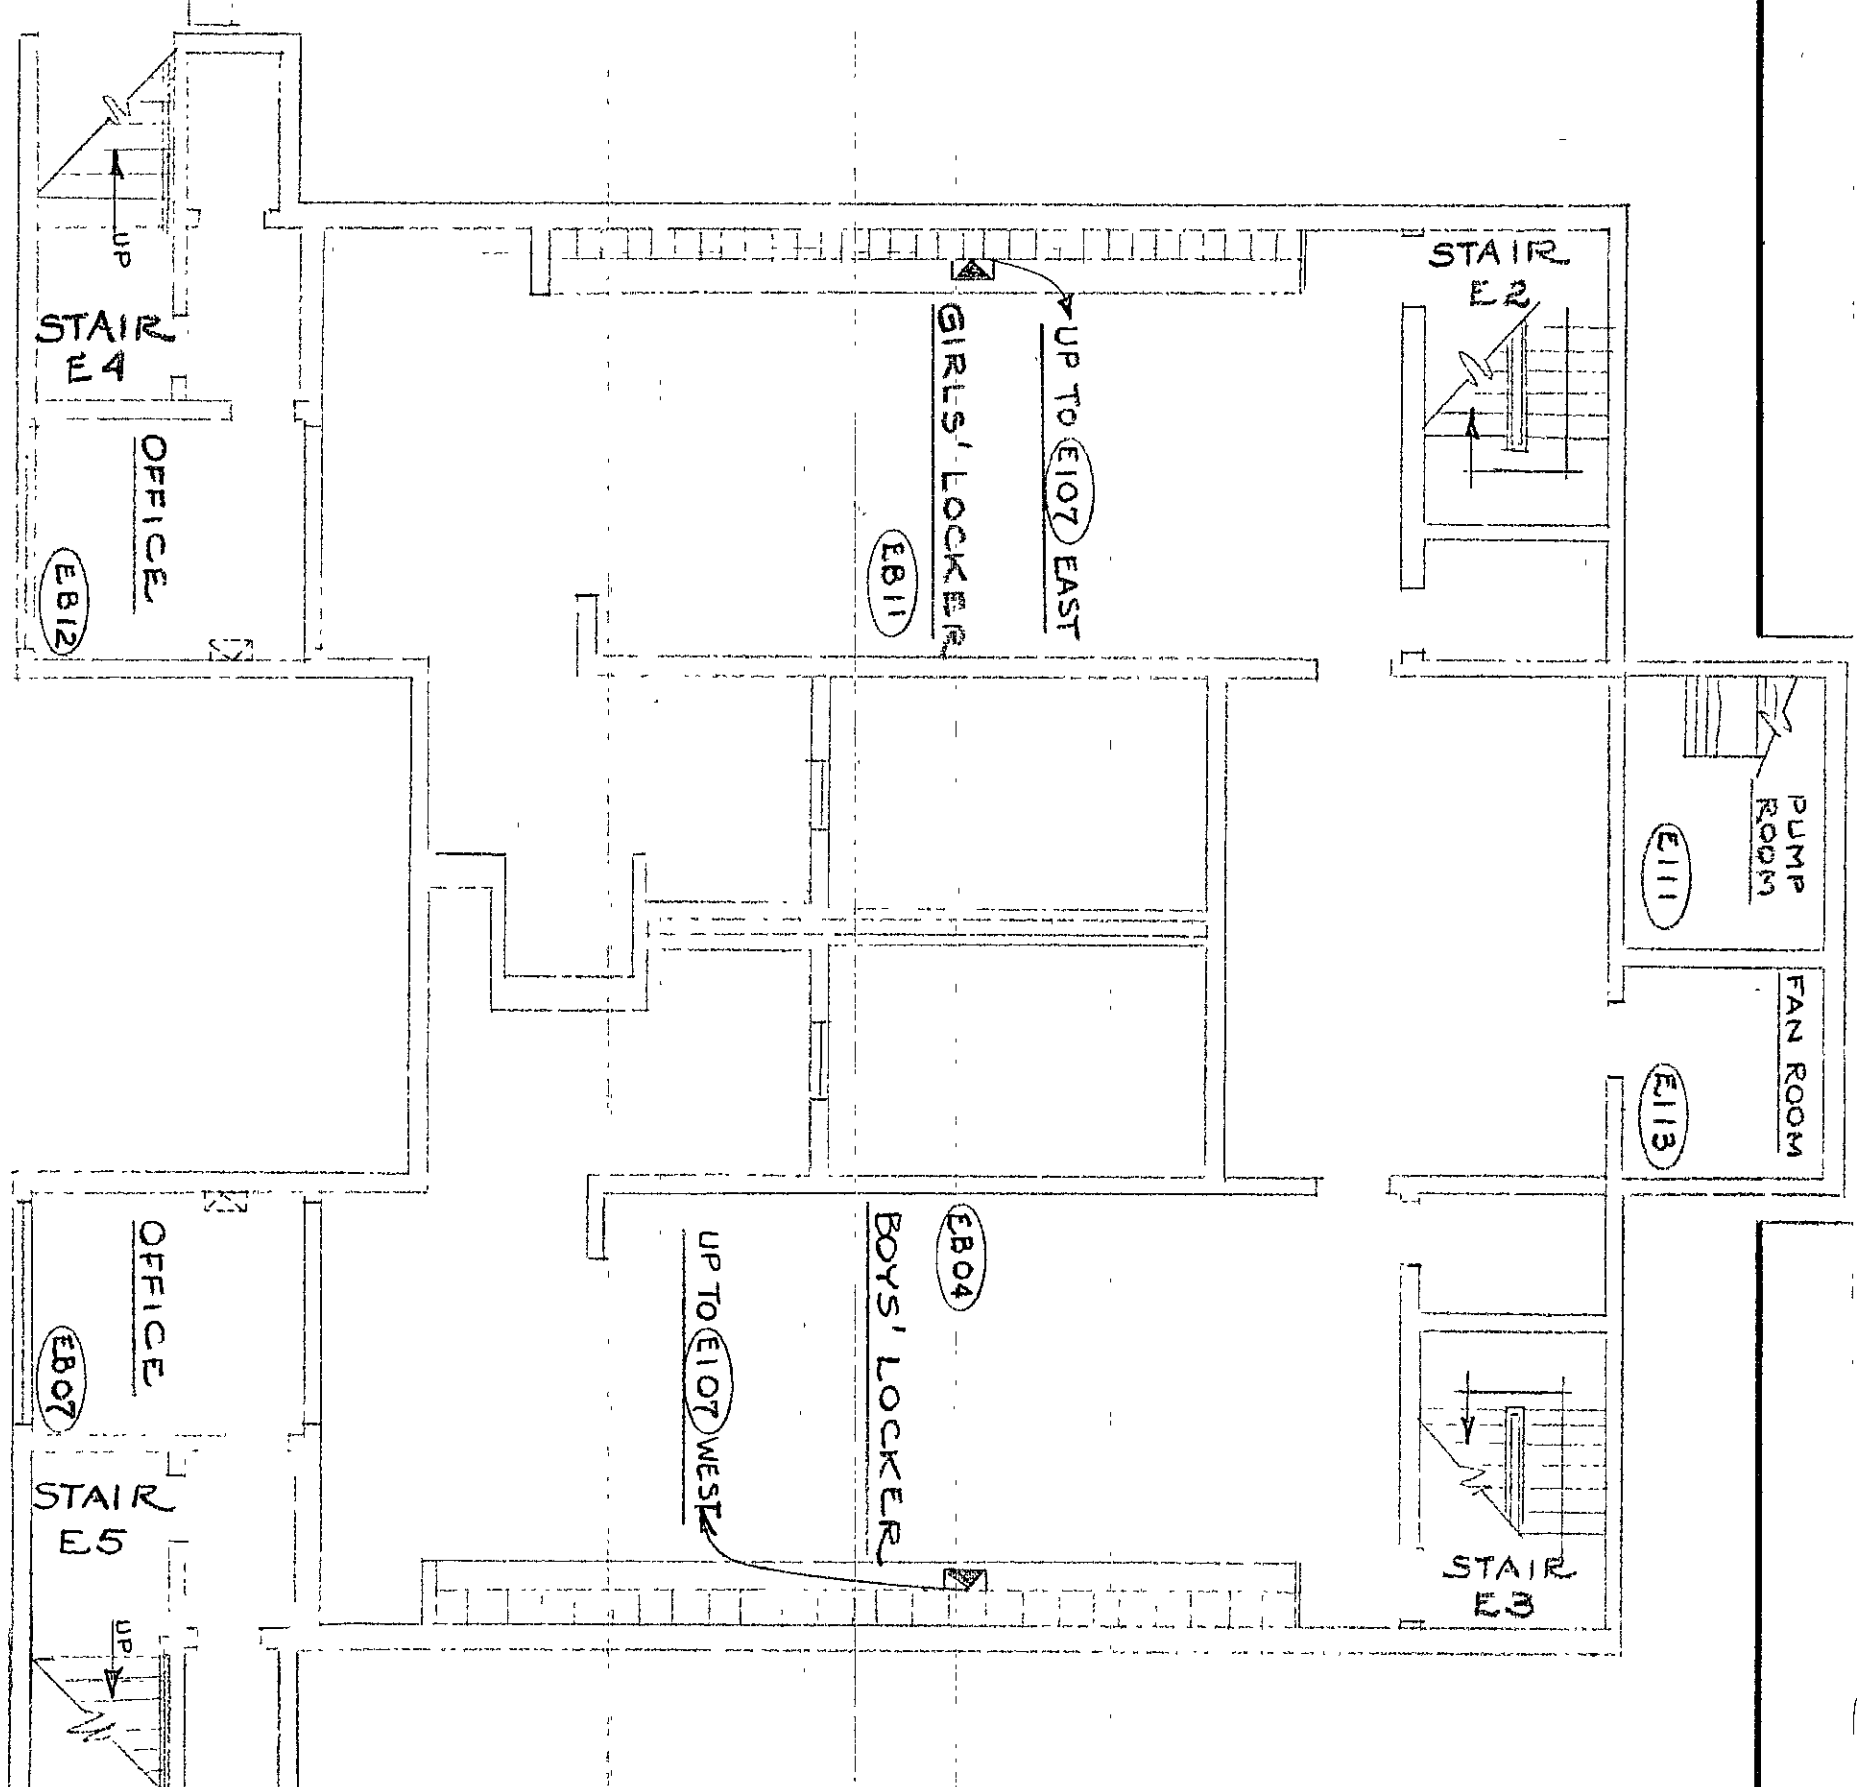


AREA 'E' BASEMENT PLAN
SCALE: 1/8"=1'-0"

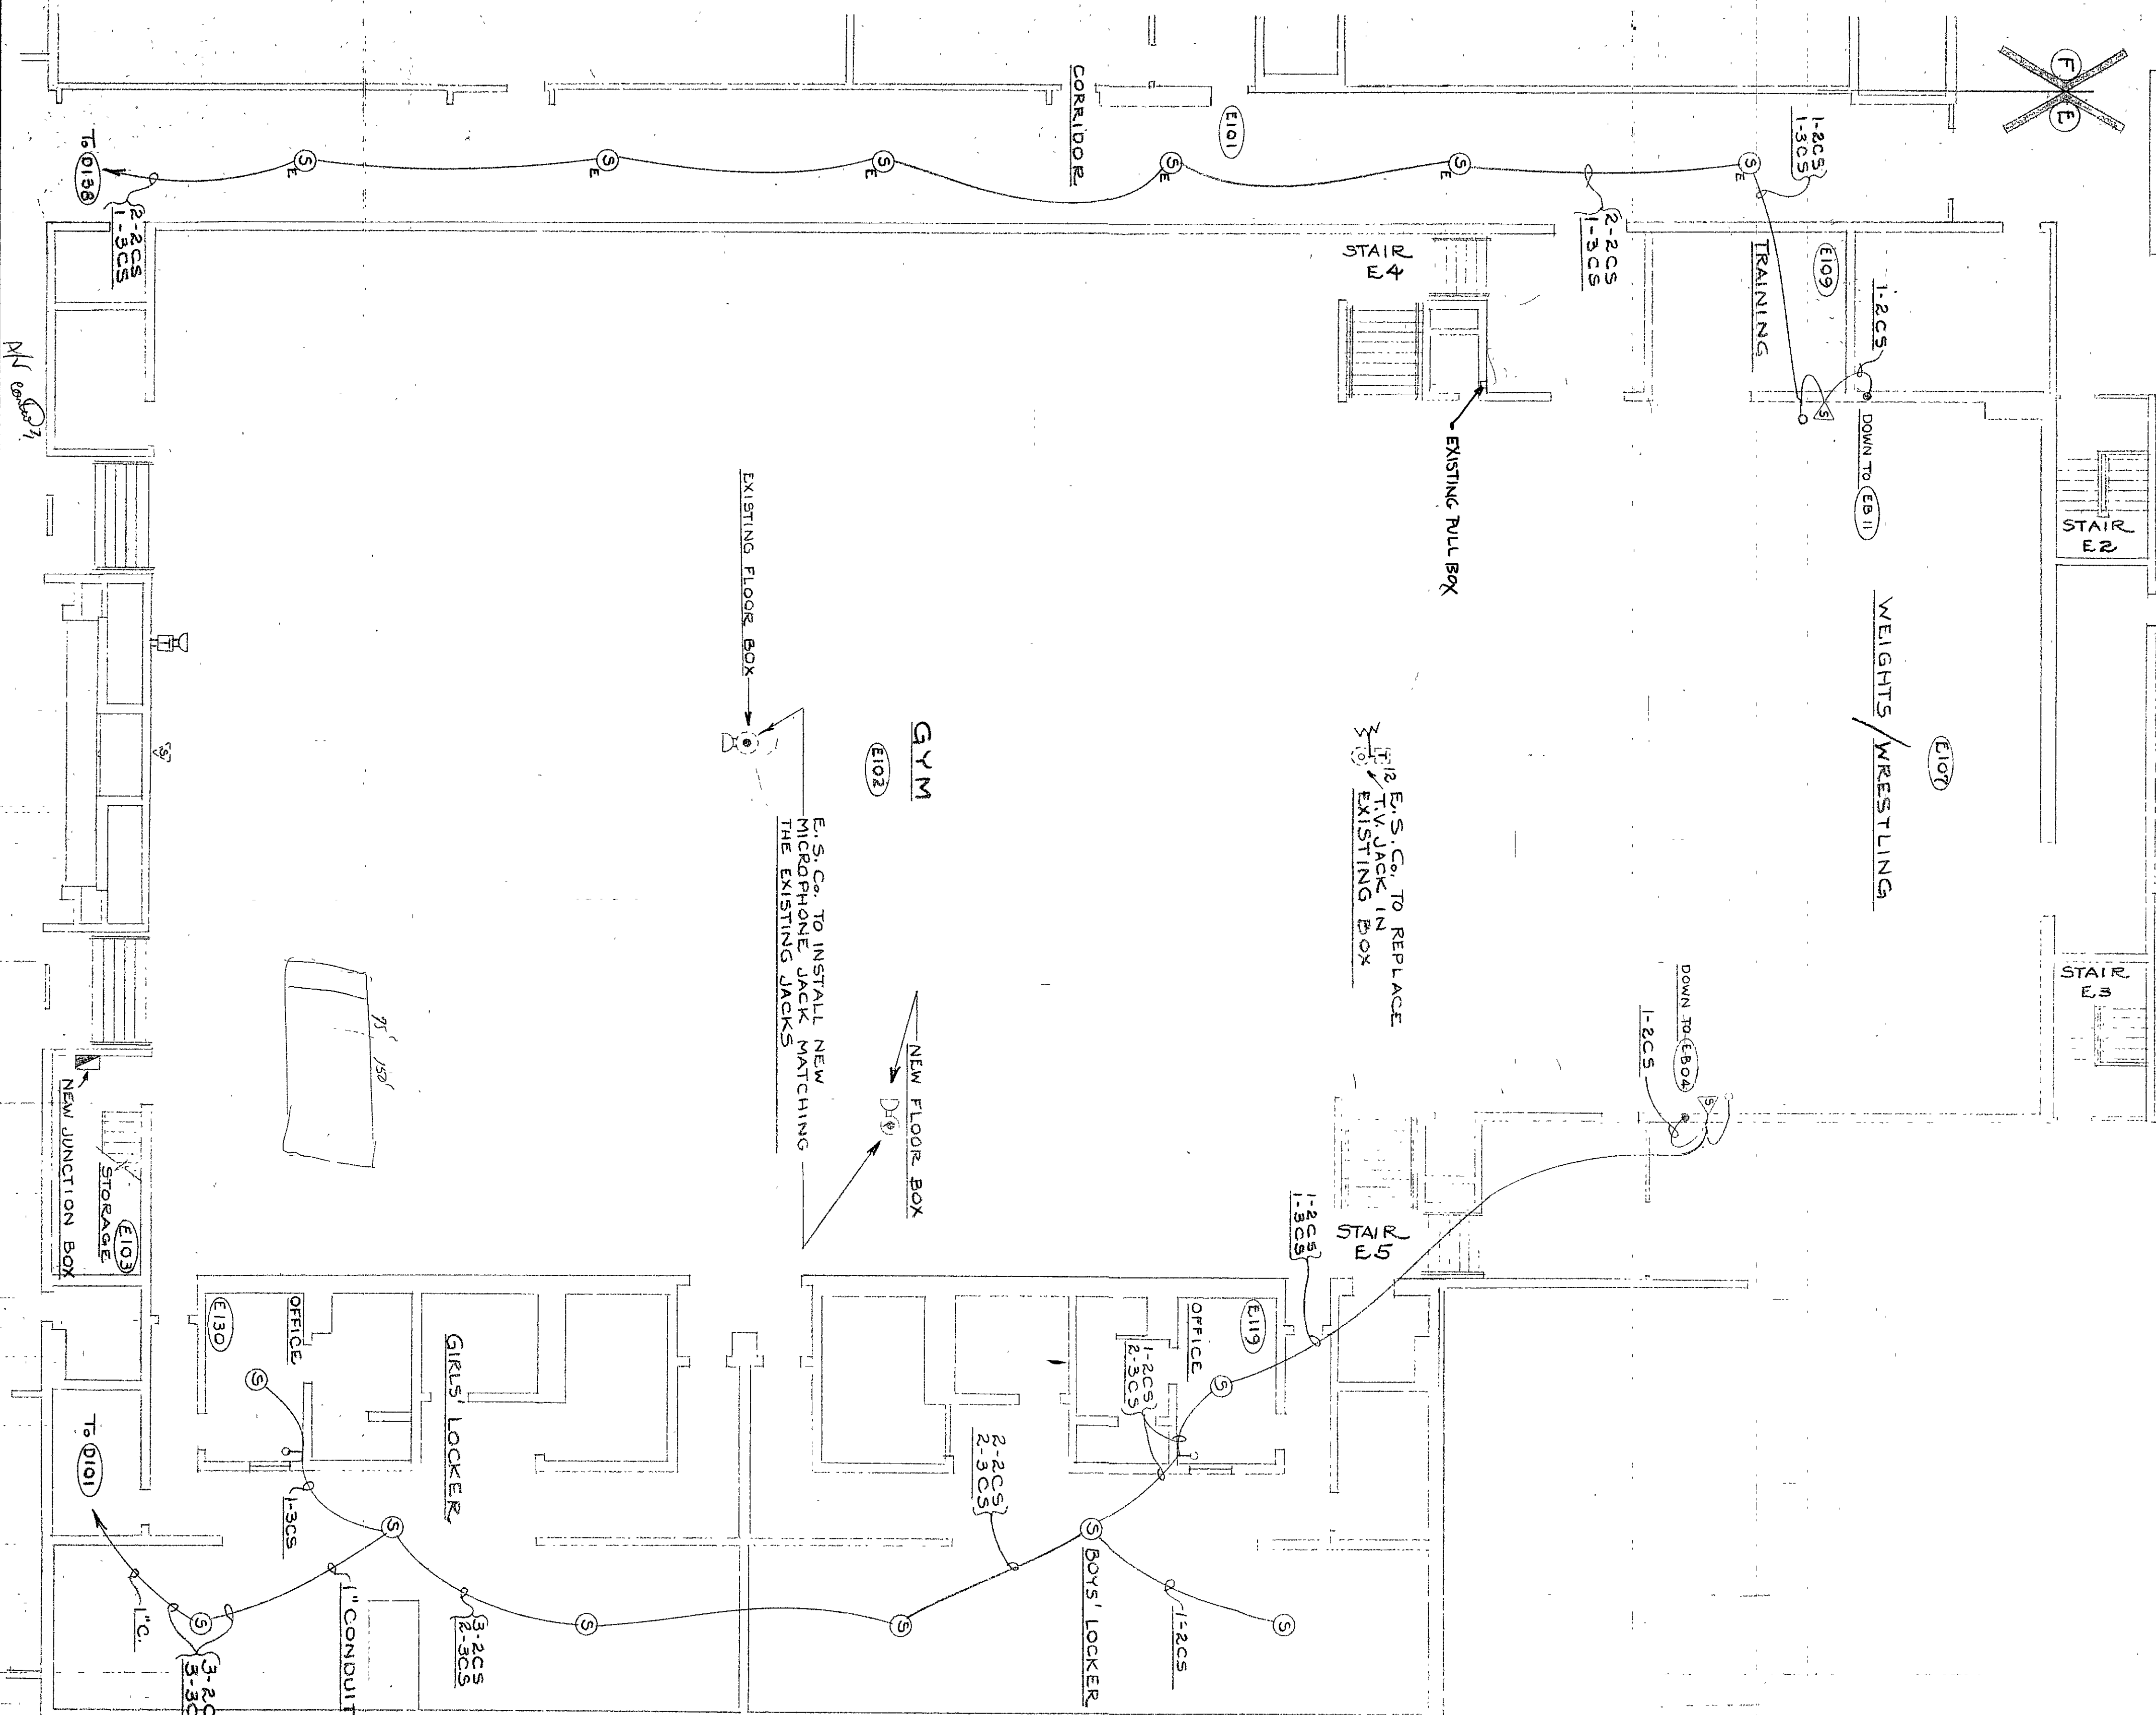

AREA 'E' FLOOR PLAN

APPROVED
AS NOTED
DEC 08 1982
BY *[Signature]*
EVERETT I. BROWN CO.

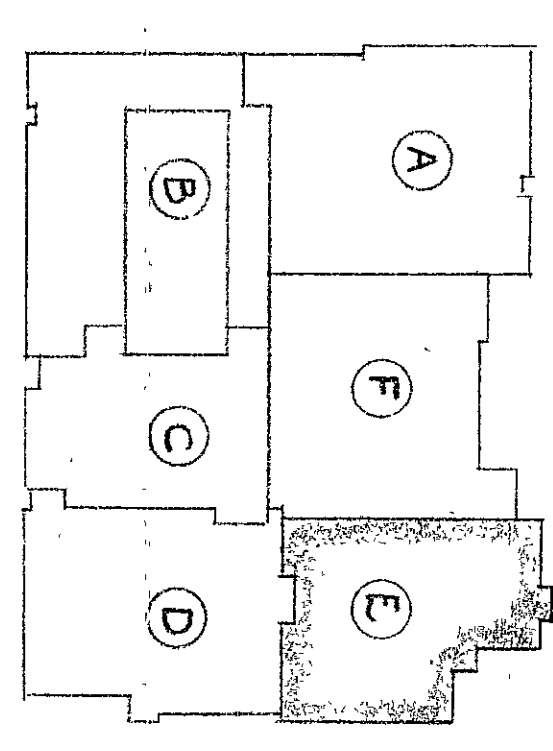

SEE SHEET #3 FOR SYMBOL LEGEND AND
CABLE LEGEND
SEE SHEET #1 FOR GENERAL NOTES

LIBERTY MIDDLE SCHOOL
CHESTERBON
SOUND TV SYSTEMS CONDUIT WIRING
DRAWN BY JCK
DATE
SOUTH BEND INDIANA 46708-0000