

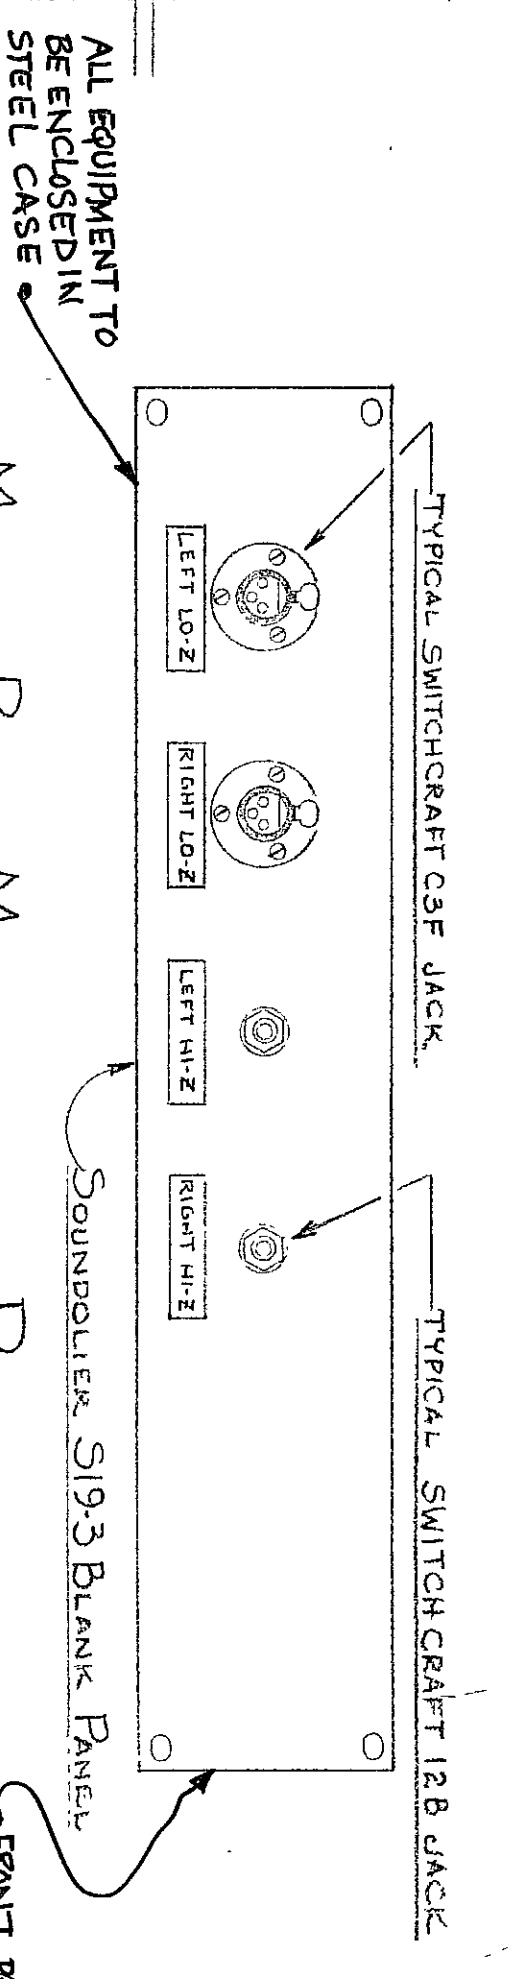
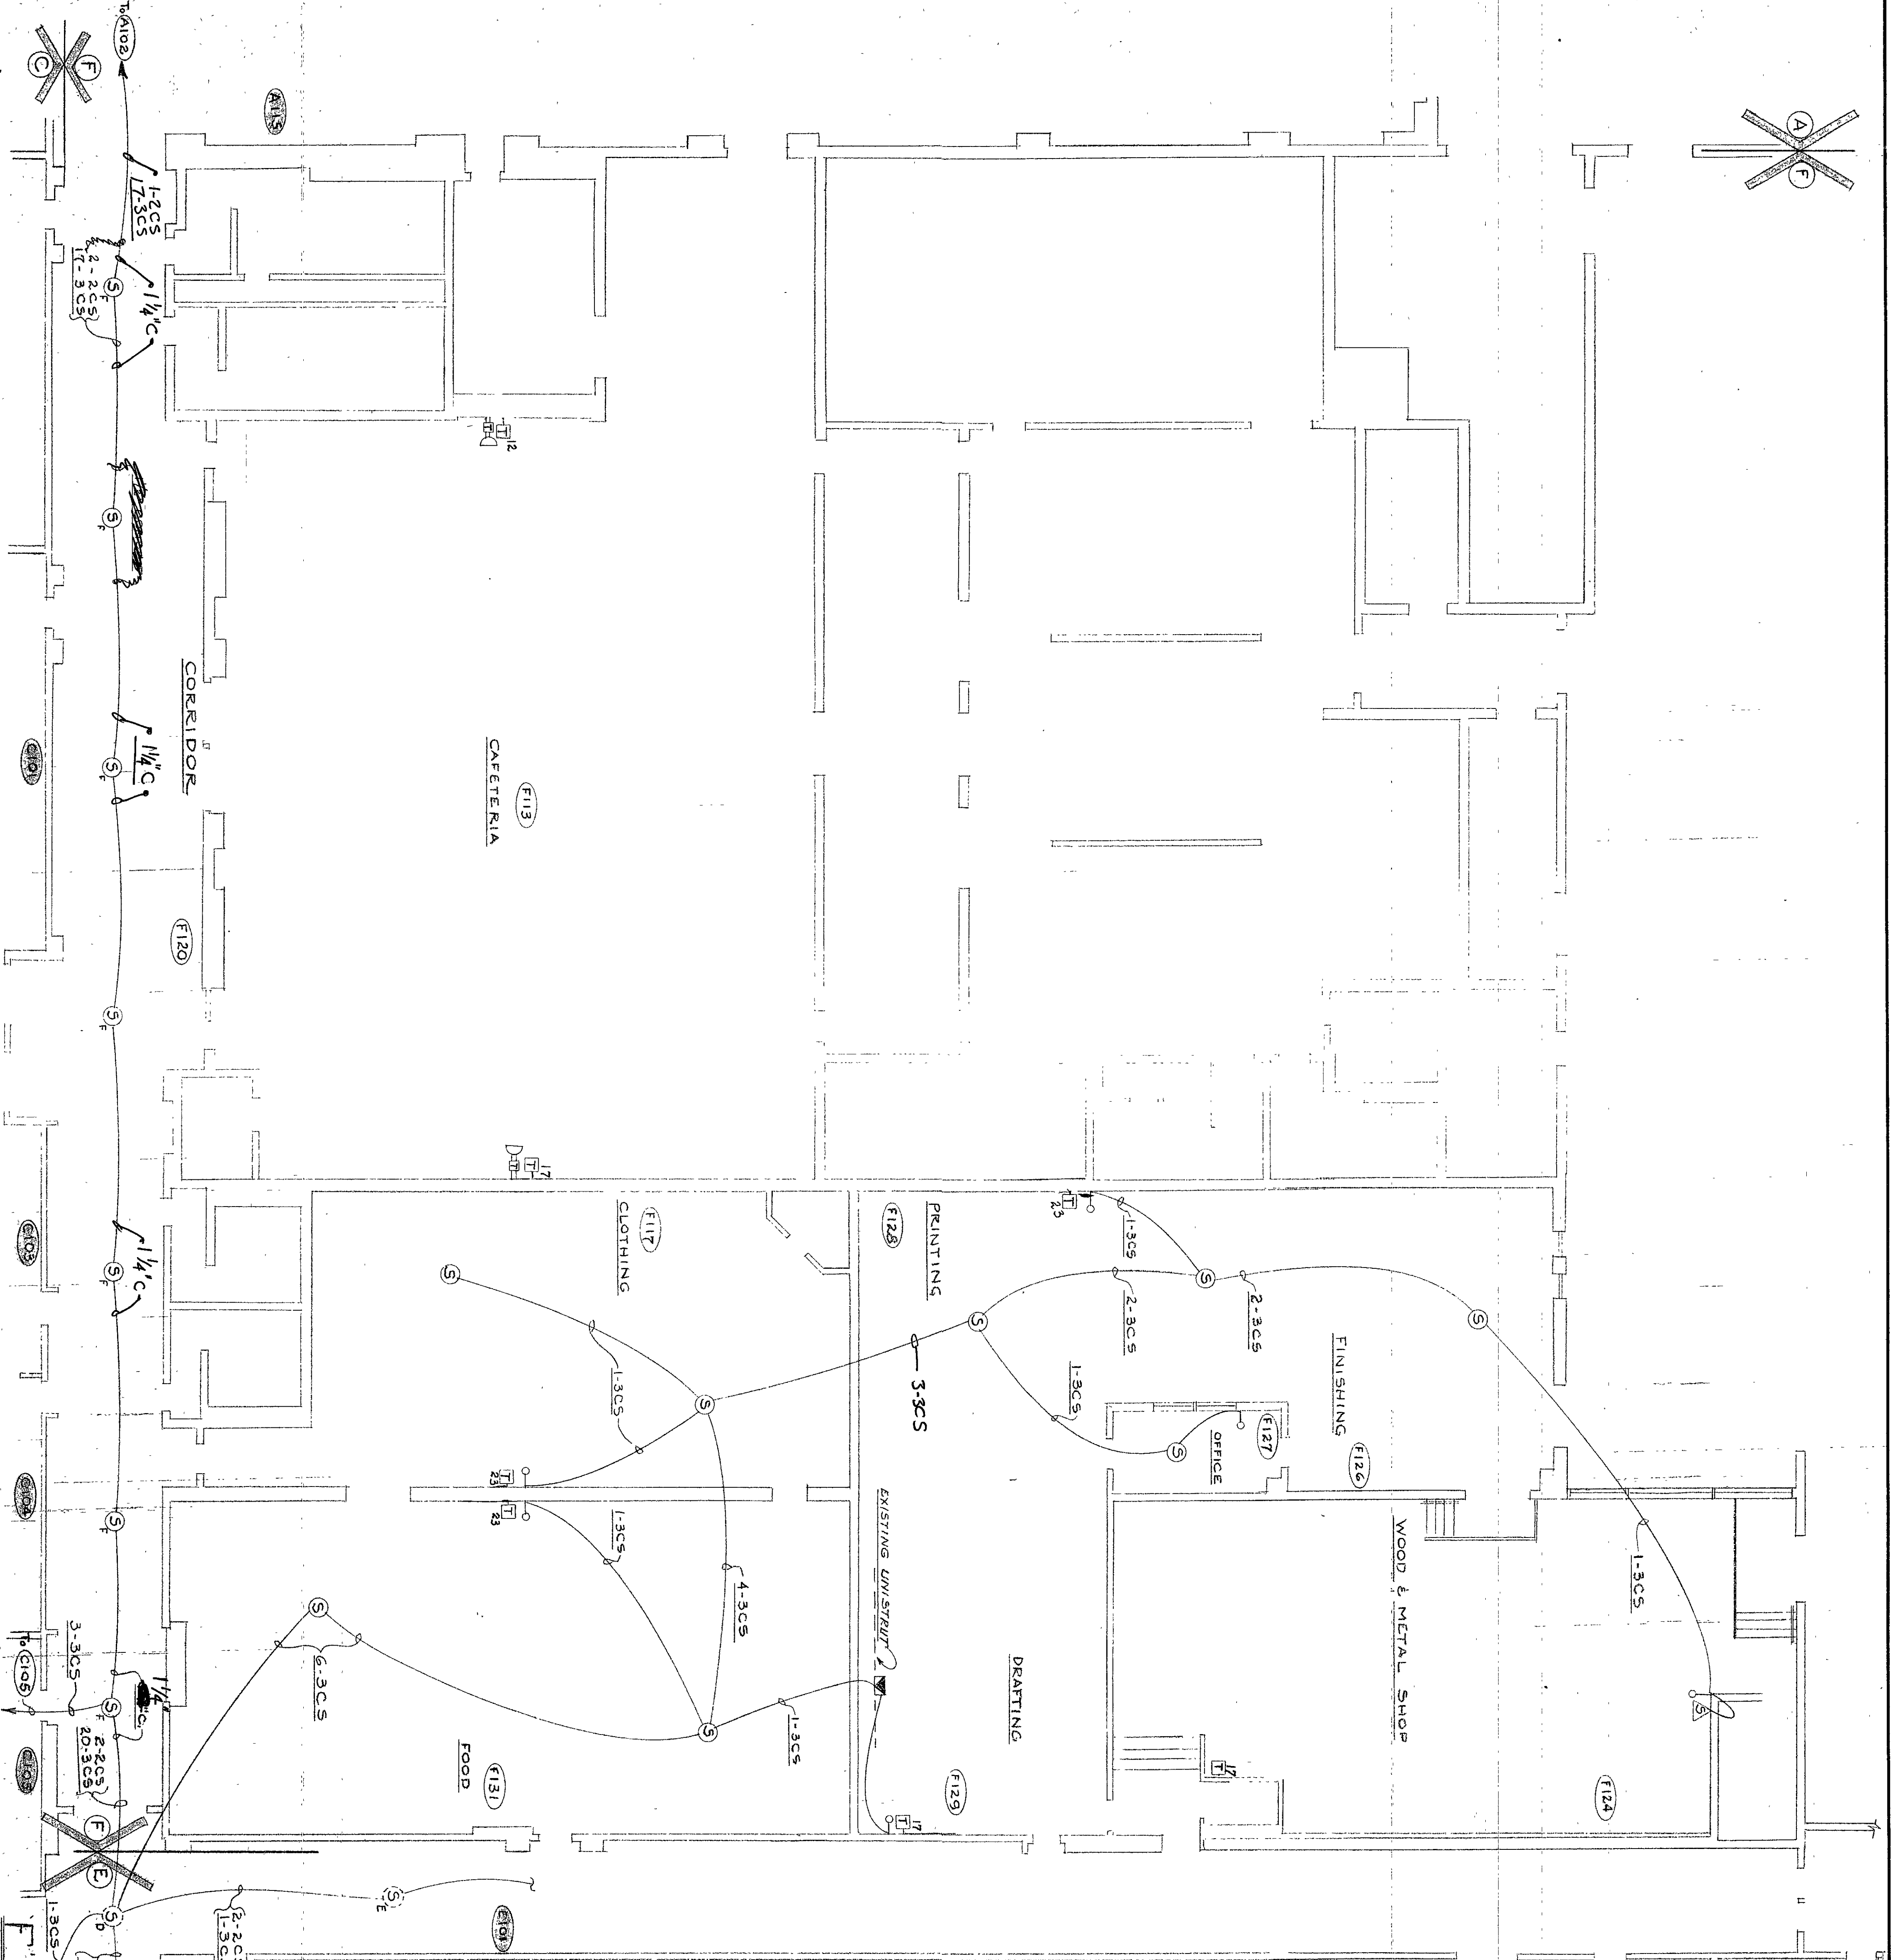


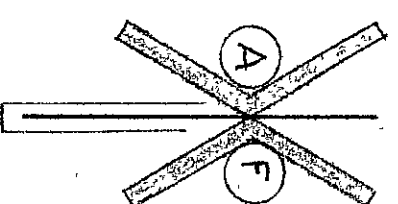


Music Rack Microphone Panel

SCALE: 1/8" = 1"

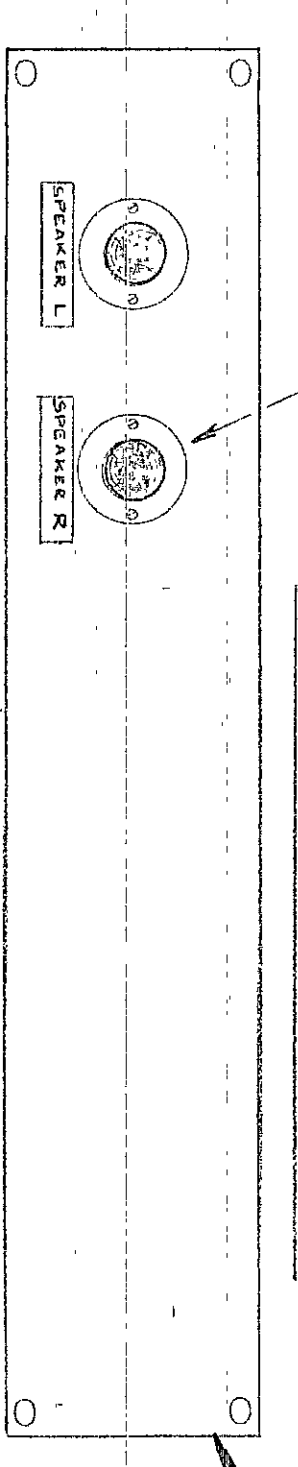


Music Rack Loudspeaker Panel

SCALE: 1/8" = 1"

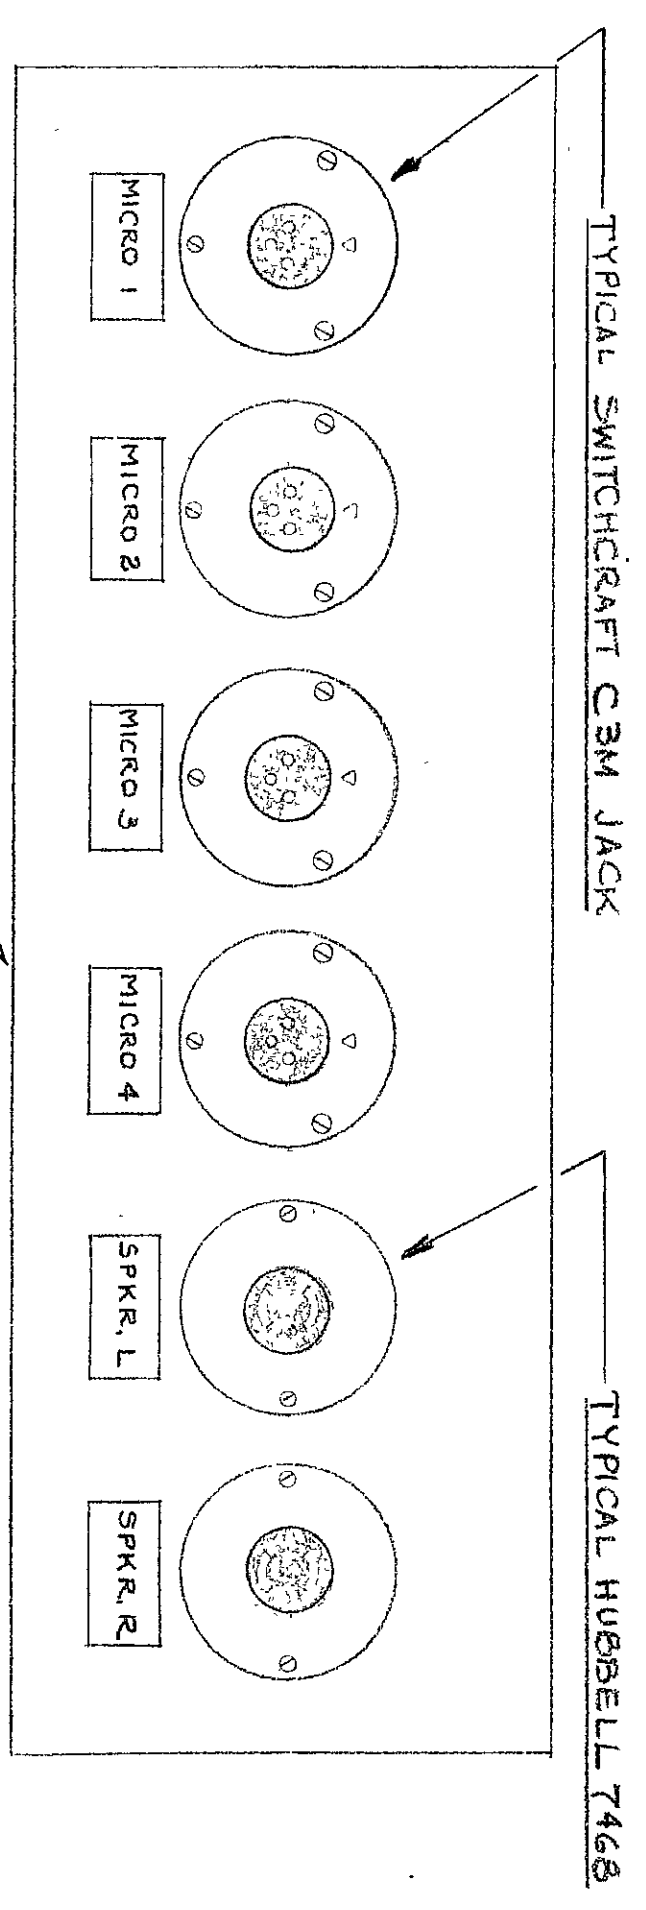

Music Dept Stereo System Control Plate Detail

SCALE: 1/4" = 1"

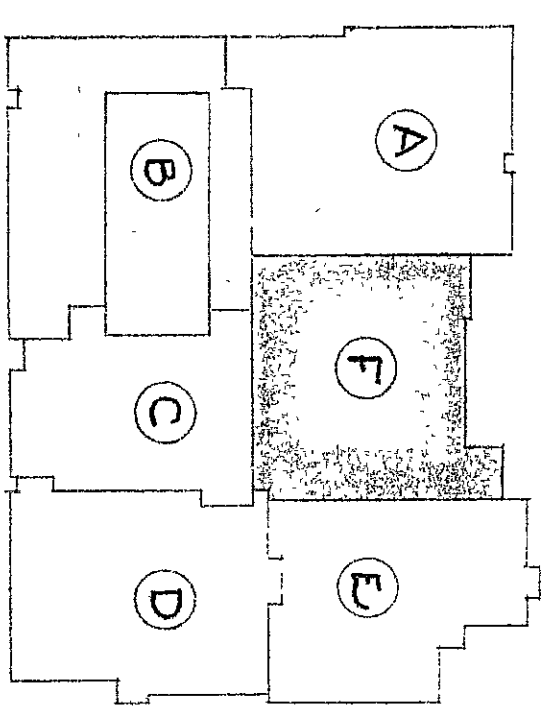

APPROVED
AS NOTED
DEC 08 1982
EVERETT L. BROWN CO.
BY *[Signature]*

KEY PLAN

SEE SHEET #3 FOR CABLE LEGEND AND
SYMBOL LEGEND
SEE SHEET #1 FOR GENERAL NOTES

F' AREA PLAN

SCALE: 1/8" = 1"

ELECTRONIC SERVICE Co., Inc.
SOUTH BEND
INDIANA
LIBERTY MIDDLE SCHOOL
CHESTERION
SOUND/TV SYSTEMS CONDUIT/WIRING
DRAWING NUMBER
H 21258-L
DATE
BY
DRAWN BY
CHECKED BY