


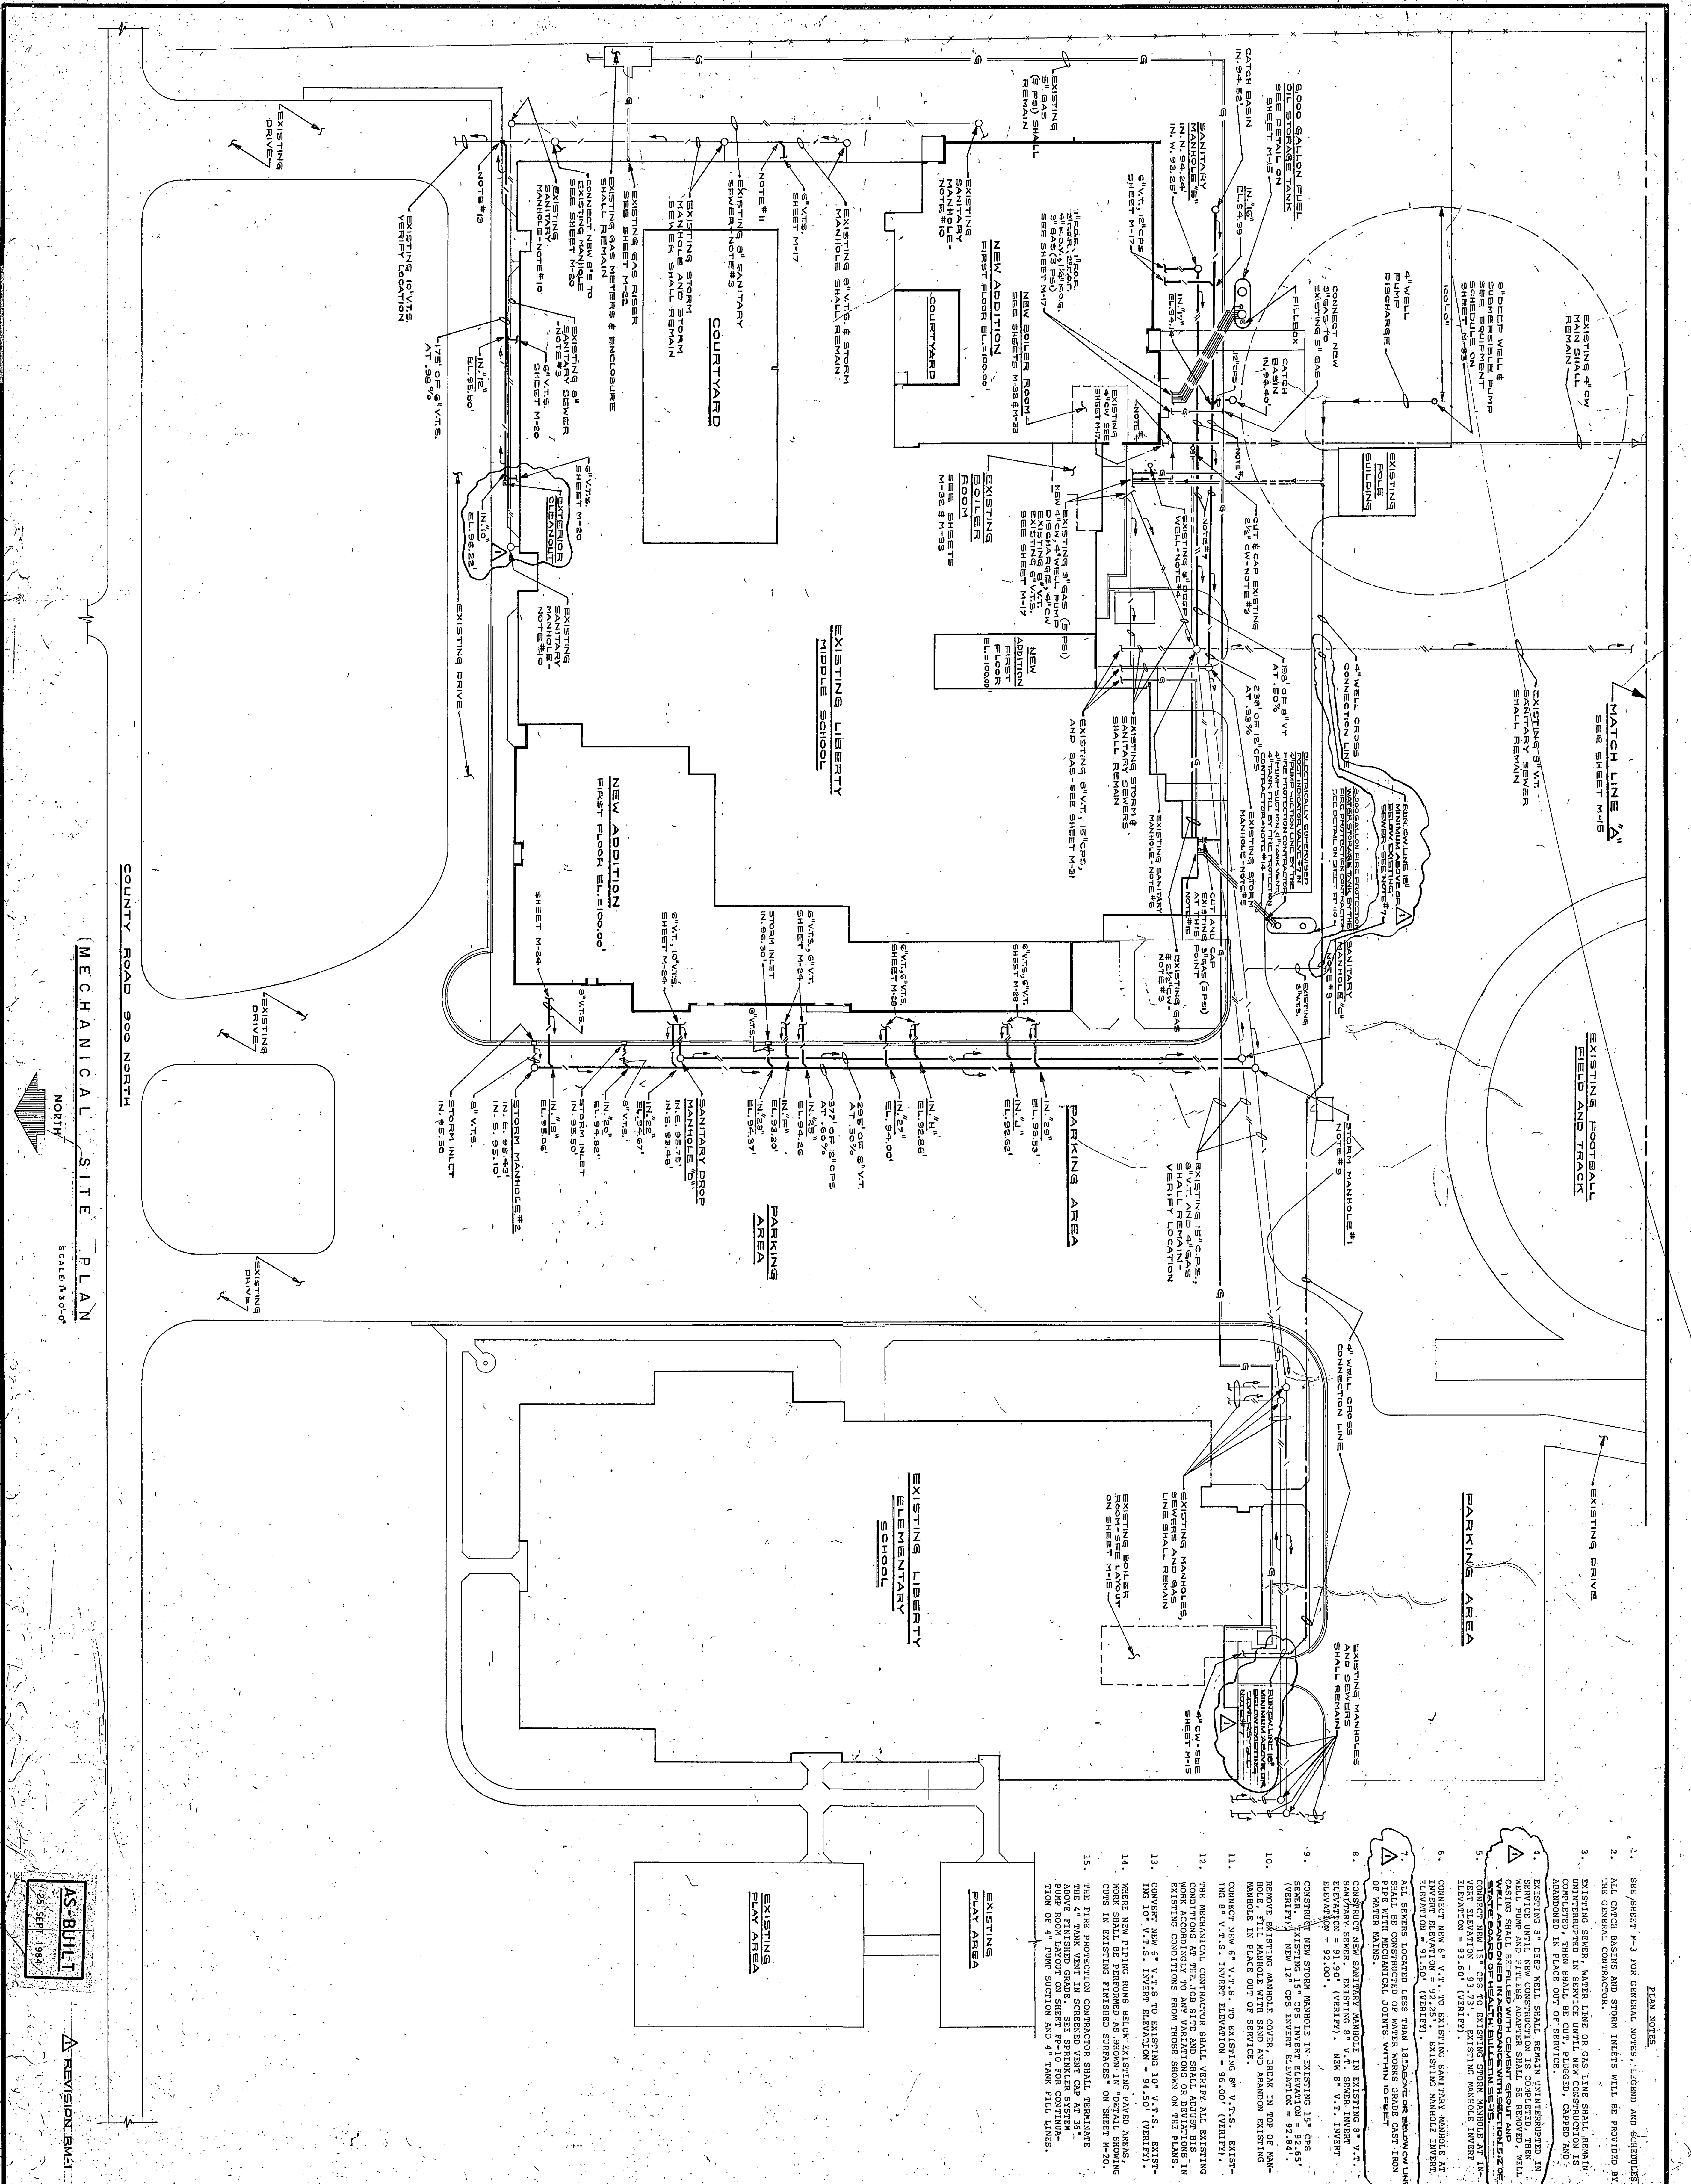

GENERAL NOTES:

1. SEE SHEET M-3 FOR GENERAL NOTES, LEGEND AND SCHEDULES.
2. ALL CATCH BASINS AND STORM INLETS WILL BE PROVIDED BY THE GENERAL CONTRACTOR.
3. EXISTING SEWER, WATER LINE OR GAS LINE SHALL REMAIN UNINTERRUPTED IN SERVICE UNTIL NEW CONSTRUCTION IS COMPLETED. AFTER WHICH, IT SHALL BE ABANDONED IN PLACE OUT OF SERVICE.
4. EXISTING 8\"/>
5. CONNECT NEW 15\"/>
6. CONNECT NEW 8\"/>
7. ALL SPHERES LOCATED LESS THAN 18\"/>
8. CONNECT THE SANITARY MANHOLE IN EXISTING 8\"/>
9. CONSTRUCT NEW STORM MANHOLE IN EXISTING 15\"/>
10. REMOVE EXISTING MANHOLE COVER, BREAK IN TOP OF MANHOLE, FILL MANHOLE WITH SAND AND ABANDON EXISTING MANHOLE IN PLACE OUT OF SERVICE.
11. CONNECT NEW 6\"/>
12. THE MECHANICAL CONTRACTOR SHALL VERIFY ALL EXISTING CONDITIONS AT THE JOB SITE AND SHALL ADJUST HIS WORK ACCORDINGLY TO ANY VARIATIONS OR DEVIATIONS IN EXISTING CONDITIONS FROM THOSE SHOWN ON THE PLANS.
13. CONVERT NEW 6\"/>
14. WHERE NEW PIPING RUNS BELOW EXISTING PAVED AREAS, WORK SHALL BE PERFORMED AS SHOWN IN DETAIL, SHOWING CUTS IN EXISTING FINISHED SURFACES ON SHEET M-20.
15. THE FIRE PROTECTION CONTRACTOR SHALL TERMINATE THE 4\"/>