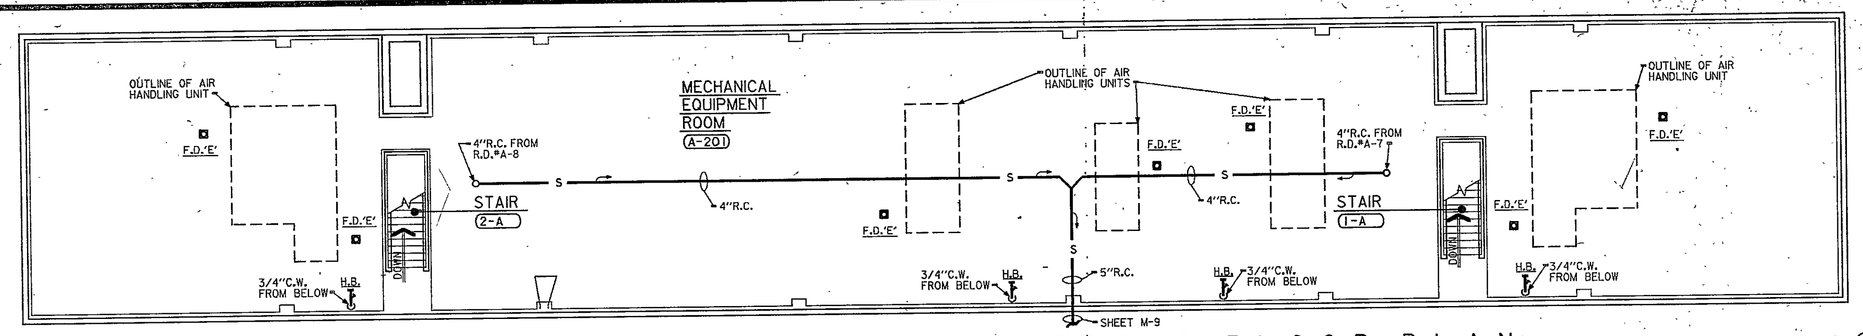

UNIT 'A' PLUMBING SECOND FLOOR PLAN

SCALE: 1/8" = 1'-0"

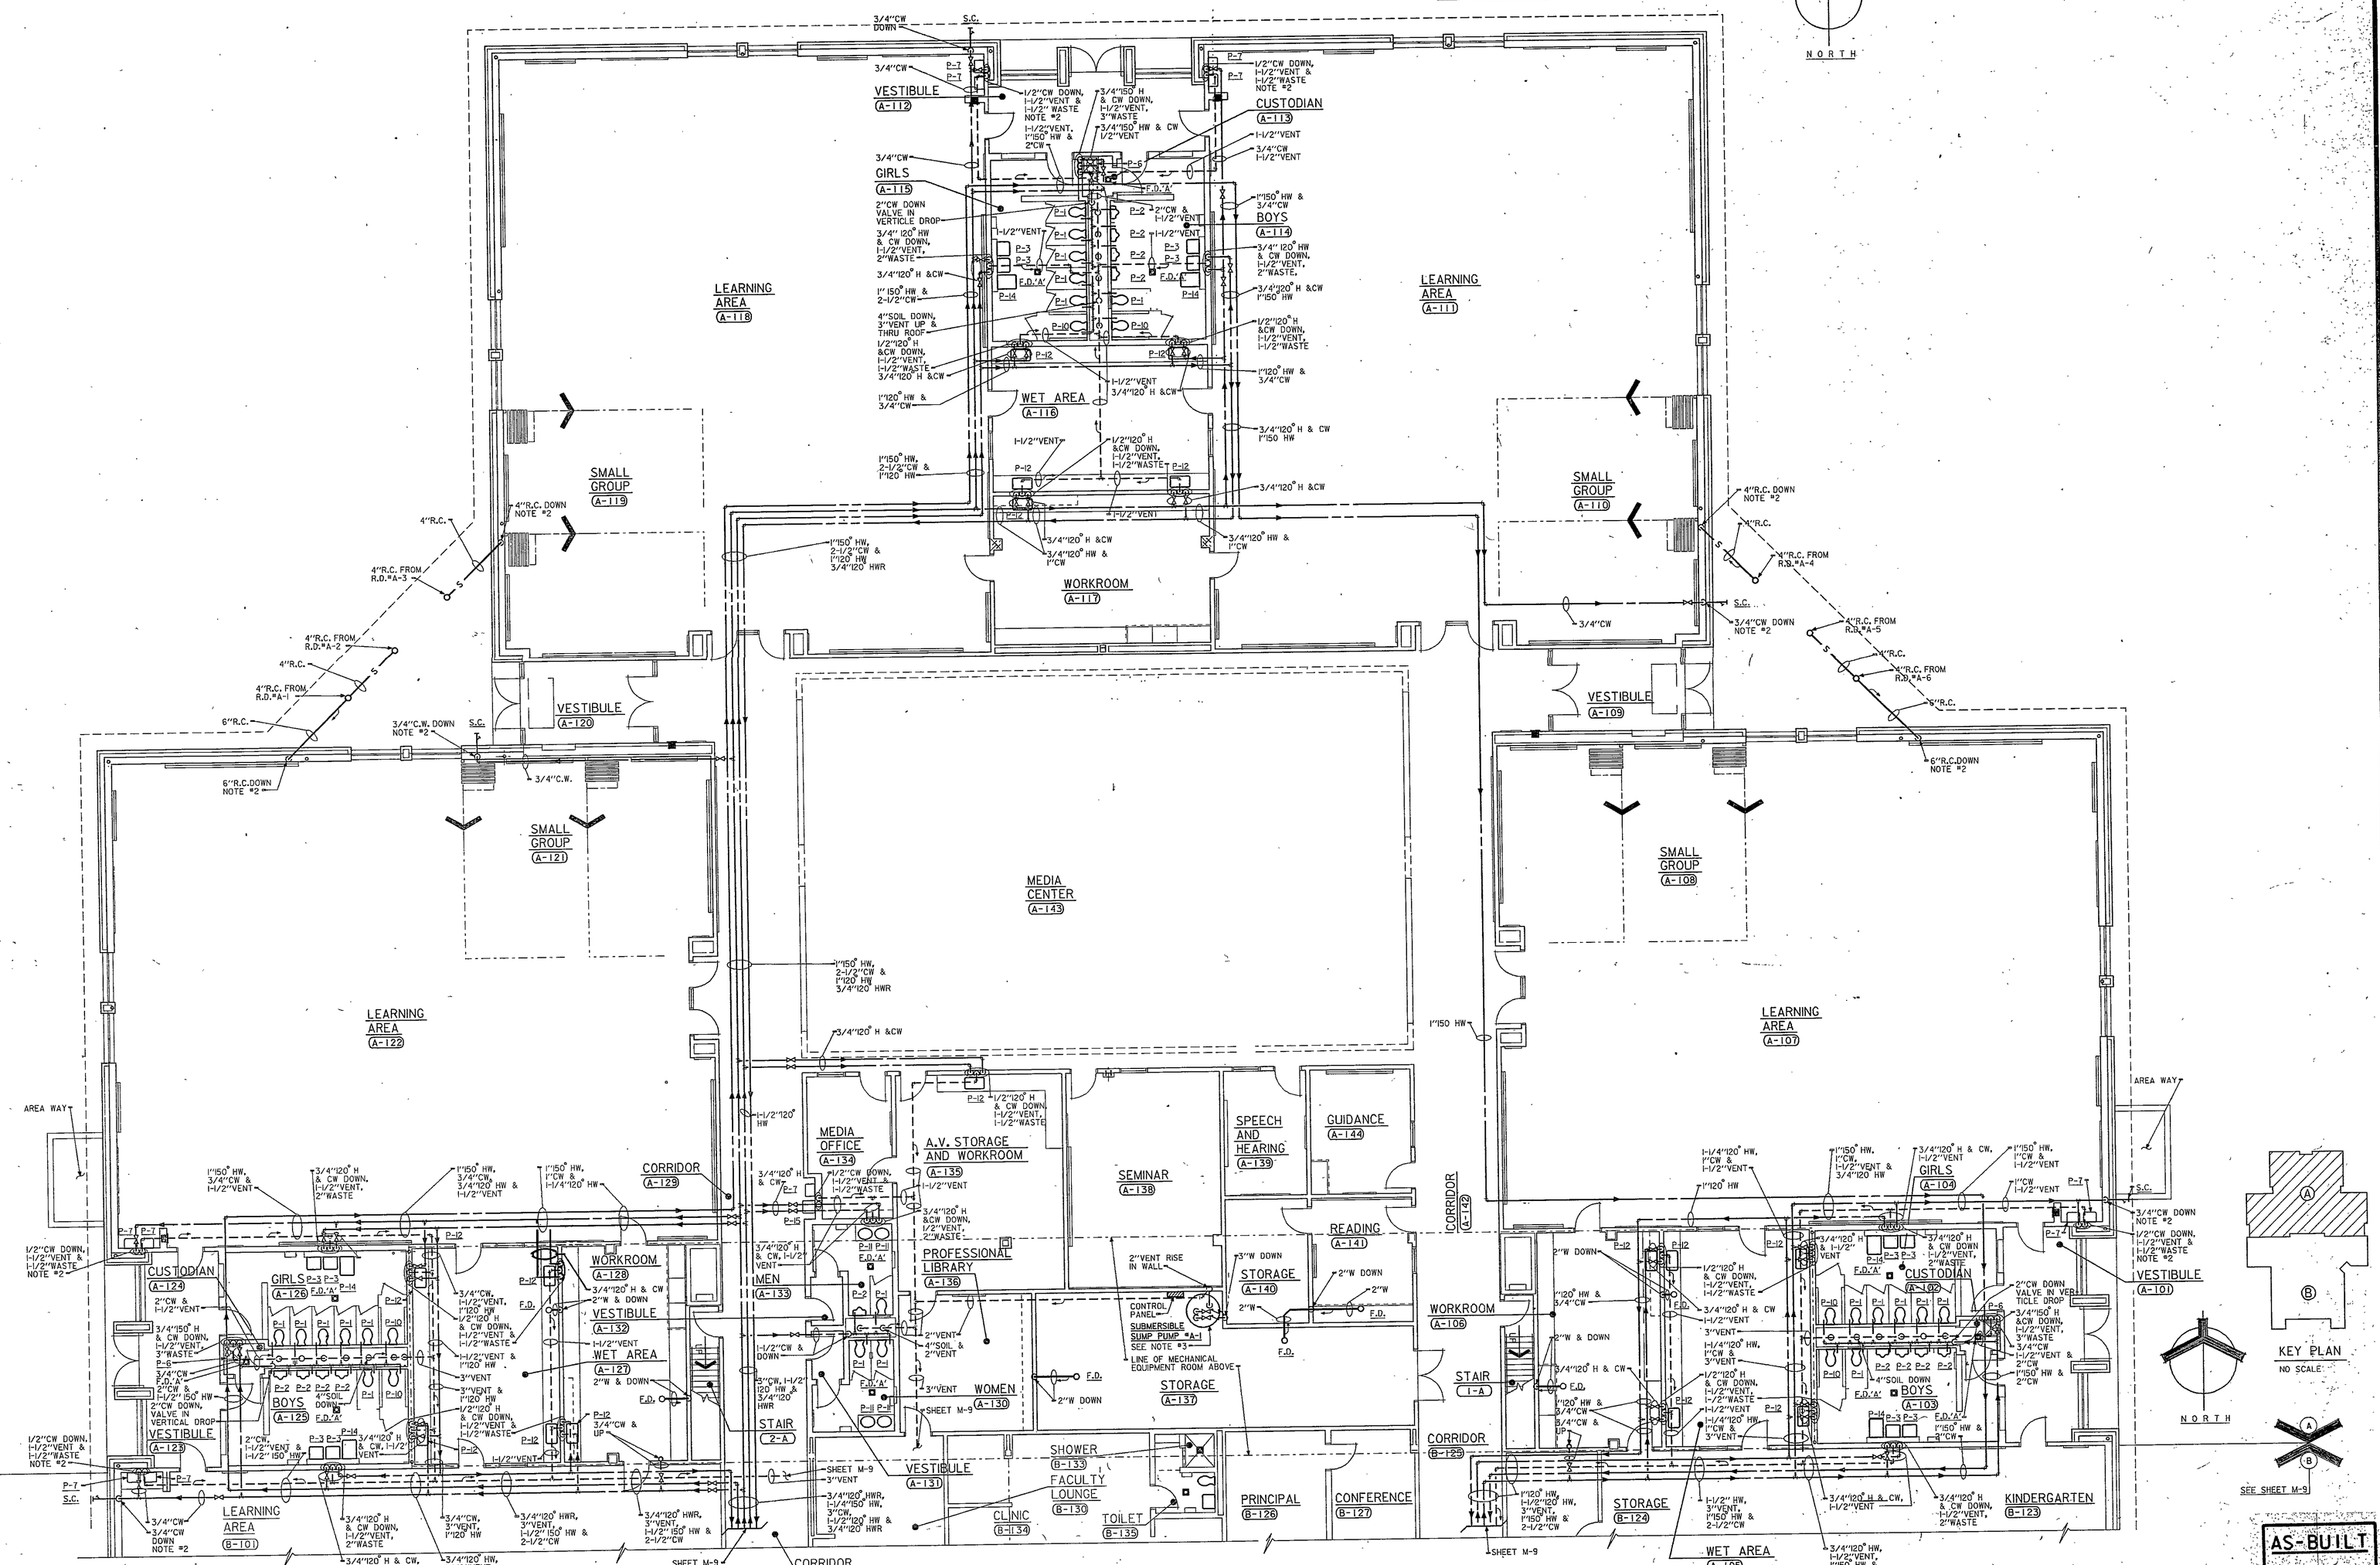

UNIT 'A' PLUMBING FIRST FLOOR PLAN

SCALE: 1/8" = 1'-0"

PLAN NOTES

1. SEE SHEET M-3 FOR GENERAL NOTES, LEGEND AND SCHEDULES.
2. ALL PIPING RUN DOWN EXTERIOR WALLS SHALL BE RUN ON ROOM SIDE OF WALL INSULATION.
3. SUBMERSIBLE SUMP PUMP SHALL BE WEIL PUMP COMPANY 2500 SERIES MODEL #3-250H4-3/4 DUPLEX TYPE WITH EACH PUMP HAVING THE CAPACITY TO PUMP 100 GPM AT 13 FEET OF HEAD. MOTOR DATA: (2) 3/4 HP, 460 VOLT, 3-PHASE, 60 HERTZ, 1750 RPM. PROVIDE 42" DIAMETER X 12'-0" DEEP BASIN WITH GAS TIGHT COVER - SEE SPECIFICATIONS.

© EVERETT I. BROWN COMPANY

EVERETT I. BROWN COMPANY

ARCHITECTS ENGINEERS

• PARK FLETCHER • INDIANAPOLIS, INDIANA • 46241

EVERETT I. BROWN SCHOOL

5500 WEST BRADBURY AVENUE • JACKSON ELEMENTARY SCHOOL

KEY PLAN

NO SCALE

PROJECT	DATE	REVISED
12579.00	MAY 3, 1982	

NO. M-6

OF 36

AS-BUILT

25 SEPT 1984