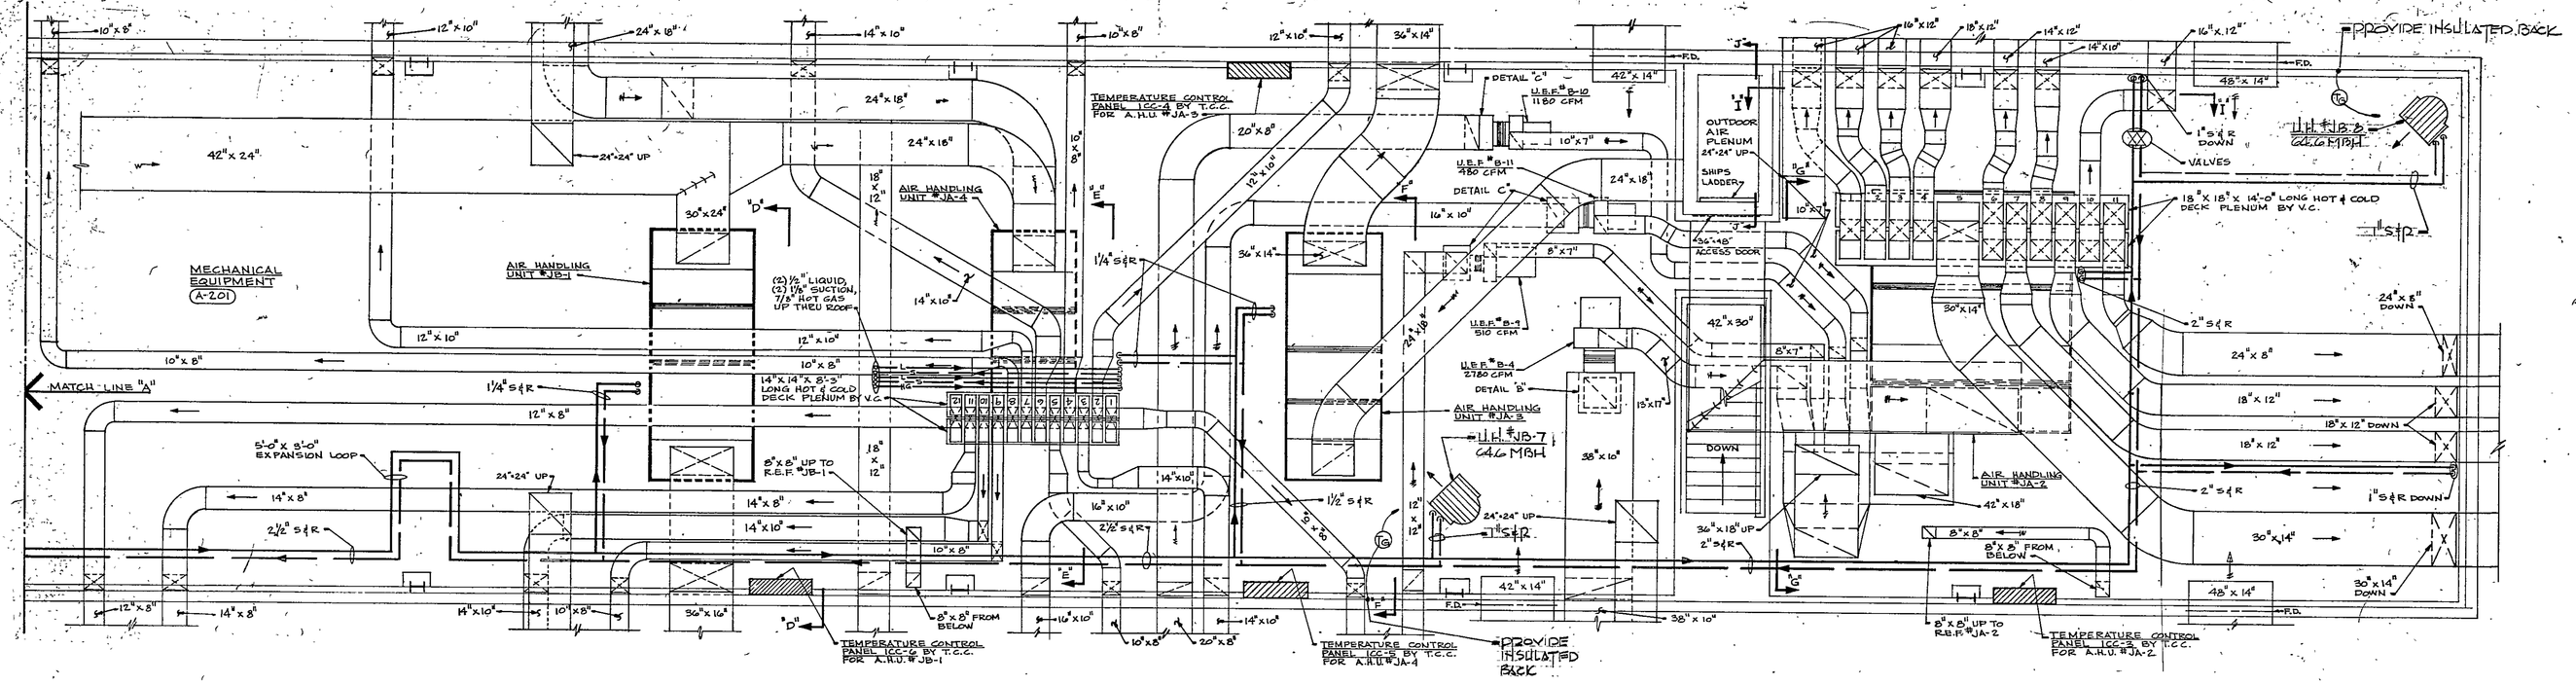

MECHANICAL EQUIPMENT ROOM #A-201

SCALE: 1/4" = 1'-0"

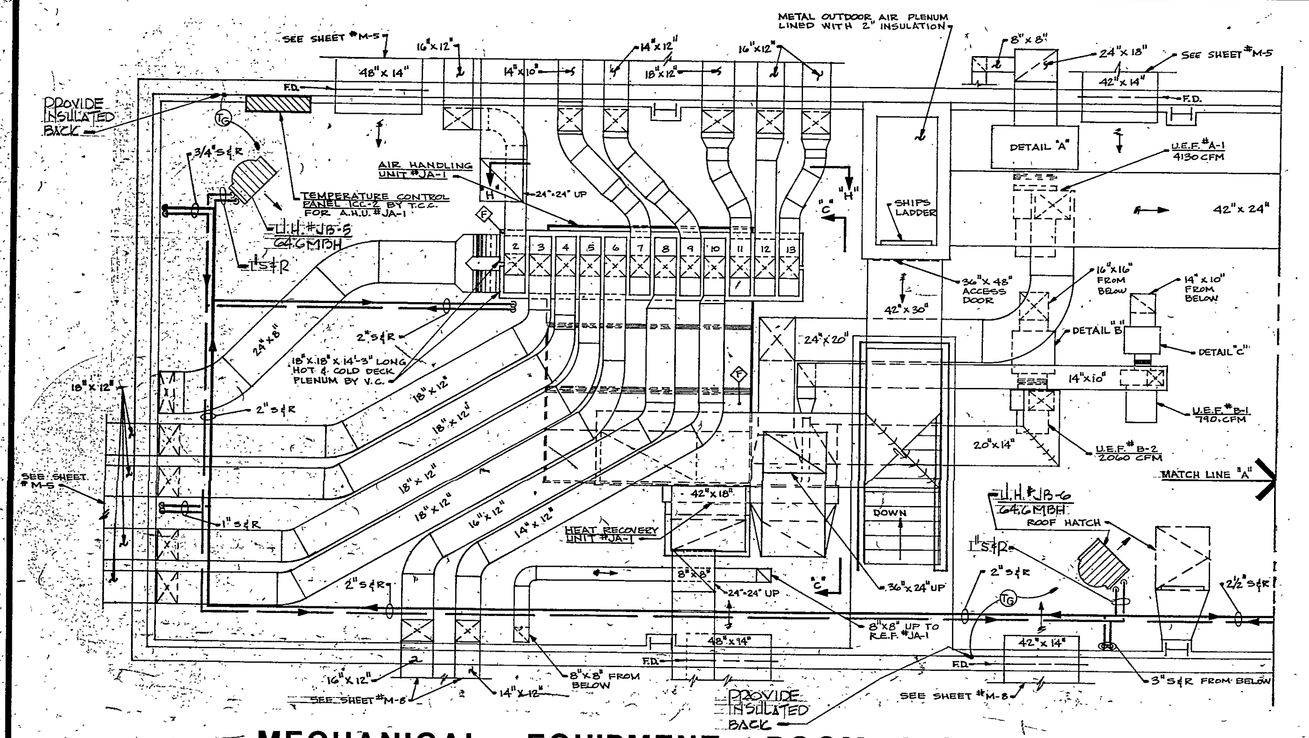

MECHANICAL EQUIPMENT ROOM #A-201

SCALE: 1/4" = 1'-0"

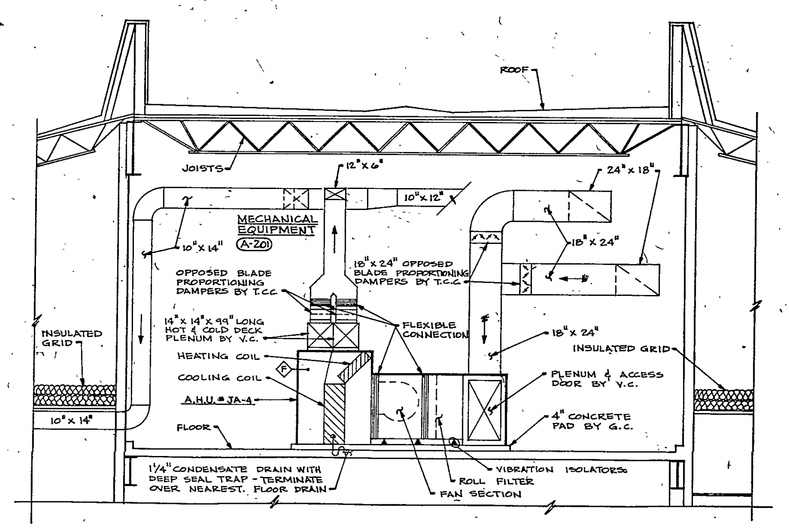

SECTION E-E

NO SCALE

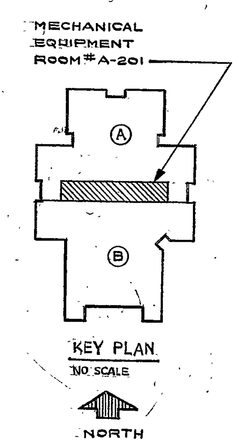

KEY PLAN

NO SCALE

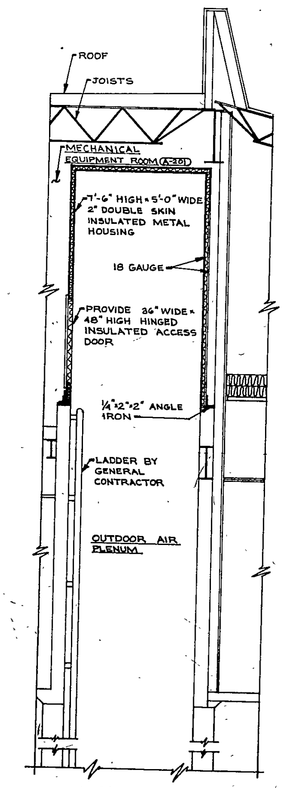

SECTION J-J

NO SCALE

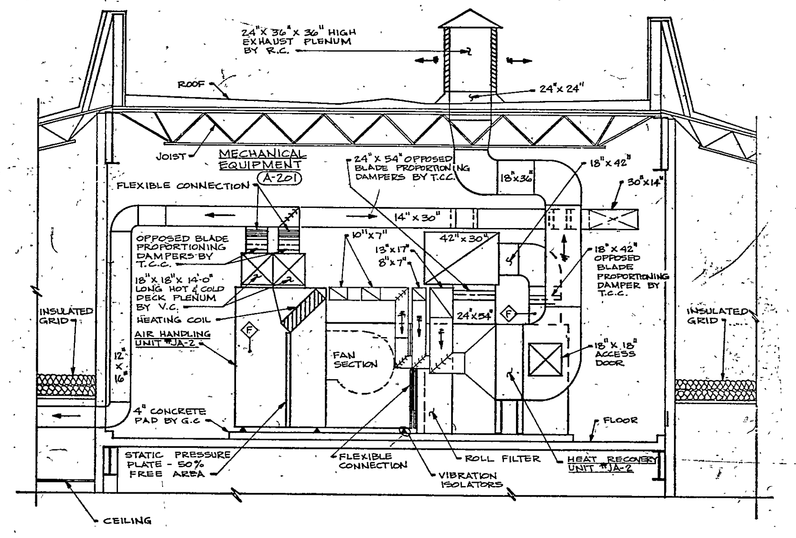

SECTION G-G

NO SCALE

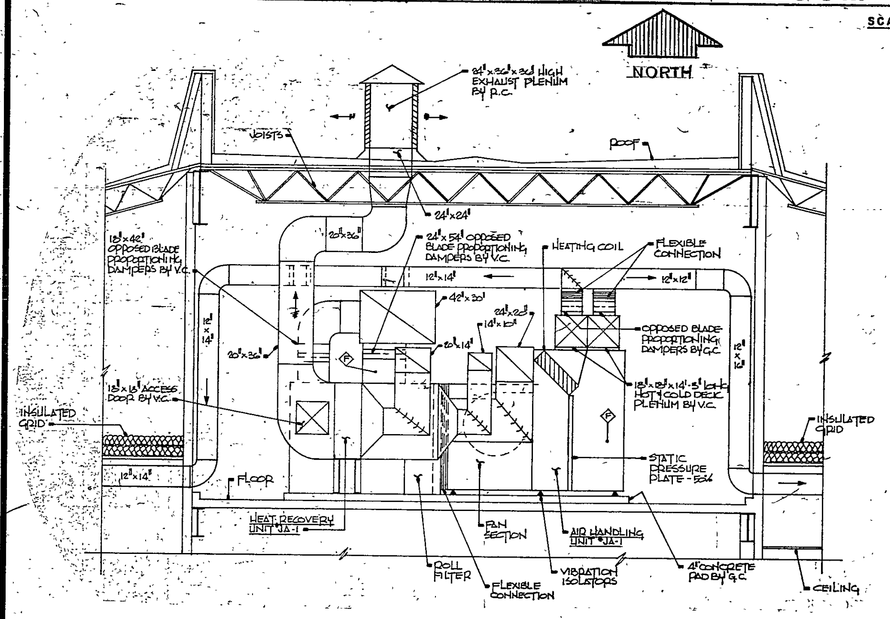

SECTION C-C

NO SCALE

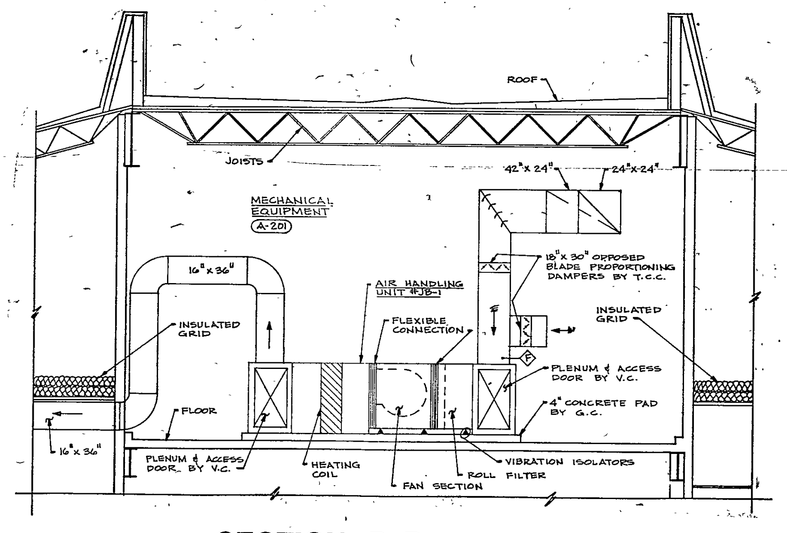

SECTION D-D

NO SCALE

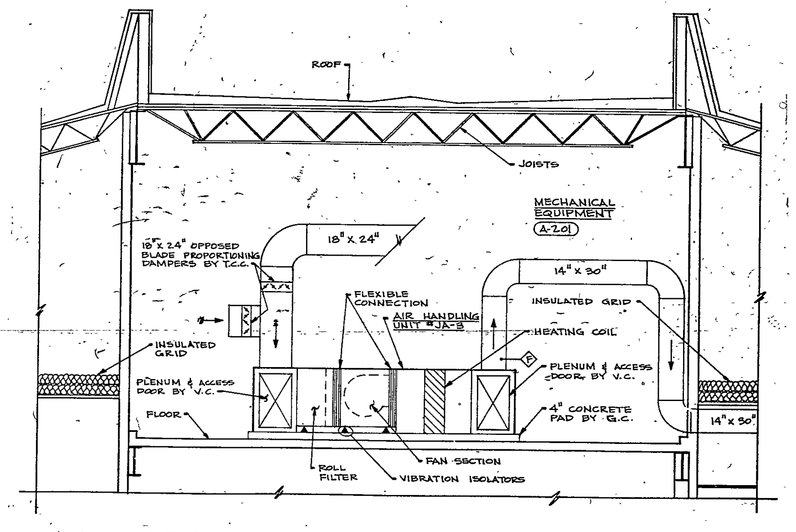

SECTION F-F

NO SCALE

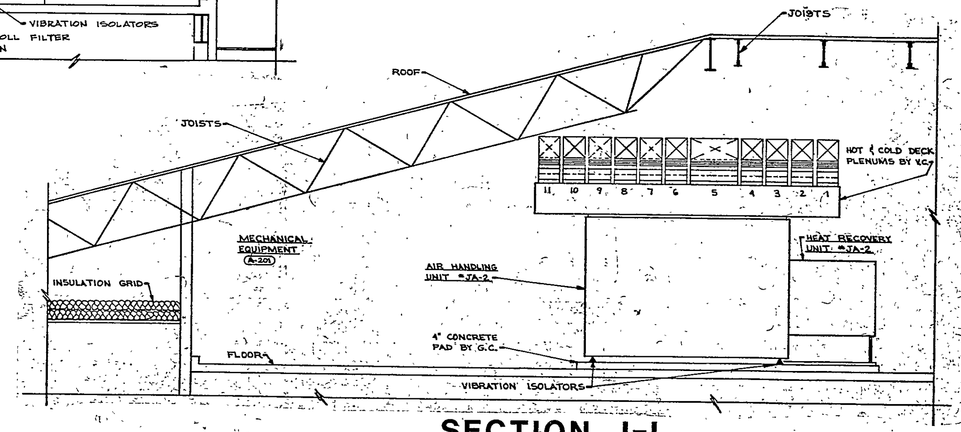

SECTION I-I

NO SCALE

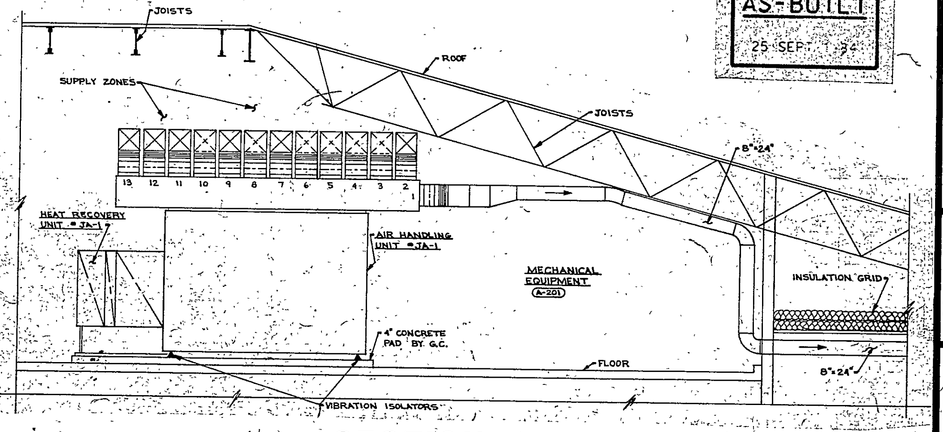

SECTION H-H

NO SCALE

AS-BUILT
25 SEP 94

EVERETT · I · BROWN COMPANY

ARCHITECTS
ENGINEERS
• INDIANAPOLIS, INDIANA • 46241
• PARK FLETCHER •

5500 WEST BRADBURY AVENUE •
JACKSON ELEMENTARY SCHOOL

©EVERETT I. BROWN COMPANY

PROJECT	DATE	REVISED
12579	3 MAY 1982	

NO. M - 12
OF 36

82-11-12