
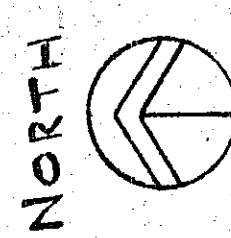


MATCH LINE
SEE SHEET A1

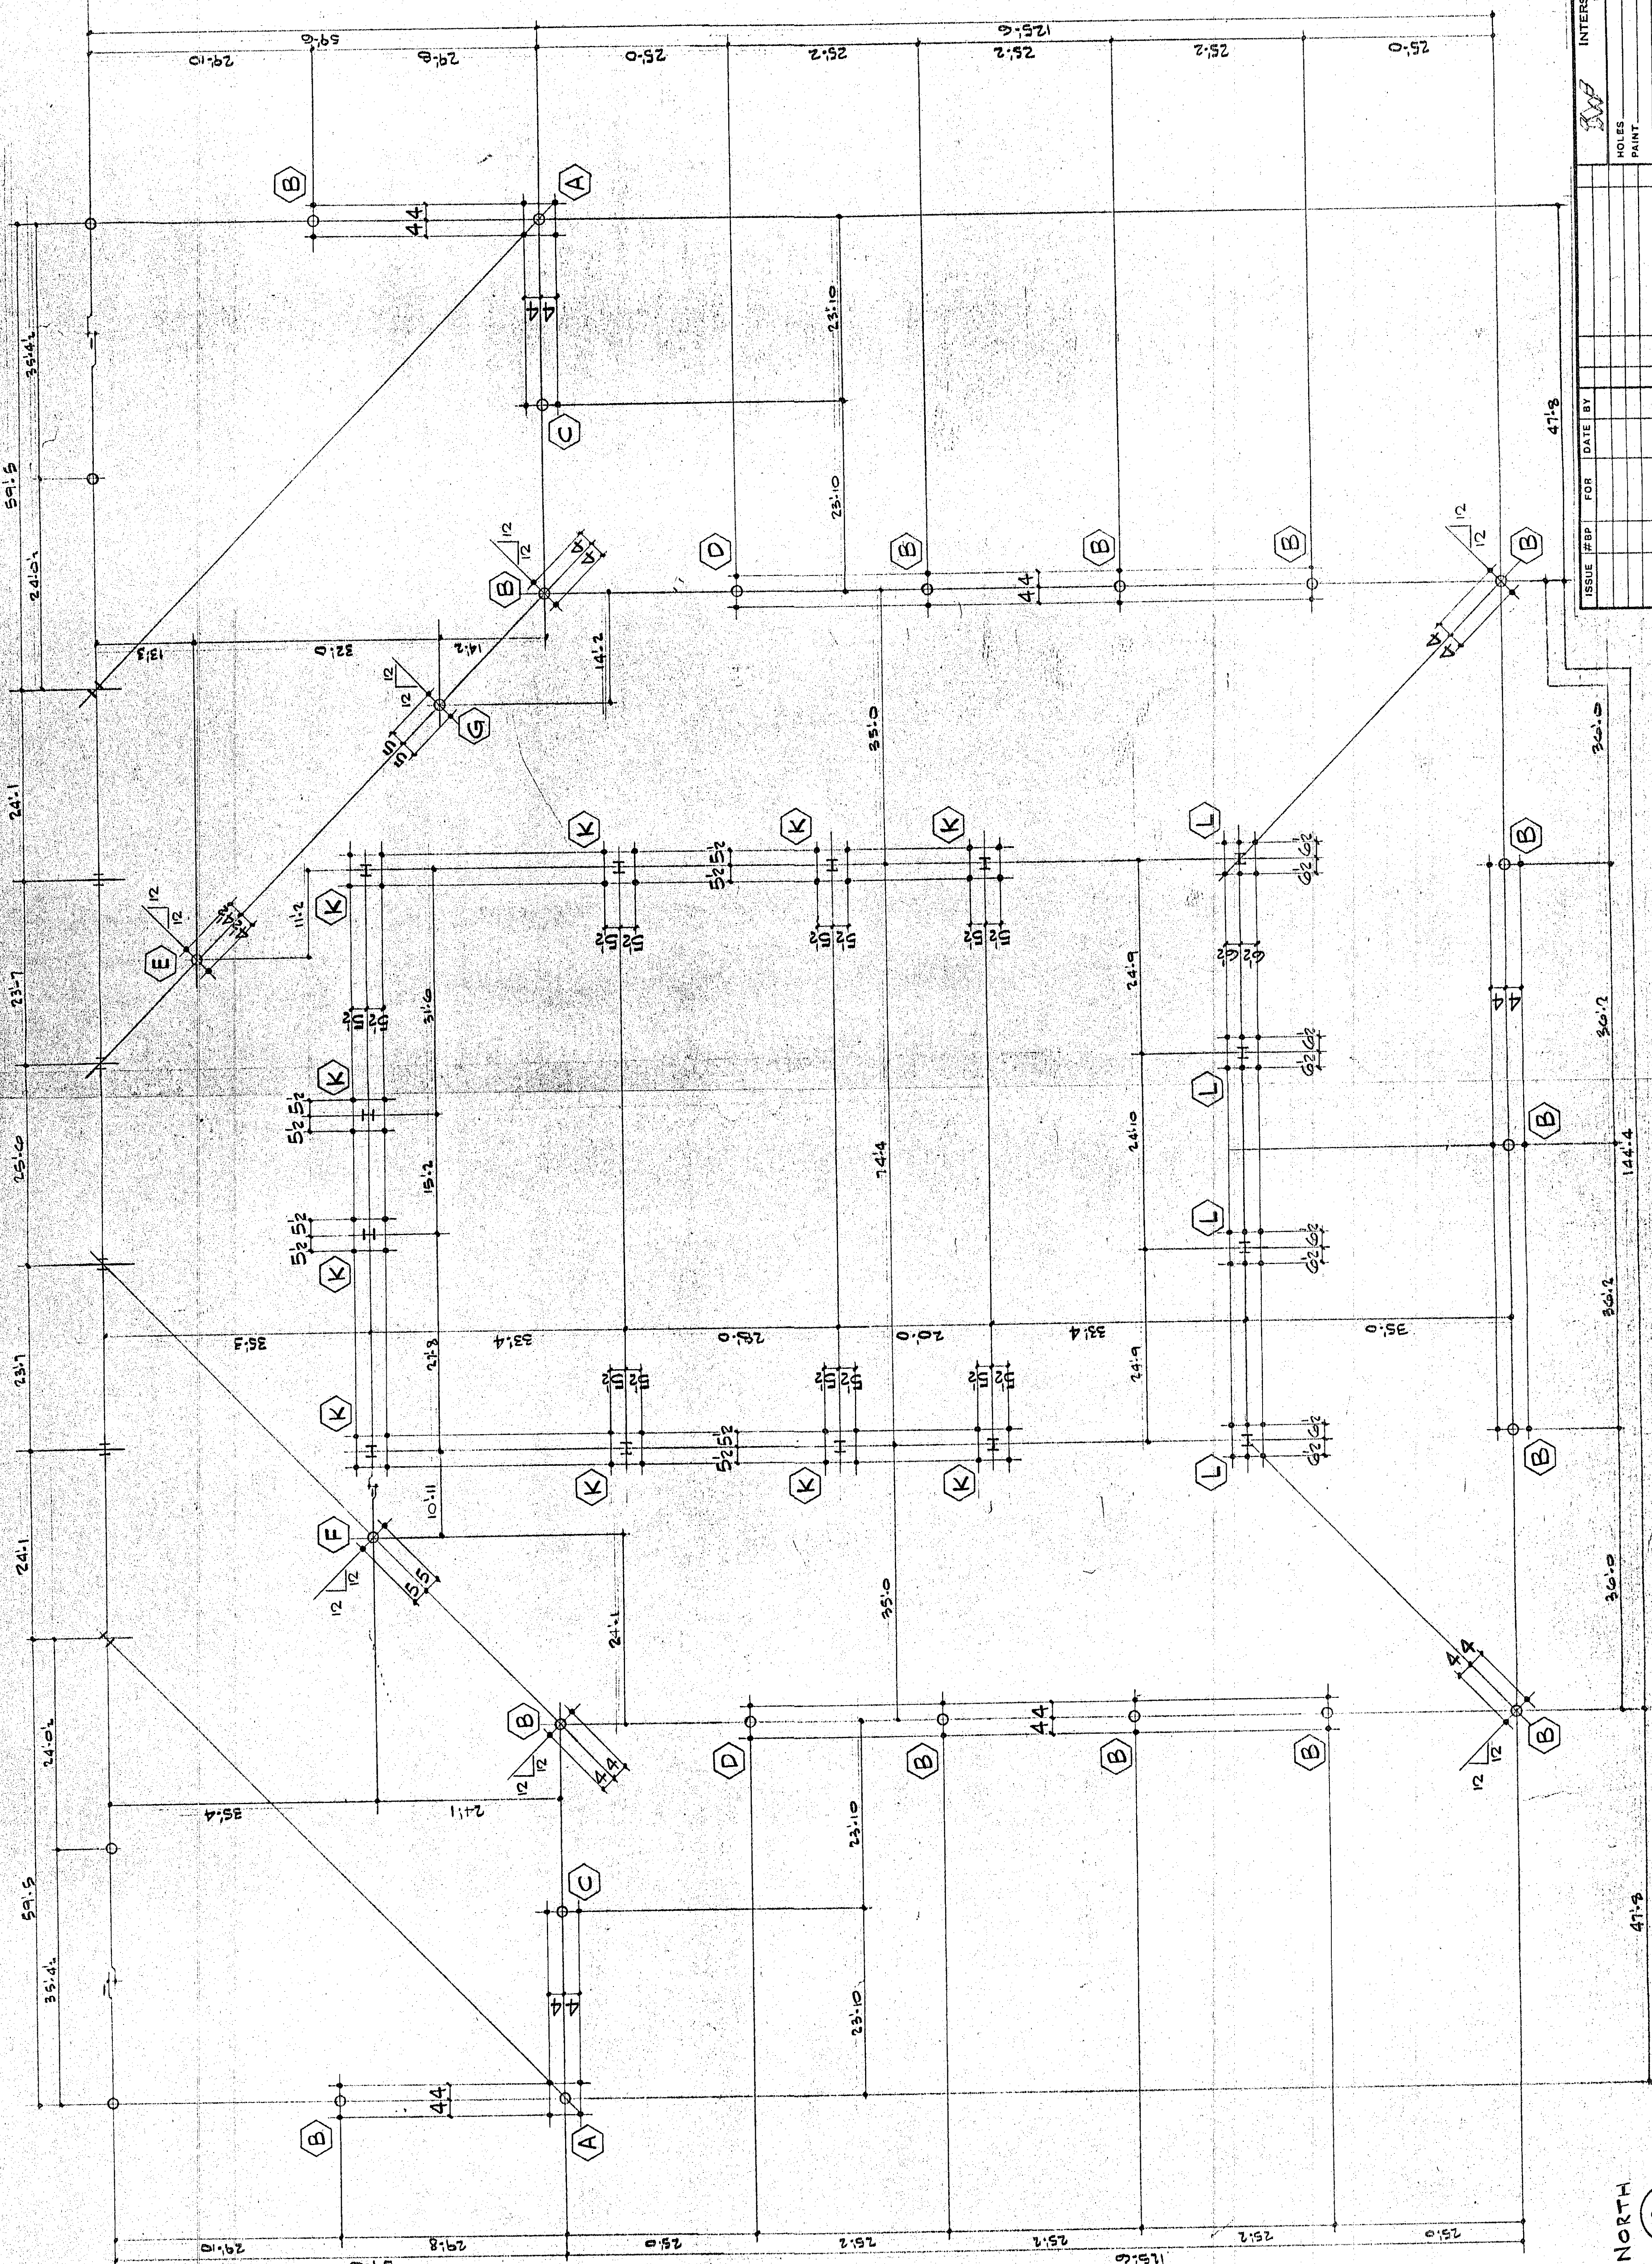

UNIT "B" ANCHOR BOLT SETTING PLAN

APPROVED
EVERETT I. BROWN CO.

BY DATE MAR 21 1983

APPROVED DRAWINGS
FOR FIELD USE
DATE MAR 21 1983

NOTE: WORK THIS
SHEET WITH SHEETS
A1, A3 & A4

INTERSTATE WELDING & FABRICATION, INC. 1870 DAVIS AVENUE • TERRE HAUTE, INDIANA 47602		OWN BY WK		CH'D BY WK		DWG. NO. WK	
JACKSON ELEMENTARY SCHOOL CHESTERTON, INDIANA		ISSUE #		FOR		DATE	
HOLES							
PAINT							
CLEANING							
REF. DWGS							
REV. DATE		REV. DATE		DESCRIPTION		REV. DATE	
3		4		F 20		3/9/83	