



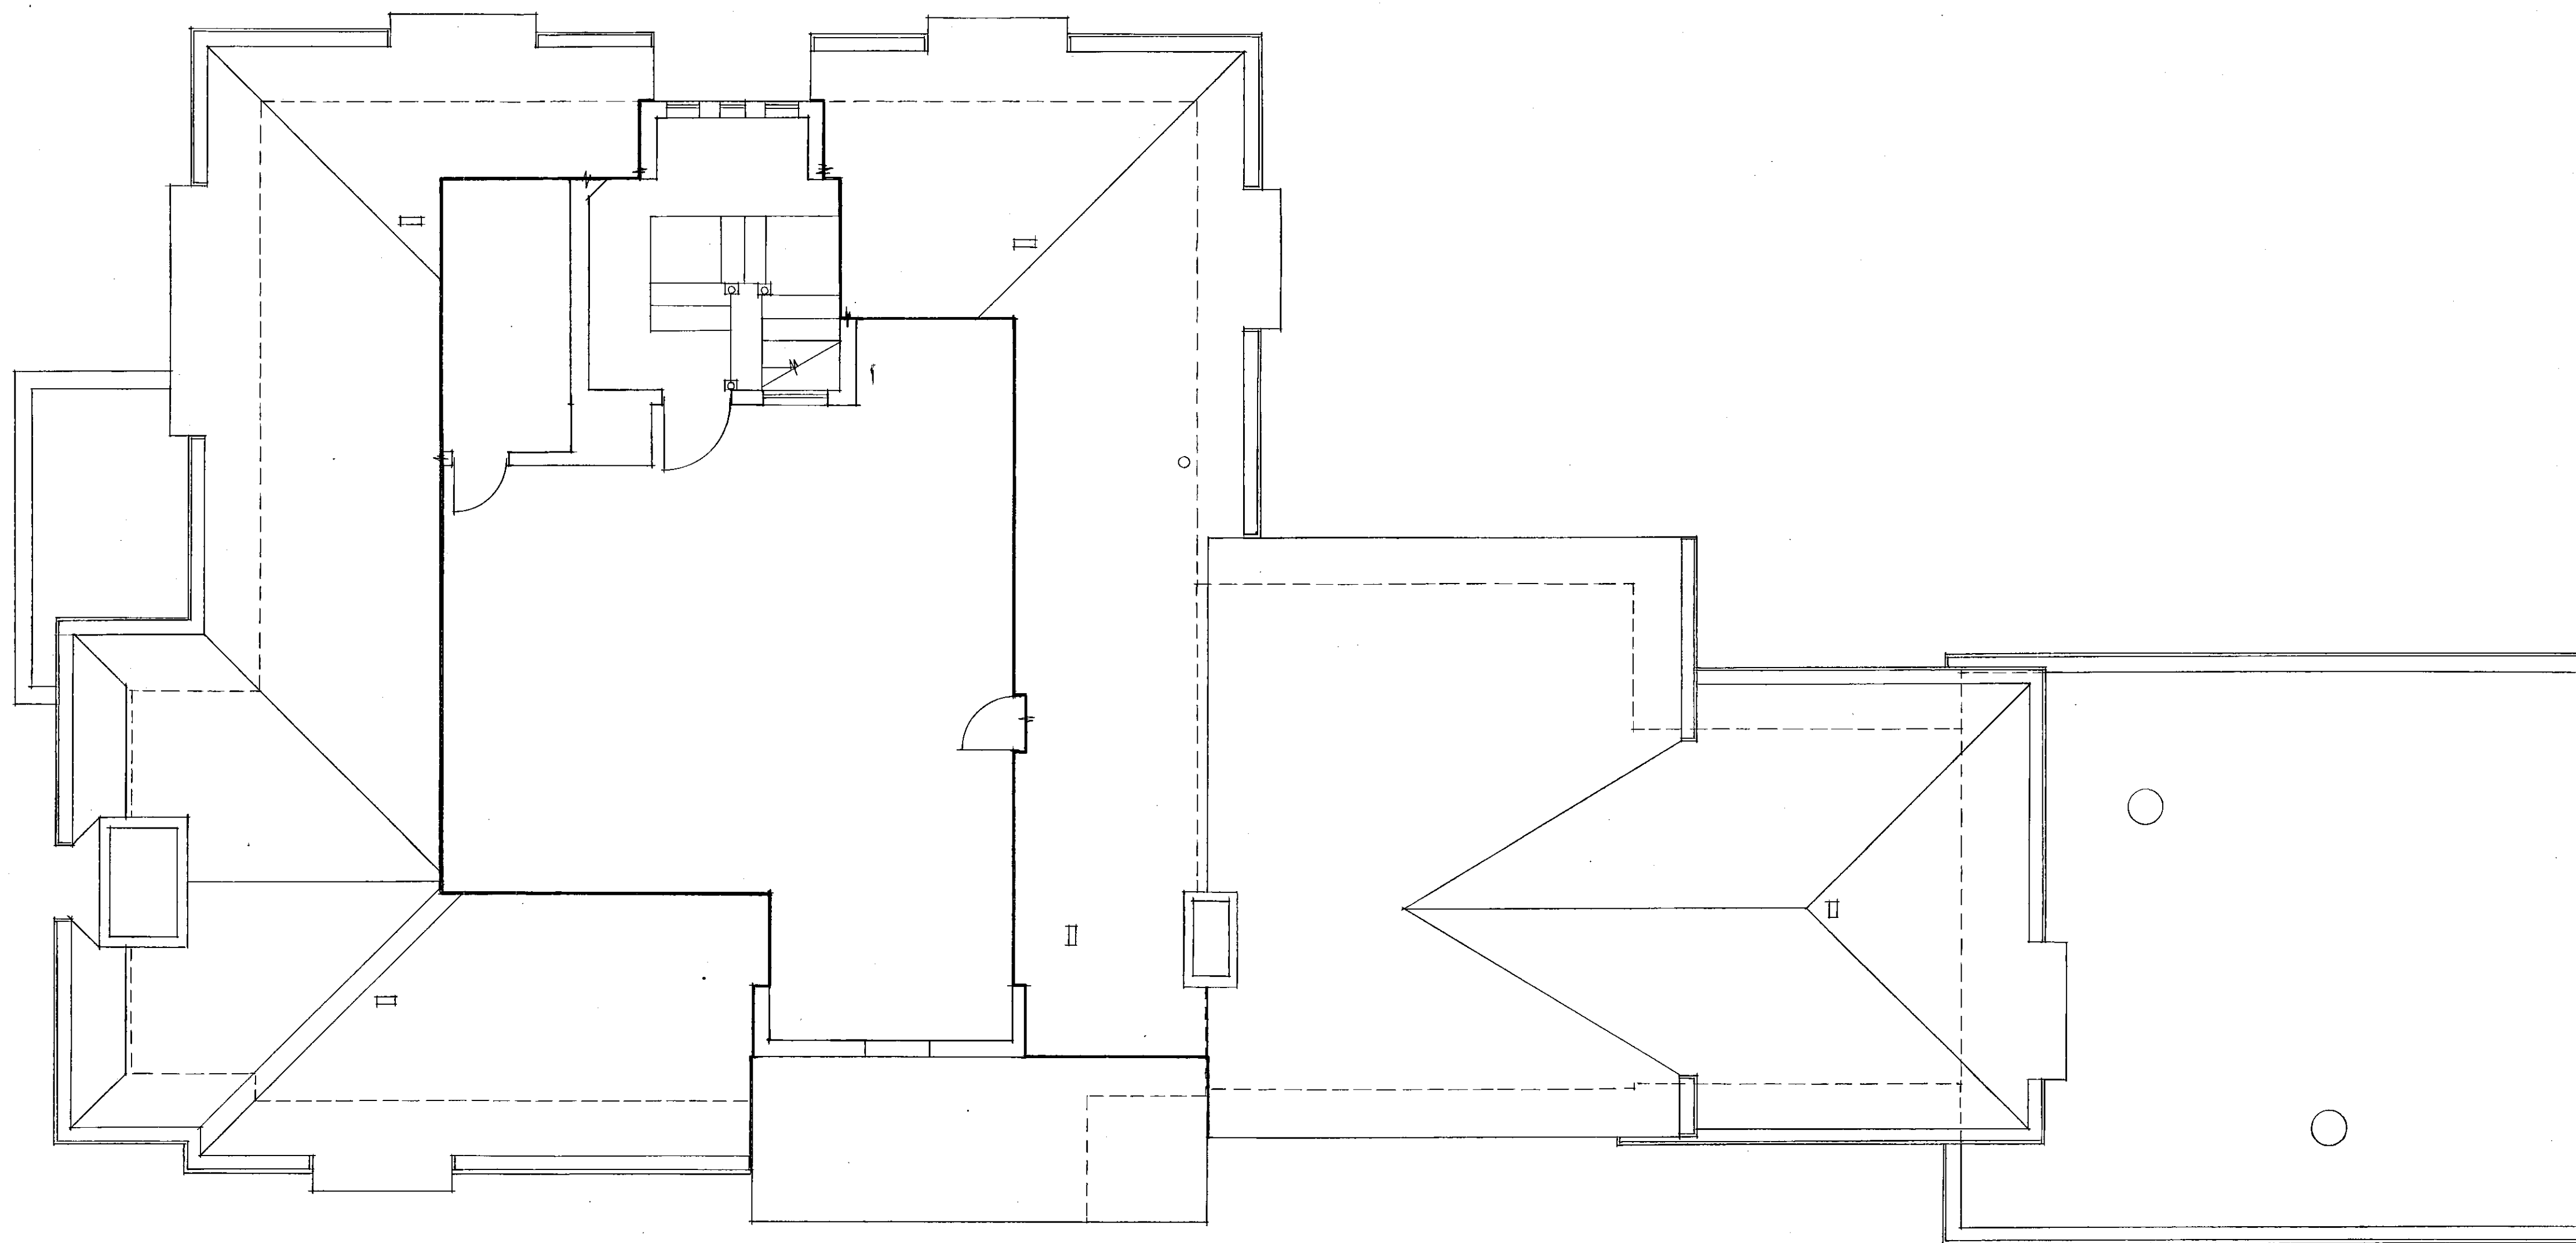

THIRD FLOOR PLAN
SCALE: 1/4" = 1'-0"
(note: this plan drawn from field
measurements - verify all dimensions)

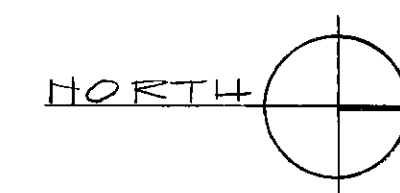

PROJECT	NO.	93-04
DATE	OF	
REVISED		

EVERETT · I · BROWN COMPANY
5500 WEST BRADBURY AVENUE ·
ARCHITECTS
ENGINEERS
INDIANAPOLIS, INDIANA · 46241