




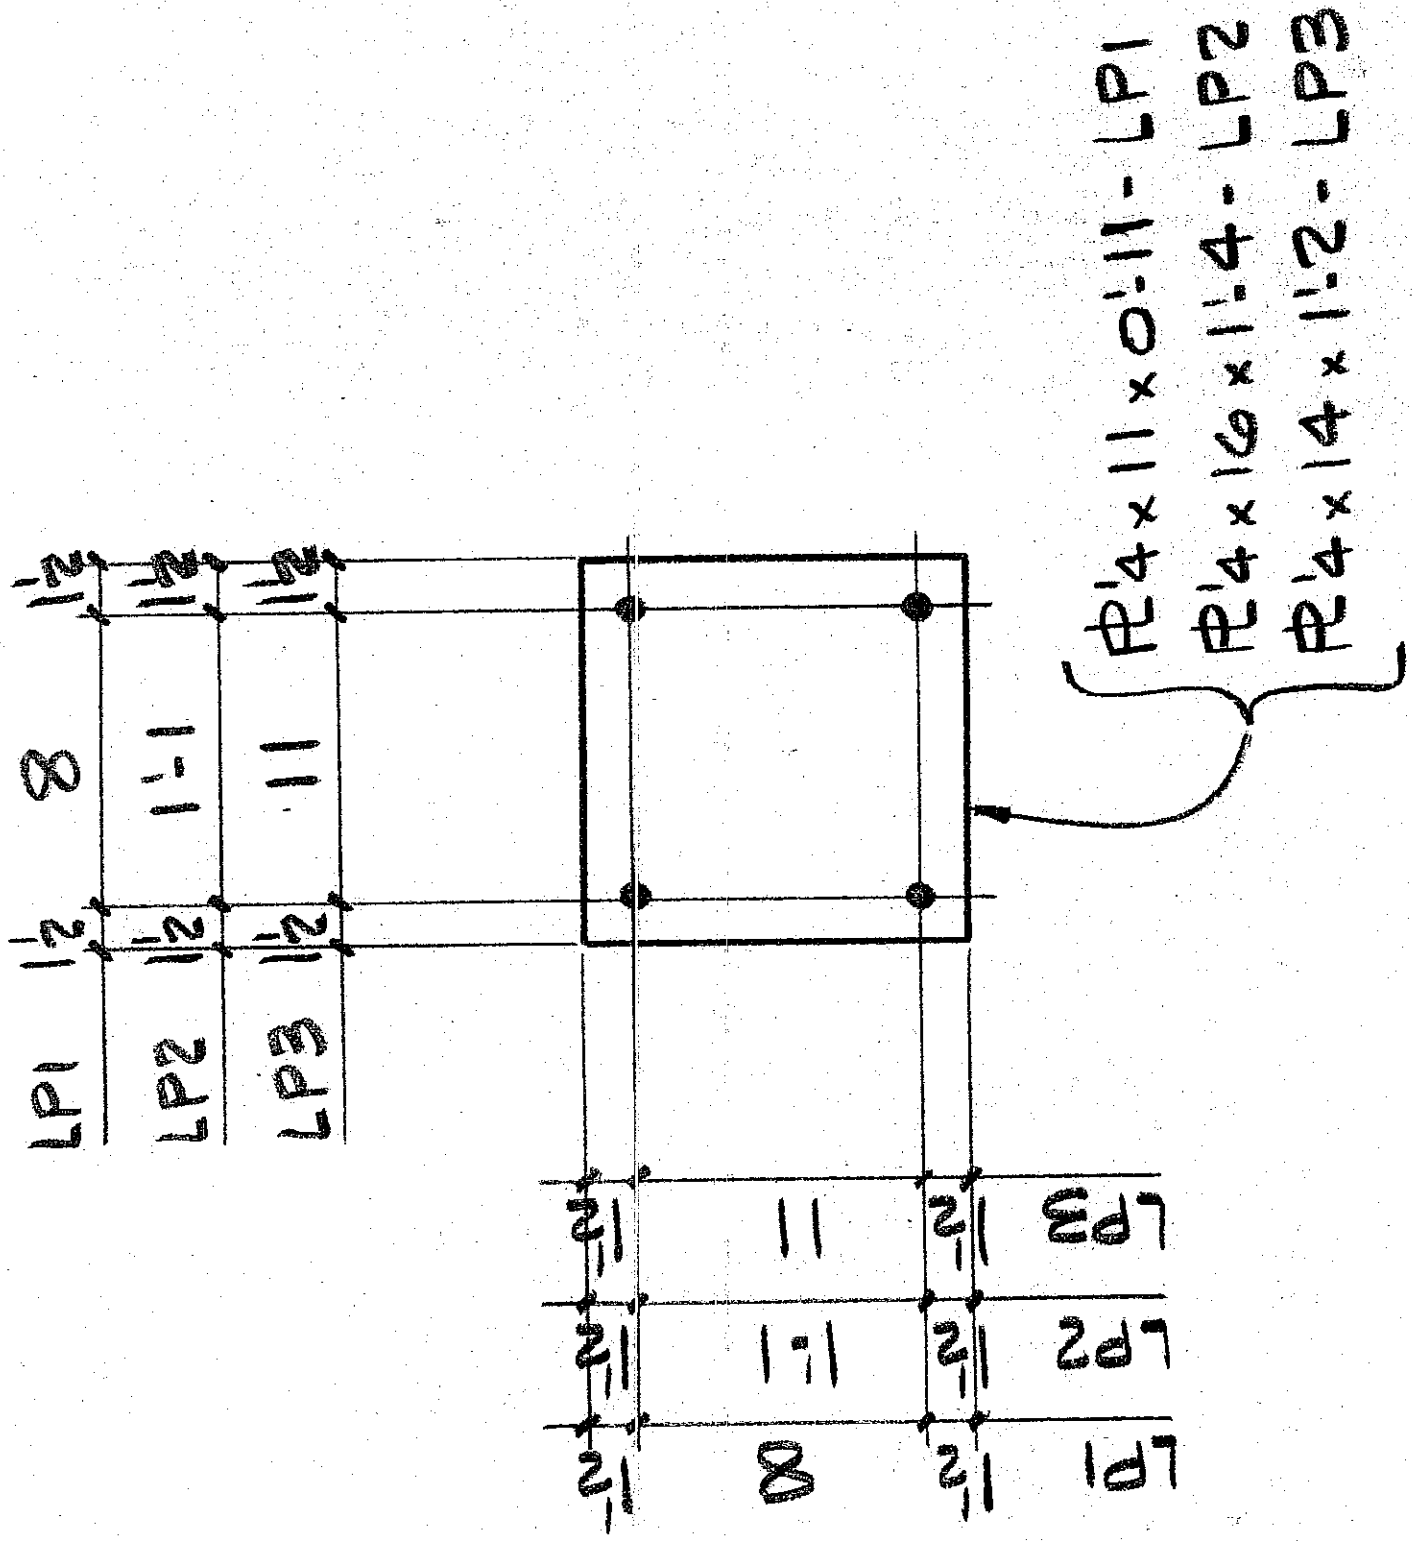


6 - LEV. PLATES - LP1		
6 -	Do	- LP2
12 -	Do	- LP3

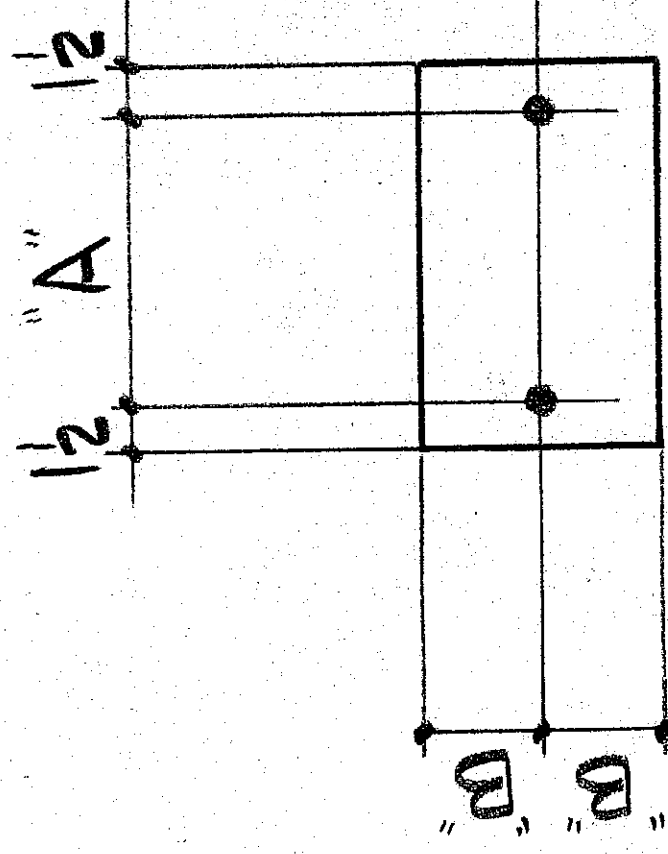


LEV. PLATE SCHEDULE				
QUAN.	PLATE SIZE	A	B	MARK
35	PL4 x 6 x 0.11	8	3	LP4
6	PL4 x 7 x 0.11	8	3 1/2	LP5
ONE	PL4 x 8 x 1.0	9	4	LP6
3	PL4 x 8 x 1.1	10	4	LP7
ONE	PL4 x 9 x 1.1	10	4 1/2	LP8

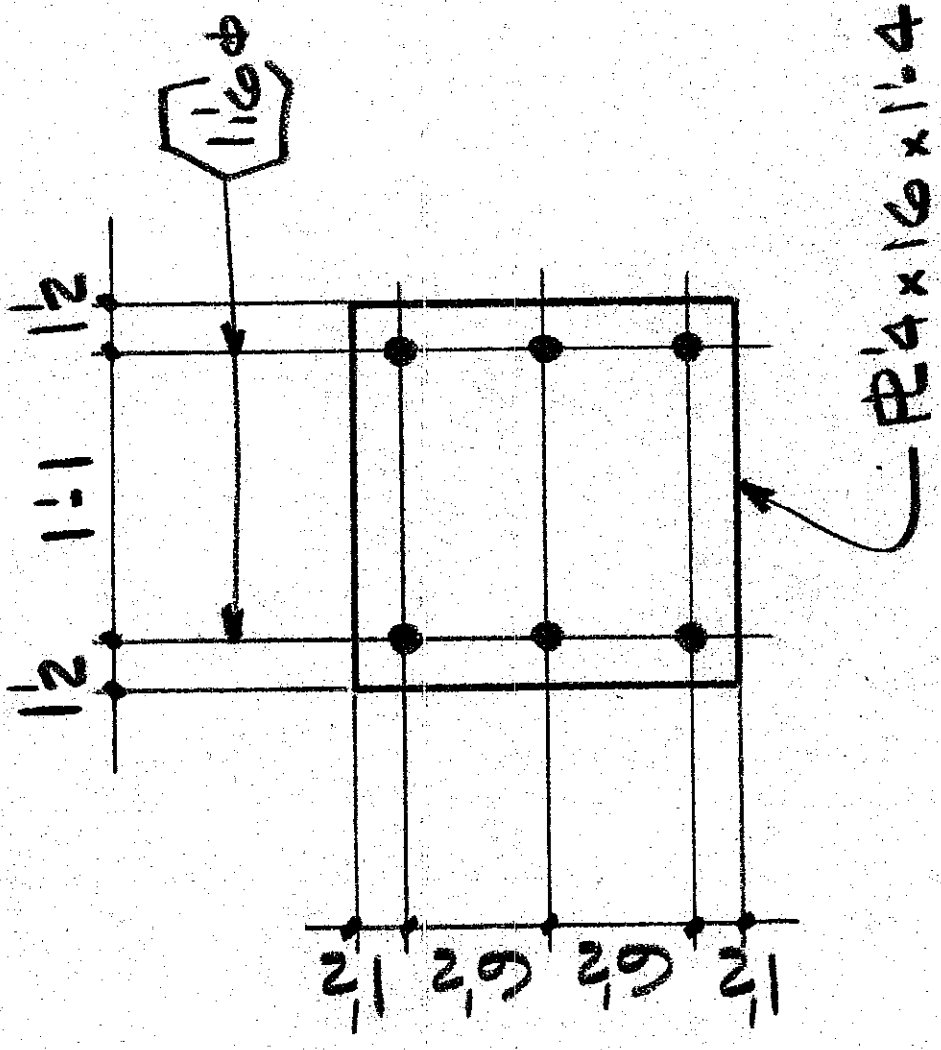

12 - LEV. PLATES - LP9

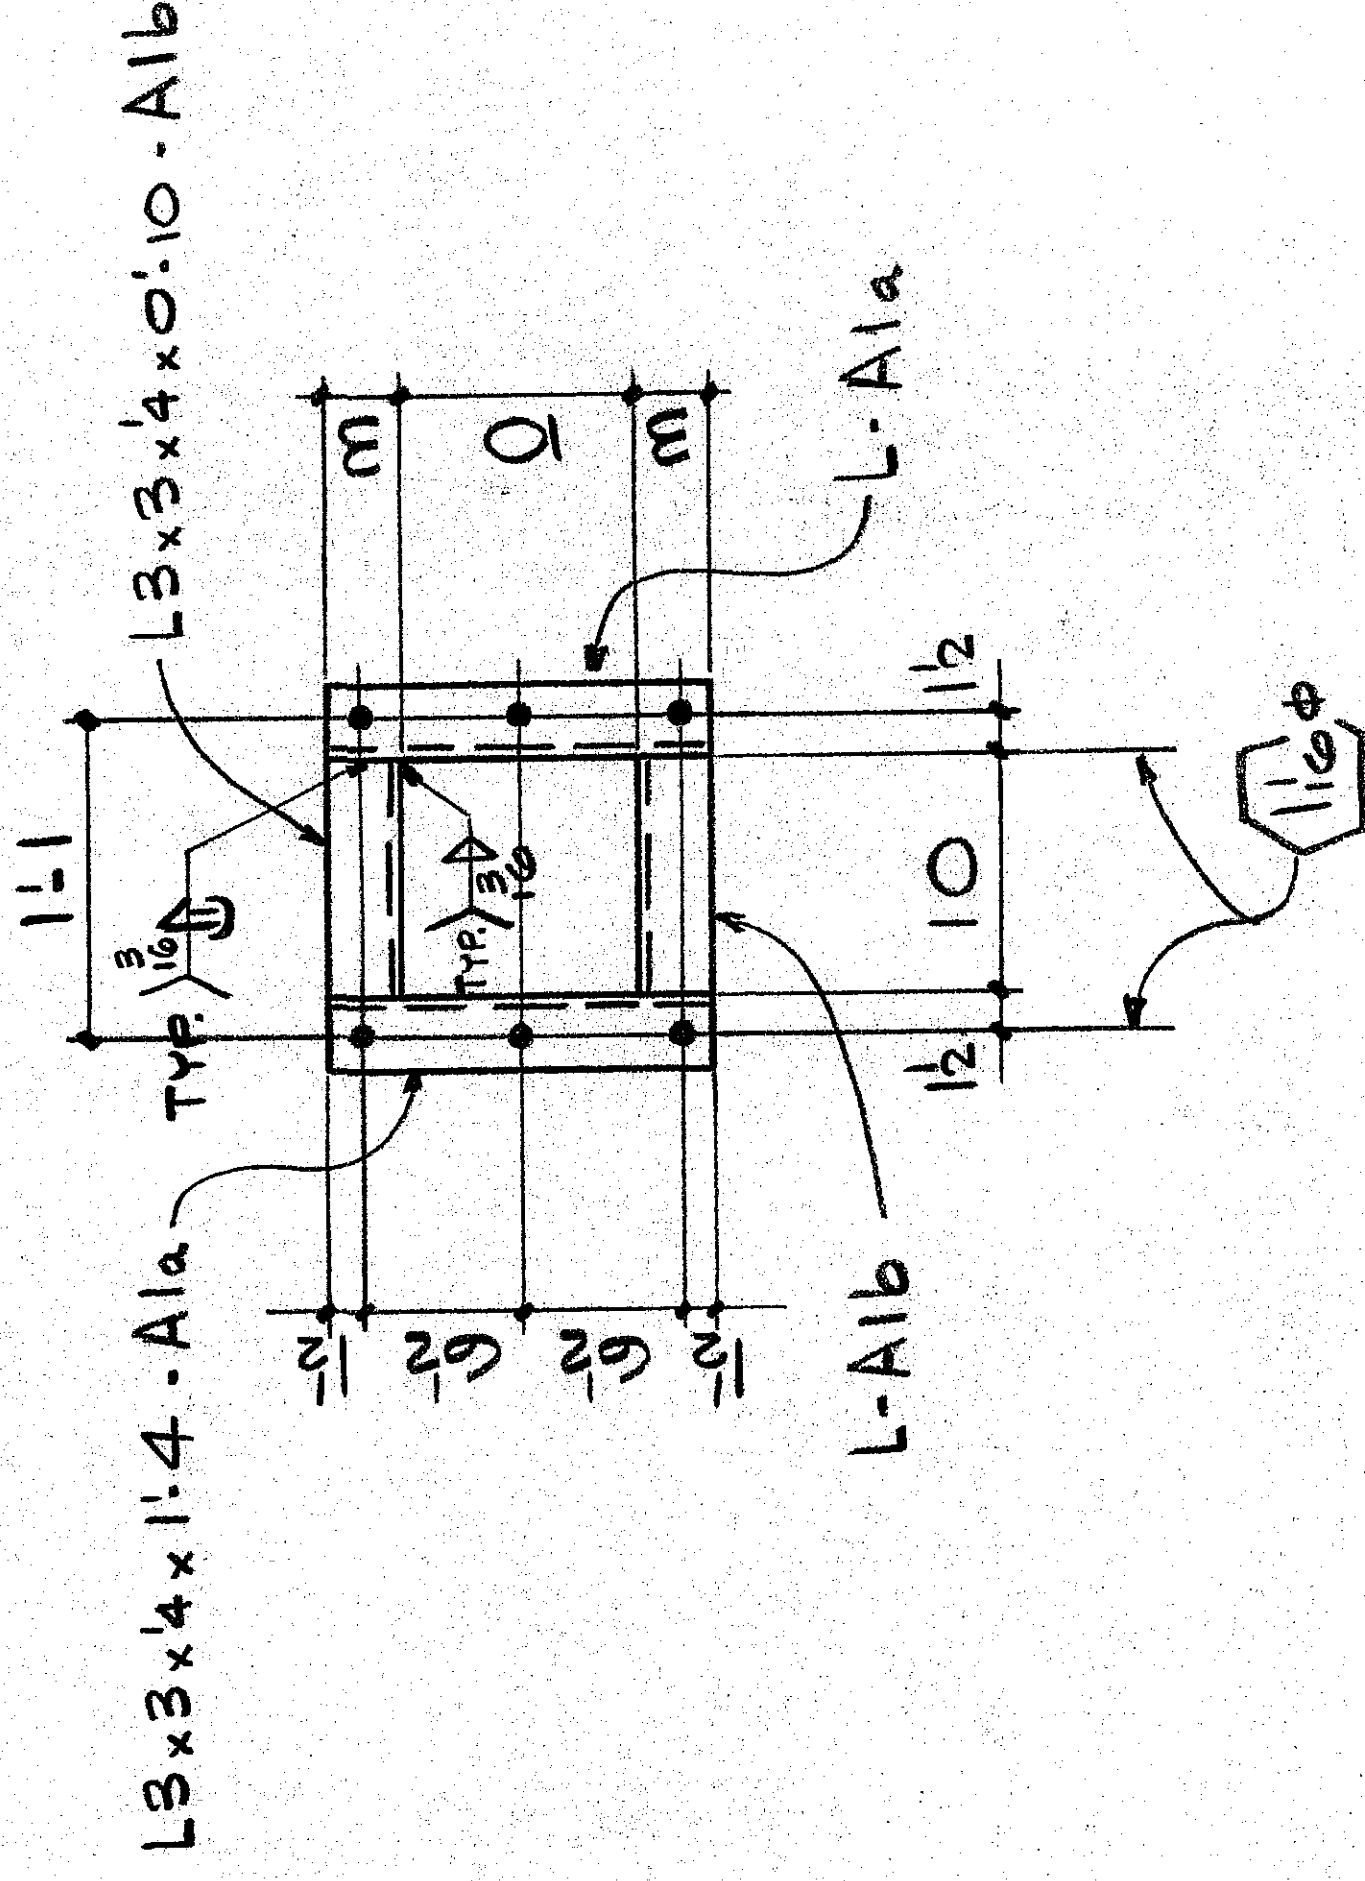


12 - FRAMES - A1

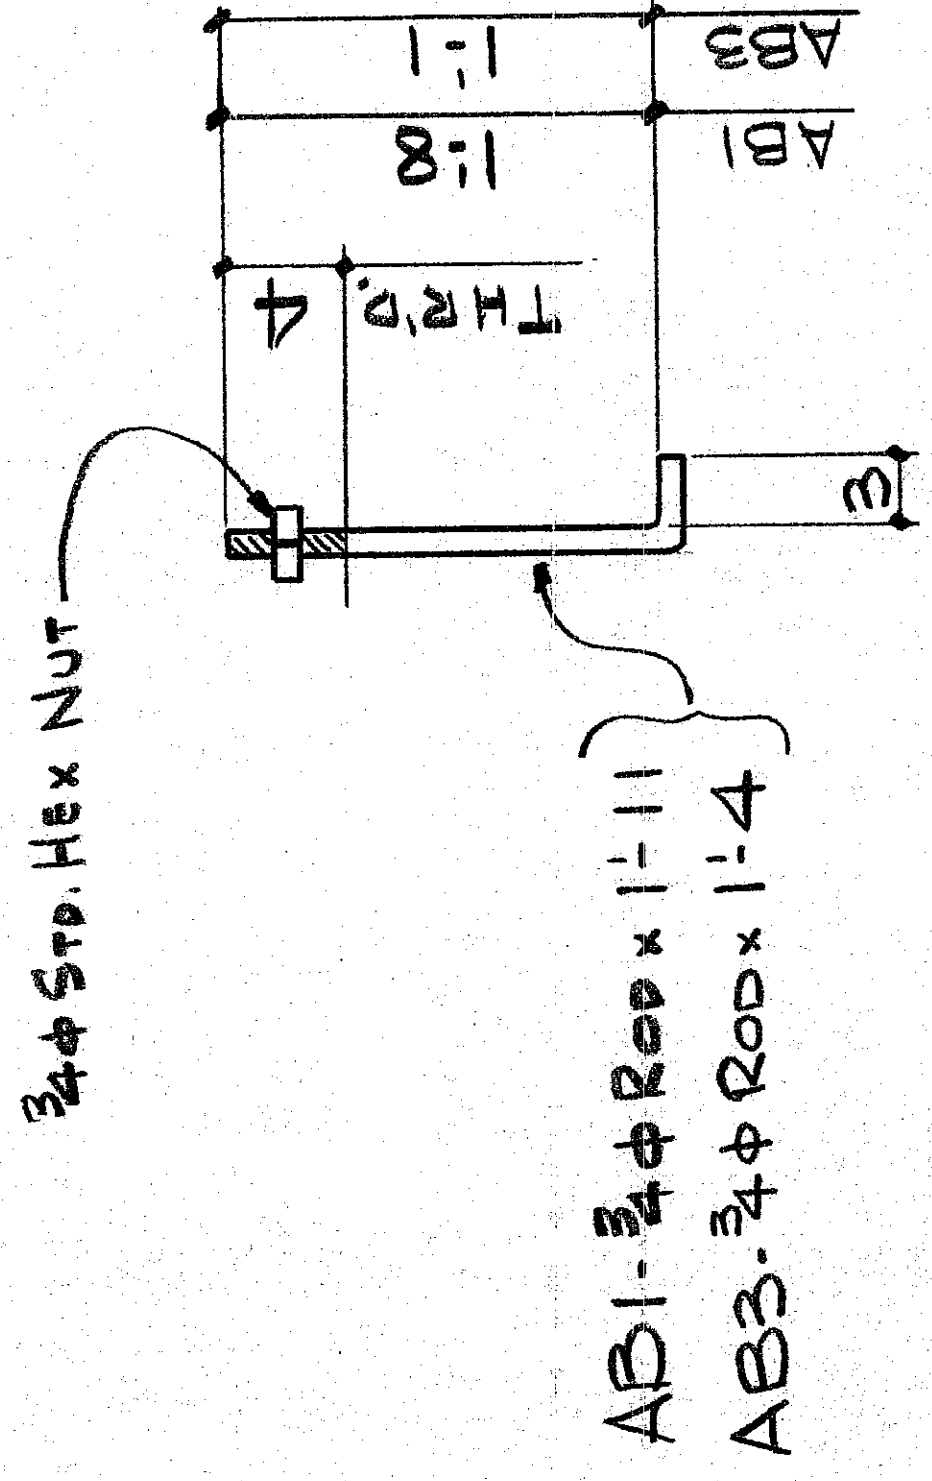

96 - ANCHOR BOLTS - AB1

92 - - AB3

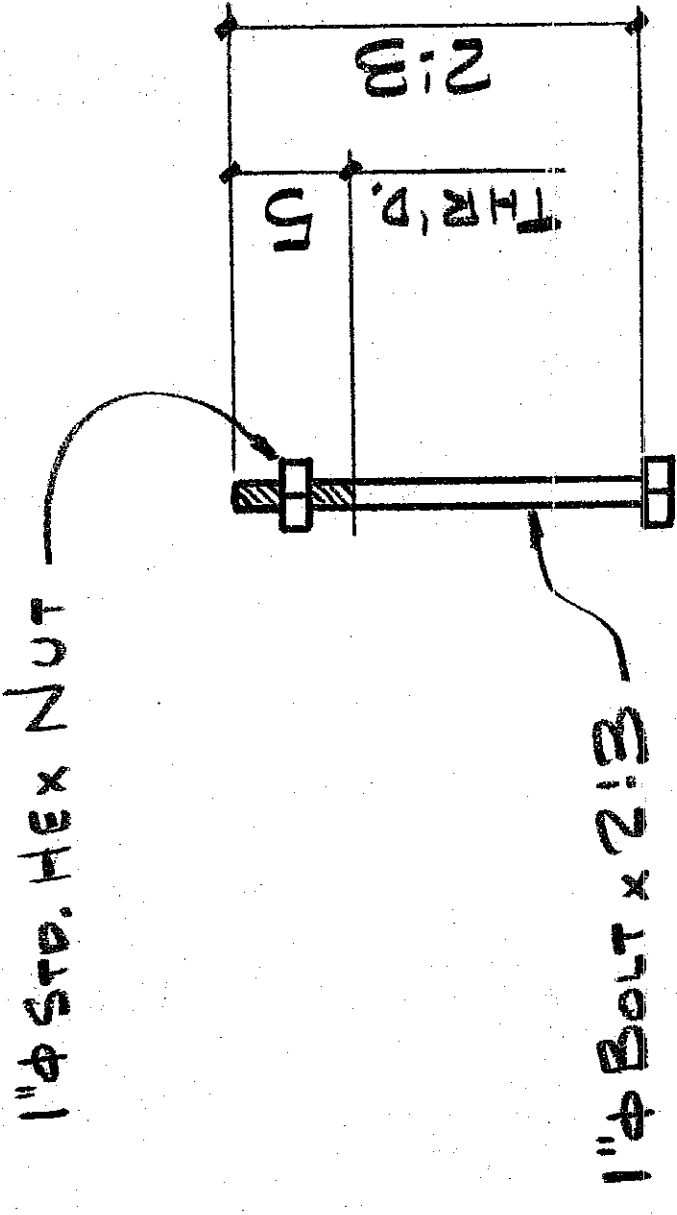

72 - ANCHOR BOLTS - AB2

APPROVED
EVERETT L BROWN CO.

BY
DATE MAR 21 1983

APPROVED DRAWINGS
FOR FIELD USE
DATE MAR 21 1983

ISSUE	#BP	FOR	DATE	BY	DESCRIPTION	REV	DATE	MADE BY
1	3	ALL	10.4.81	SS				
2	4	FIELD	3/4/83	AA				

INTERSTATE WELDING & FABRICATION, INC. 1970 DAVIS AVENUE • TERRE HAUTE, INDIANA 47602	DWN BY WJK
JACKSON ELEMENTARY School CHESTERTON, INDIANA	CHK'D BY P.
	JOB # 0300
	SHT # 1