
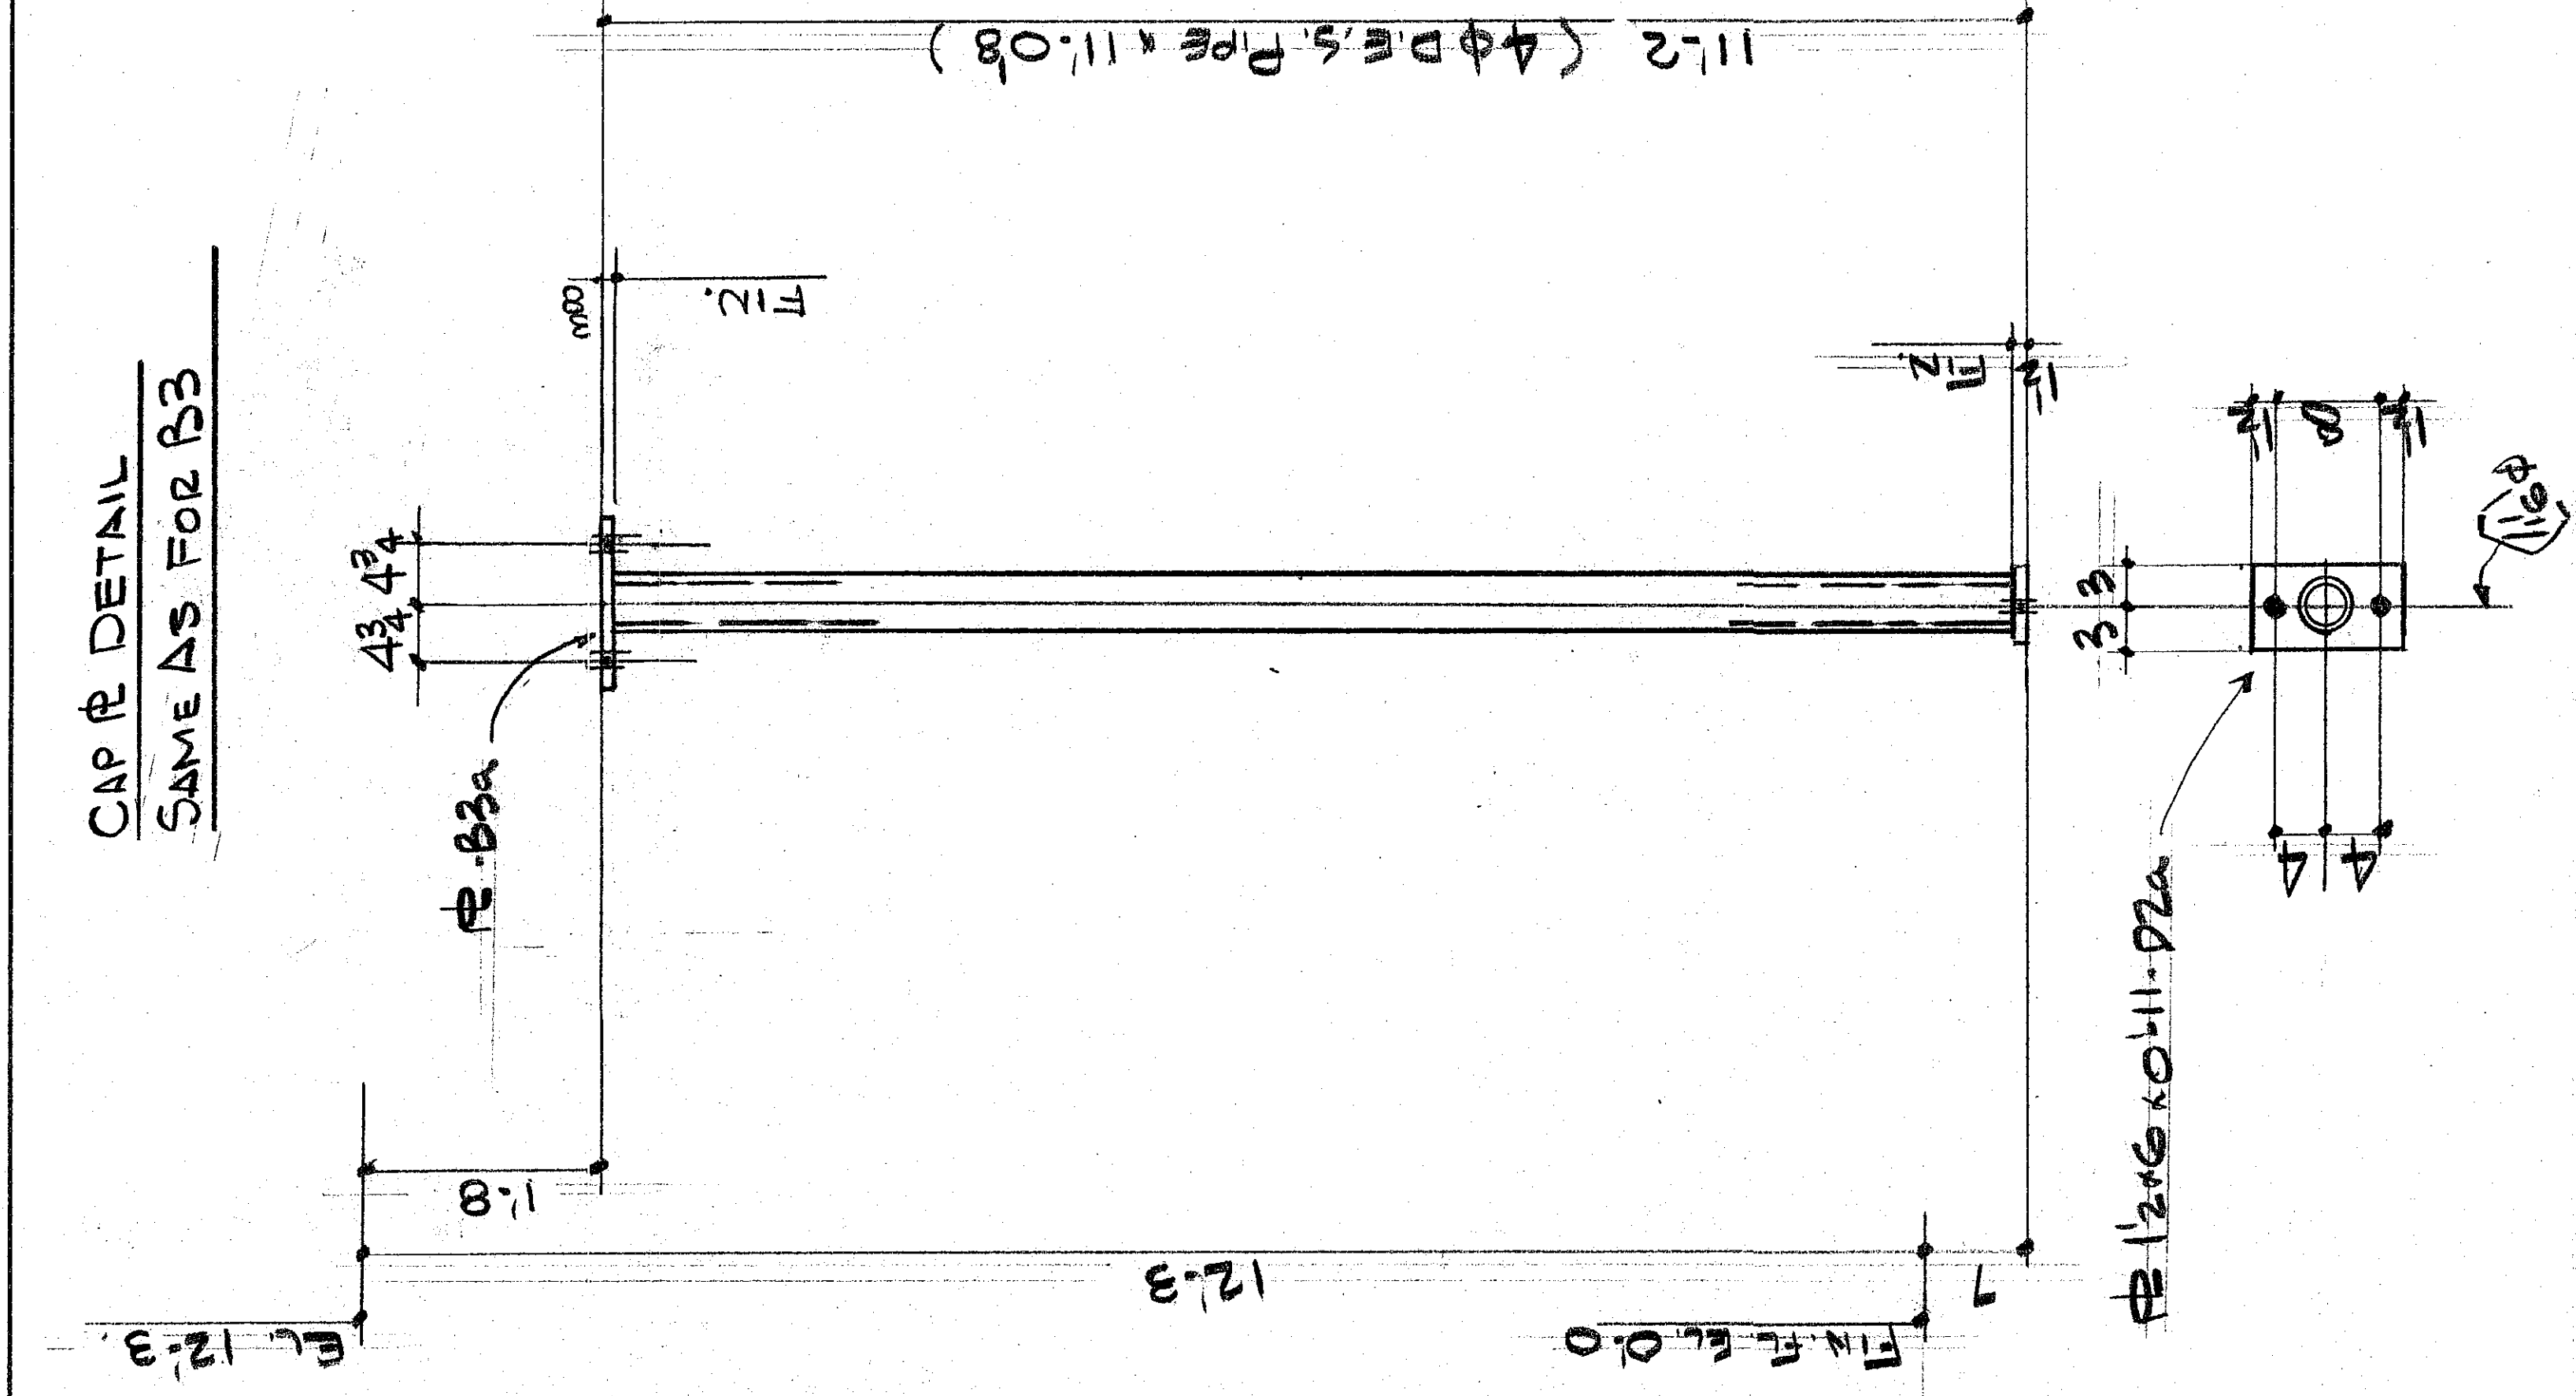
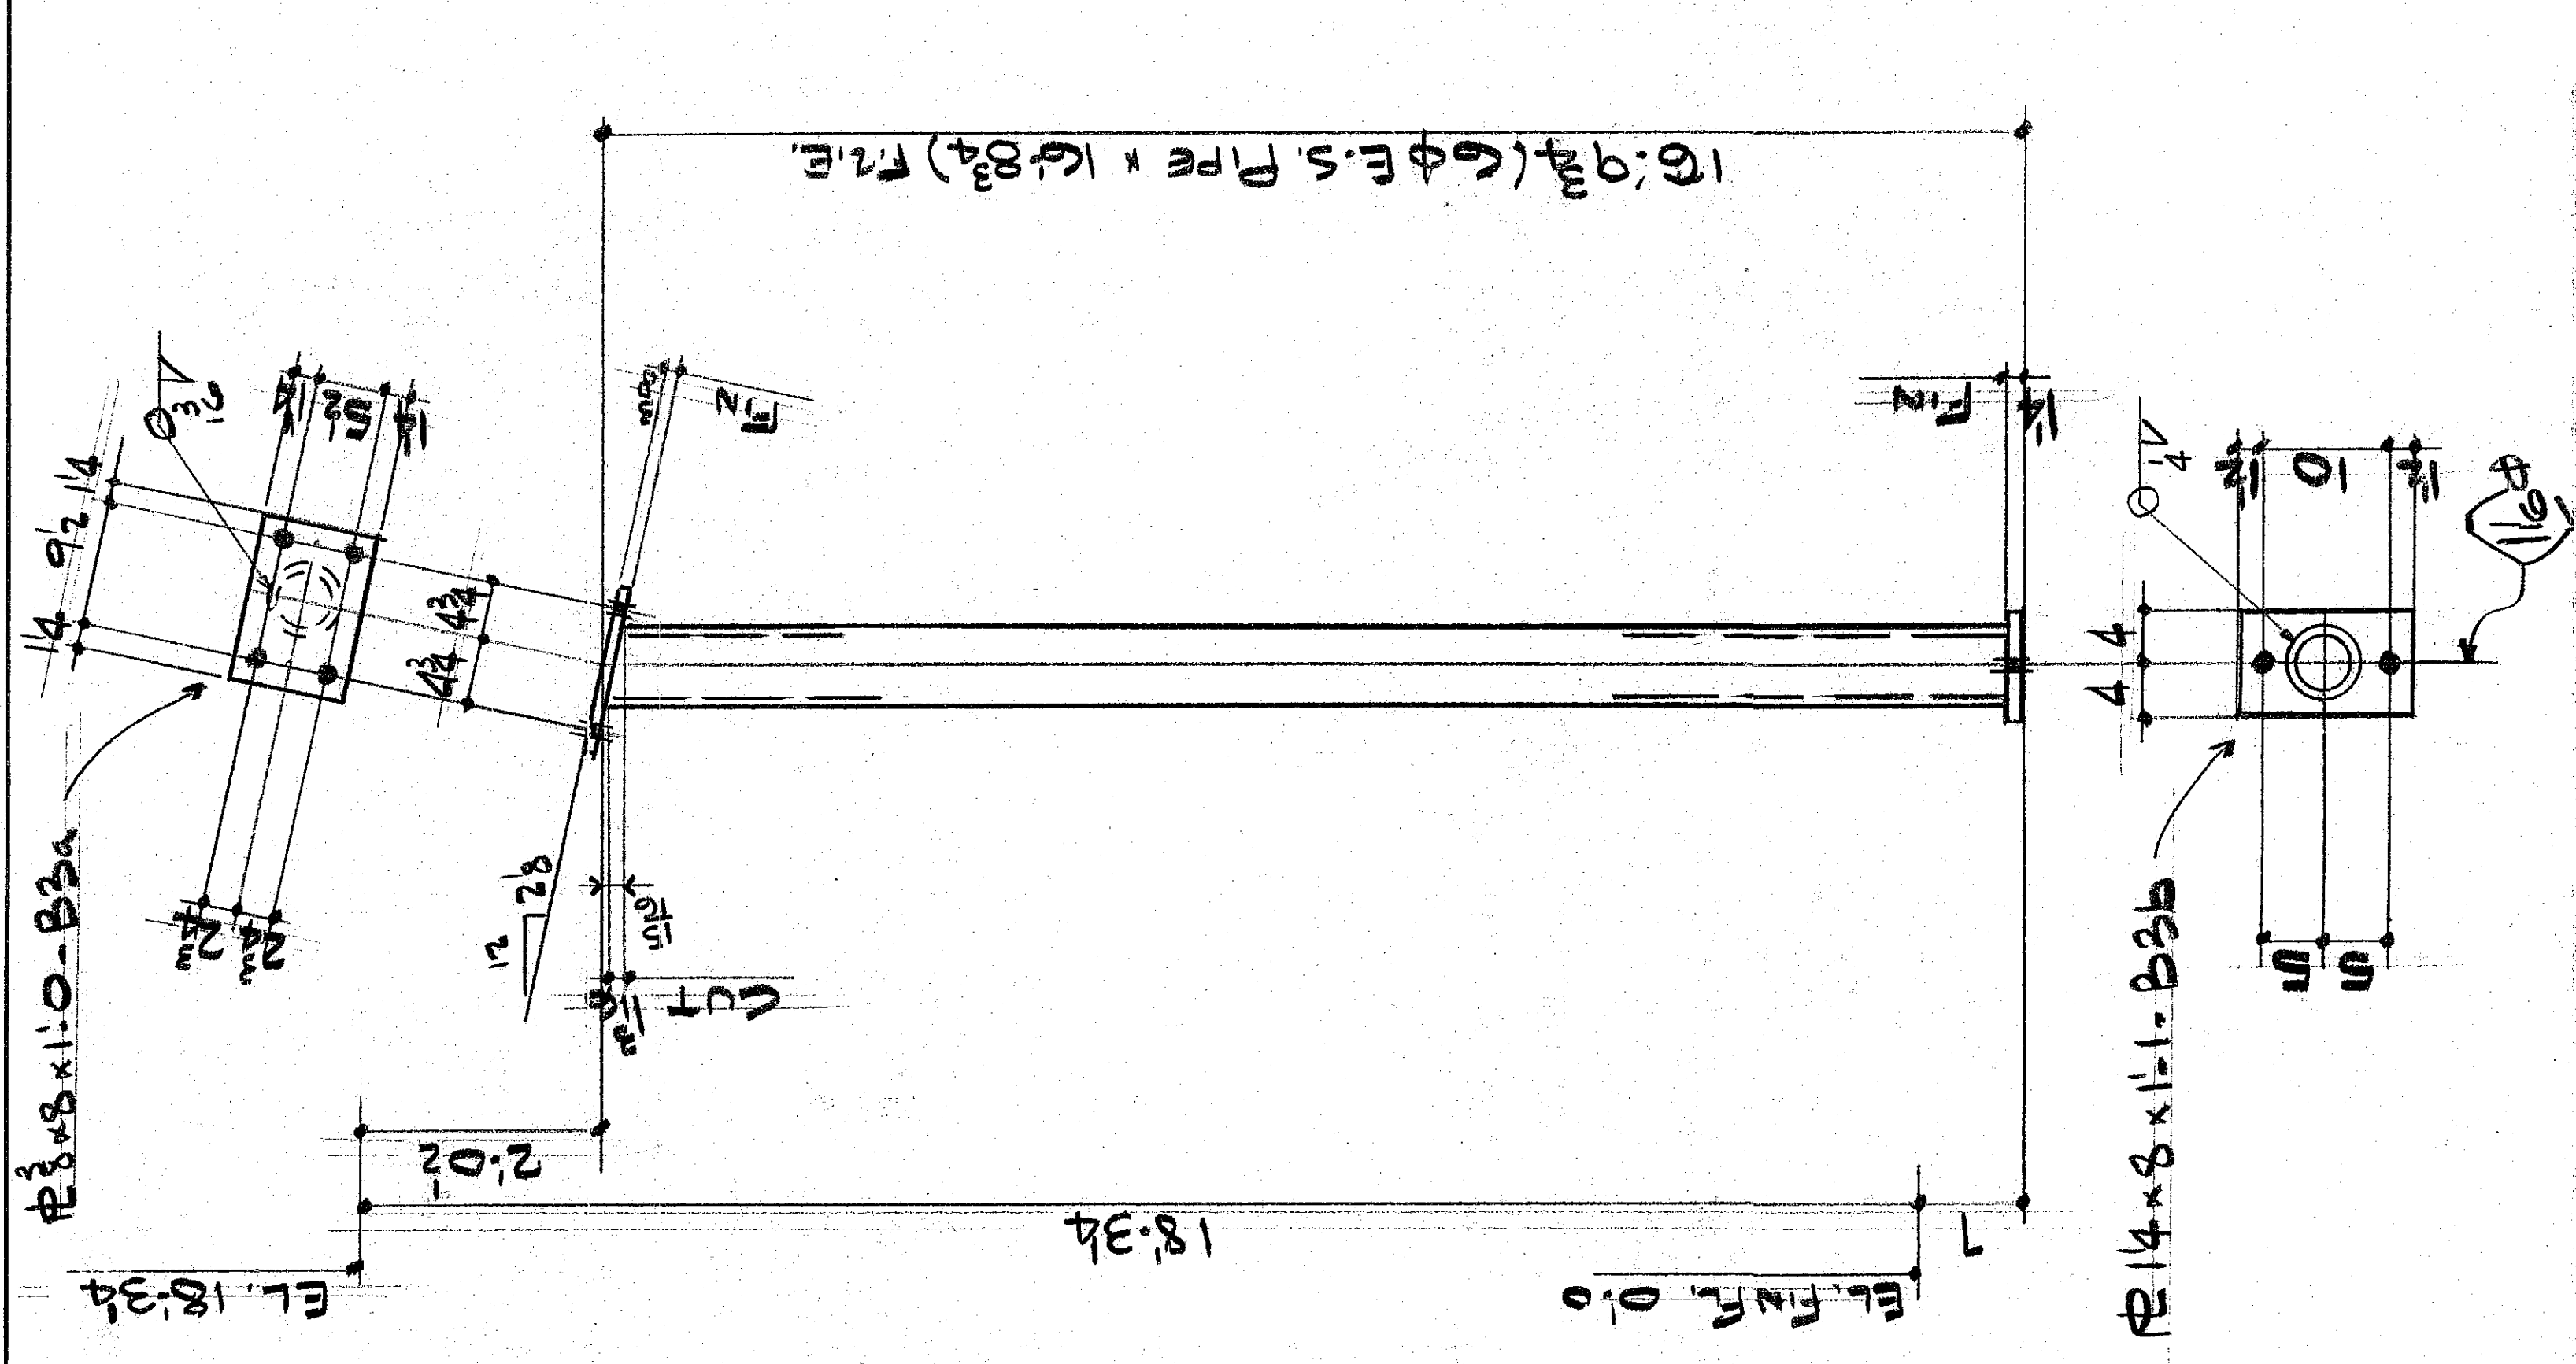


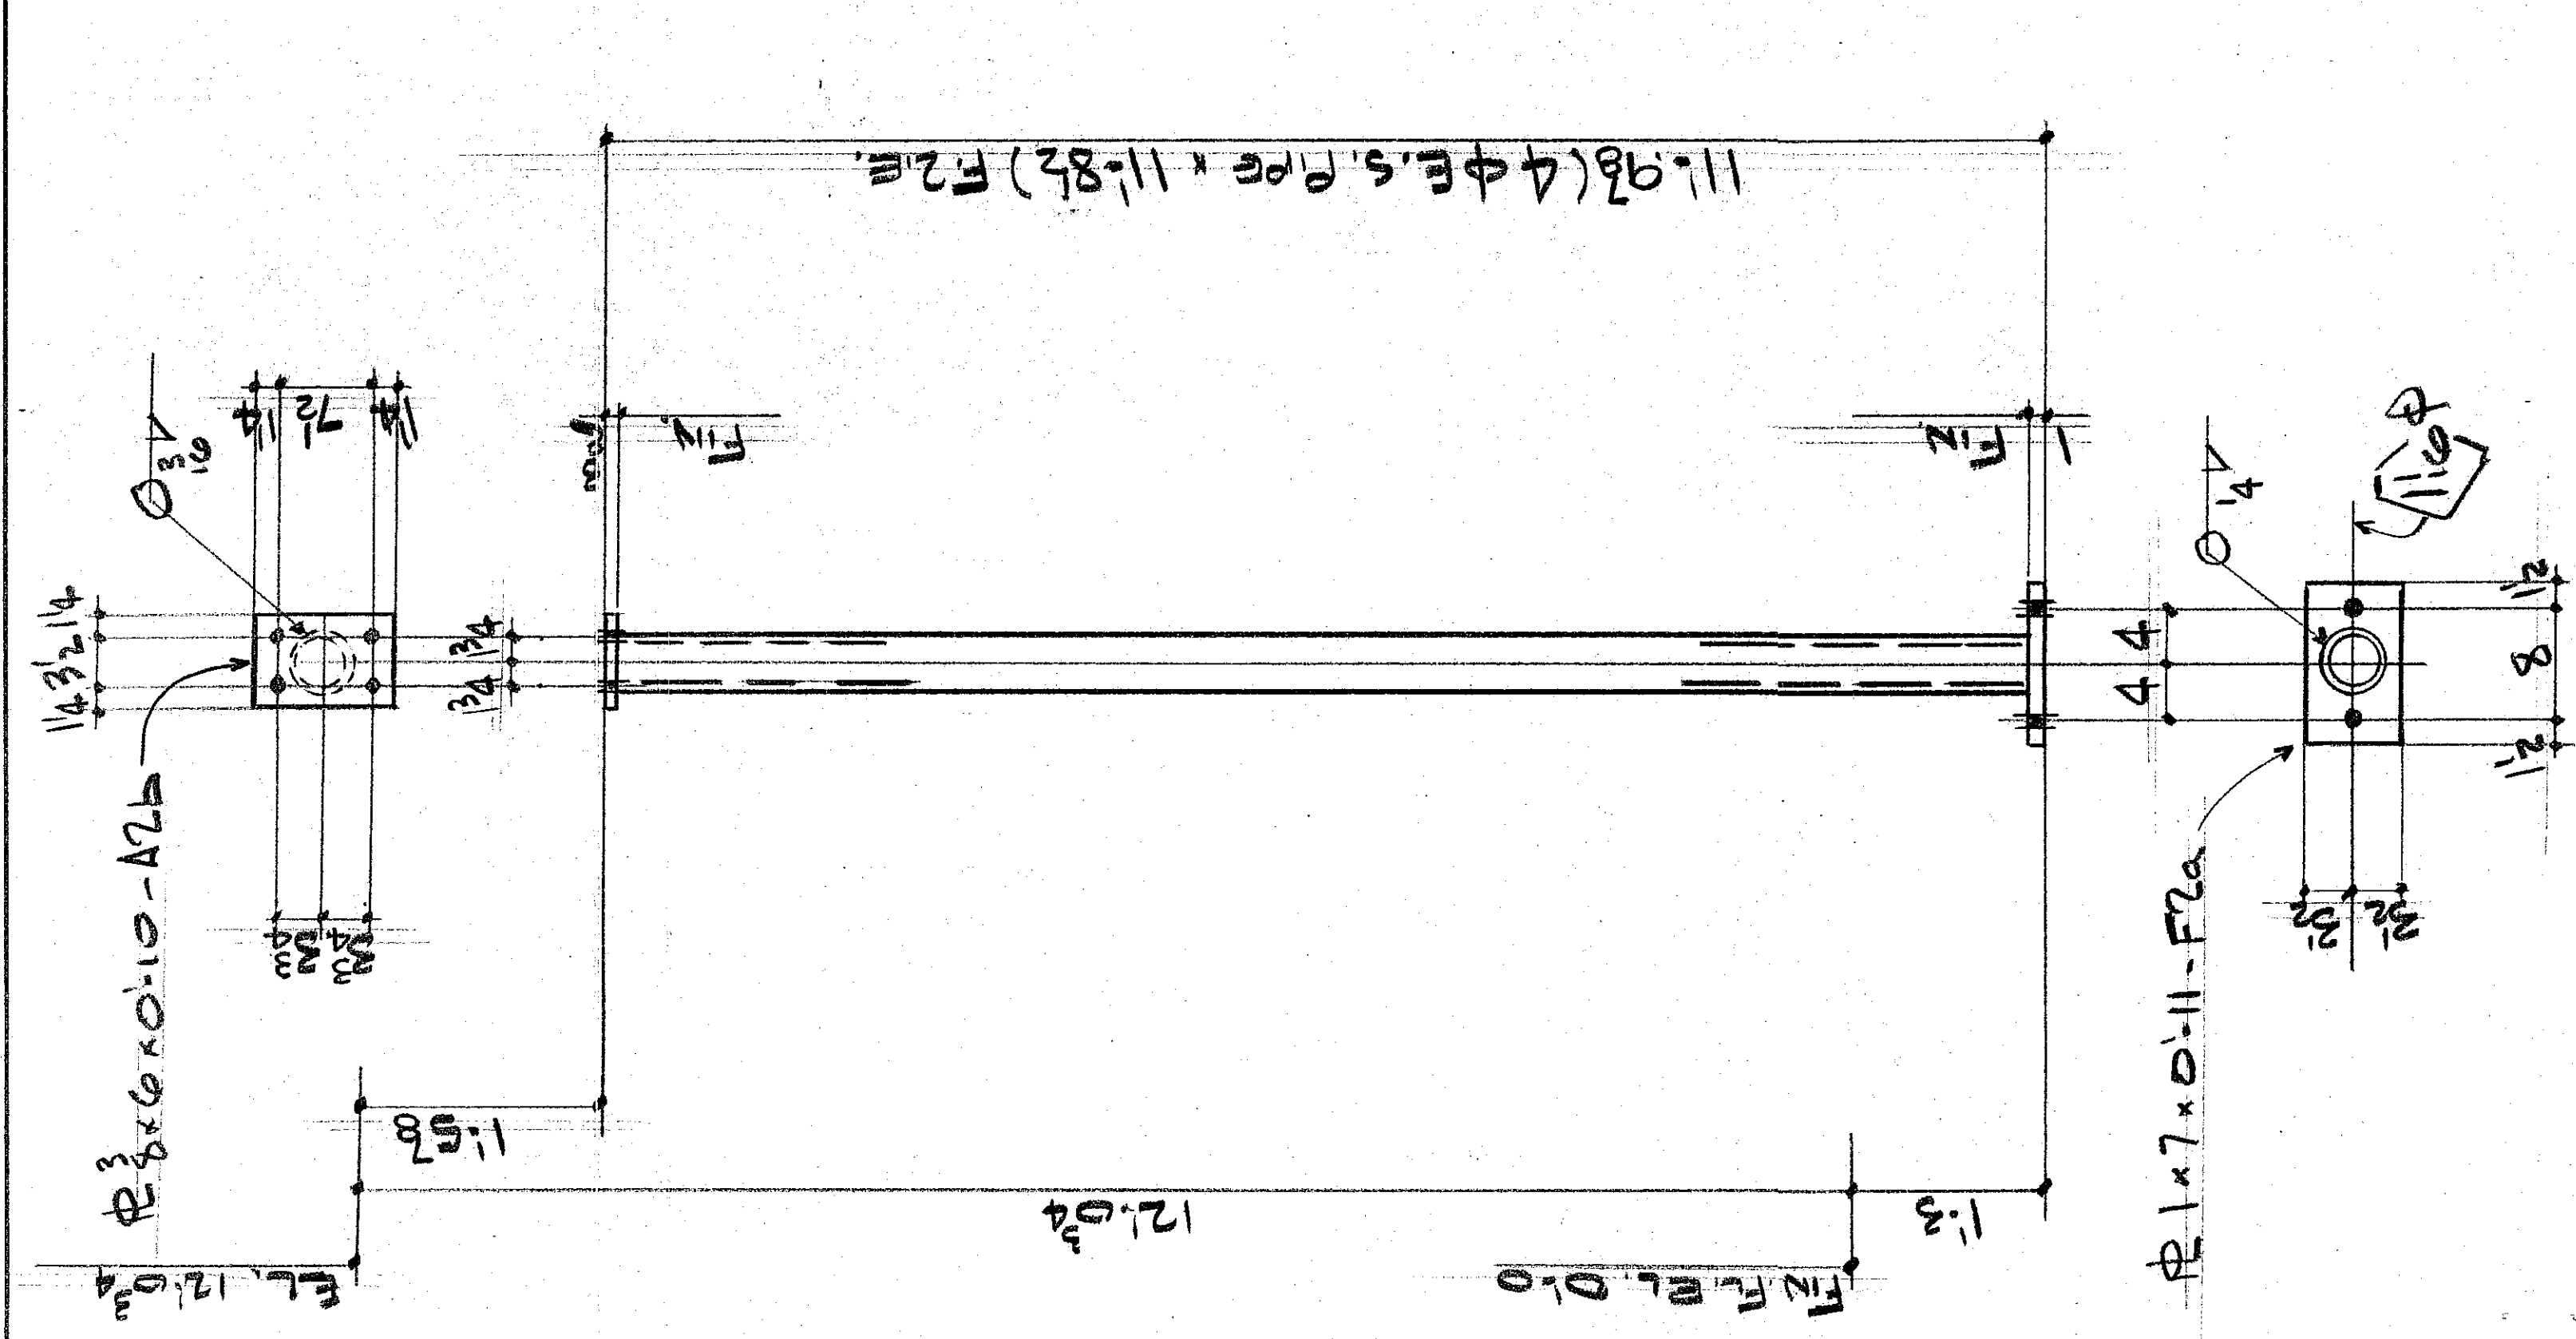

CAP & DETAIL
SAME AS FOR B3

2-COLUMNS-A3 (UNIT B)

2-COLUMNS-B3 (UNIT A)



2-COLUMNS-C3 (UNIT A)

APPROVED
EVERETT I. BROWN CO.

BY: 
DATE: MAR 21 1983
APPROVED DRAWINGS
FOR FIELD USE
DATE: MAR 21 1983

ISSUE	#BP	FOR	DATE	BY	DESCRIPTION	REV	DATE	DESCRIPTION	REF. DWGS.	NO. OF	SHT. #
1	128	APP	11/2/55								1
2	384	APP	11-3	SS							2
3	1	FAB	9/9/54	AA							3
4	4	FAB	9/9/54	AA							4
CLEAN G.											5

INTERSTATE WELDING & FABRICATION, INC.
1070 DAVIS AVENUE • TERRE HAUTE, INDIANA 47602

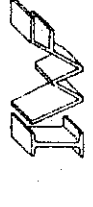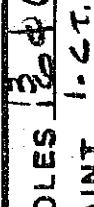OWN BY: 
CHECKED BY: 
JOB # 6300
PAINT 1-2-1 600
MAB - 6000
CLEAN G.