




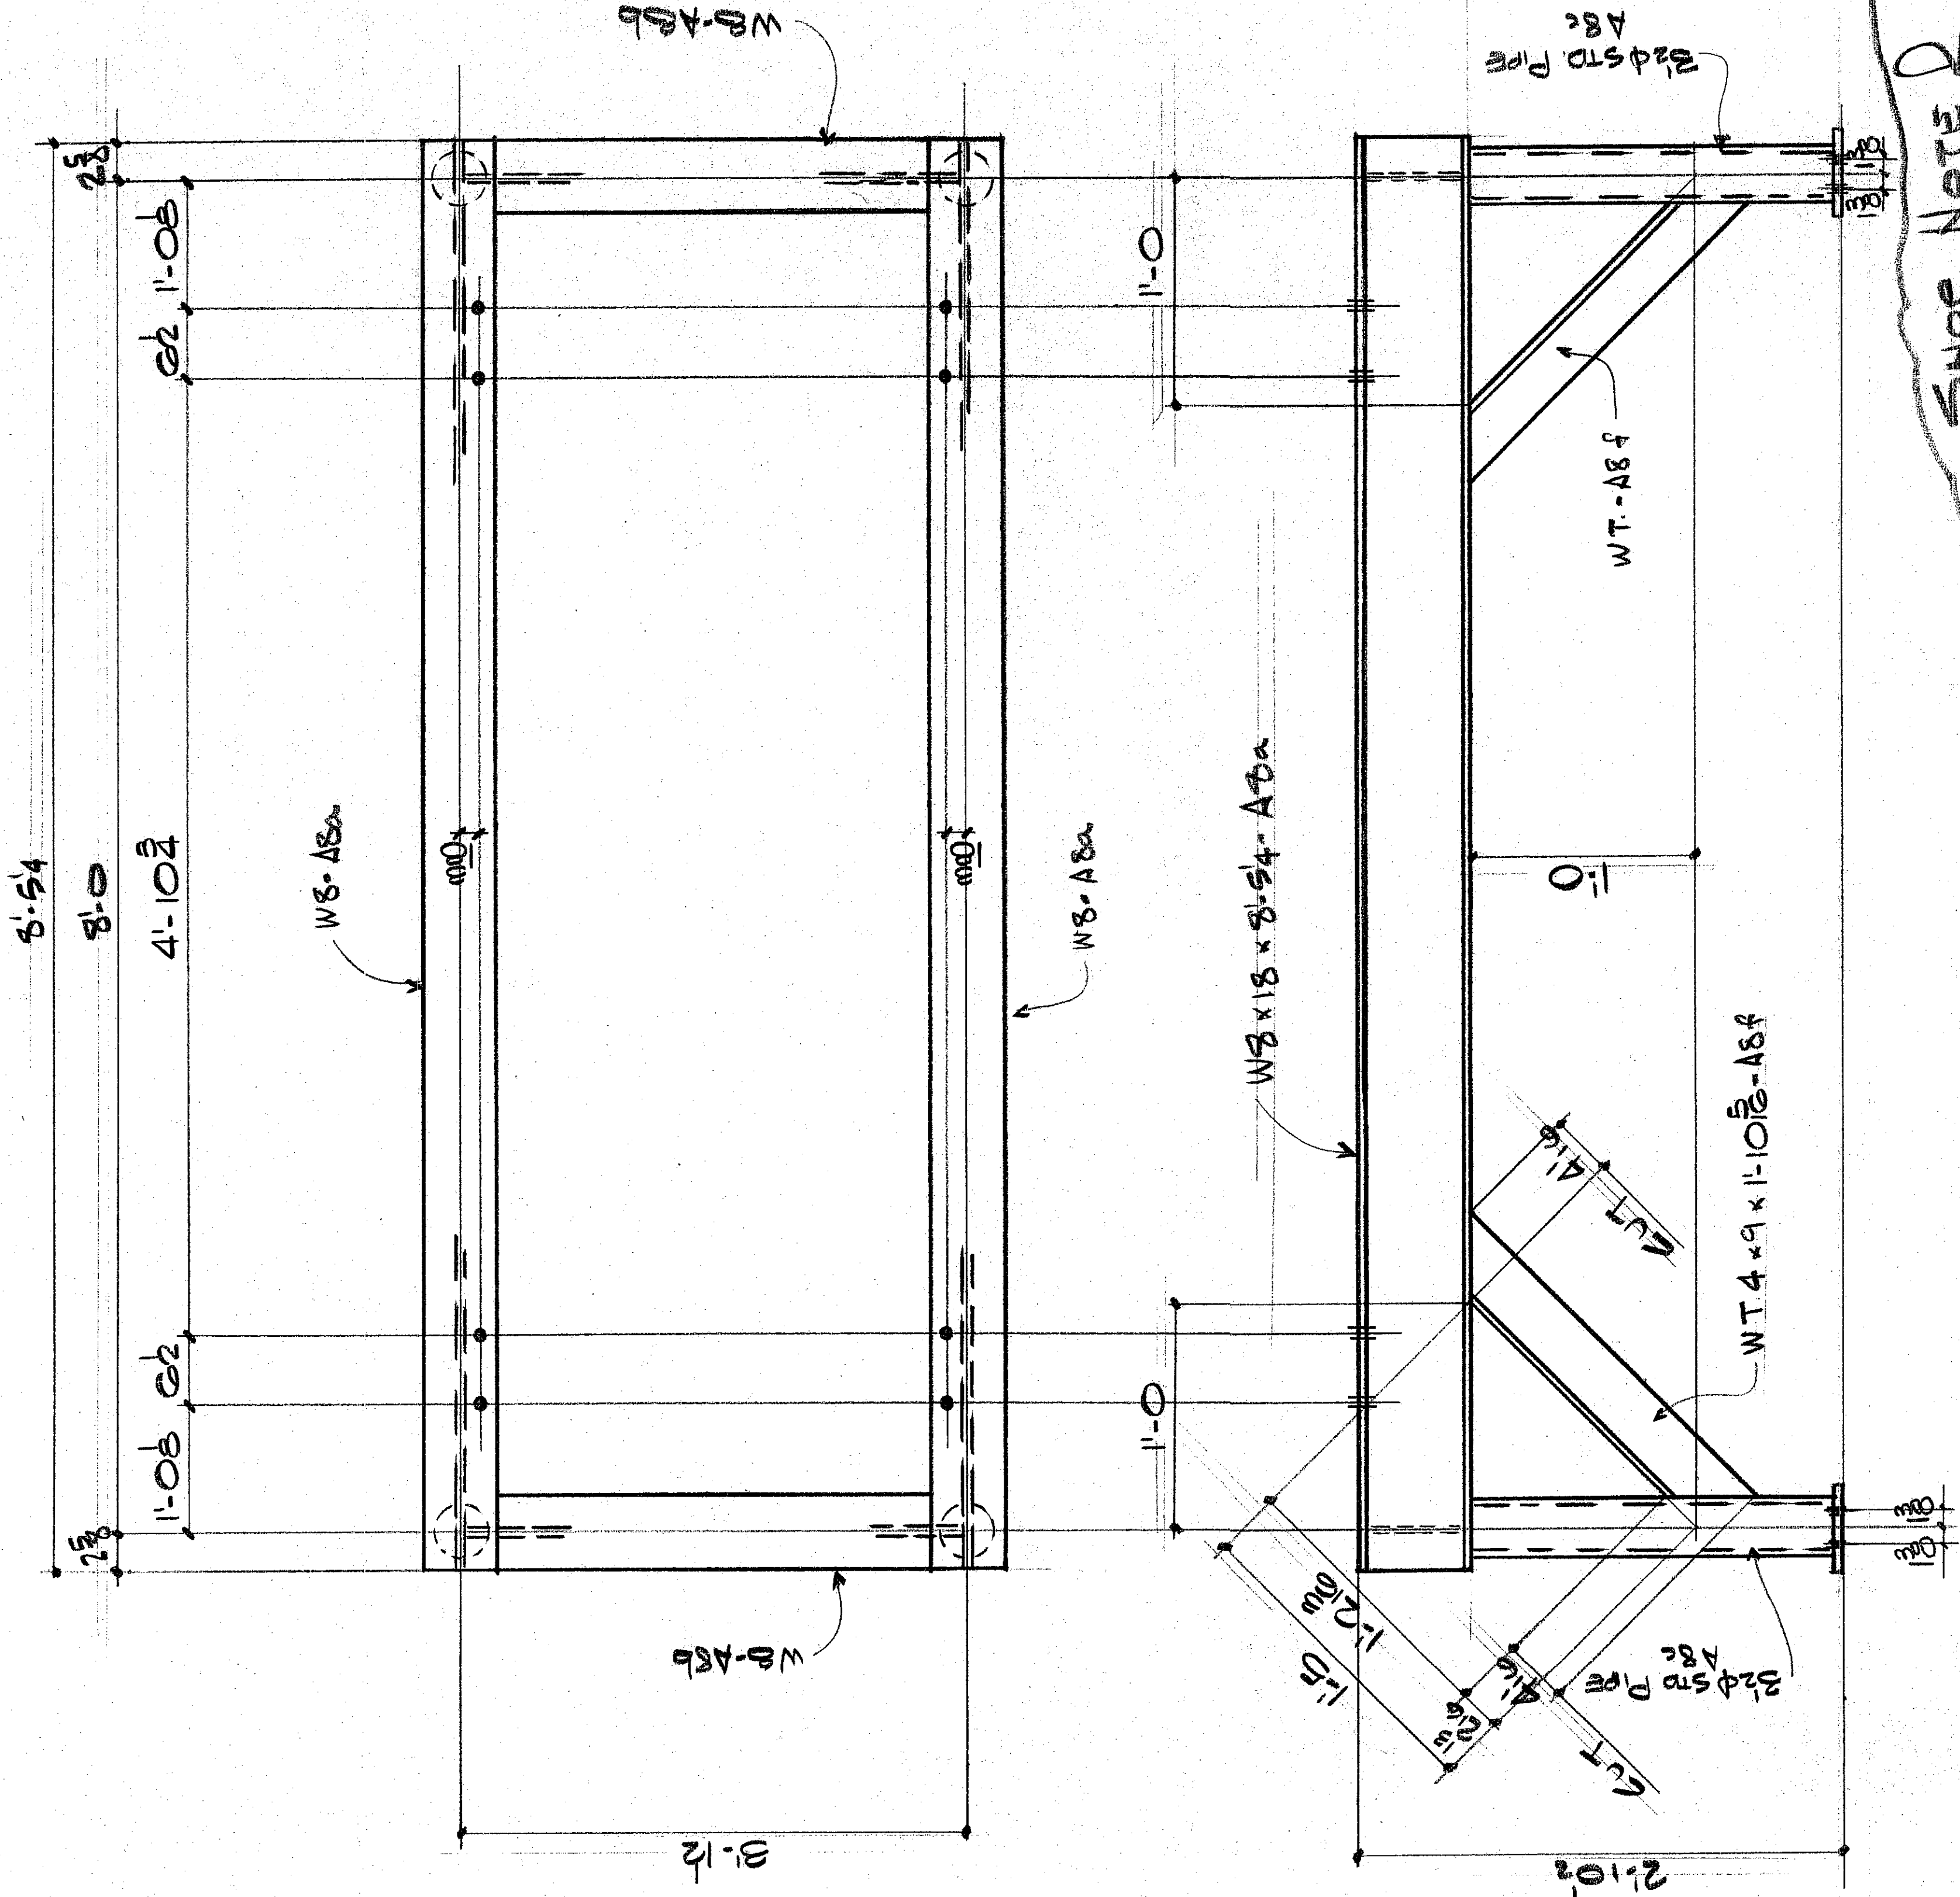

ONE-FRAME-A8

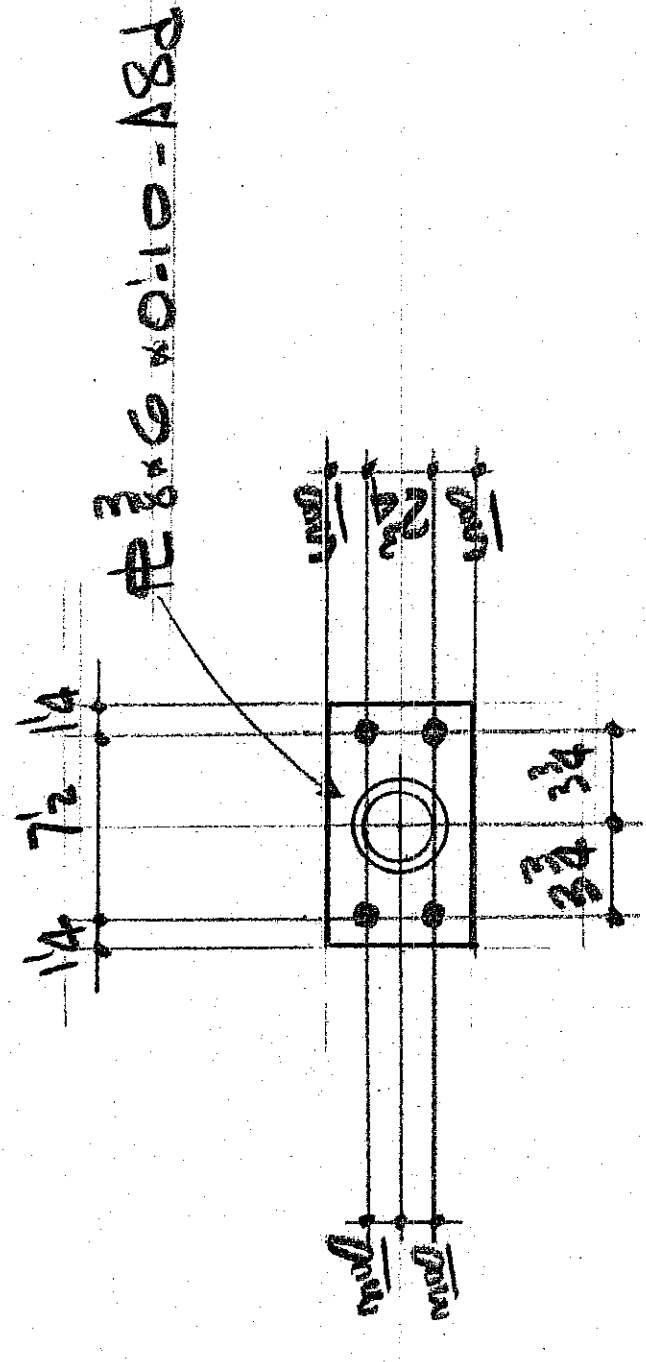

SECTION A-A

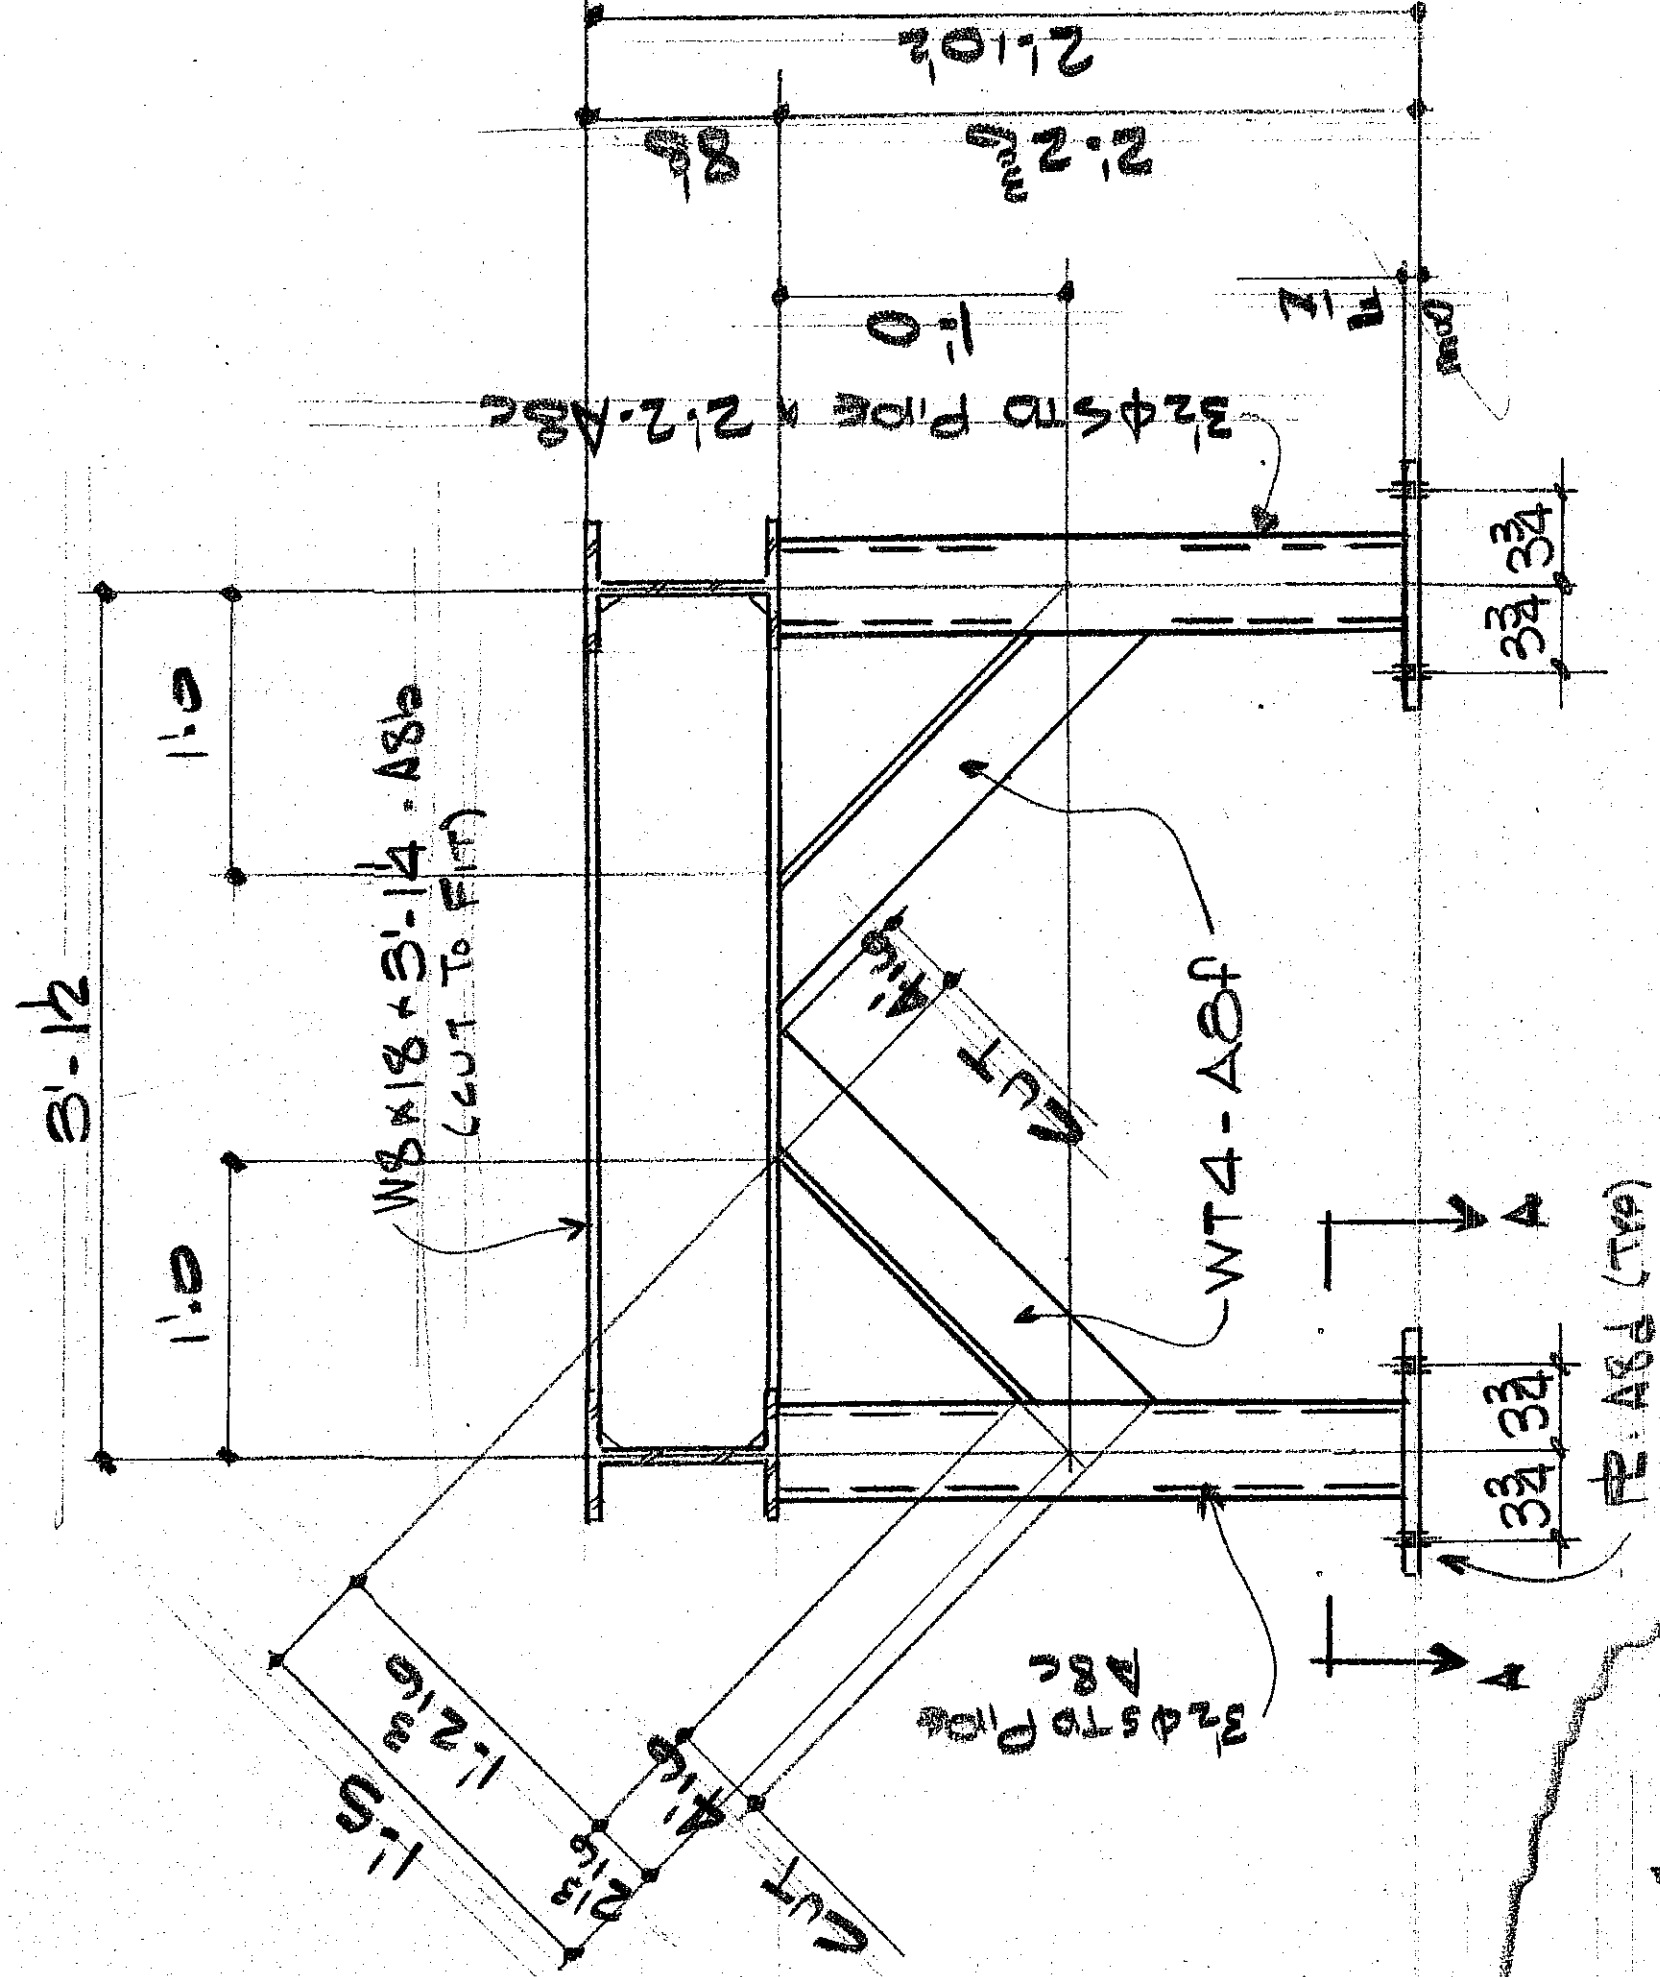

SHOP NOTE:
FRAME TO BE ALL WELDED CONSTR.

APPROVED
EVERETT I. BROWN CO.

BY: [Signature]
DATE: MAR 21 1983

APPROVED DRAWINGS
FOR FIELD USE
DATE: MAR 21 1983

UNIT A				INTERSTATE WELDING & FABRICATION, INC.			
DWN BY				1670 DAVIS AVENUE • TERRE HAUTE, INDIANA 47602			
CHK'D BY				JACKSON ELEMENTARY SCHOOL			
JOB #				6200			
SHT #				8			
HOLE				1-CT 1-CT 1-CT 1-CT			
PAINT				MA6-60802			
CLEAN G.				REF DWGS.			
REV				DATE			
DESCRIPTION				MADE			
1	1/12	APPROVAL	SS	1	1/12	APPROVAL	SS