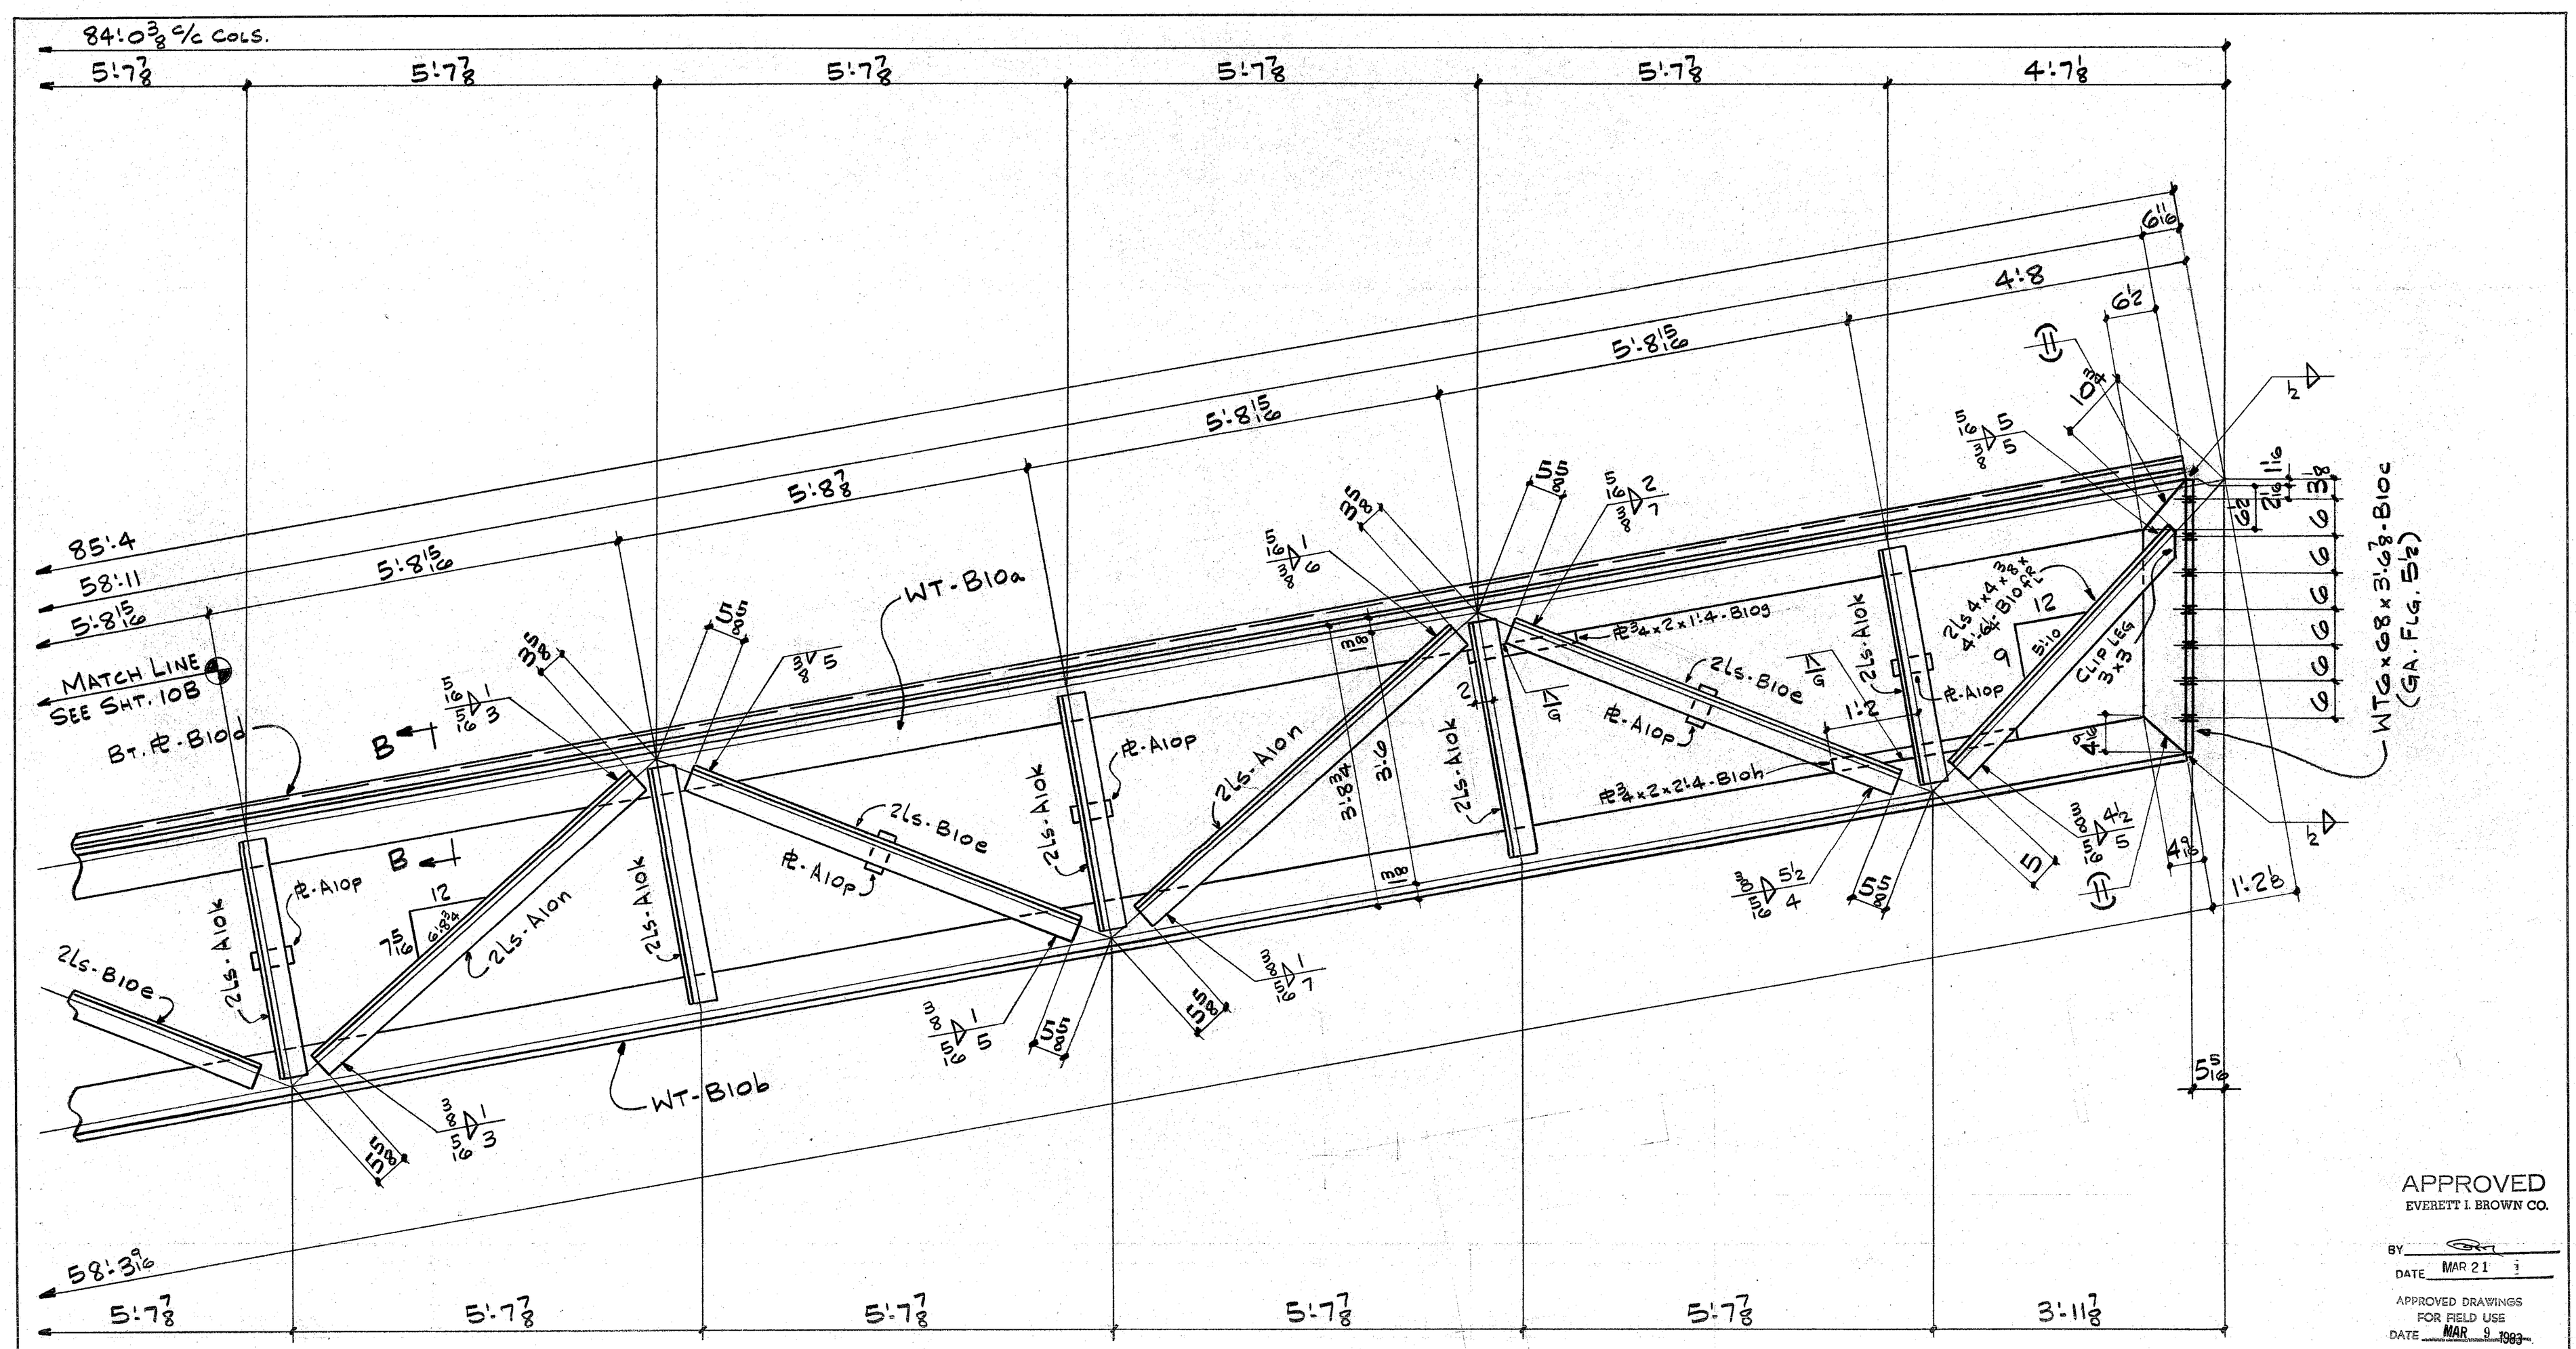

APPROVED
EVERETT I. BROWN CO.
BY
DATE MAR 21
APPROVED DRAWINGS FOR FIELD USE
DATE MAR 9 1983

SHOP NOTE!
WORK THIS SHEET
W/ SHEETS 10A, 10B & 10D

83-R-10C

ISSUE	#BP	FOR	DATE	BY
1	3BL	APP	11-3	SS
2	1	FAB		
3	1	FAB		SB
4	4	Field	3/9/83	AA

REV.	DATE	DESCRIPTION	MADE BY

INTERSTATE WELDING & FABRICATION, INC.
1670 DAVIS AVENUE • TERRE HAUTE, INDIANA 47802

HOLES 13/20 Φ
PAINT 1-CT. RED MAB-60802
CLEAN'G.
REF. DWG'S.

JACKSON ELEMENTARY SCHOOL

DWN. BY WK
CHK'D. BY B.
JOB # 6300
SHT. # 10C