



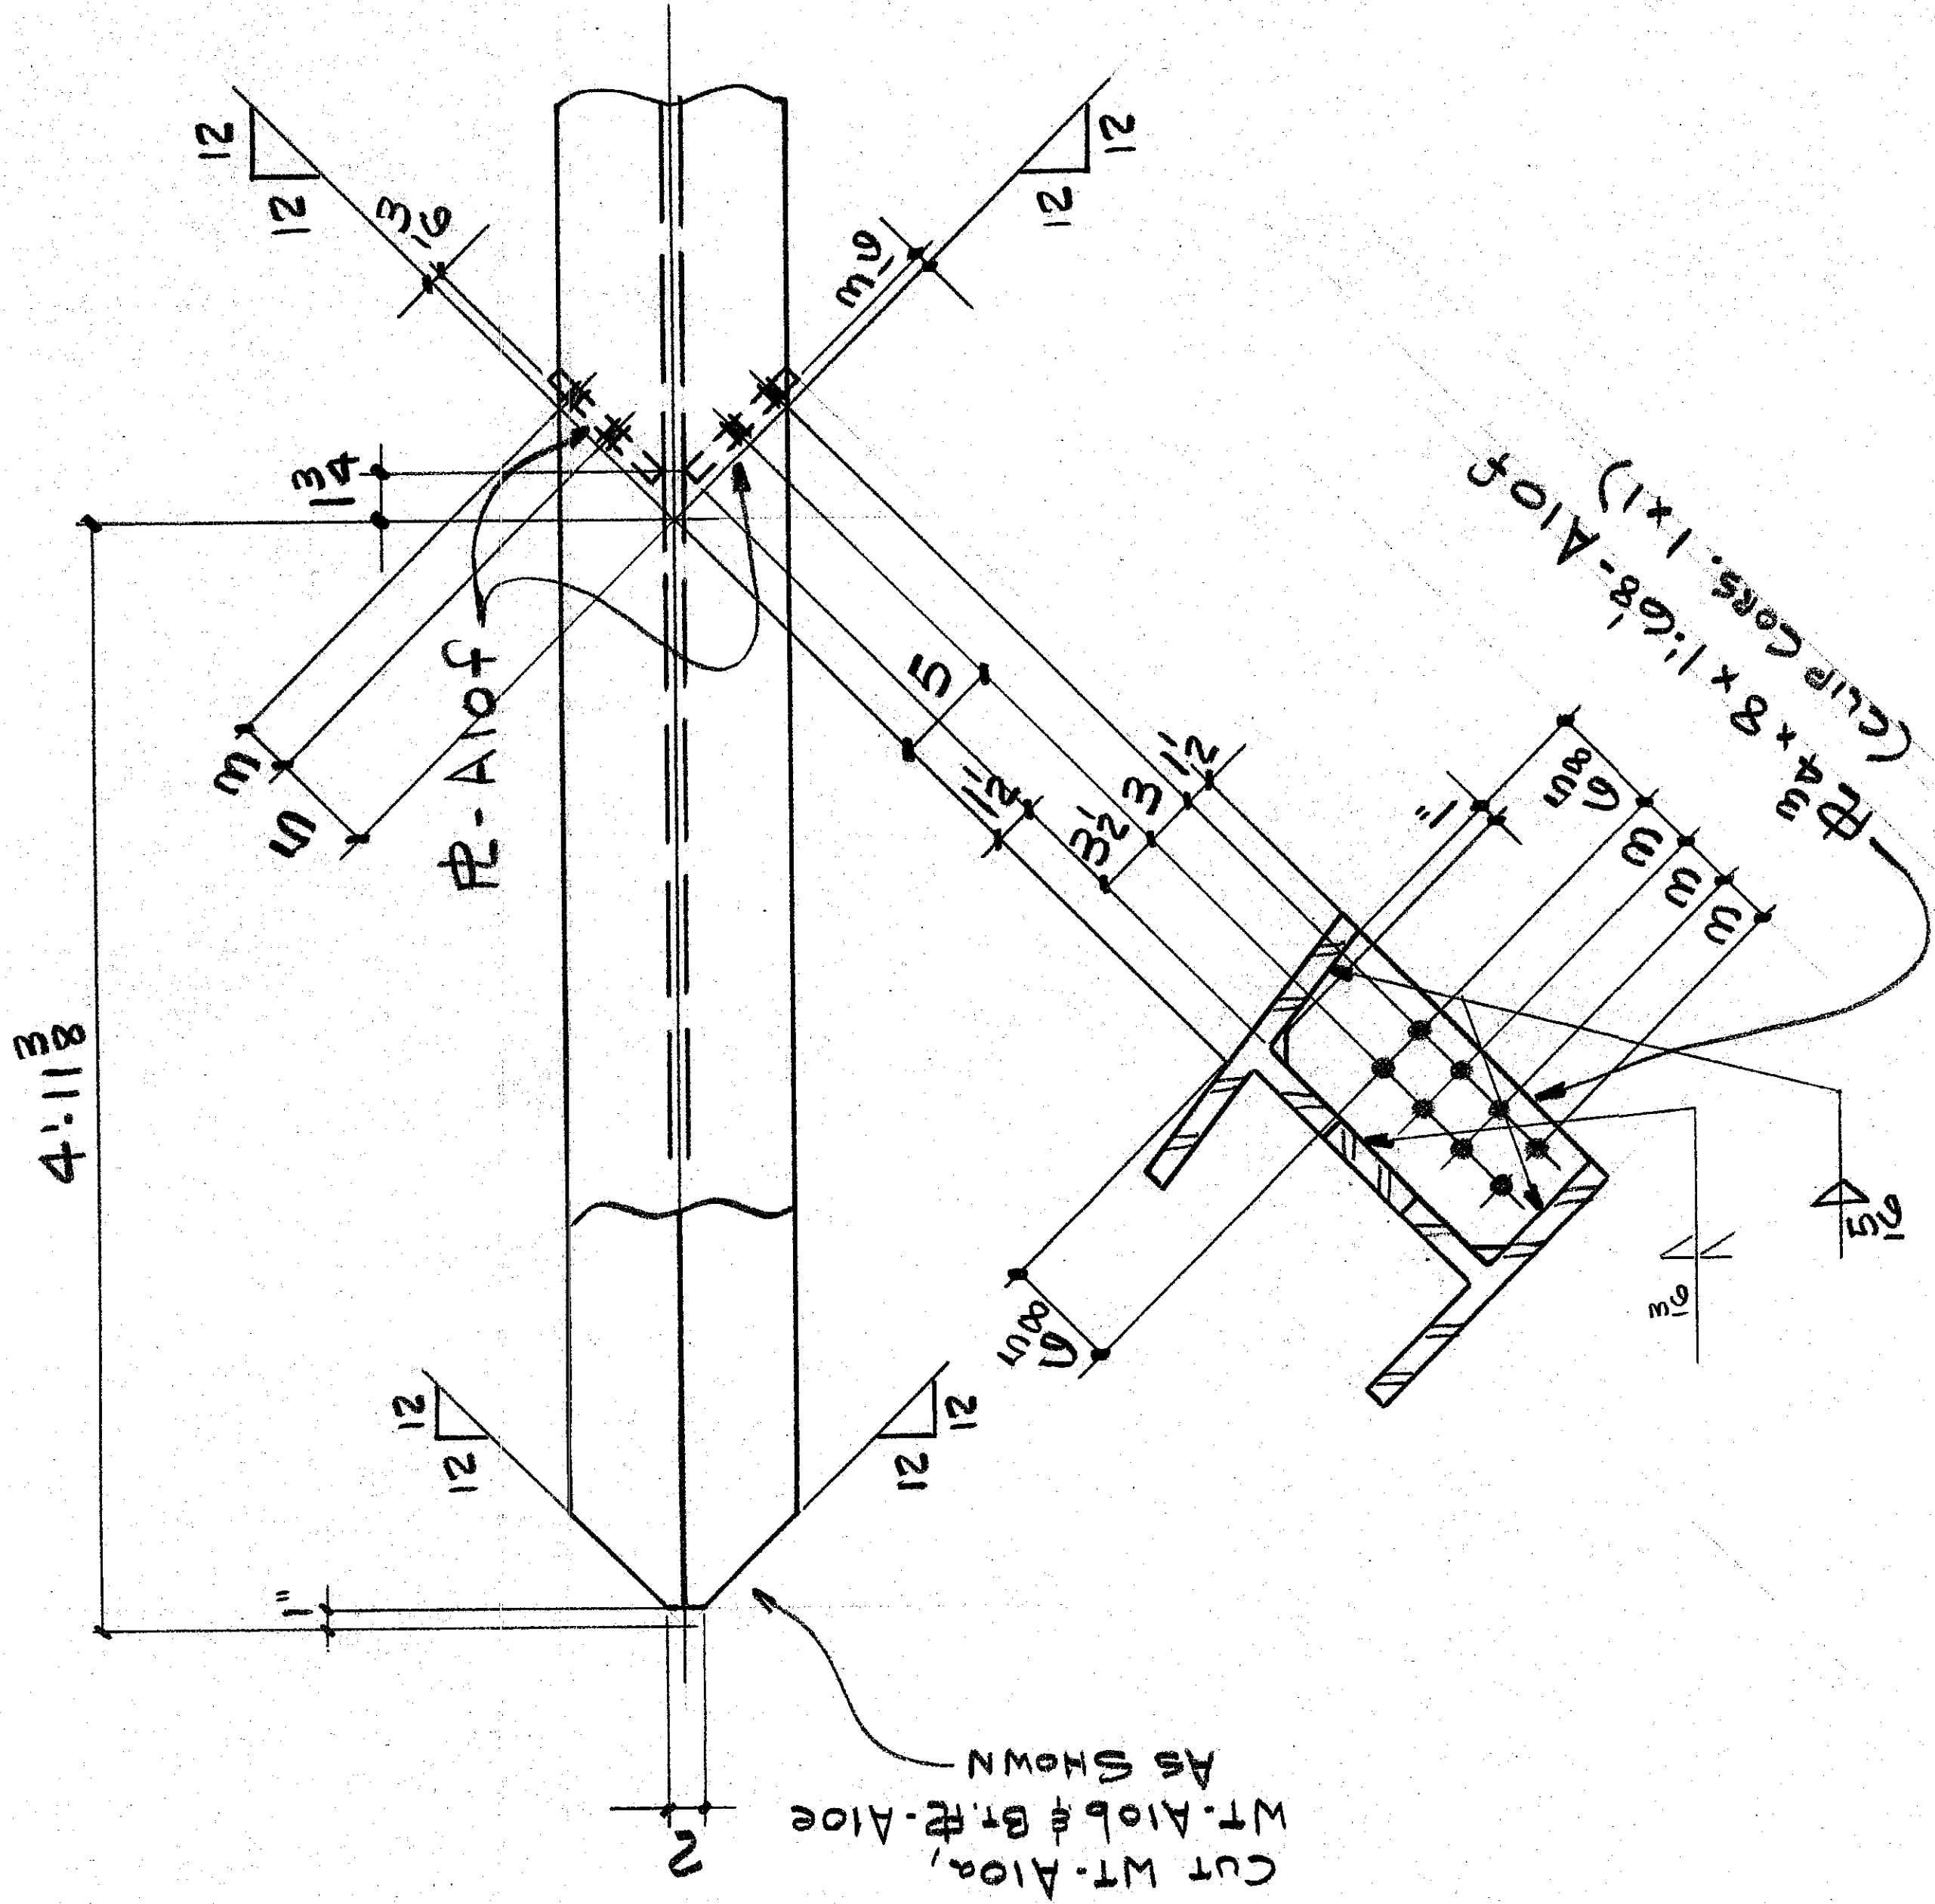

VIEW A-A

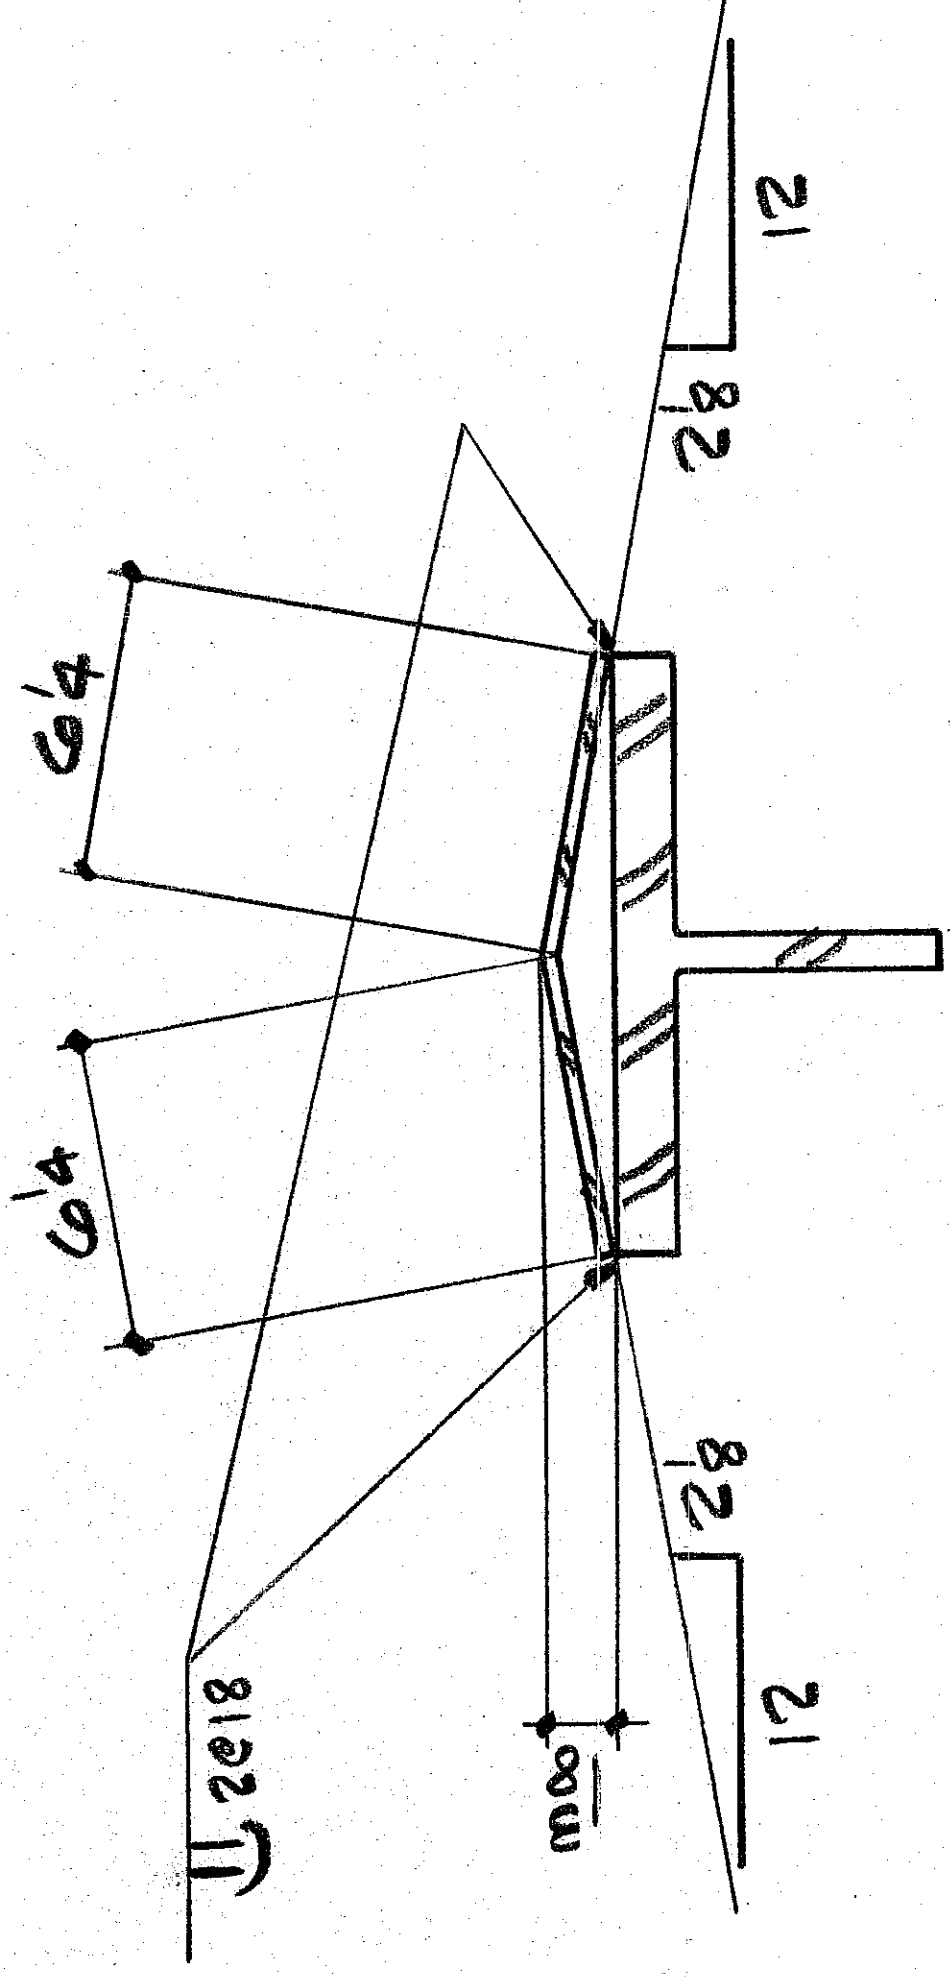

SECTION B-B

APPROVED
EVERETT I. BROWN CO.

BY [Signature] DATE MAR 21 1
APPROVED DRAWINGS
FOR FIELD USE
DATE MAR 2 1989

SHOP NOTE:
WORK THIS SHEET
W/ SHEETS 10A, 10B & 10C

ISSUE	#	BP	FOR	DATE	BY	DESCRIPTION	REV.	DATE	MADE BY
1	3	APD	11/3	SS					
2	1	FAB		SB					
3	1	FAB	3/9/83	AA					
4	4	FIELD							

DOWN BY WK	INTERSTATE WELDING & FABRICATION, INC. 1870 DAVIS AVENUE • TERRE HAUTE, INDIANA 47802	CHK'D BY WK
JOB # 6300	JACKSON ELEMENTARY SCHOOL	HOLD 1-CT. RED
SHT. # 10D	CLEAN G.	PAINT MAB-60802
	REF. DWG'S.	