

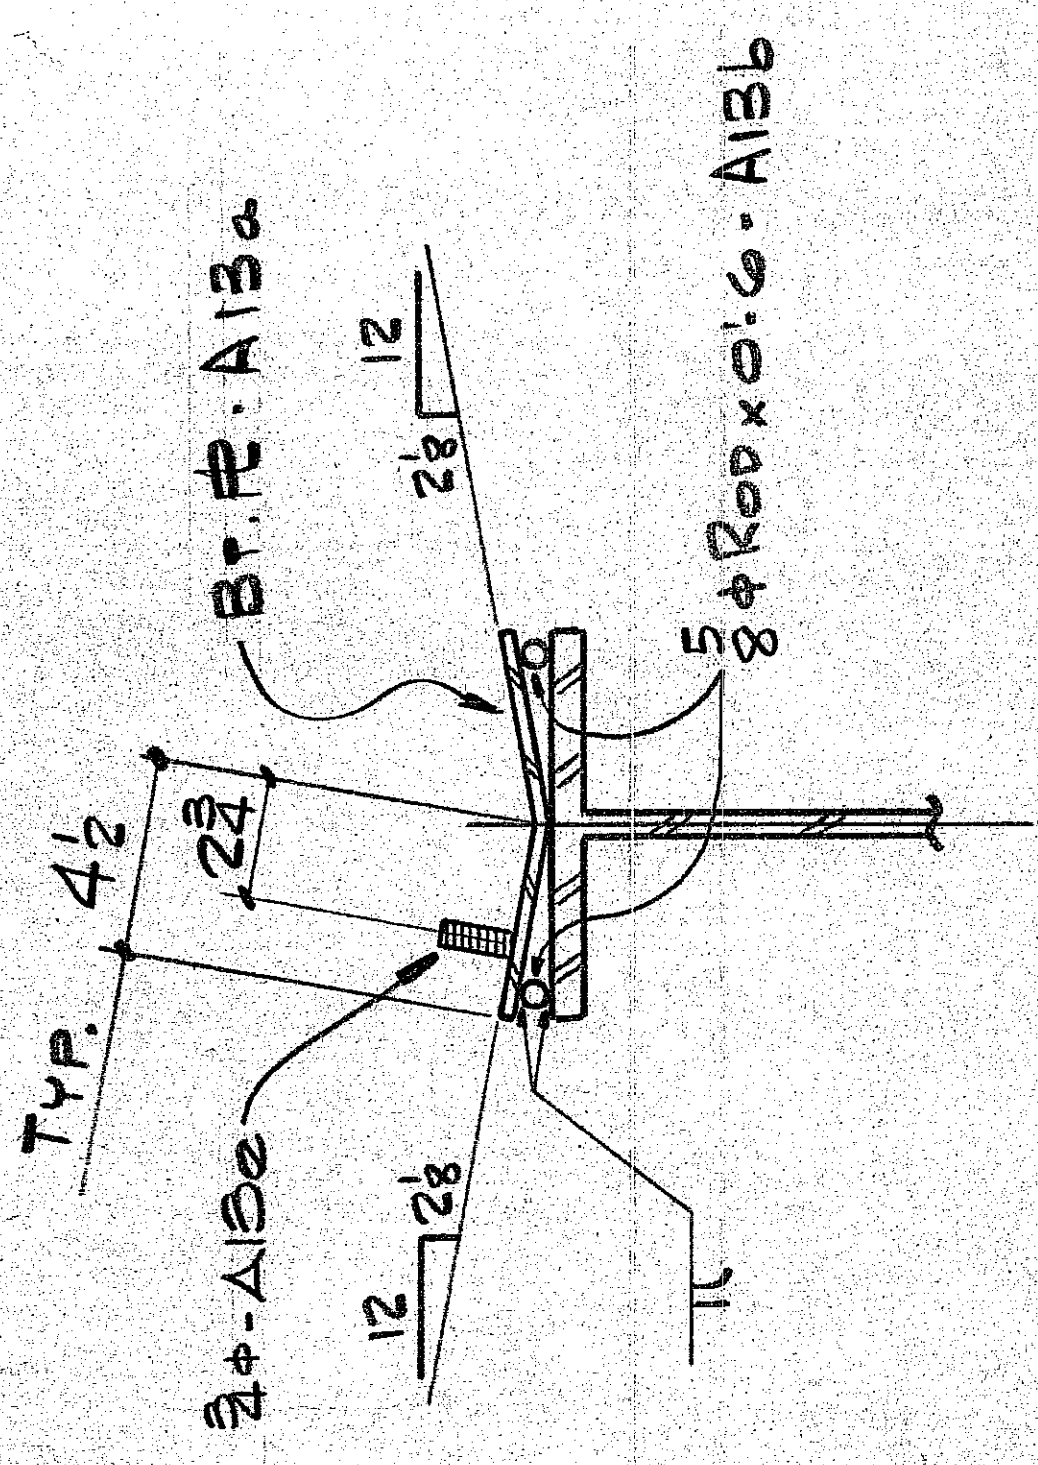


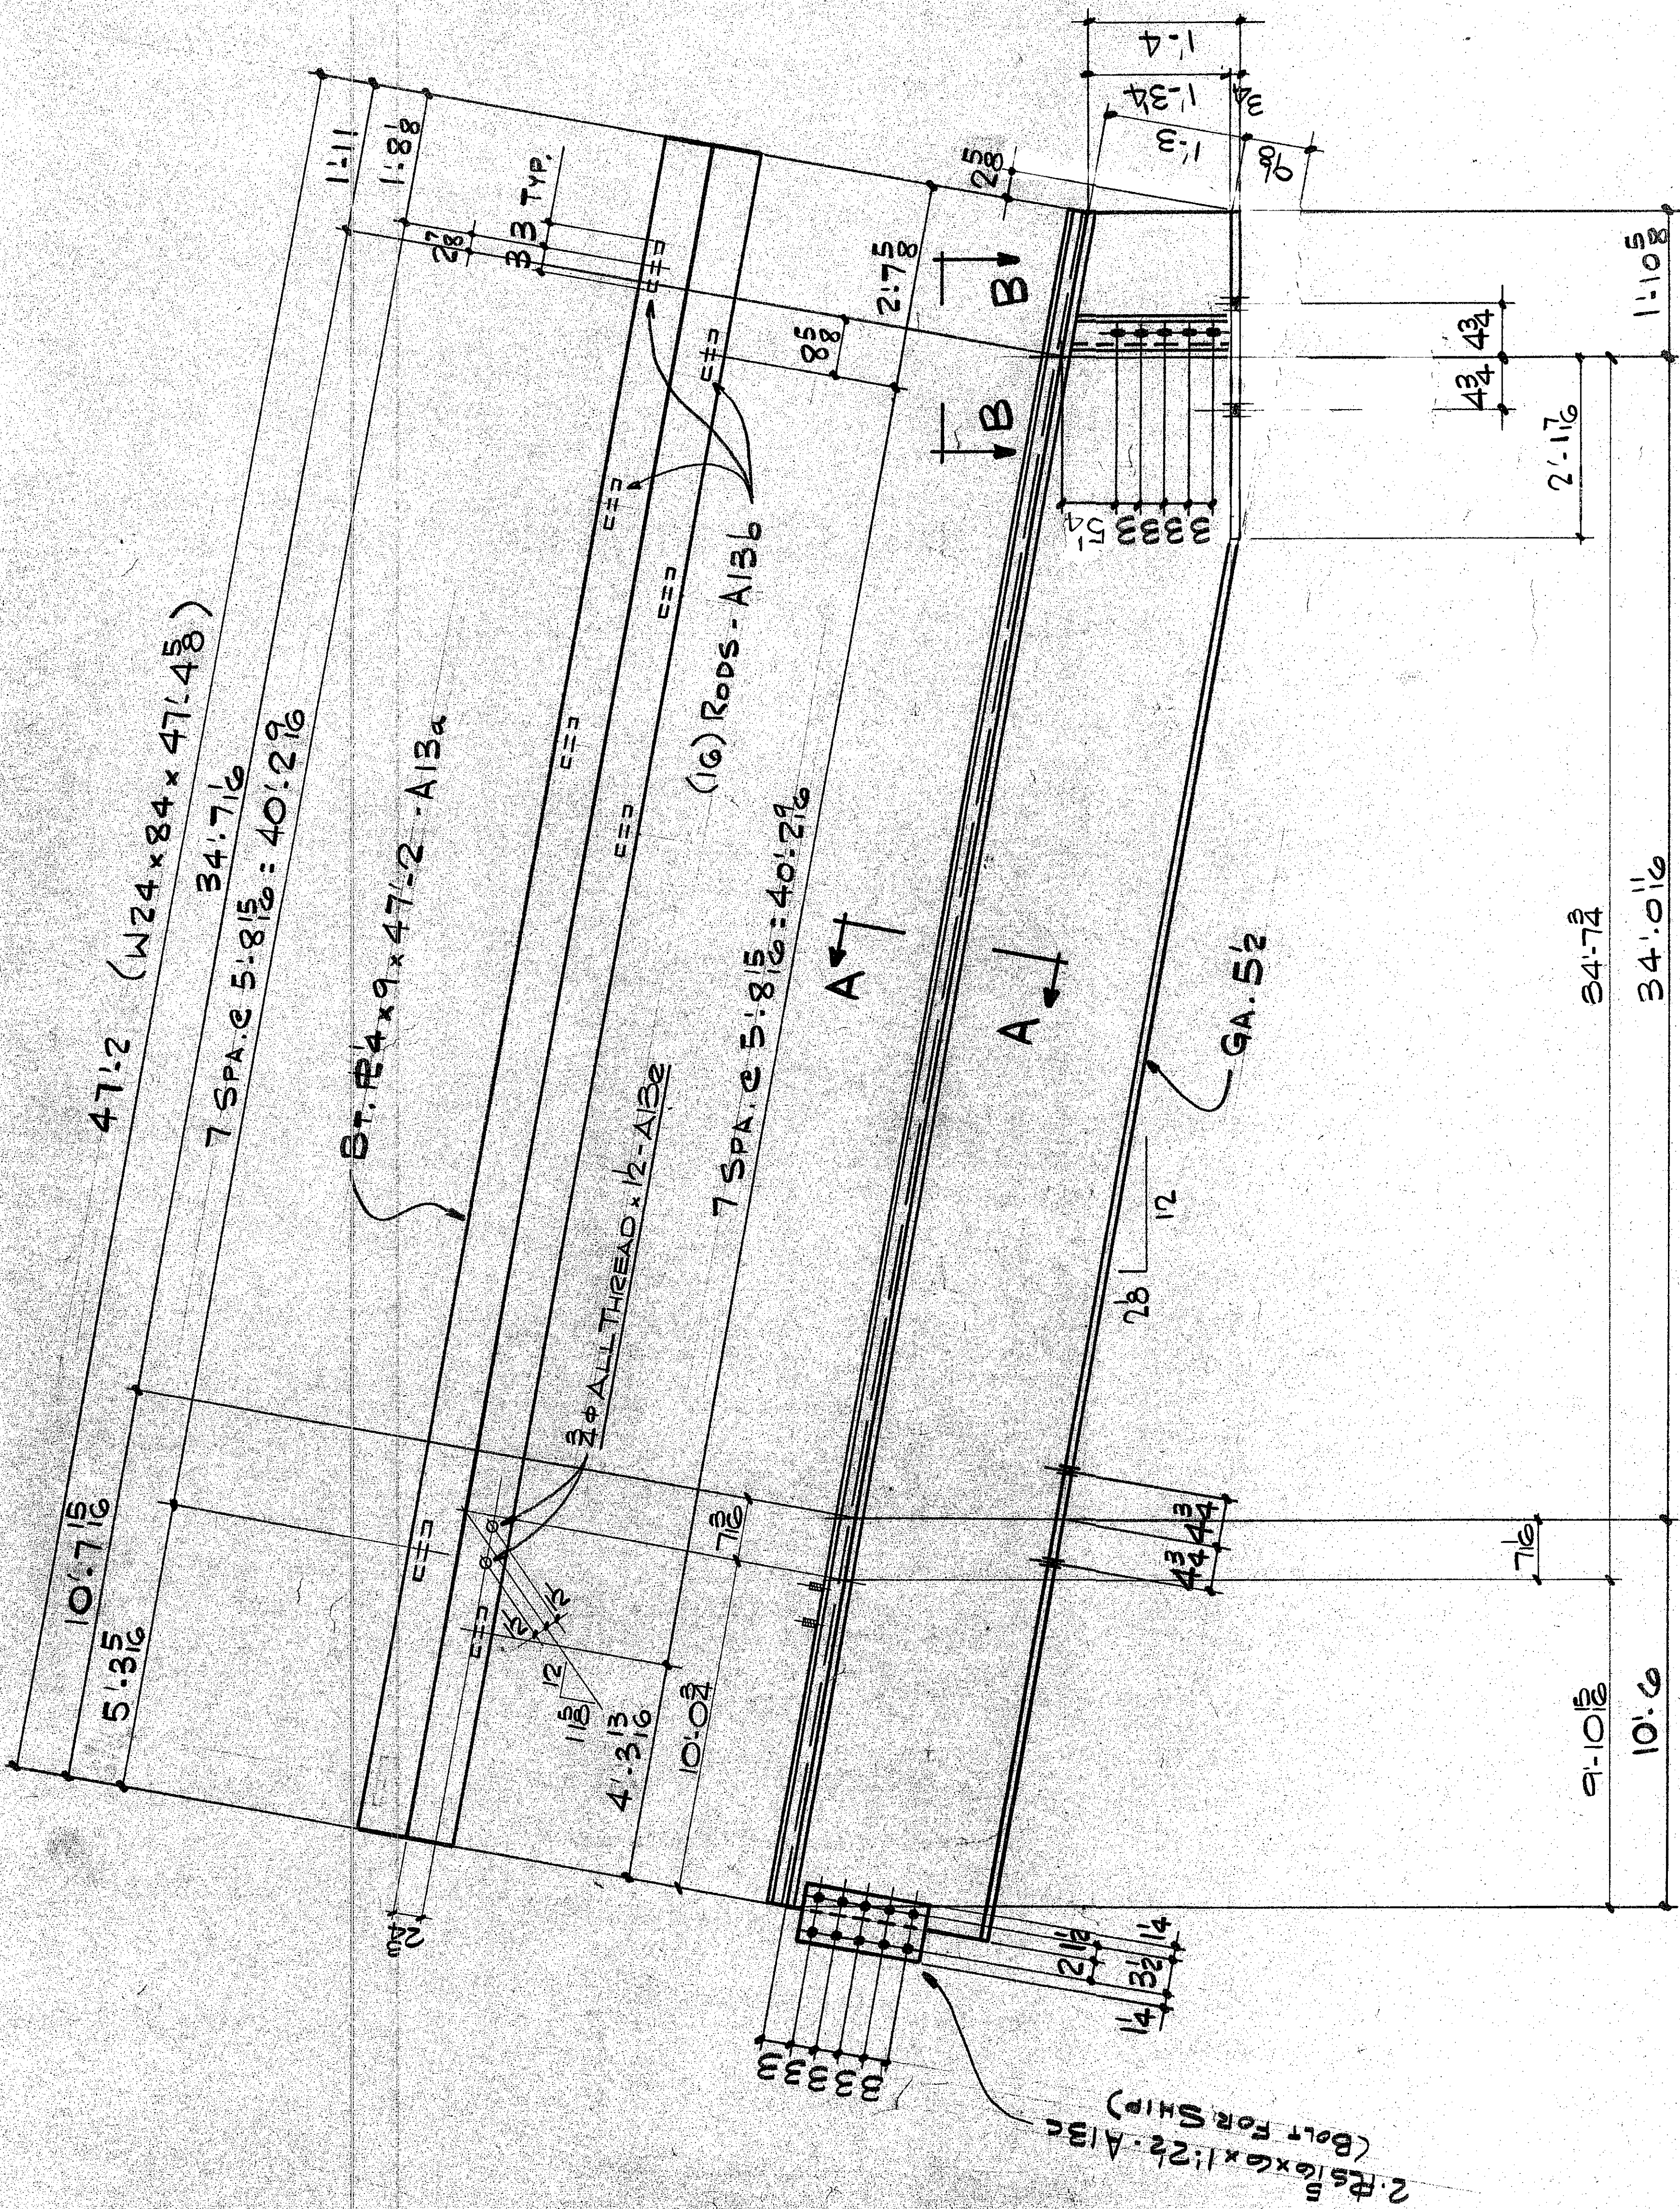

SECTION A-A

SHOP NOTE
BT # A13a NOT SHOWN
FOR CLARITY

VIEW B-B

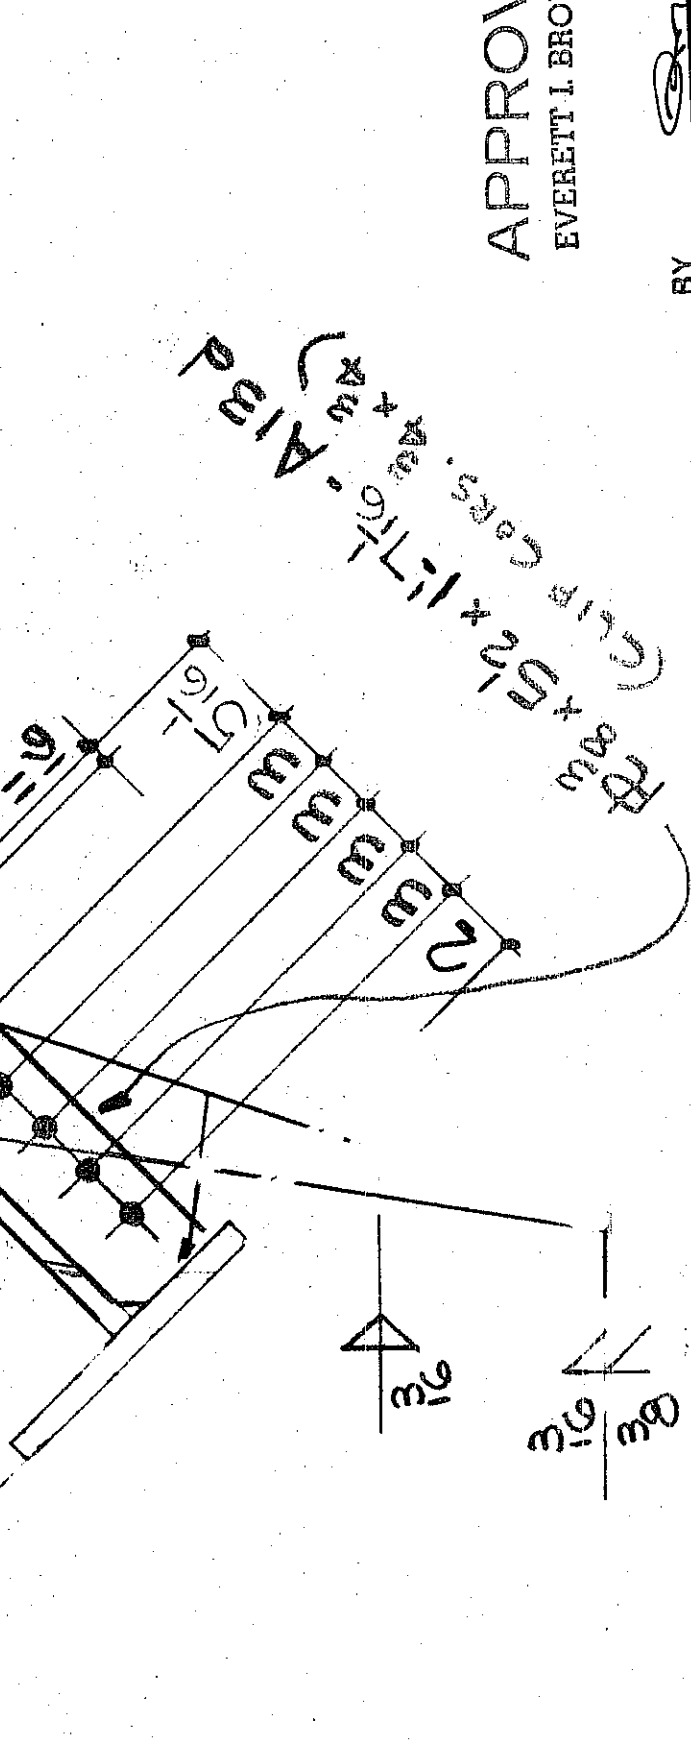

ONE - BEAM - A13 (ASSN.)
ONE - DO - B13 (OPP. HD.)

8-3/4 x 2 1/2 HS w/w

28-3/4 x 2 1/2 HS w/w

APPROVED
EVERETT L. BROWN CO.

BY: [Signature]
DATE: MAR 21 1983
APPROVED DRAWINGS
FOR FIELD USE
DATE: MAR 9 1983

UNIT A			
INTERSTATE WELDING & FABRICATION, INC. 1670 DAVIS AVENUE • TERRE HAUTE, INDIANA 47602			
DWR BY WK	CHKD BY B.	JOB # 6300	SHT # 13
JACKSON ELEMENTARY School			
HOLD 1-5-83	PAINT 1-5-83	CLEAN G. MAB-60802	REF. DWGS.
ISSUE #BP	FOR	DATE BY	DESCRIPTION
1	APP	11/83 SS	
2	APP	11/83 SS	
3	APP	11/83 AP	
4	APP	3/8/83 AA	
		REV DATE	DESCRIPTION
		11/83	APPROVAL
		MADE BY	