



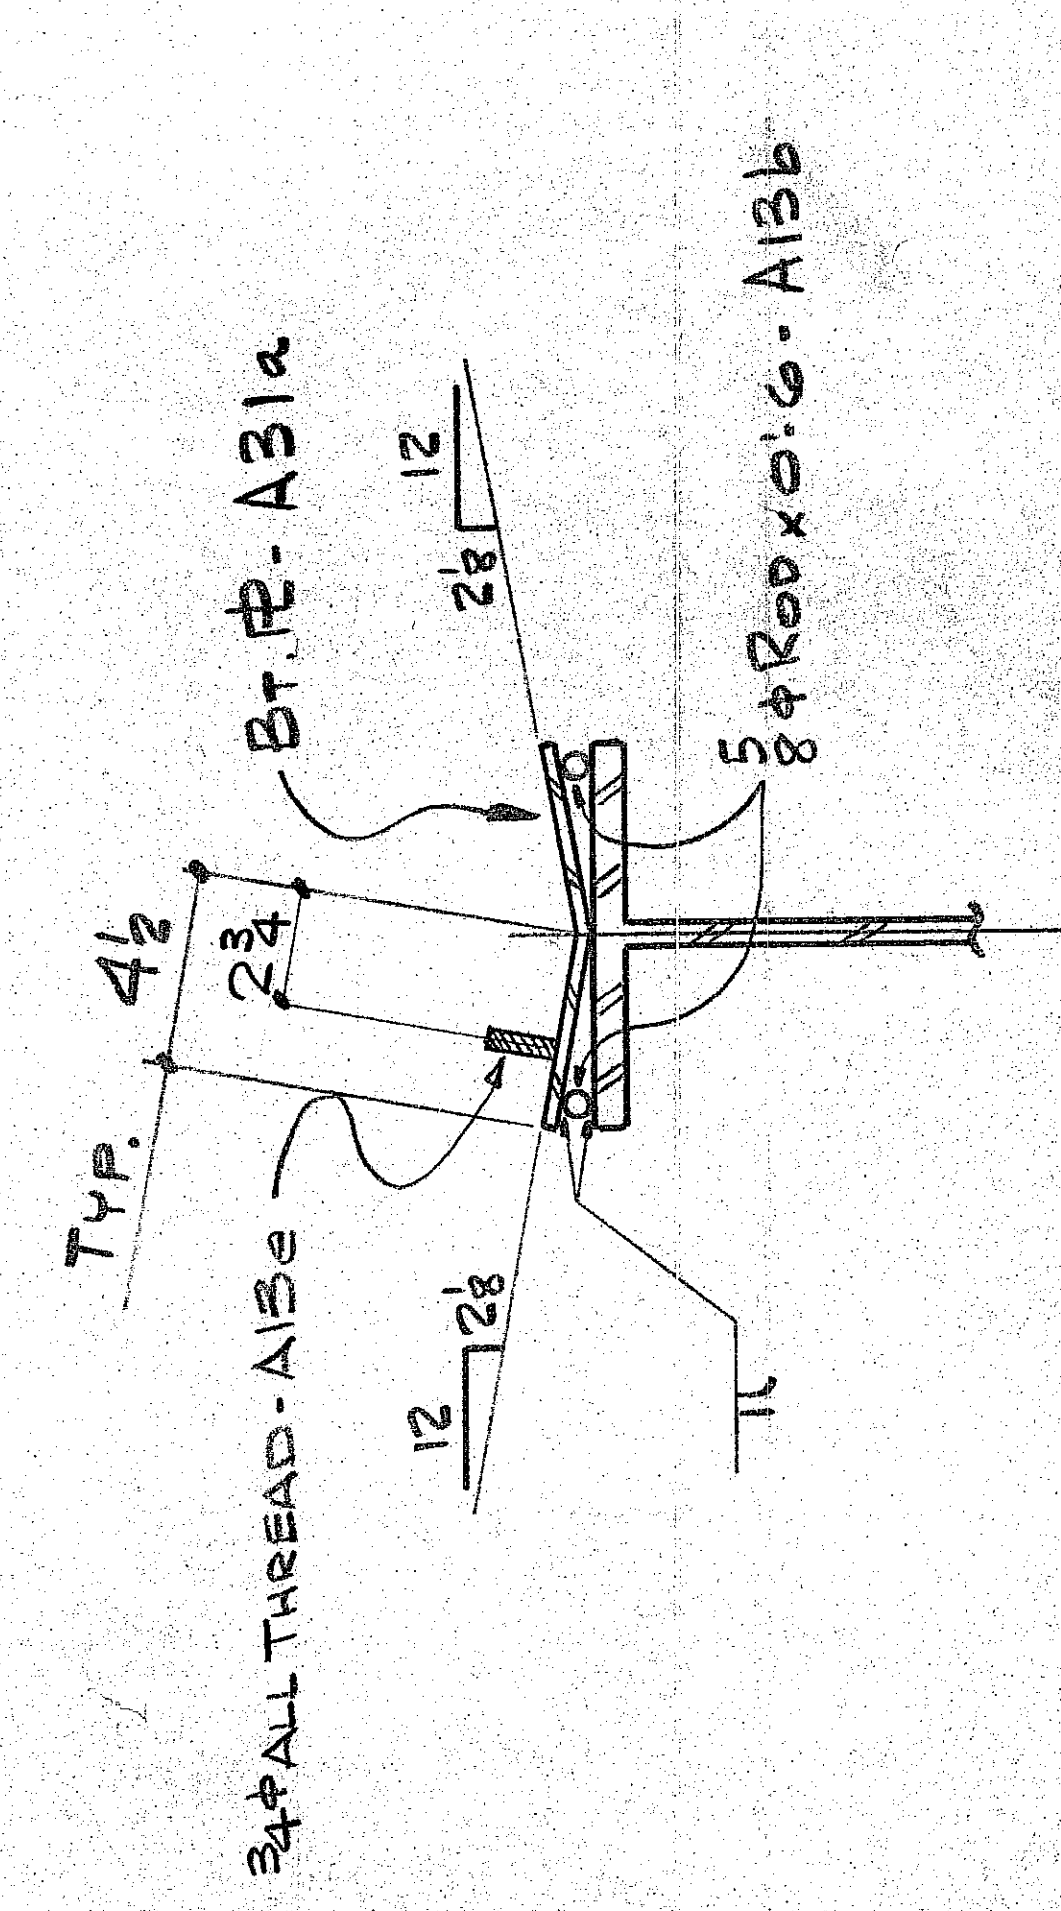

VIEW B-B

SHOP NOTED
BT # - A31a Not Shown
FOR CLARITY

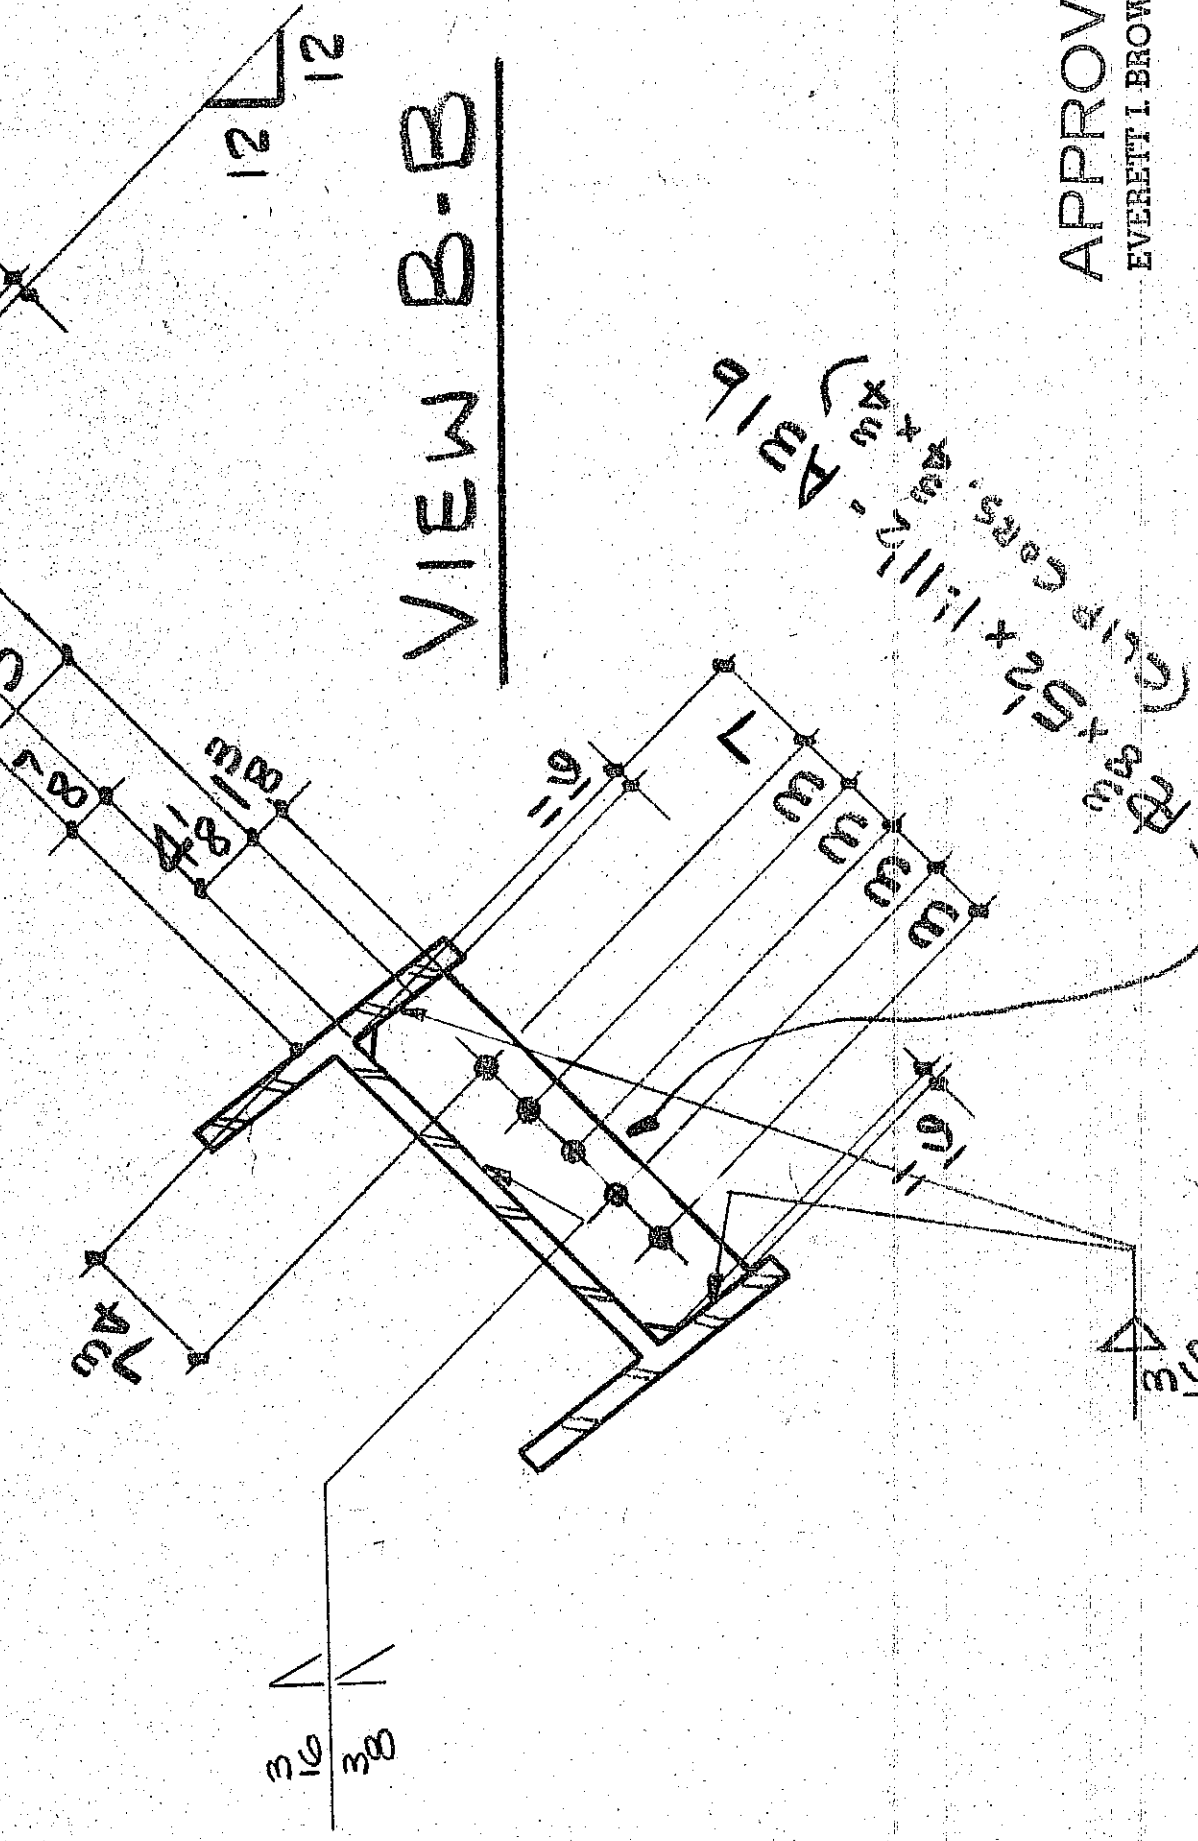

APPROVED DRAWINGS
FOR FIELD USE
DATE MAR 9 1983

4-34φ x 24HS 3/3

14-34 x 24 HS 3/3

[illegible]