


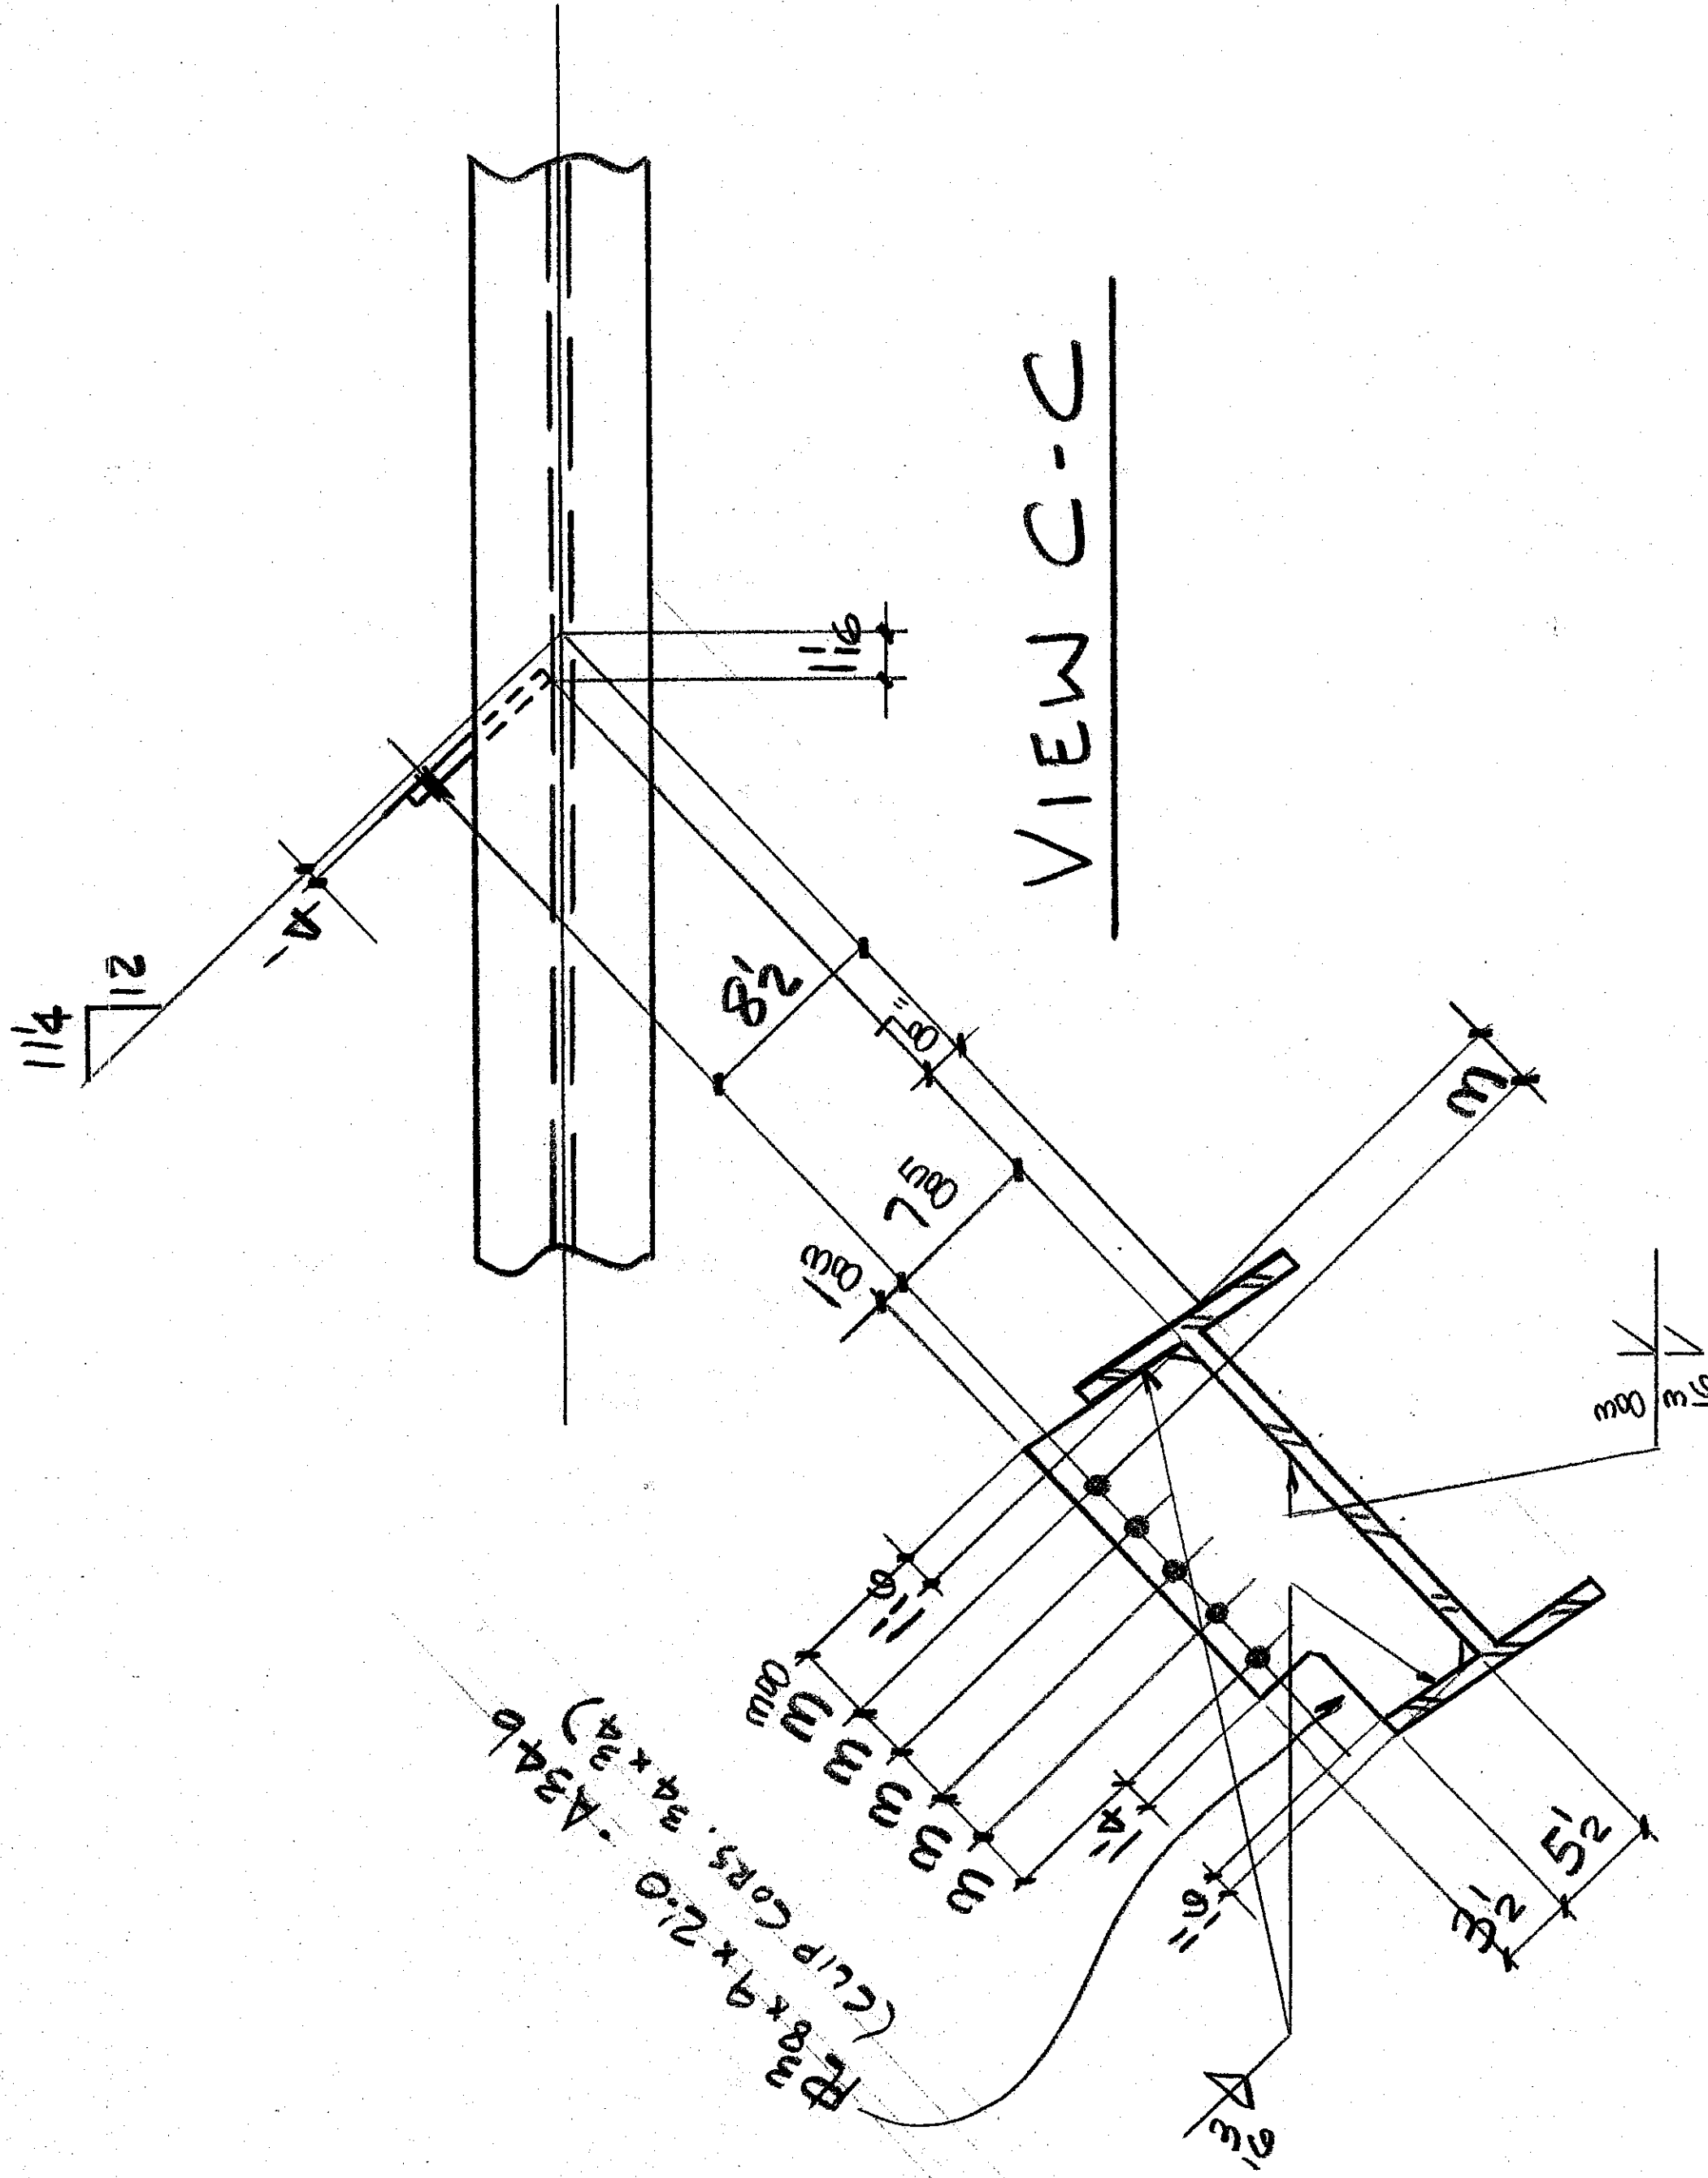

VIEW C-C

APPROVED
EVERETT I BROWN CO.

BY [Signature] DATE MAR 21

APPROVED DRAWINGS
FOR FIELD USE
DATE MAR 9 1983

SHOP NOTE 2
WORK THIS SHEET
WITH SHEET 34A

ISSUE	#BP	FOR	DATE	BY	DWN BY
					WK
					CHK'D BY
					JOB #
					6300
					SHT. #
					34B
					INTERSTATE WELDING & FABRICATION, INC.
					1670 DAVIS AVENUE • TERRE HAUTE, INDIANA 47802
					JACKSON ELEMENTARY SCHOOL
					HOLES 13-4
					PAINT 1-CT. RED
					MAB-G0802
					CLEAN G.
					REF. DWGS.
					MADE BY
					DESCRIPTION
					REV DATE
					17/10/83 AA
					APP
					3
					4
					Field
					3/9/83 AA
					1