




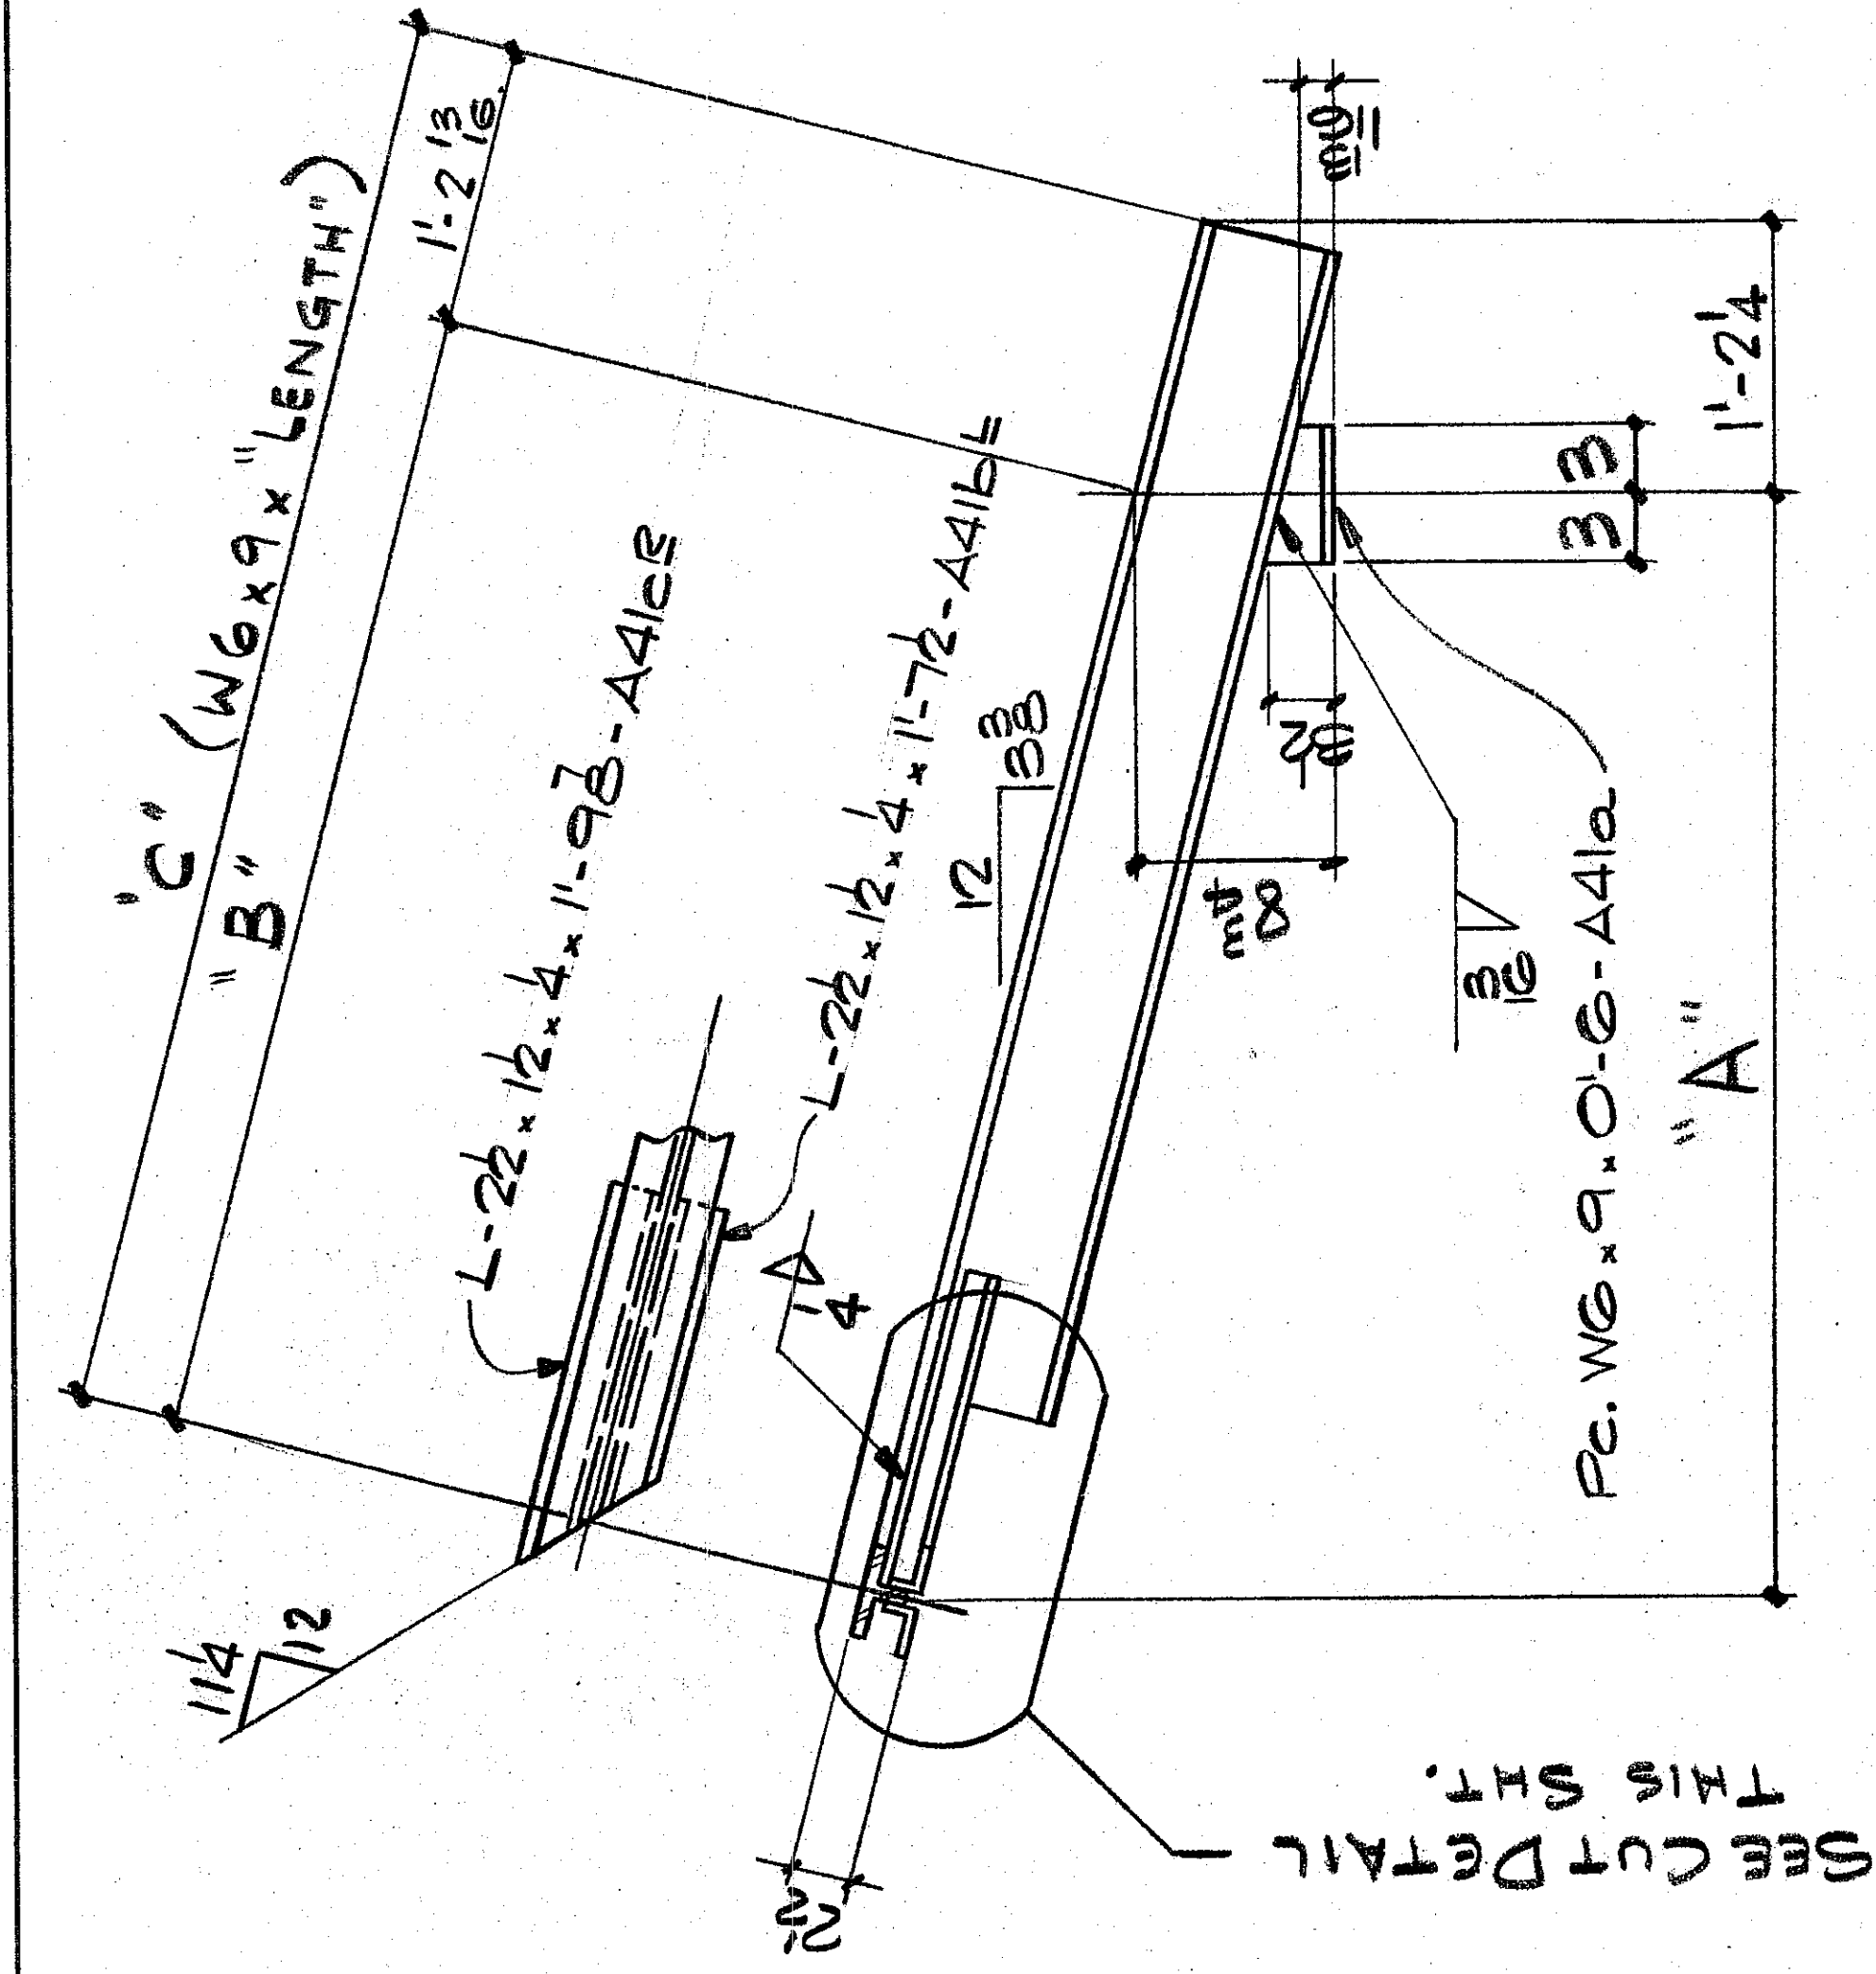

BEAM SCHEDULE				
QUAN.	A	B	C	MARK
2	6'-5 1/8 D _o	6'-8 1/8 D _o	7'-10 3/8 D _o	A41 (ASSN.)
2				B41 (OPP. HD.)
2	2'-10 1/8 D _o	2'-11 3/8 D _o	4'-2 3/8 D _o	C41 (ASSN.)
2				D41 (OPP. HD.)

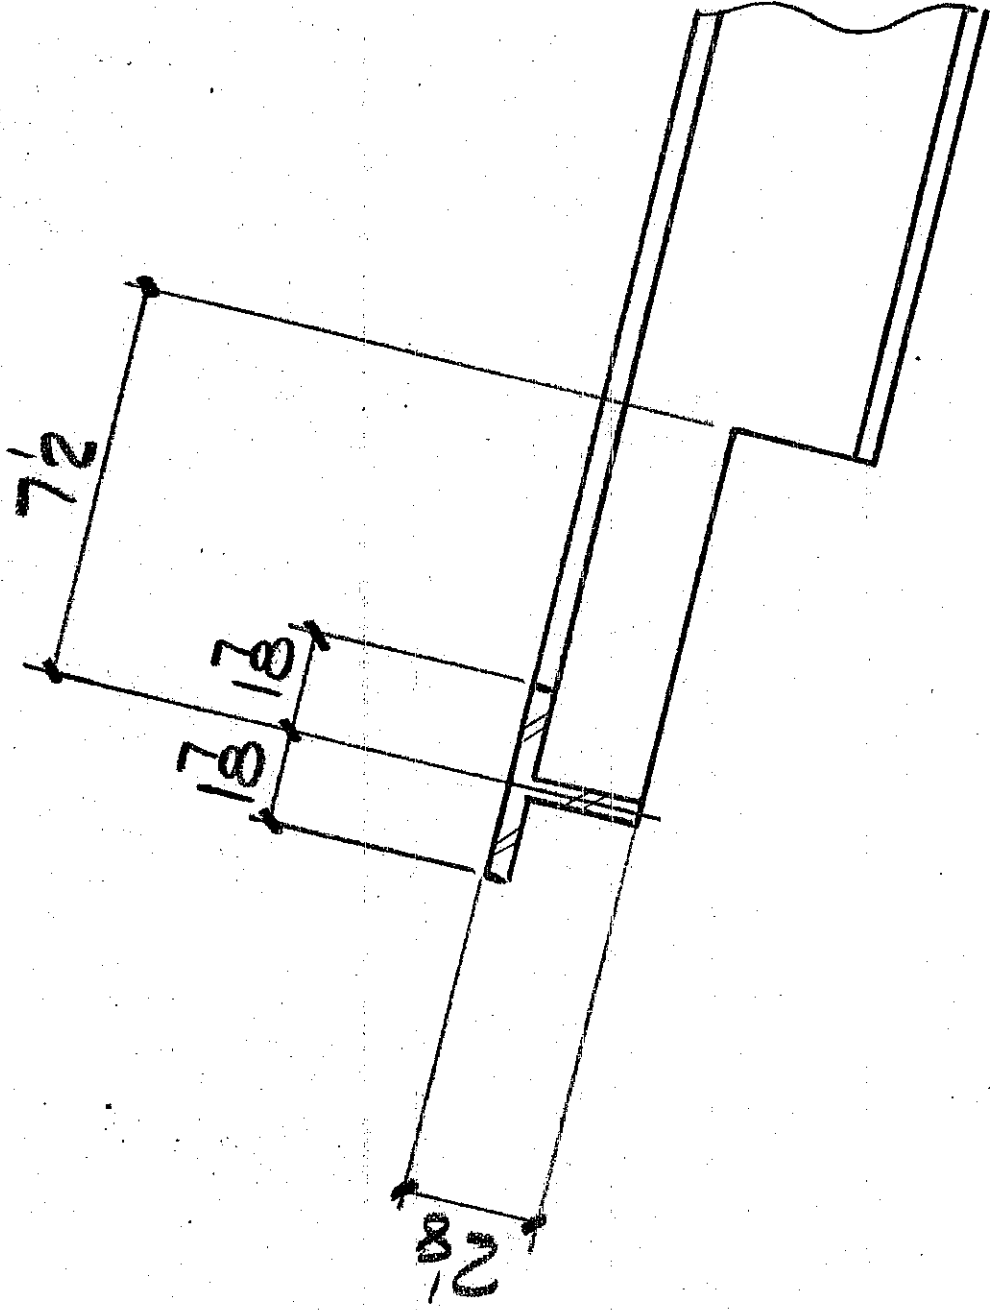

CUT DETAIL

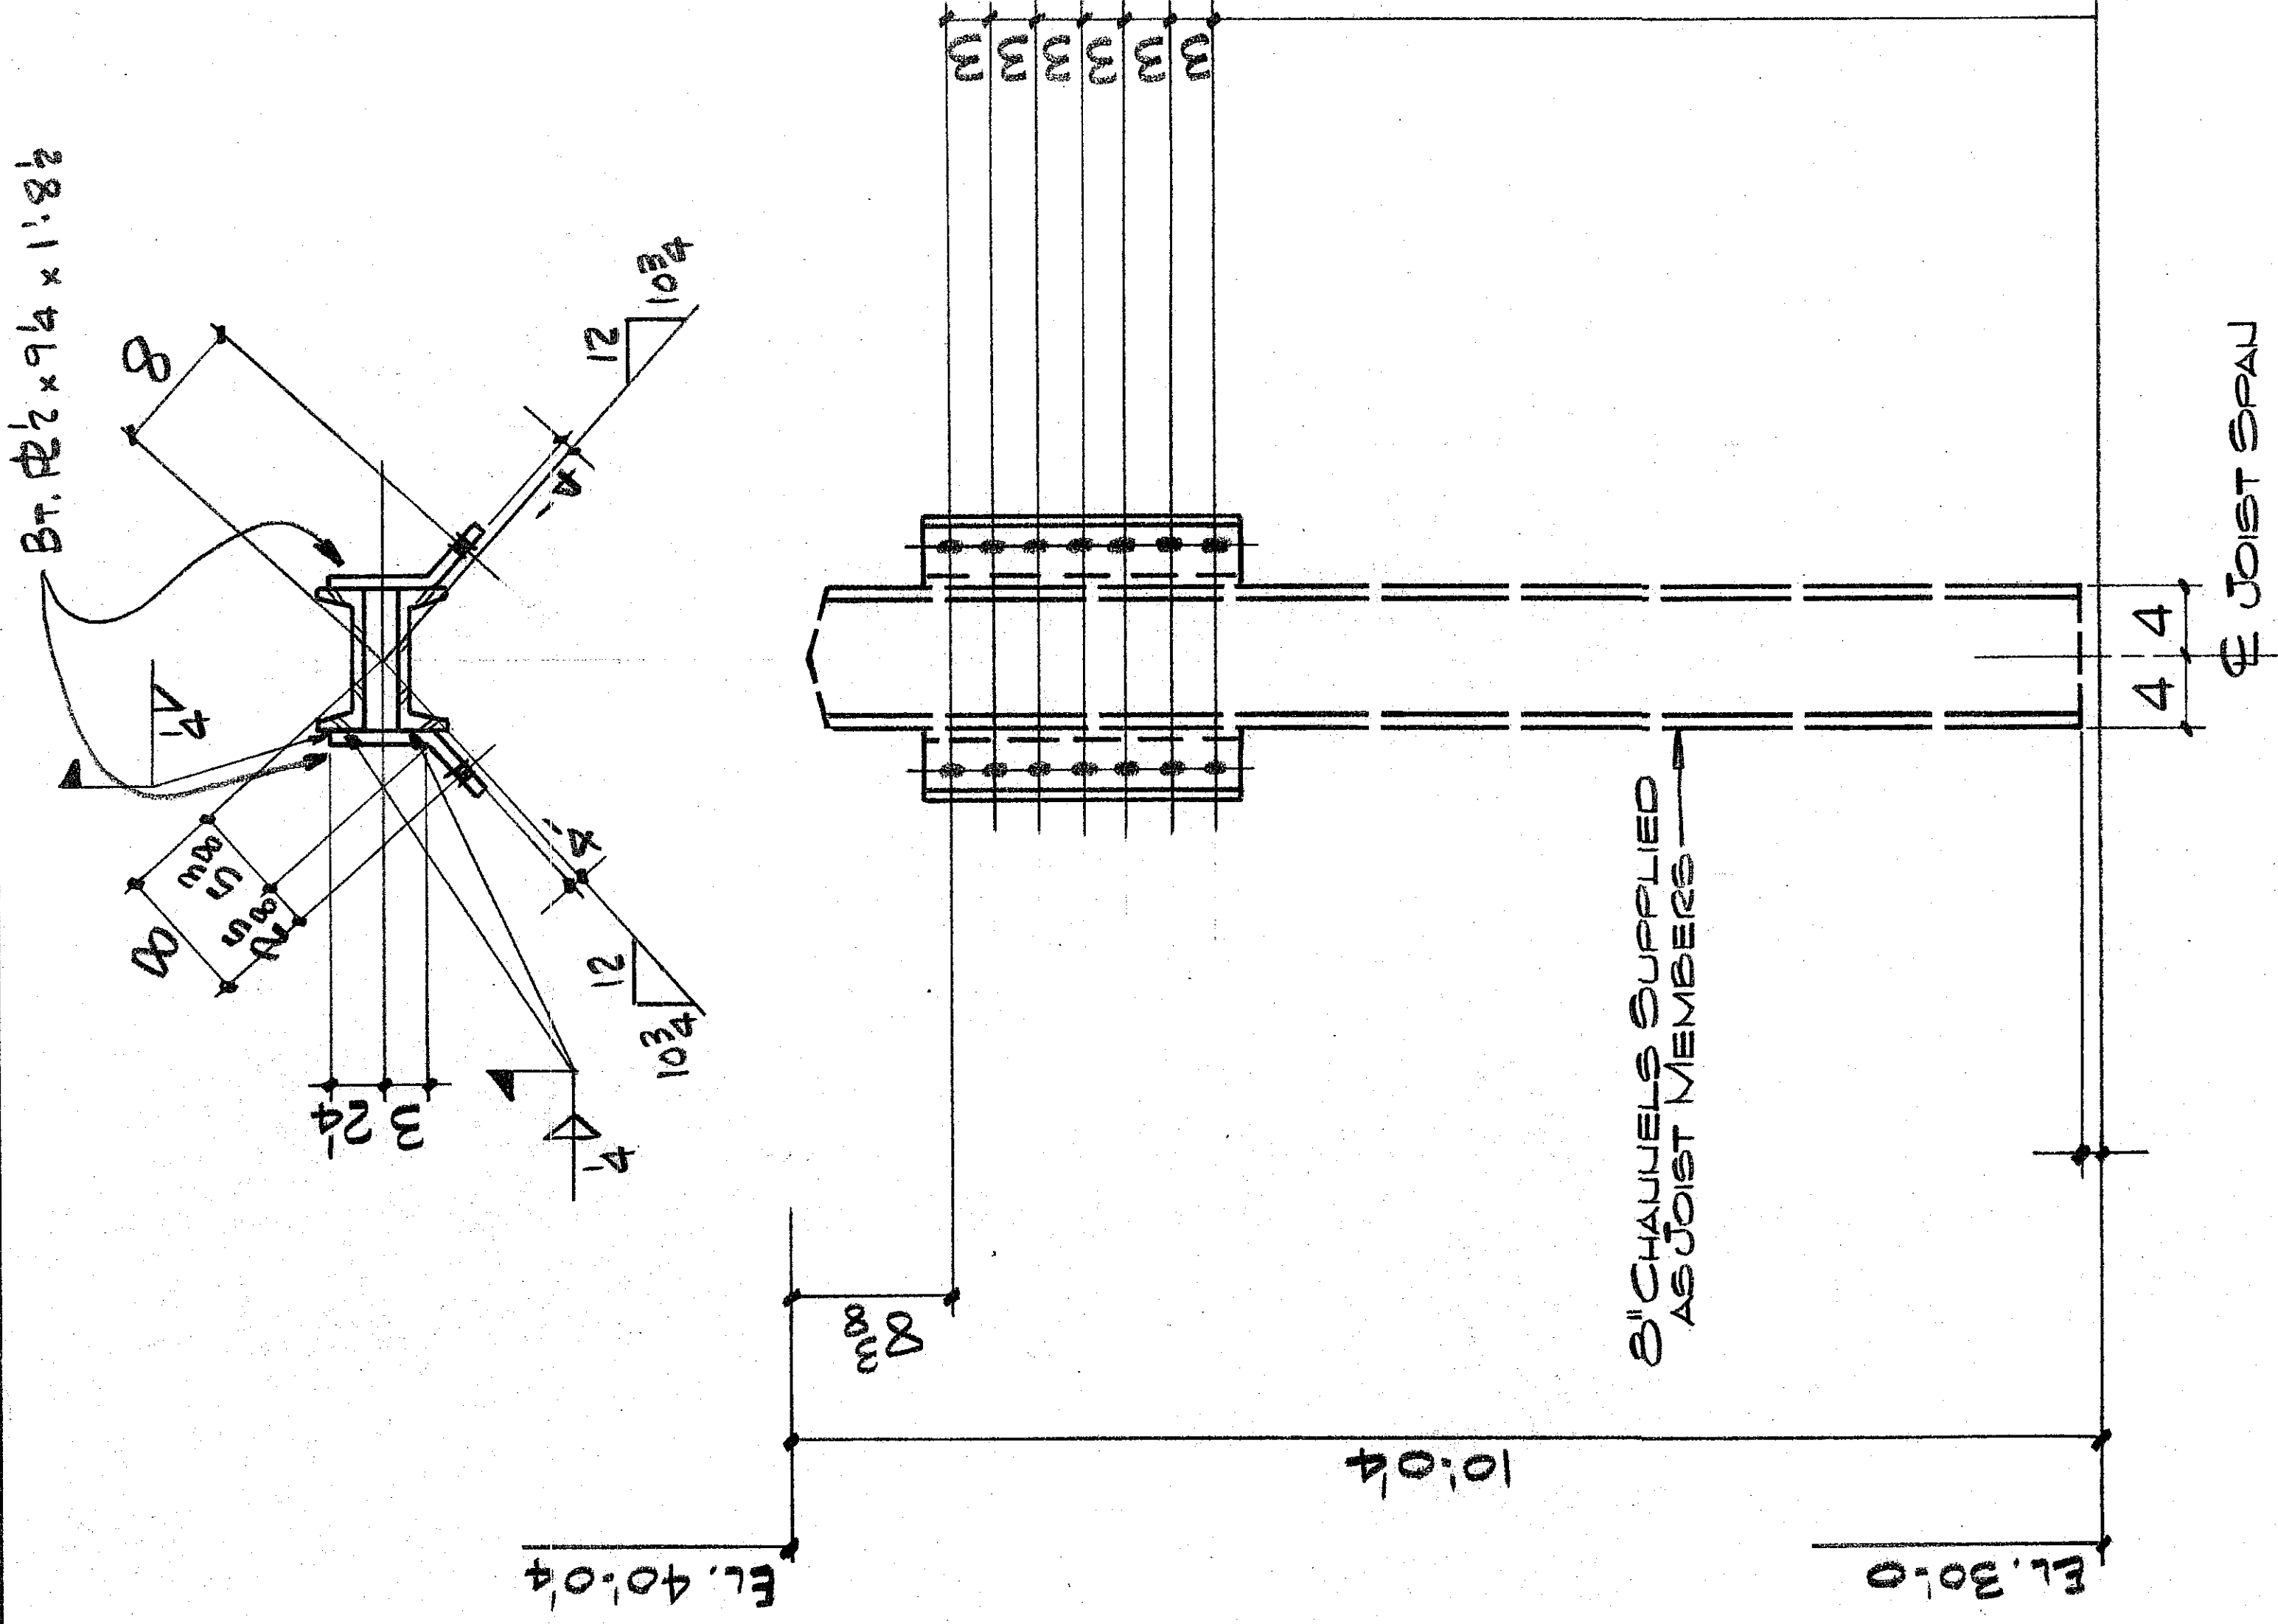

4 - BRACKETS - H41

APPROVED
EVERETT I. BROWN CO.

BY:
DATE: MAR 21 1983
APPROVED DRAWINGS FOR FIELD USE
DATE: MAR 9 1983

ISSUE	#BP	FOR	DATE	BY	DWN BY
1	3	APP	11/10/82	A A	WIK
2					WIK
3	4	FIELD	3/1/83	AN	WIK
4					WIK

INTERSTATE WELDING & FABRICATION, INC. 1670 DAVIS AVENUE • TERRE HAUTE, INDIANA 47802	JACKSON ELEMENTARY SCHOOL
HOLES: 12-ø 1/2"	PAINT: 1-CY. RED
	JOB#: MAB 60802
	CLEAN G.
	REF. DWGS.
	SHT. # 41