




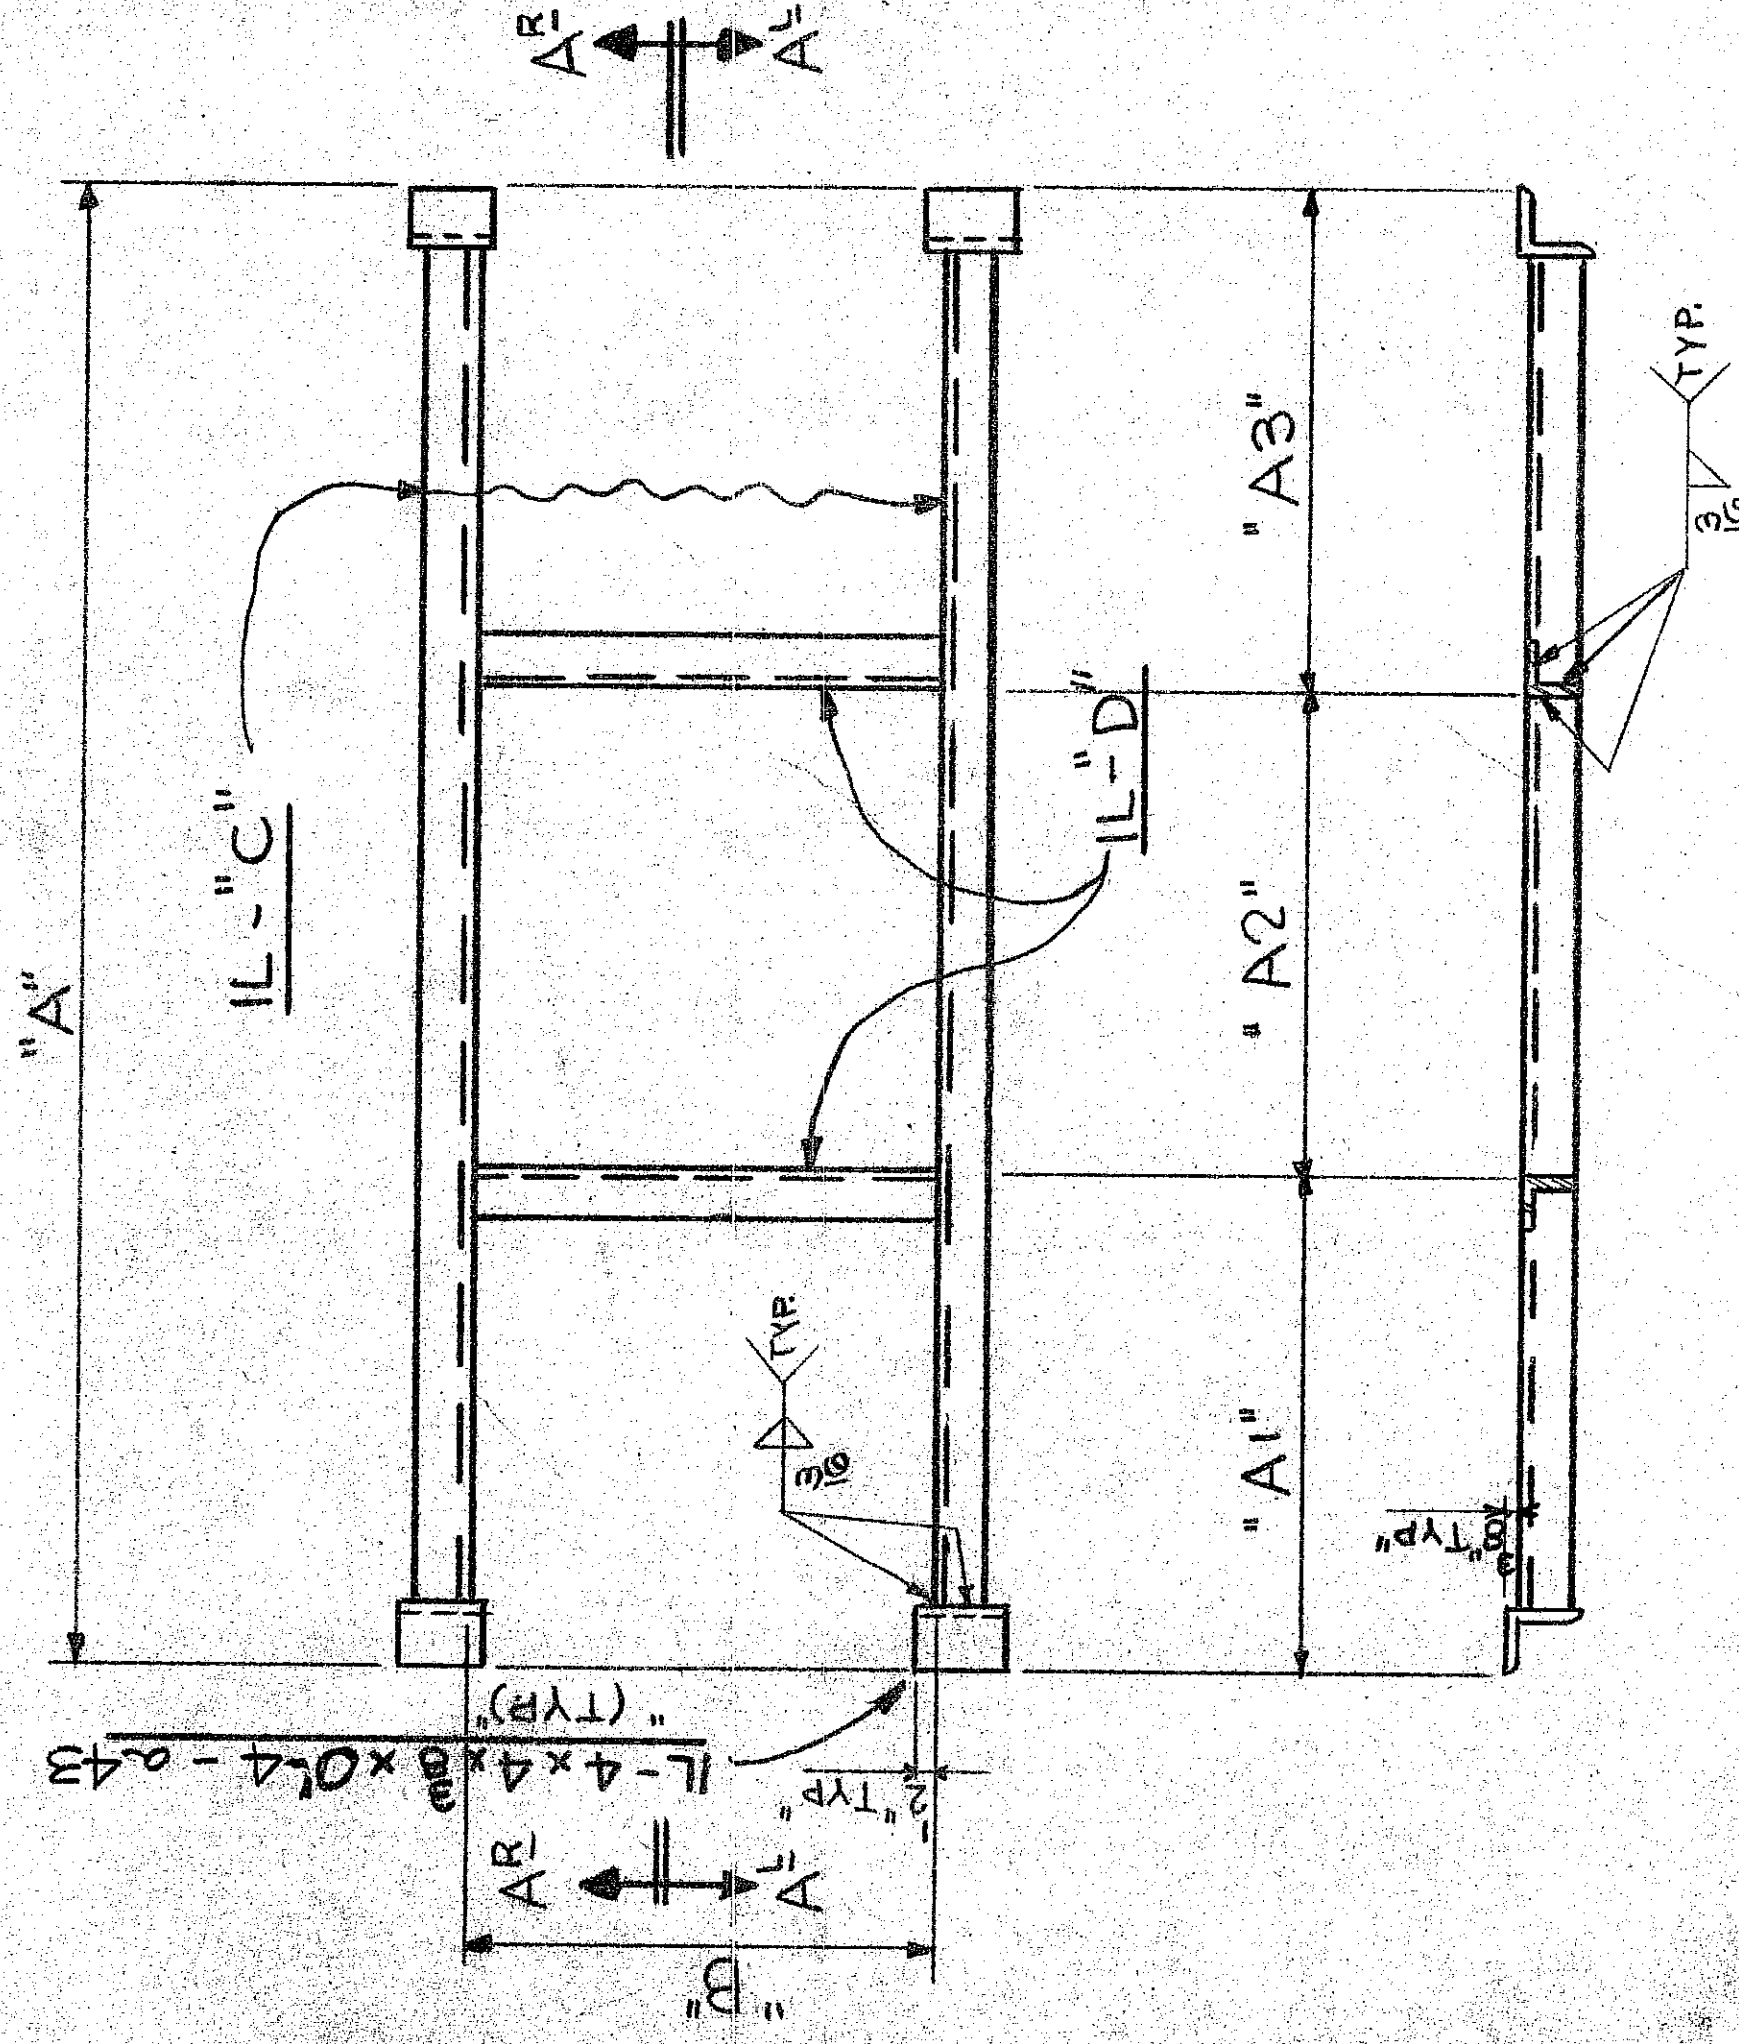

SECTION A-A (SHOWN)
SECTION A-A (OFF. HD.)

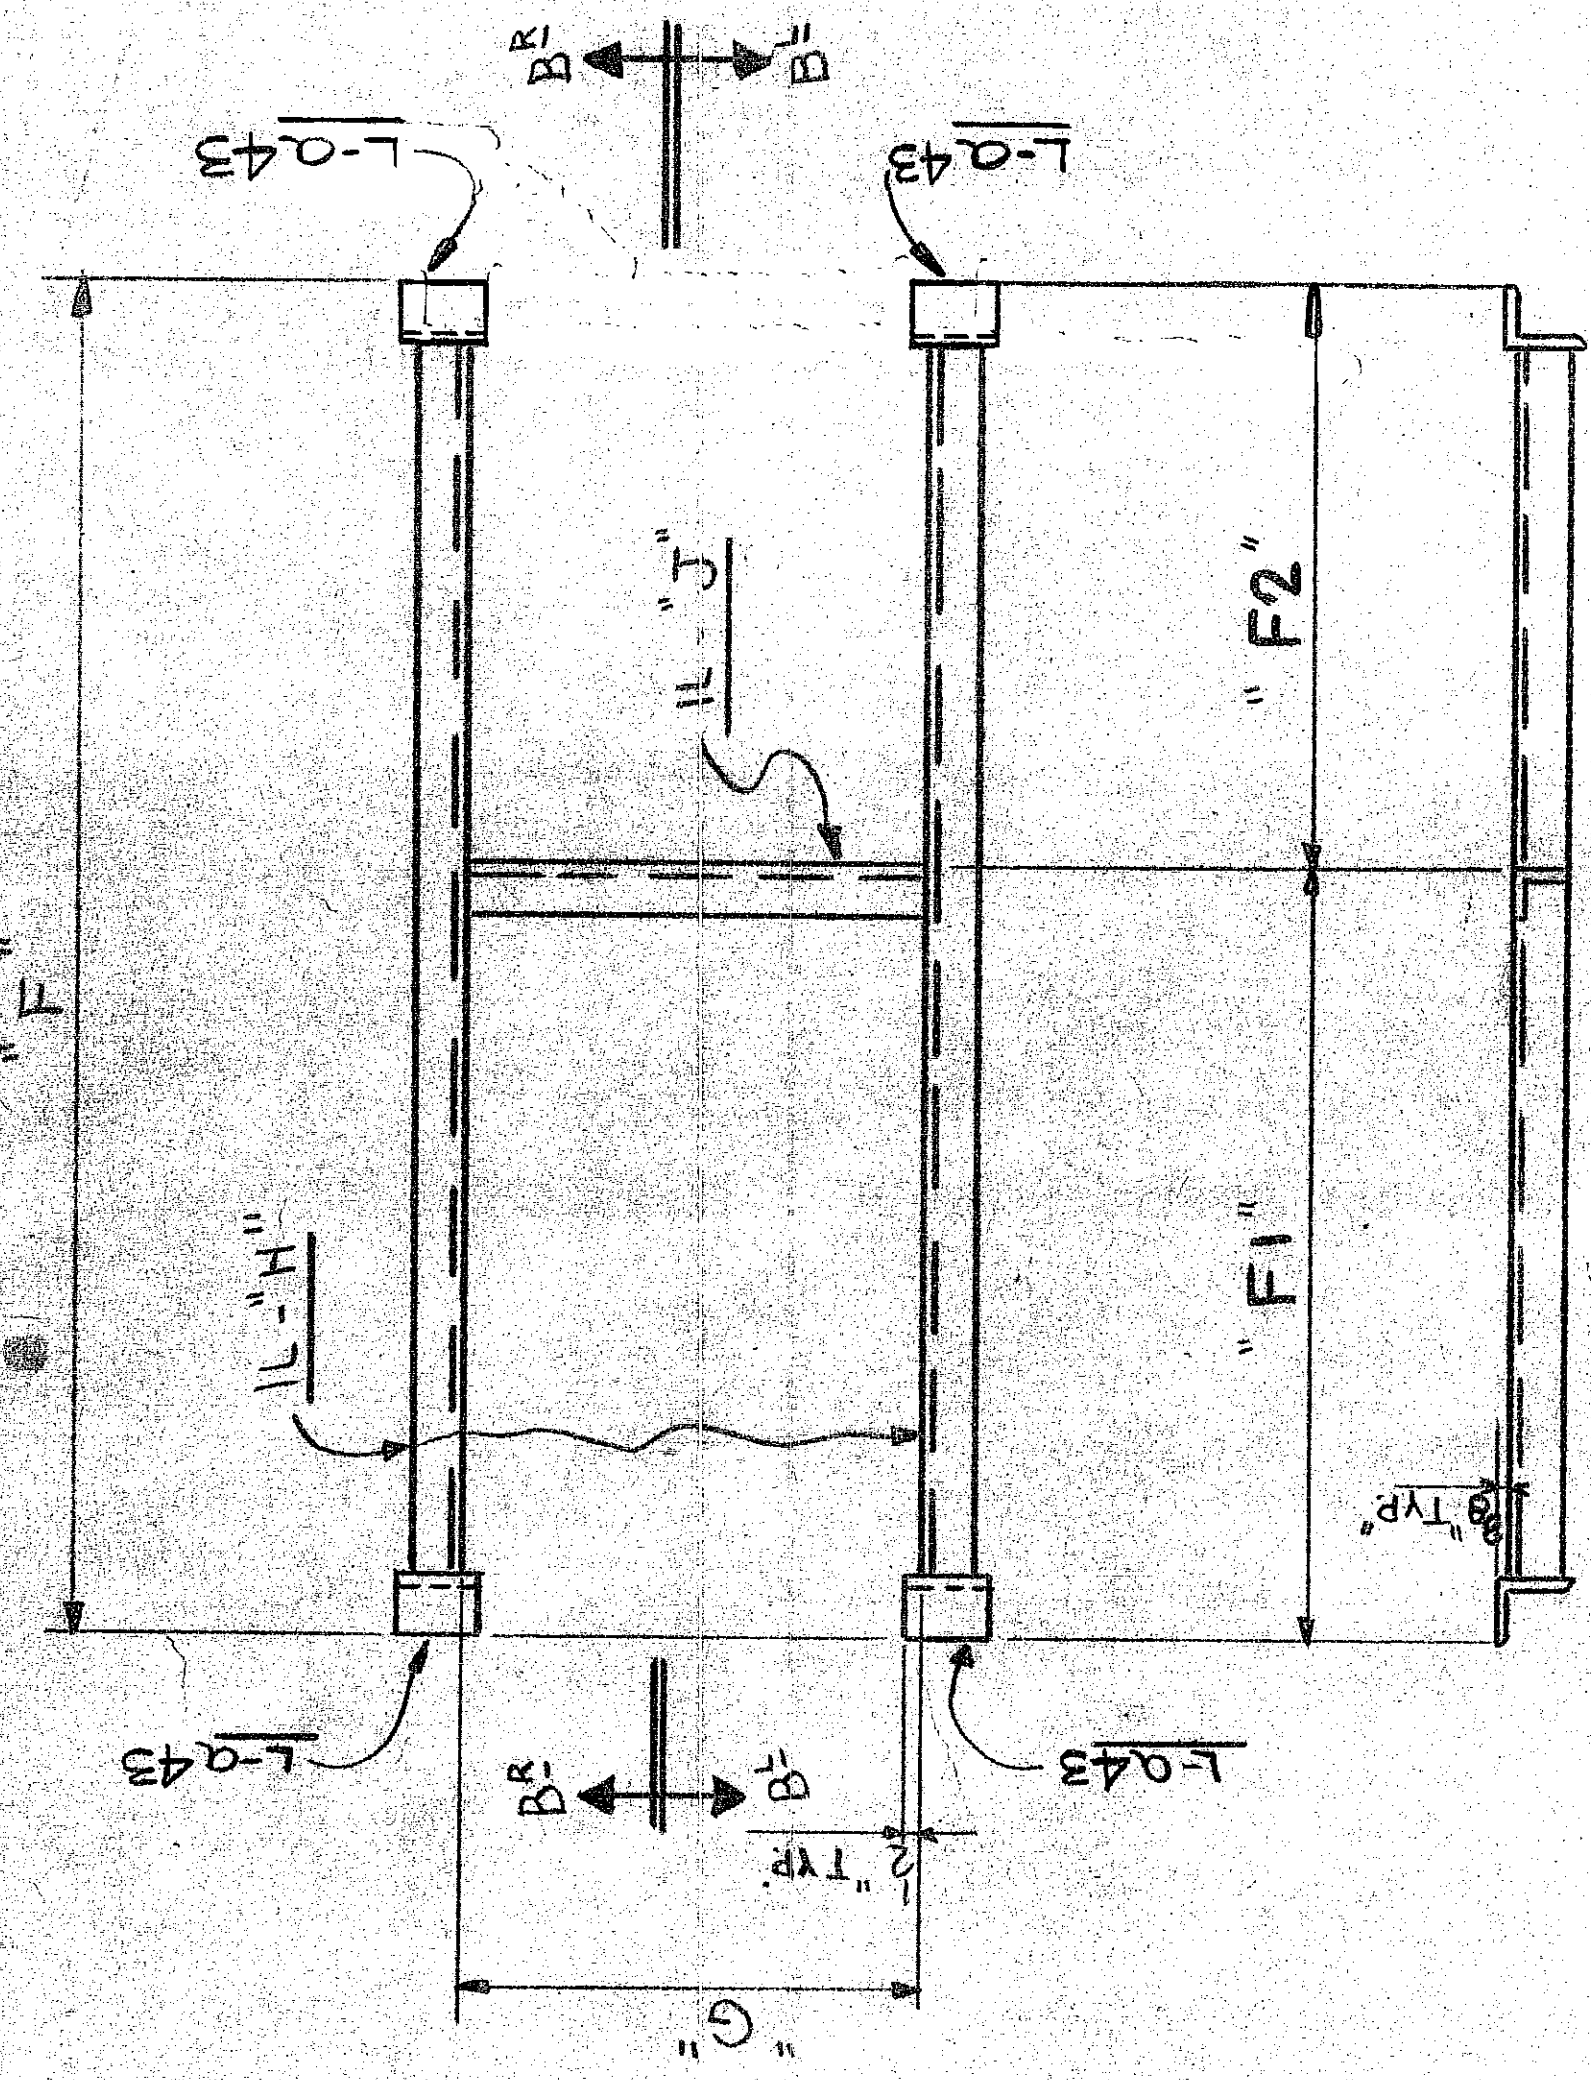


SECTION B-B (SHOWN)
SECTION B-B (OFF. HD.)

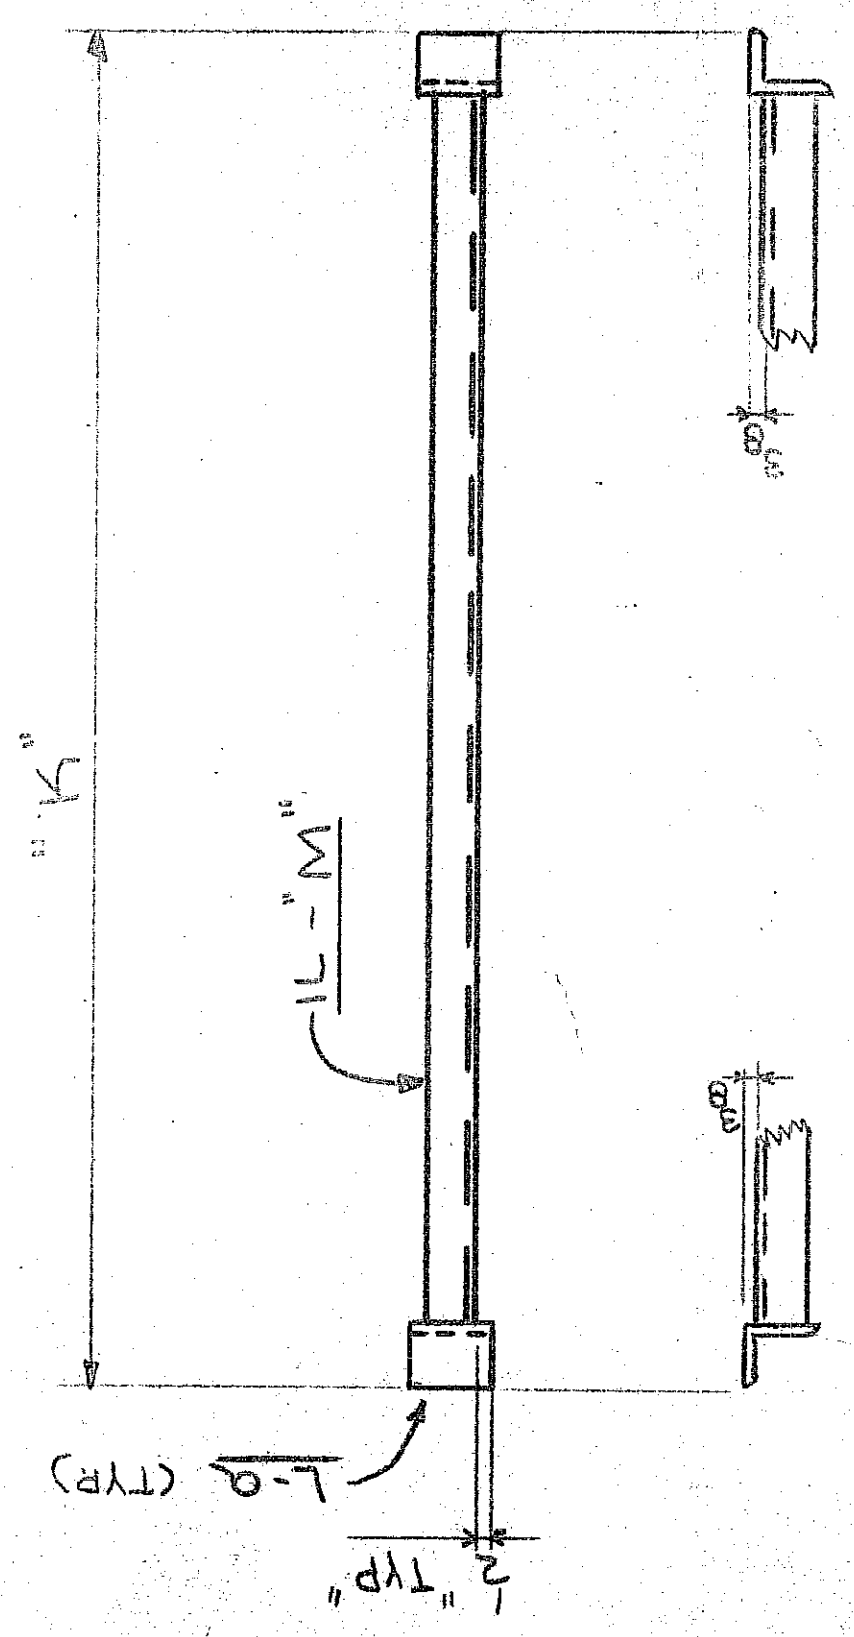

QUAN.	"K"	L "M"	MARK

QUAN.	"A"	"A1"	"A2"	"A3"	"B"	L "C"	L "D"	MARK
8	4'-0"	11 1/2"	2'-1"	11 1/2"	2'-1"	L-3.3.4.3.4-A43a	L-3.3.4.2-1-A43b	A43
ONE	4'-0"	8"	2'-0"	10"	3'-0"	L-3.4-A43a	L-3.0-B43a	B43

QUAN.	"F"	"F1"	"F2"	"G"	L "H"	L "J"	MARK
3	4'-0"	2'-1 1/2"	1'-0 1/2"	9"	L-3.3.4.3.4-A43a	L-3.3.4.0.9-C43a	C43

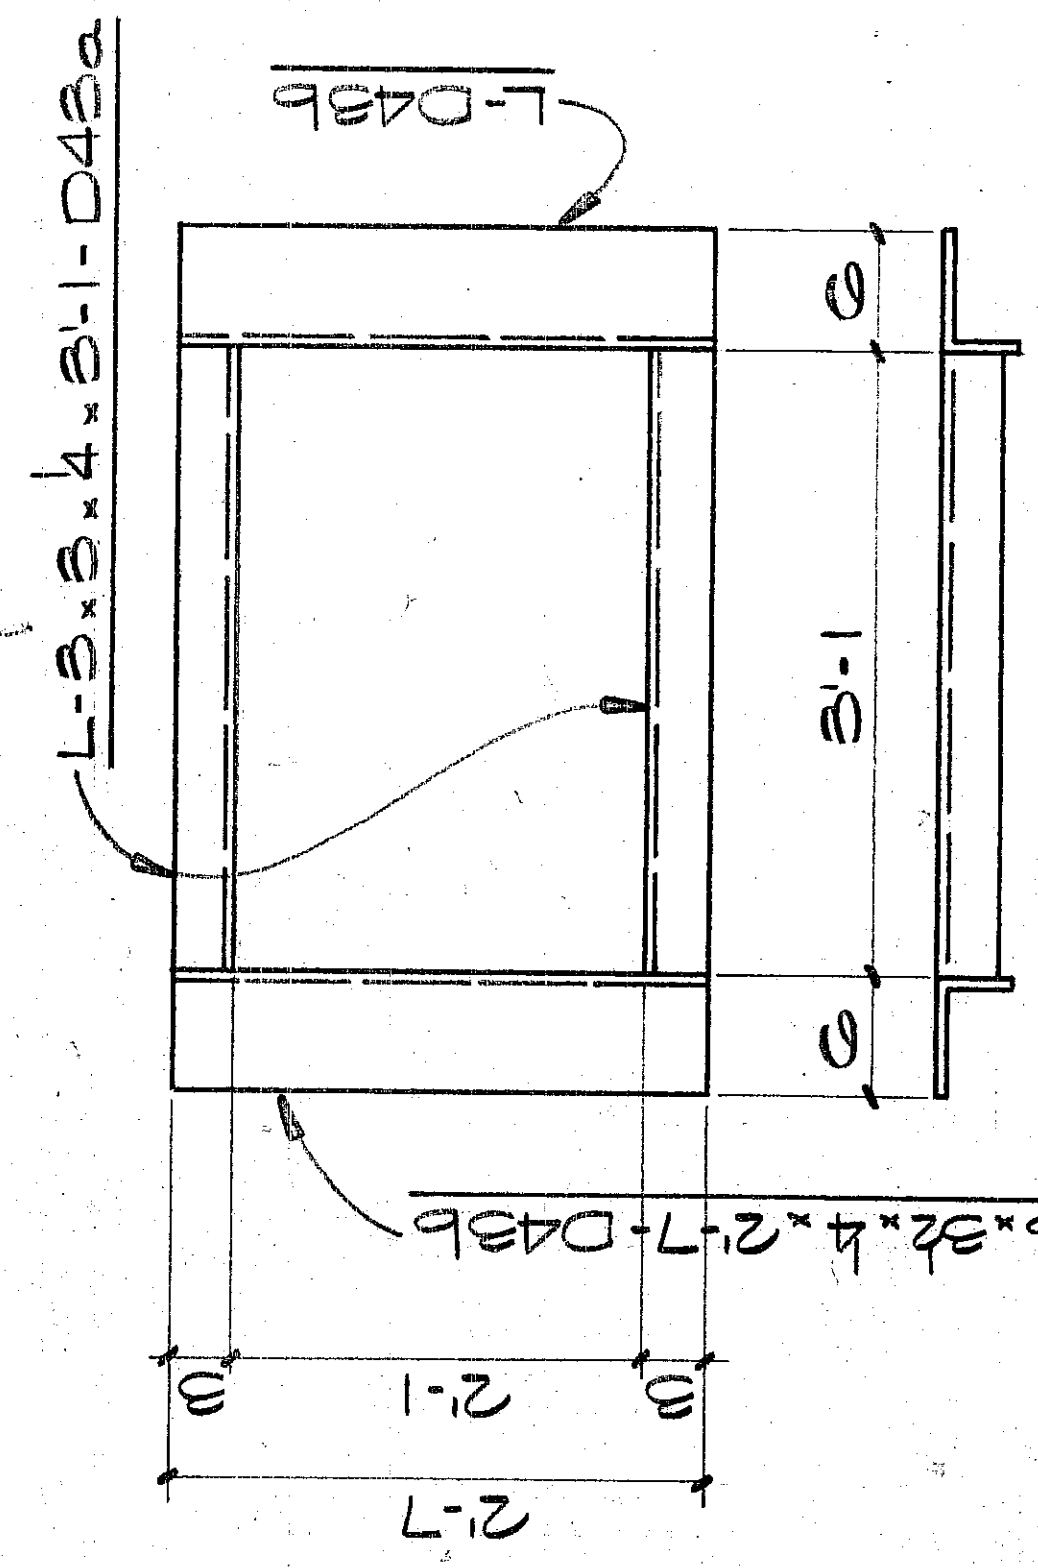

2 - FRAMES - D43

APPROVED
EVERETT I. BROWN CO.
BY 
DATE MAR 21 1983
APPROVED DRAWINGS
FOR FIELD USE
DATE MAR 9 1983

INTERSTATE WELDING & FABRICATION, INC. 1870 DAVIS AVENUE • TERRE HAUTE, INDIANA 47602	DWN BY EM
HOLES PAINT MADE CLEANING REF. DWGS.	CHKD. BY b. JOB # 6800 SHT. # 43
JACKSON ELEMENTARY SCHOOL CHESTERTON, INDIANA	