



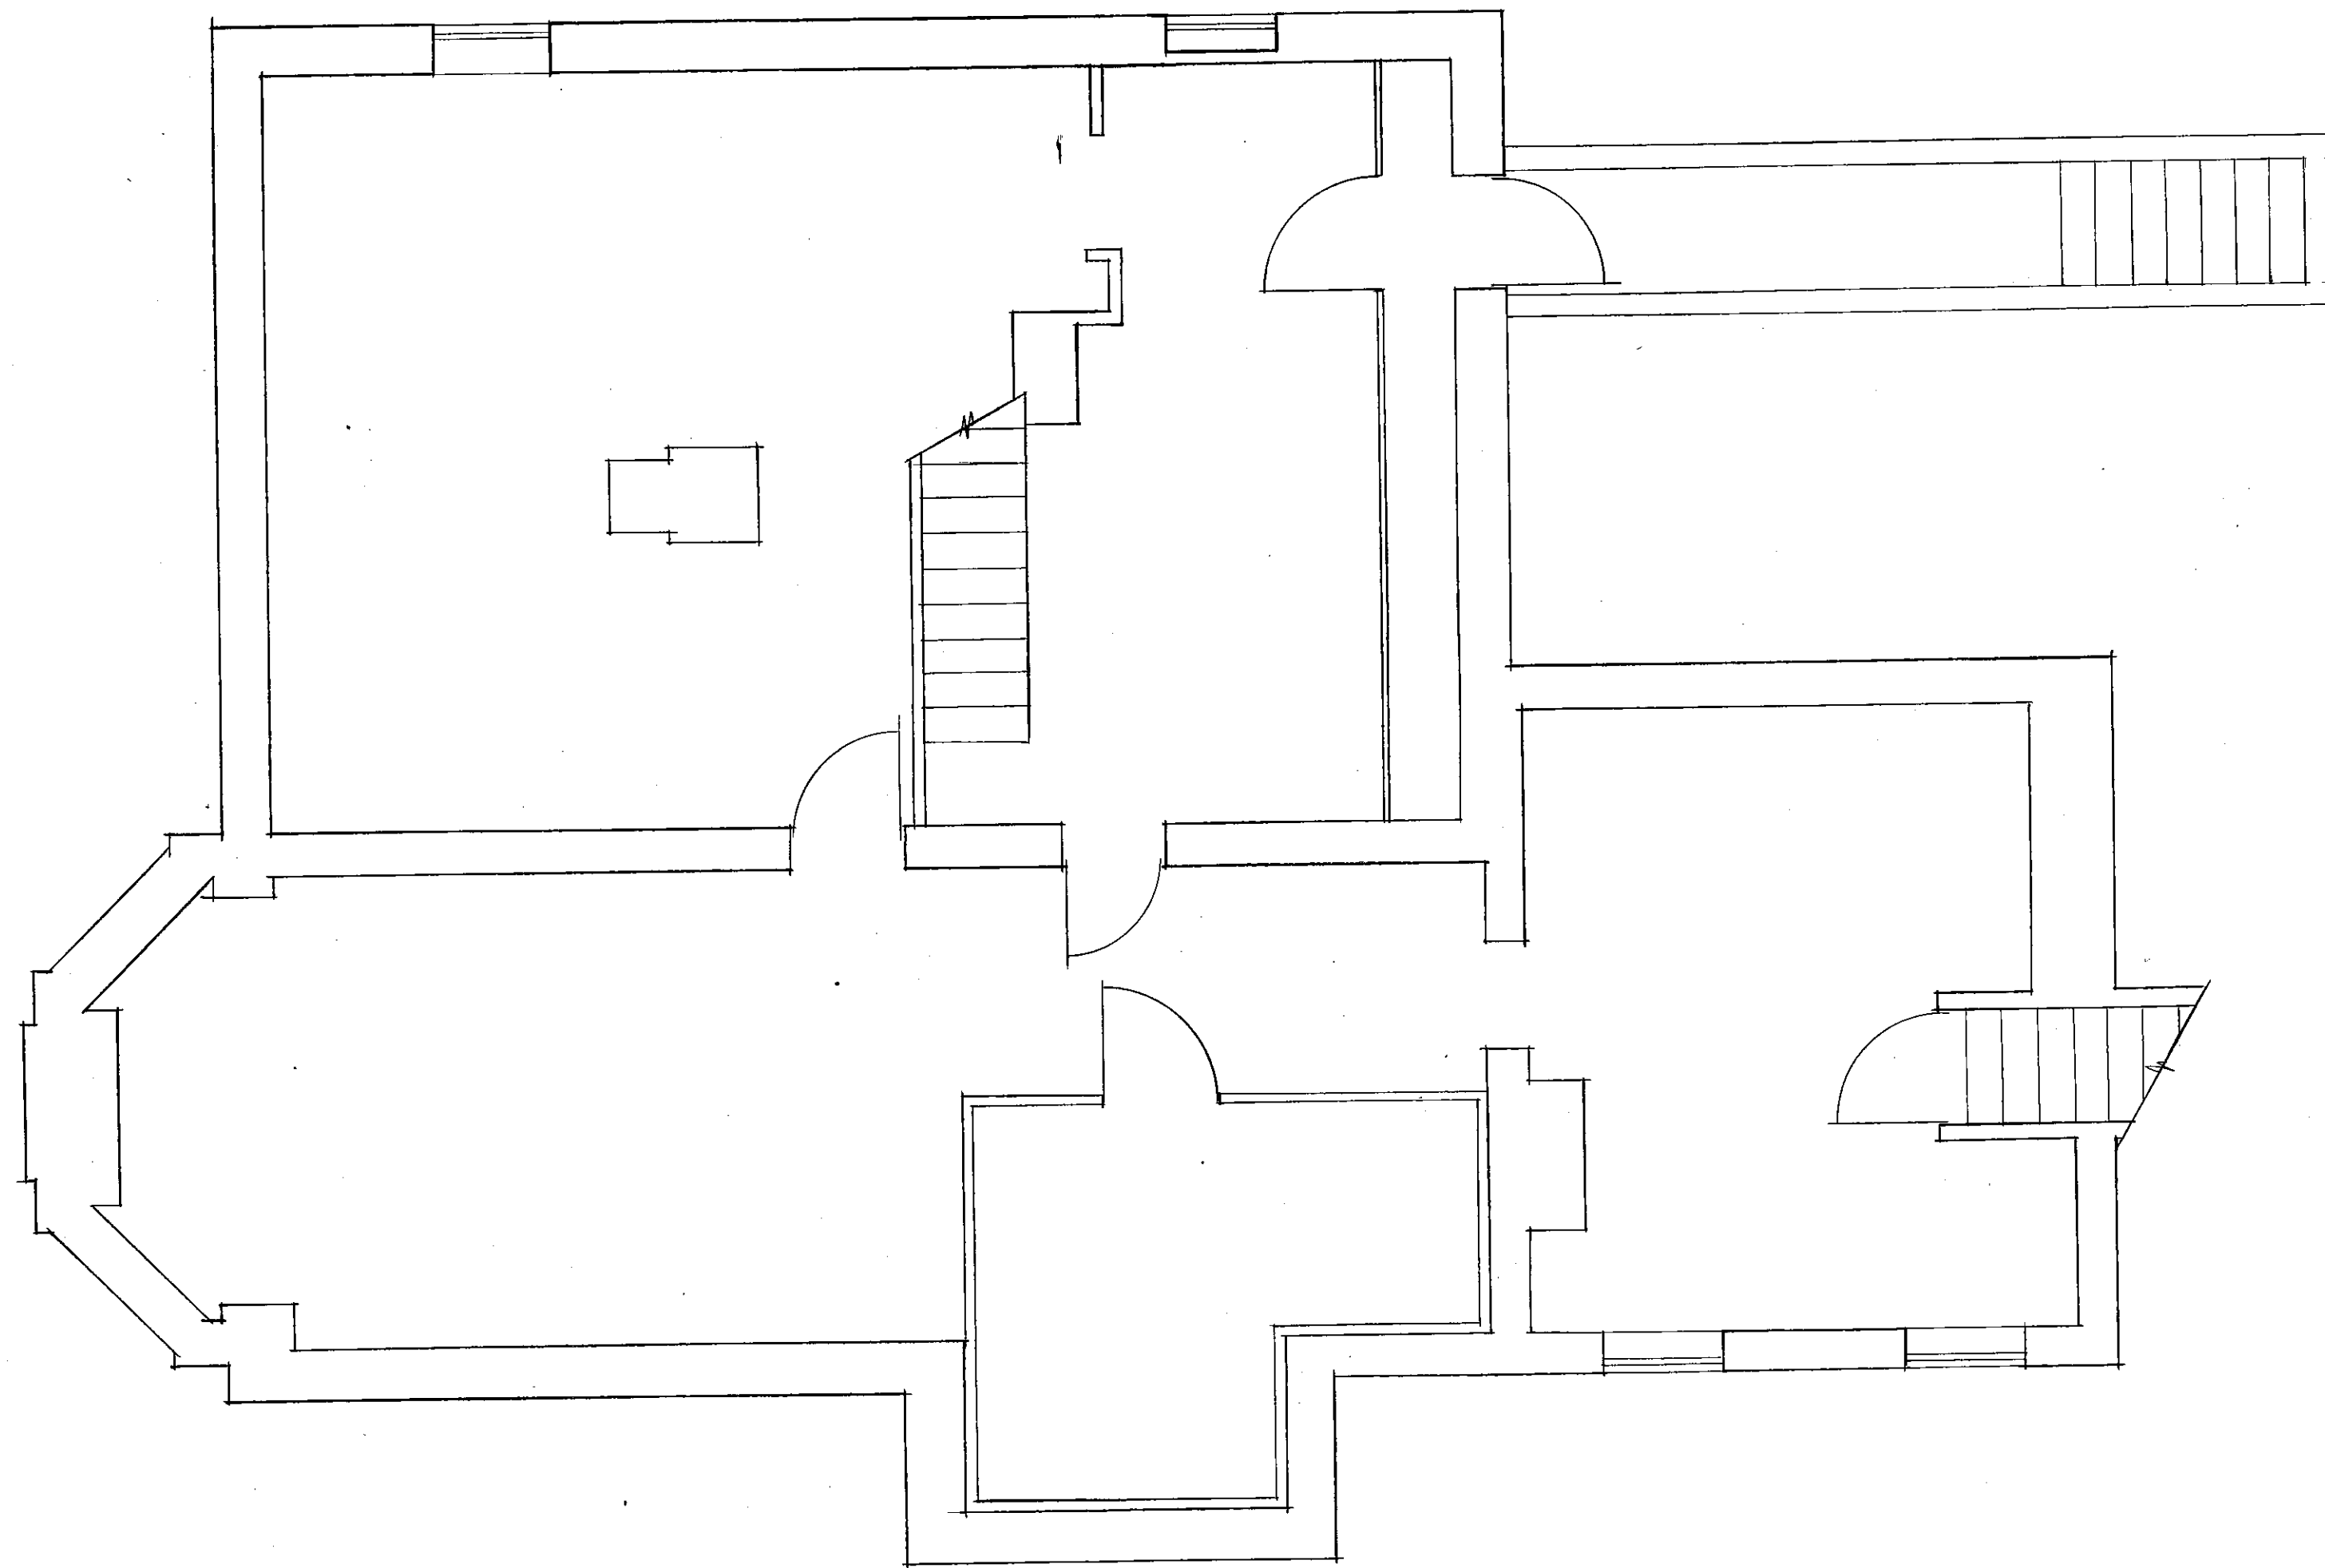

BASEMENT PLAN
SCALE: 1/4" = 1'-0" (note: this plan drawn from field measurements - verify all dimensions)

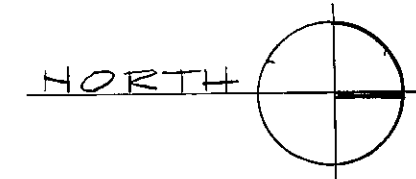

EVERETT · I · BROWN COMPANY ARCHITECTS
ENGINEERS
• INDIANAPOLIS, INDIANA • 46241
• PARK FLETCHER •
5500 WEST BRADBURY AVENUE •

PROJECT	DATE	REVISED
NO.	OF	
93-5-02		