DOUBLE - SIDED
80 CARD FILE DRWS.
P. L. TOP

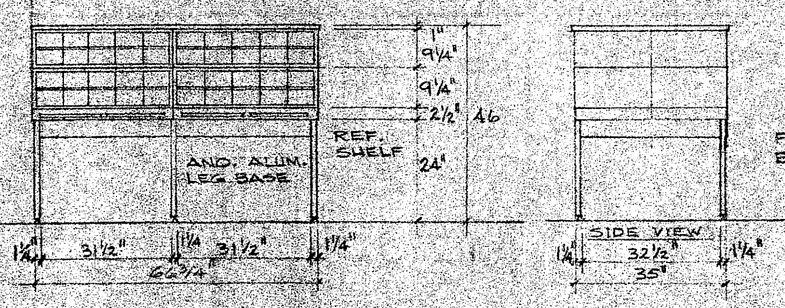

ELEV. 1
ONE REQ'D. - MEDIA CTR. A-143

6 VERT CARD TRAYS REMOVABLE P.L. TOP

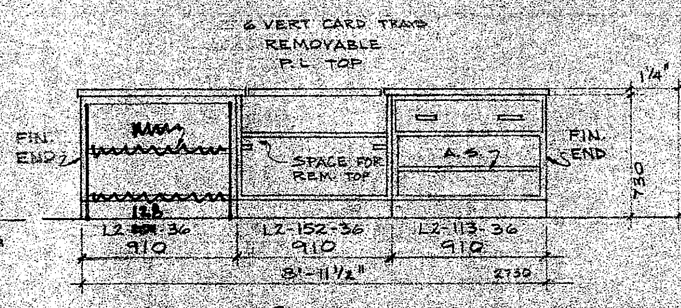

ELEV. 2
ONE REQ'D. - MEDIA CENTER A-143

each group of four carrells shall be comprised of 4 - #T8-800-36 as specified (12 units required).

DOUBLE SIDED — WRITING SURFACE ADJ. @ 25", 27", 29" A.F.F.

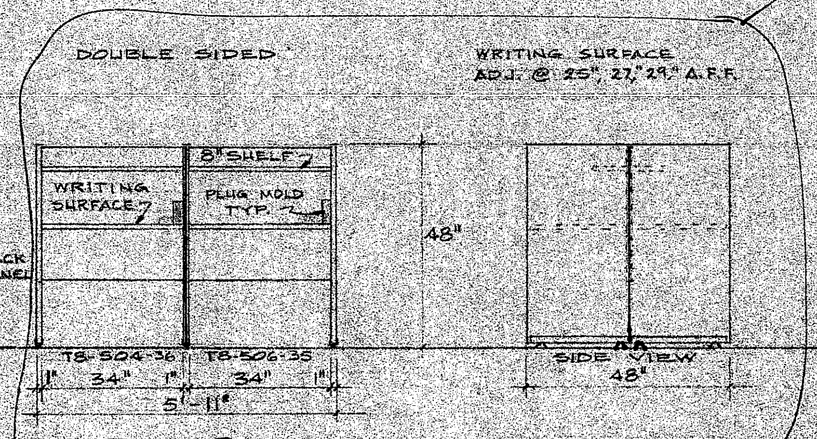

ELEV. 3
THREE REQ'D. - MEDIA CTR. A-143

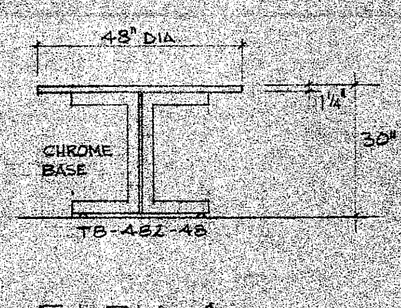

ELEV. 4
~~SEVEN~~ SIX REQ'D - MEDIA CTR. A-143

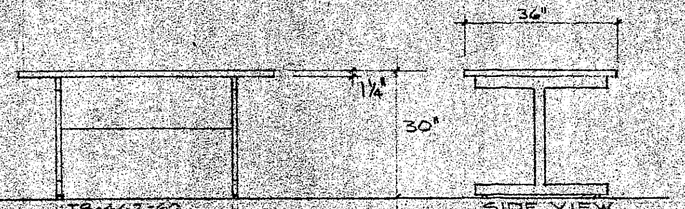

ELEV. 5
SIX REQ'D. - MEDIA CTR. A-143

266 DEEP = 10½"
298 DEEP (11¾")
SOFFIT SCRIBE
4 ADJ. SHELVES
5 SLOPING SHELVES
FILLER
INTERIORS SAME AS EXTERIORS
A.S. TYP.
PUTTY BACKS

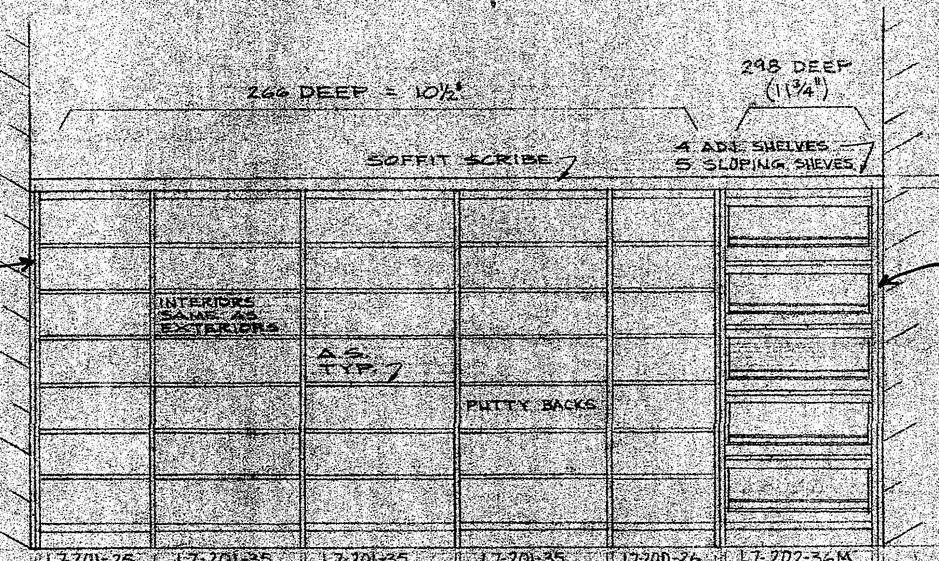

ELEV. 6
ONE REQ'D. - PROF. LIBRARY A-136

FIELD CHECK REQUIRED AVAILABLE SPACE

266 D. = 10½"

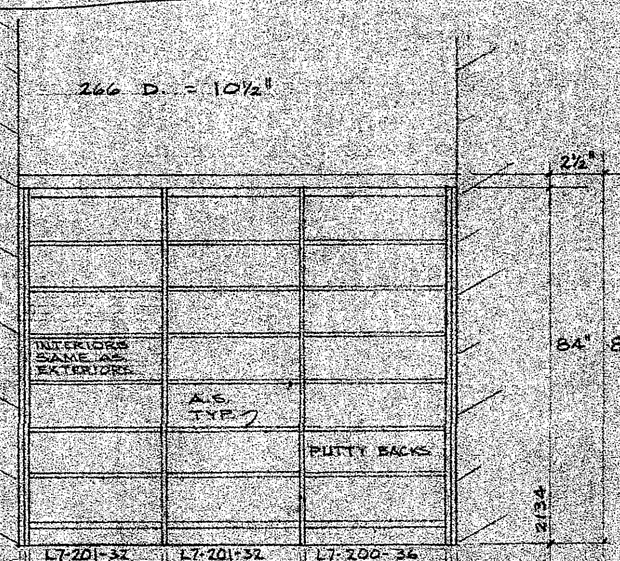

ELEV. 7
ONE REQ'D. - MEDIA OFFICE A-134

NOTE: VERIFY BULKHEAD HEIGHT AT JOB SITE.

FIELD CHECK REQUIRED AVAILABLE SPACE

17½" D.
20 CARD FILE DRWS.
P.L. TOP

FIELD CHECK REQUIRED FLOOR TO WINDOW SILL

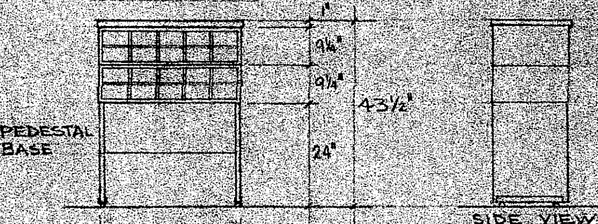

ELEV. 8
ONE REQ'D. - MED. OFCE. A-134

266 D. = 10½"

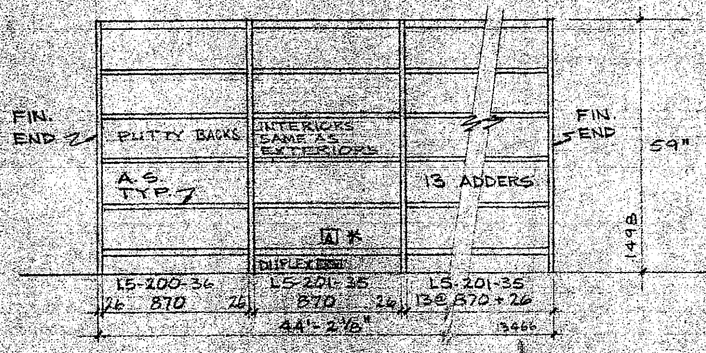

ELEV. 9
ONE REQ'D. - MEDIA CENTER A-143

* NOTE: THREE DUPLEX OUTLETS REQ'D. THIS ELEV. LOCATED AS PER PLAN VIEW.

502 D. = 19¾"
DOUBLE SIDED

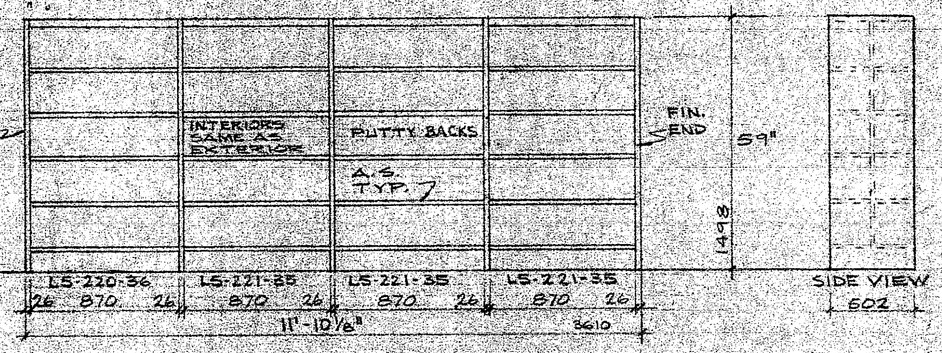

ELEV. 10
FIVE REQ'D. - MEDIA CENTER A-143

266 D. = 10½"

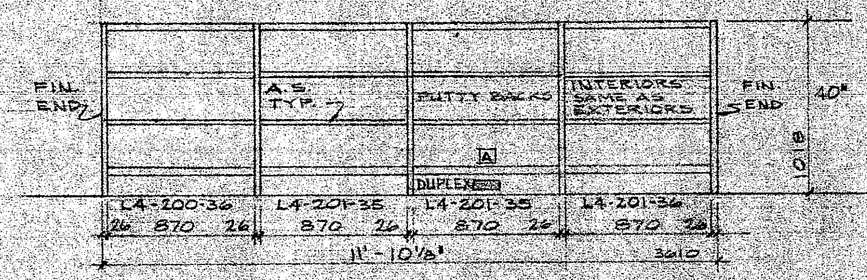

ELEV. 11
ONE REQ'D. - MEDIA CENTER A-143

266 D. = 10½"

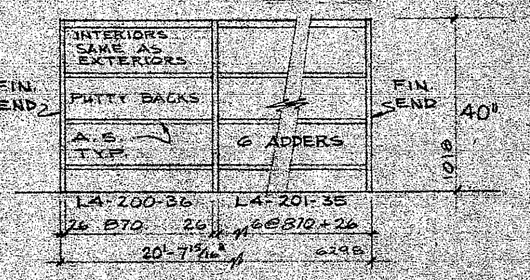

ELEV. 12
ONE REQ'D. - MEDIA CTR. A-143

NOTE: ONE DUPLEX OUTLET REQ'D. THIS ELEV. LOCATED AS PER PLAN VIEW.

SCALE: 1:25 mm	DRAWN BY: WLB	REVISIONS	APPROVED	FIELD CHECK	ACCEPTED BY	STEVENS TEUTOPOLIS, ILLINOIS 62467	DEALER: LEE COMPANY INC. TERRE HAUTE, INDIANA	P.O. 30683	JACKSON ELEMENTARY SCHOOL VALPARAISO, INDIANA	RUN NO.	SHEET 2 OF 3
DATE: 2-28-83	CHECKED BY		COLORS	PRODUCTION	DATE					DRAWING NO. 82333	

82-42