

566 D. = 22 1/4" DOUBLE SIDED






566 D. = 22 1/4" DOUBLE SIDED

298 D. = 13 1/4"

566 D. = 22 1/4" DOUBLE SIDED

1 ADJ. SHELF & 2 SLOPING SHELVES W/ 8 RODS

1 NEWSPAPER RACK INSERT

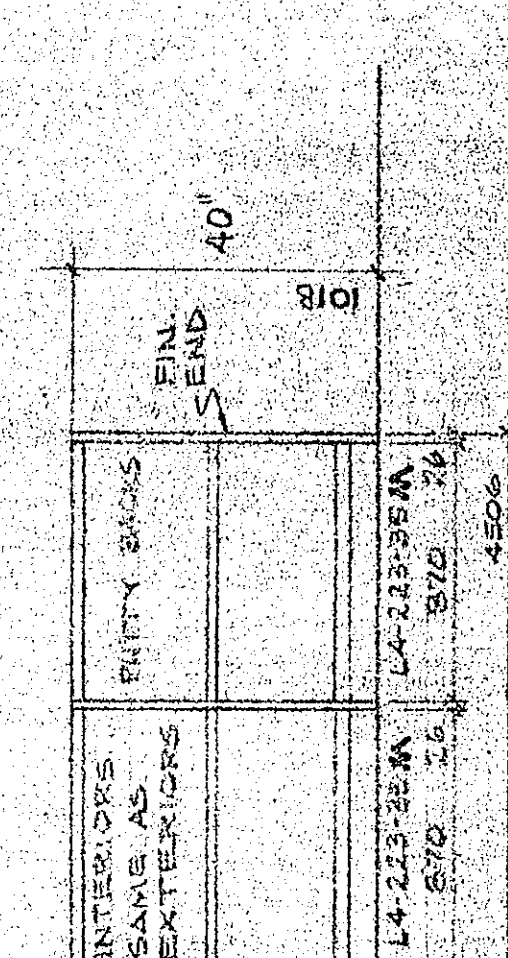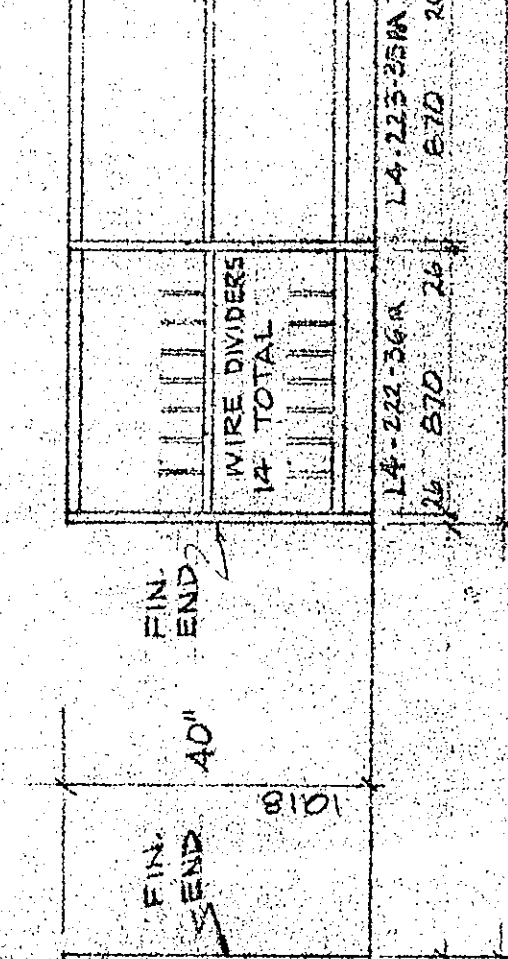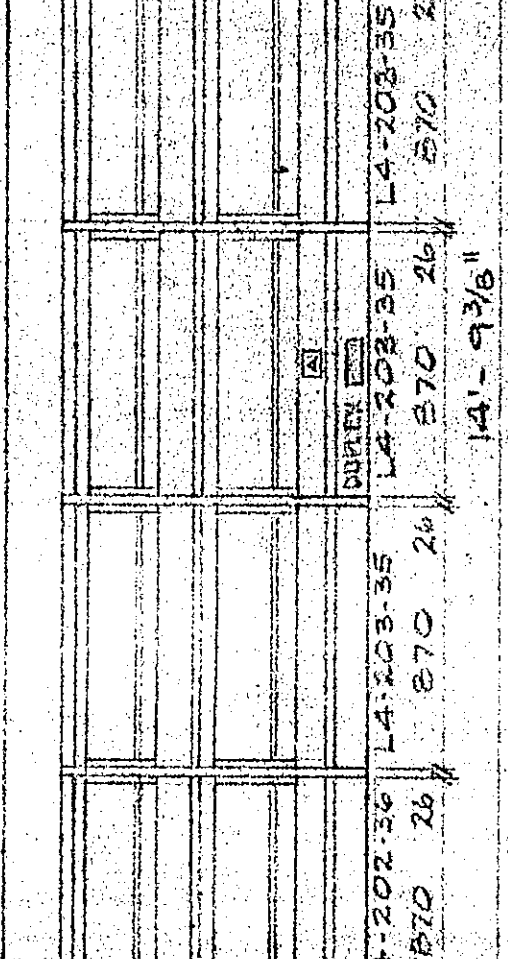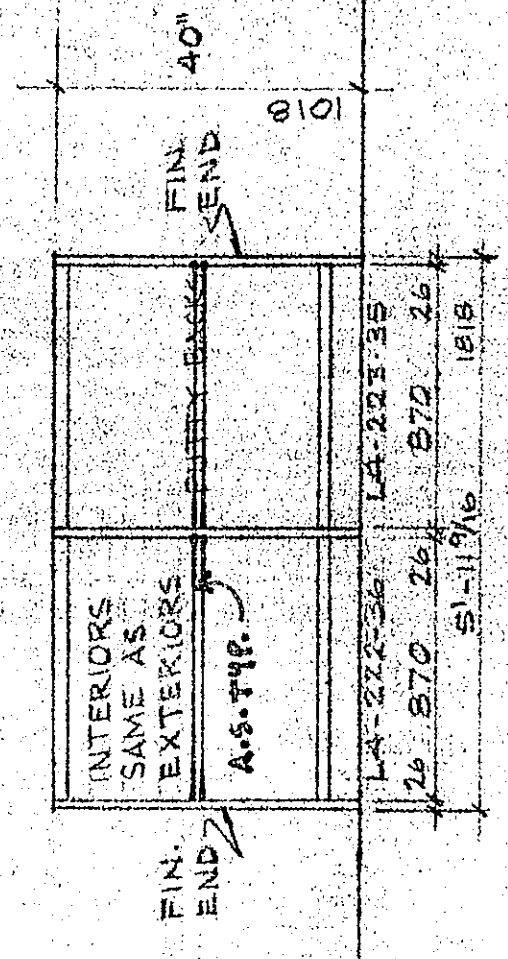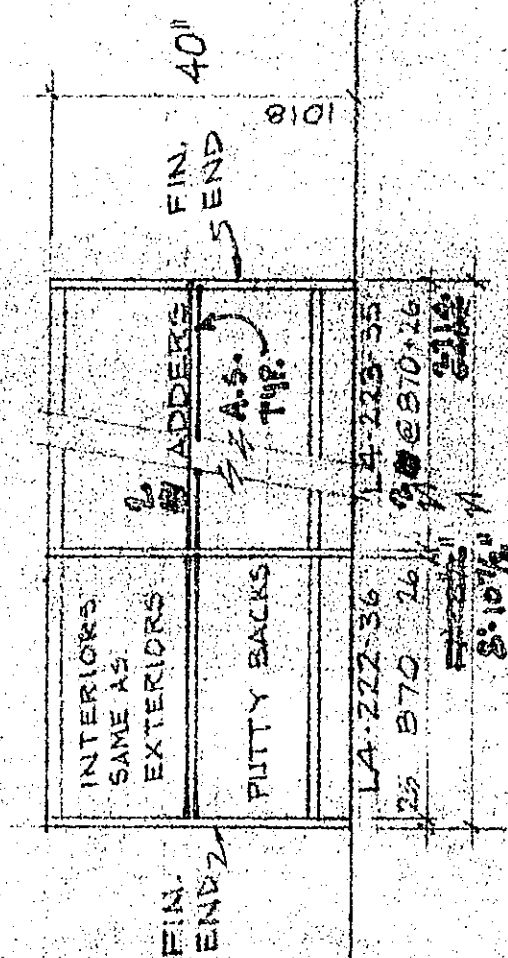

566 D. = 22 1/4" DOUBLE SIDED

566 D. = 22 1/4" DOUBLE SIDED

566 D. = 22 1/4" DOUBLE SIDED

566 D. = 22 1/4" DOUBLE SIDED

see plan, detail and schedule on Architect's drawing sheet A-13 and construct as specified!

