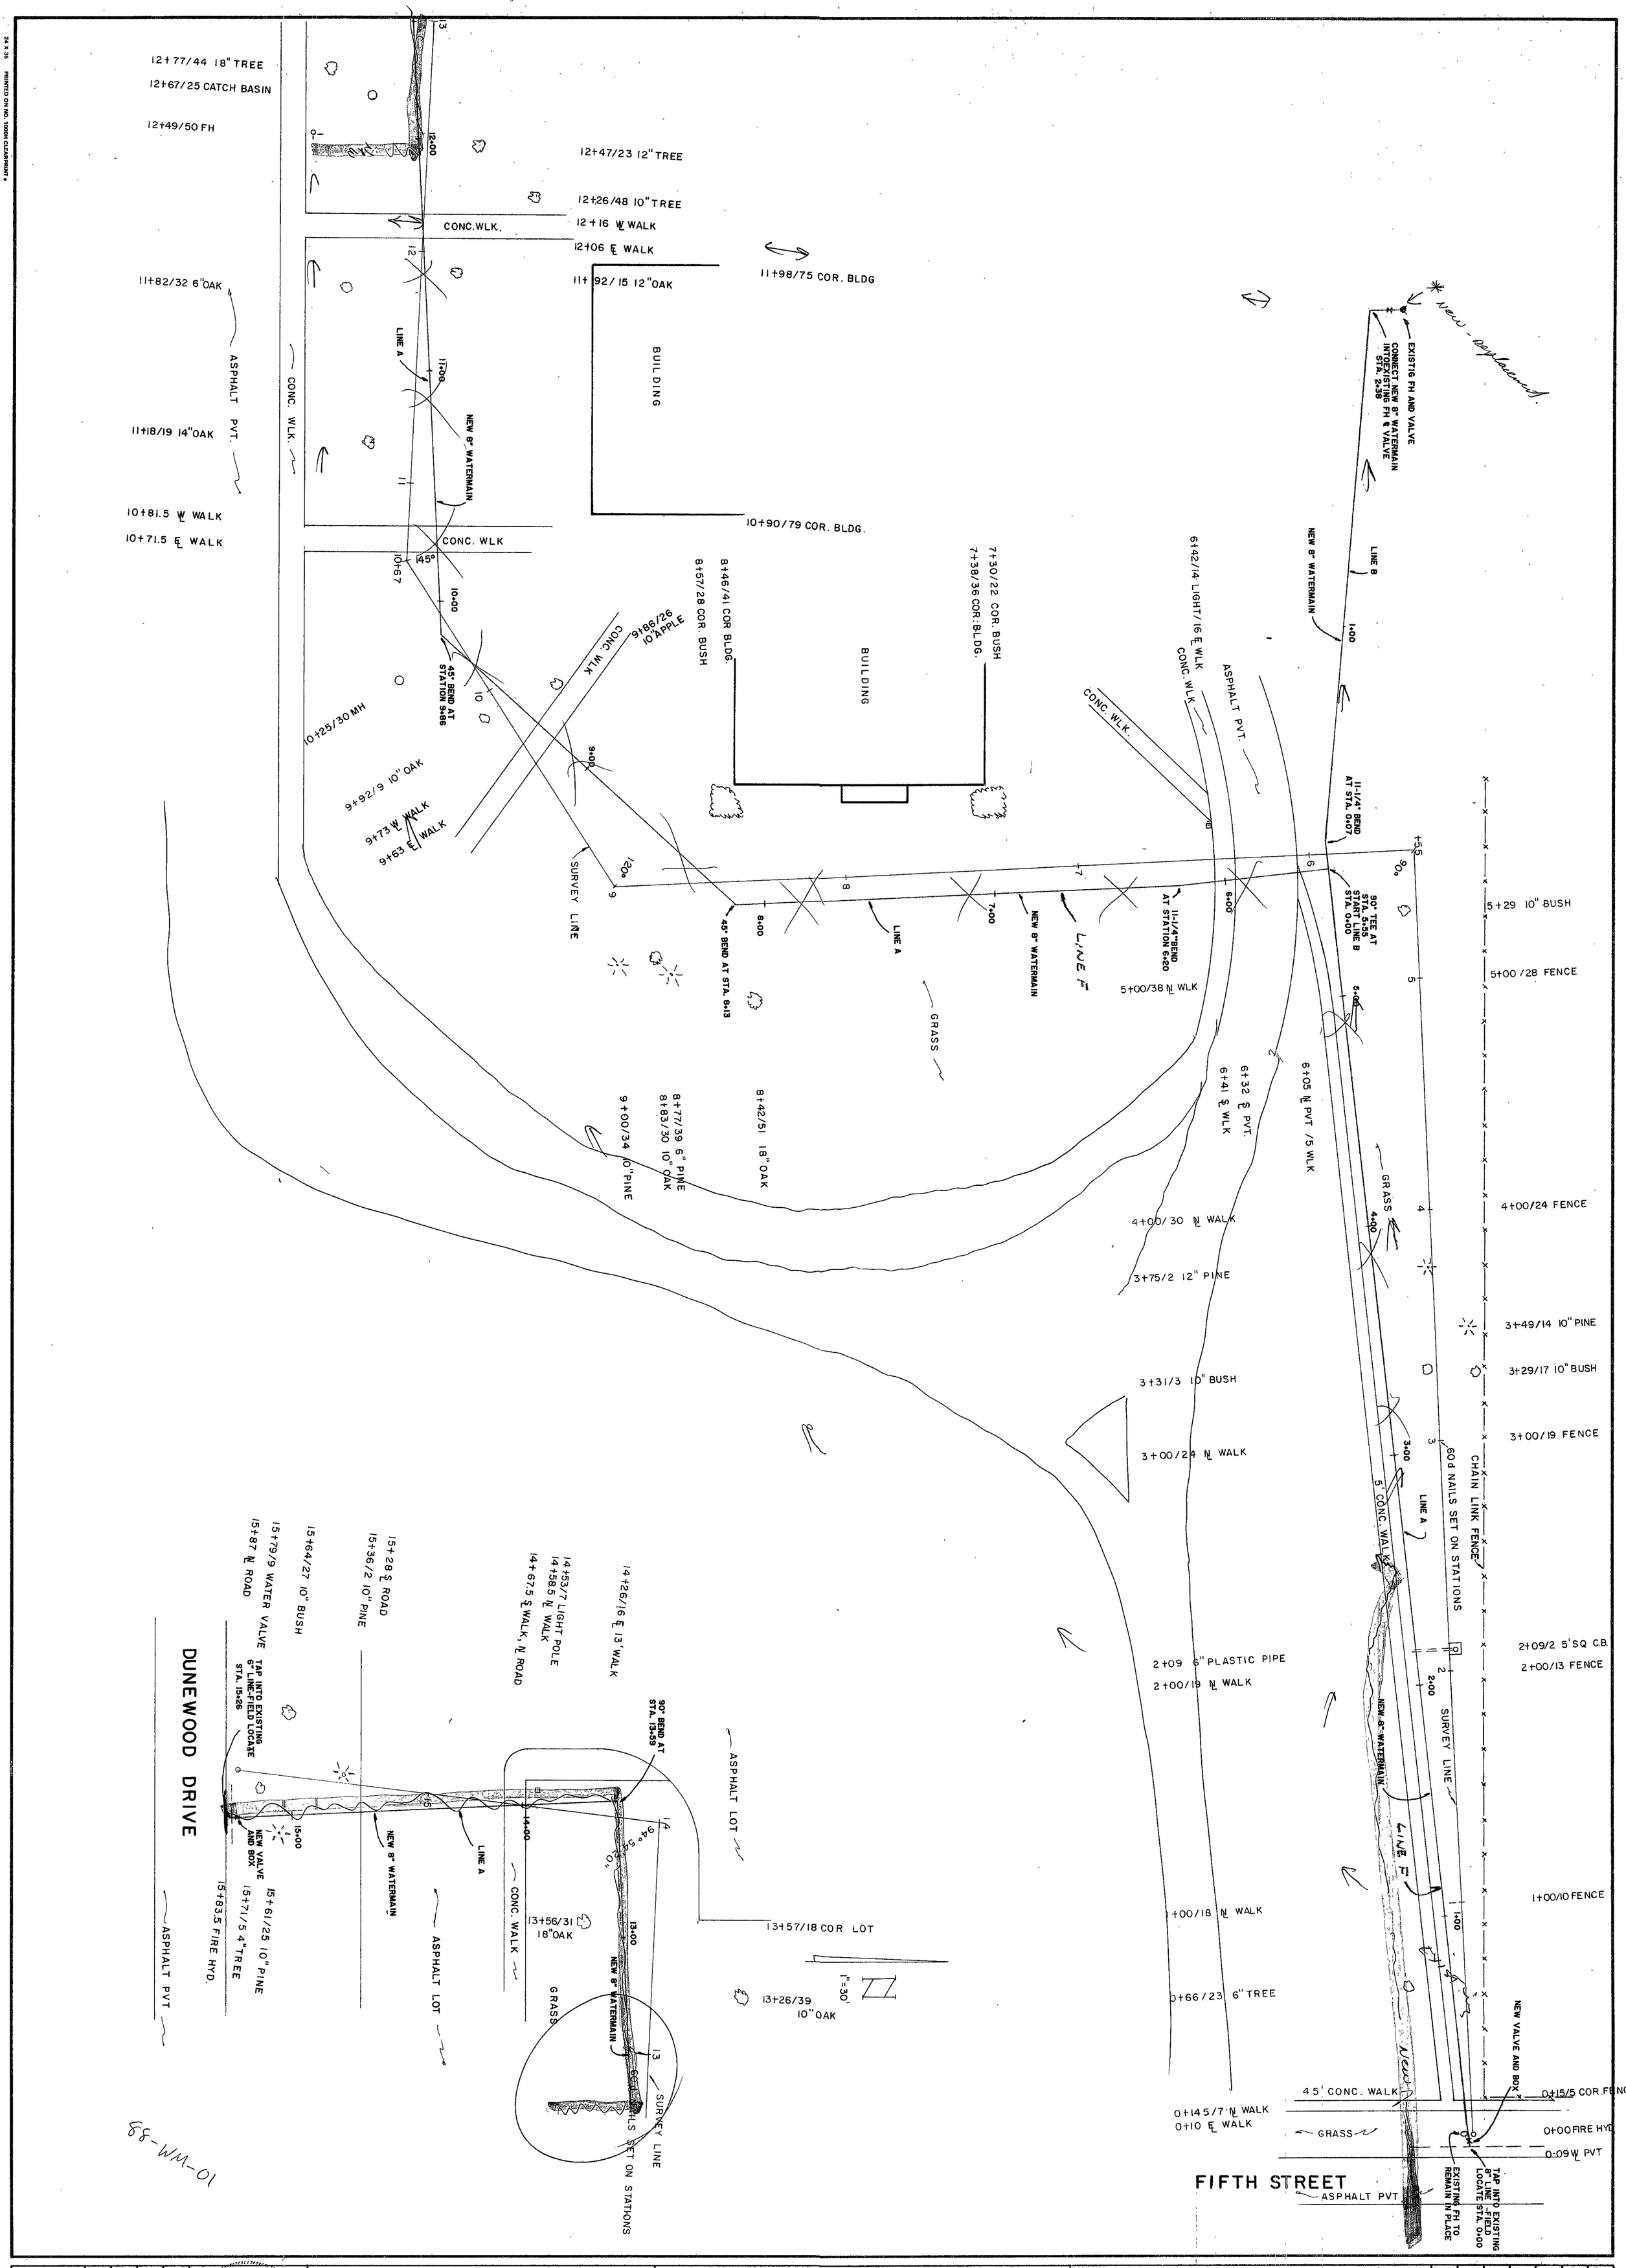


88-WM-01

| | | | | |
|---|---|---|---|---|
| Sheet 2 Of 9 Sheets | Job | Drawn EMS | Scale 1" = 30' | Date 4-20-88 |

**CHESTERTON, INDIANA**
**WATER MAIN DISTRIBUTION FACILITIES**

**WESTCHESTER MIDDLE SCHOOL AREA**

**KEITH FUJIHARA, INC.**
**MICHIGAN CITY, INDIANA**

| REVISIONS | BY |
|---|---|
| | |

24 X 36 PRINTED ON NO. 1000H CLEARPRINT®