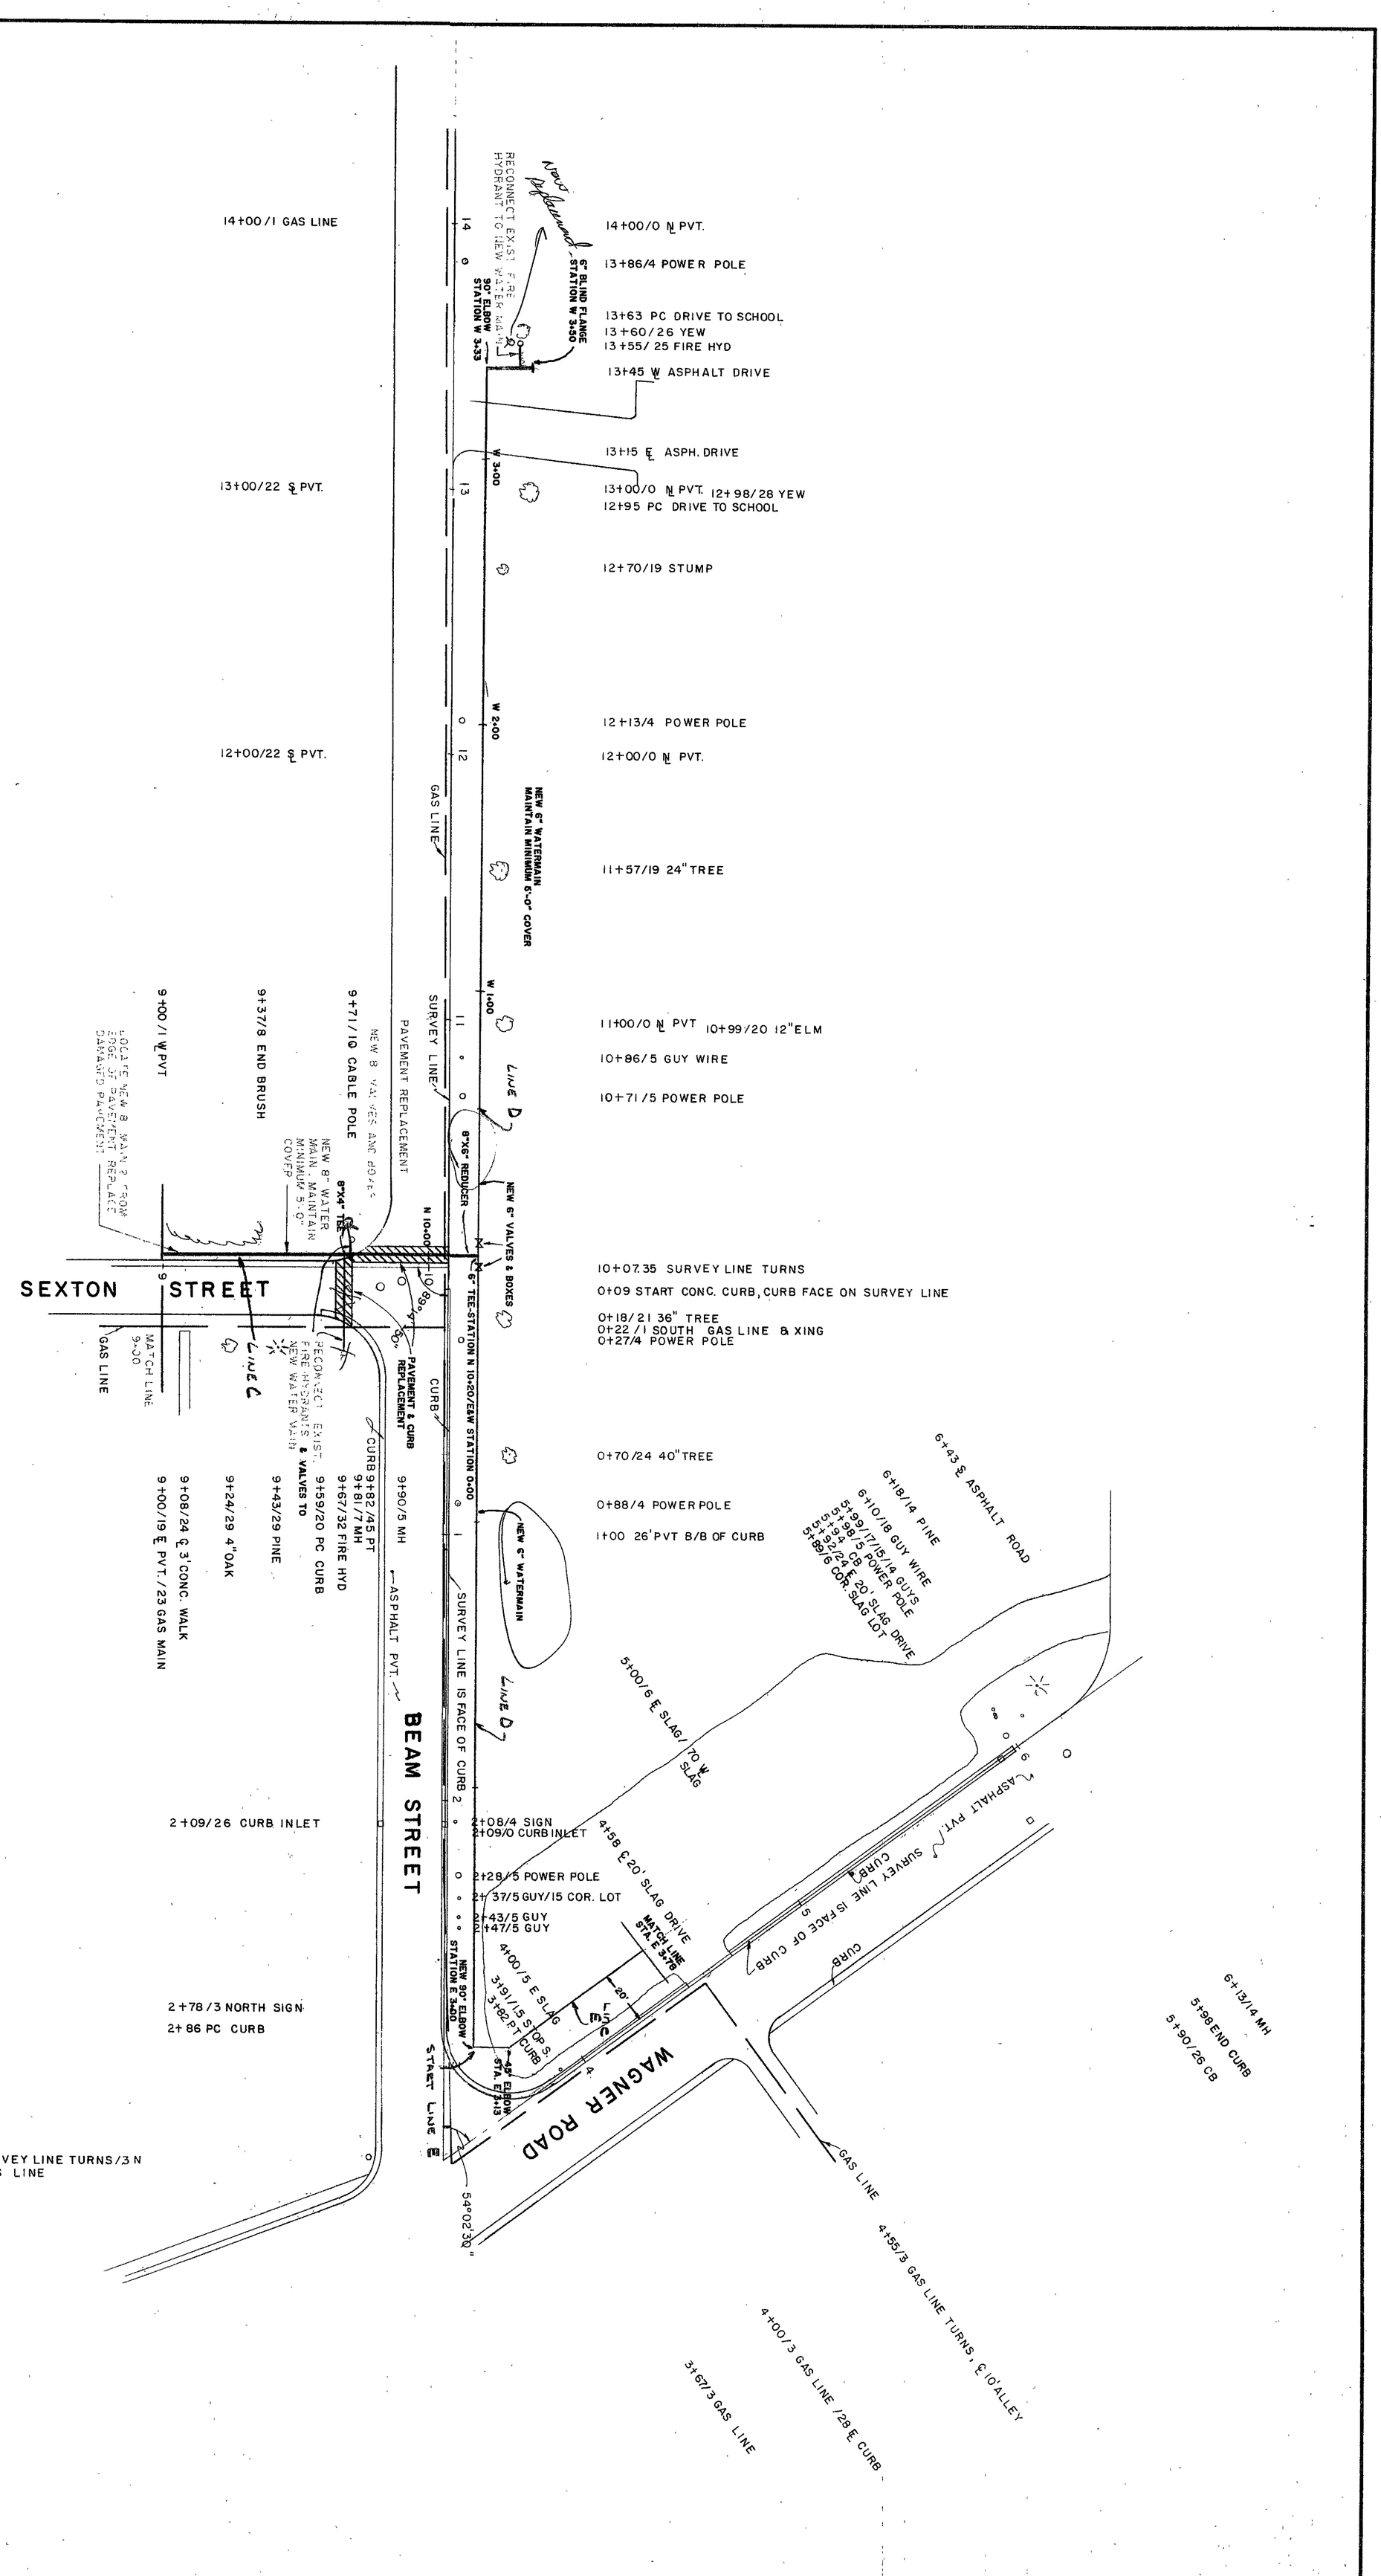

88-WM-03

Sheet 4 Of 9 Sheets	Job	Drawn EMS	Scale 1" = 30'	Date MAY 10, 1988	CHESTERTON, INDIANA WATER MAIN DISTRIBUTION FACILITIES

YOST SCHOOL AREA

KEITH FUJIHARA, INC.
MICHIGAN CITY, INDIANA

REVISIONS	BY

24 X 36 PRINTED ON NO. 1000H CLEARPRINT®