


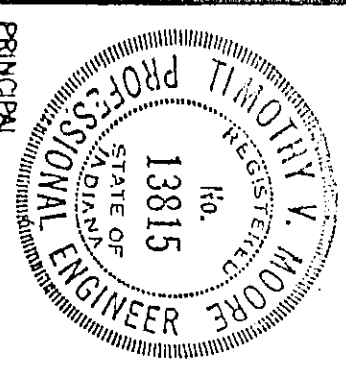

PRINCIPAL PROJECT ENGINEER
CERTIFIED BY
V. Moore
PROJECT NO. 94054

PRODUCT REQUEST
CERTIFIED BY

REVISIONS

MARK	DATE	DESCRIPTION

MOORE ENGINEERS
A PROFESSIONAL CORPORATION
9245 N. Meridian Street, Suite 105
Indianapolis, Indiana 46260-1812
(317) 848-5045 FAX: (317) 848-2705

COPYRIGHT NOTICE: THIS DRAWING IS THE PROPERTY OF MOORE ENGINEERS. IT IS TO BE USED ONLY FOR THE PROJECT AND SITE SPECIFICALLY IDENTIFIED HEREON. NO PART OF THIS DRAWING IS TO BE REPRODUCED OR TRANSMITTED IN ANY FORM OR BY ANY MEANS, ELECTRONIC OR MECHANICAL, WITHOUT PERMISSION IN WRITING FROM MOORE ENGINEERS.


COMMUNICATIONS INFRASTRUCTURE FOR DUNELAND SCHOOL CORPORATION

**DUNELAND SCHOOL CORPORATION
CHESTERTON, INDIANA**

BRUMMITT ELEMENTARY SCHOOL

DATE	12/5/94	SHEET NO.	10
SCALE	1/8" = 1'-0"	CONV. NO.	94054
DRAWN BY	R.D.C.		

ELECTRICAL SYSTEM PLAN - UNIT B

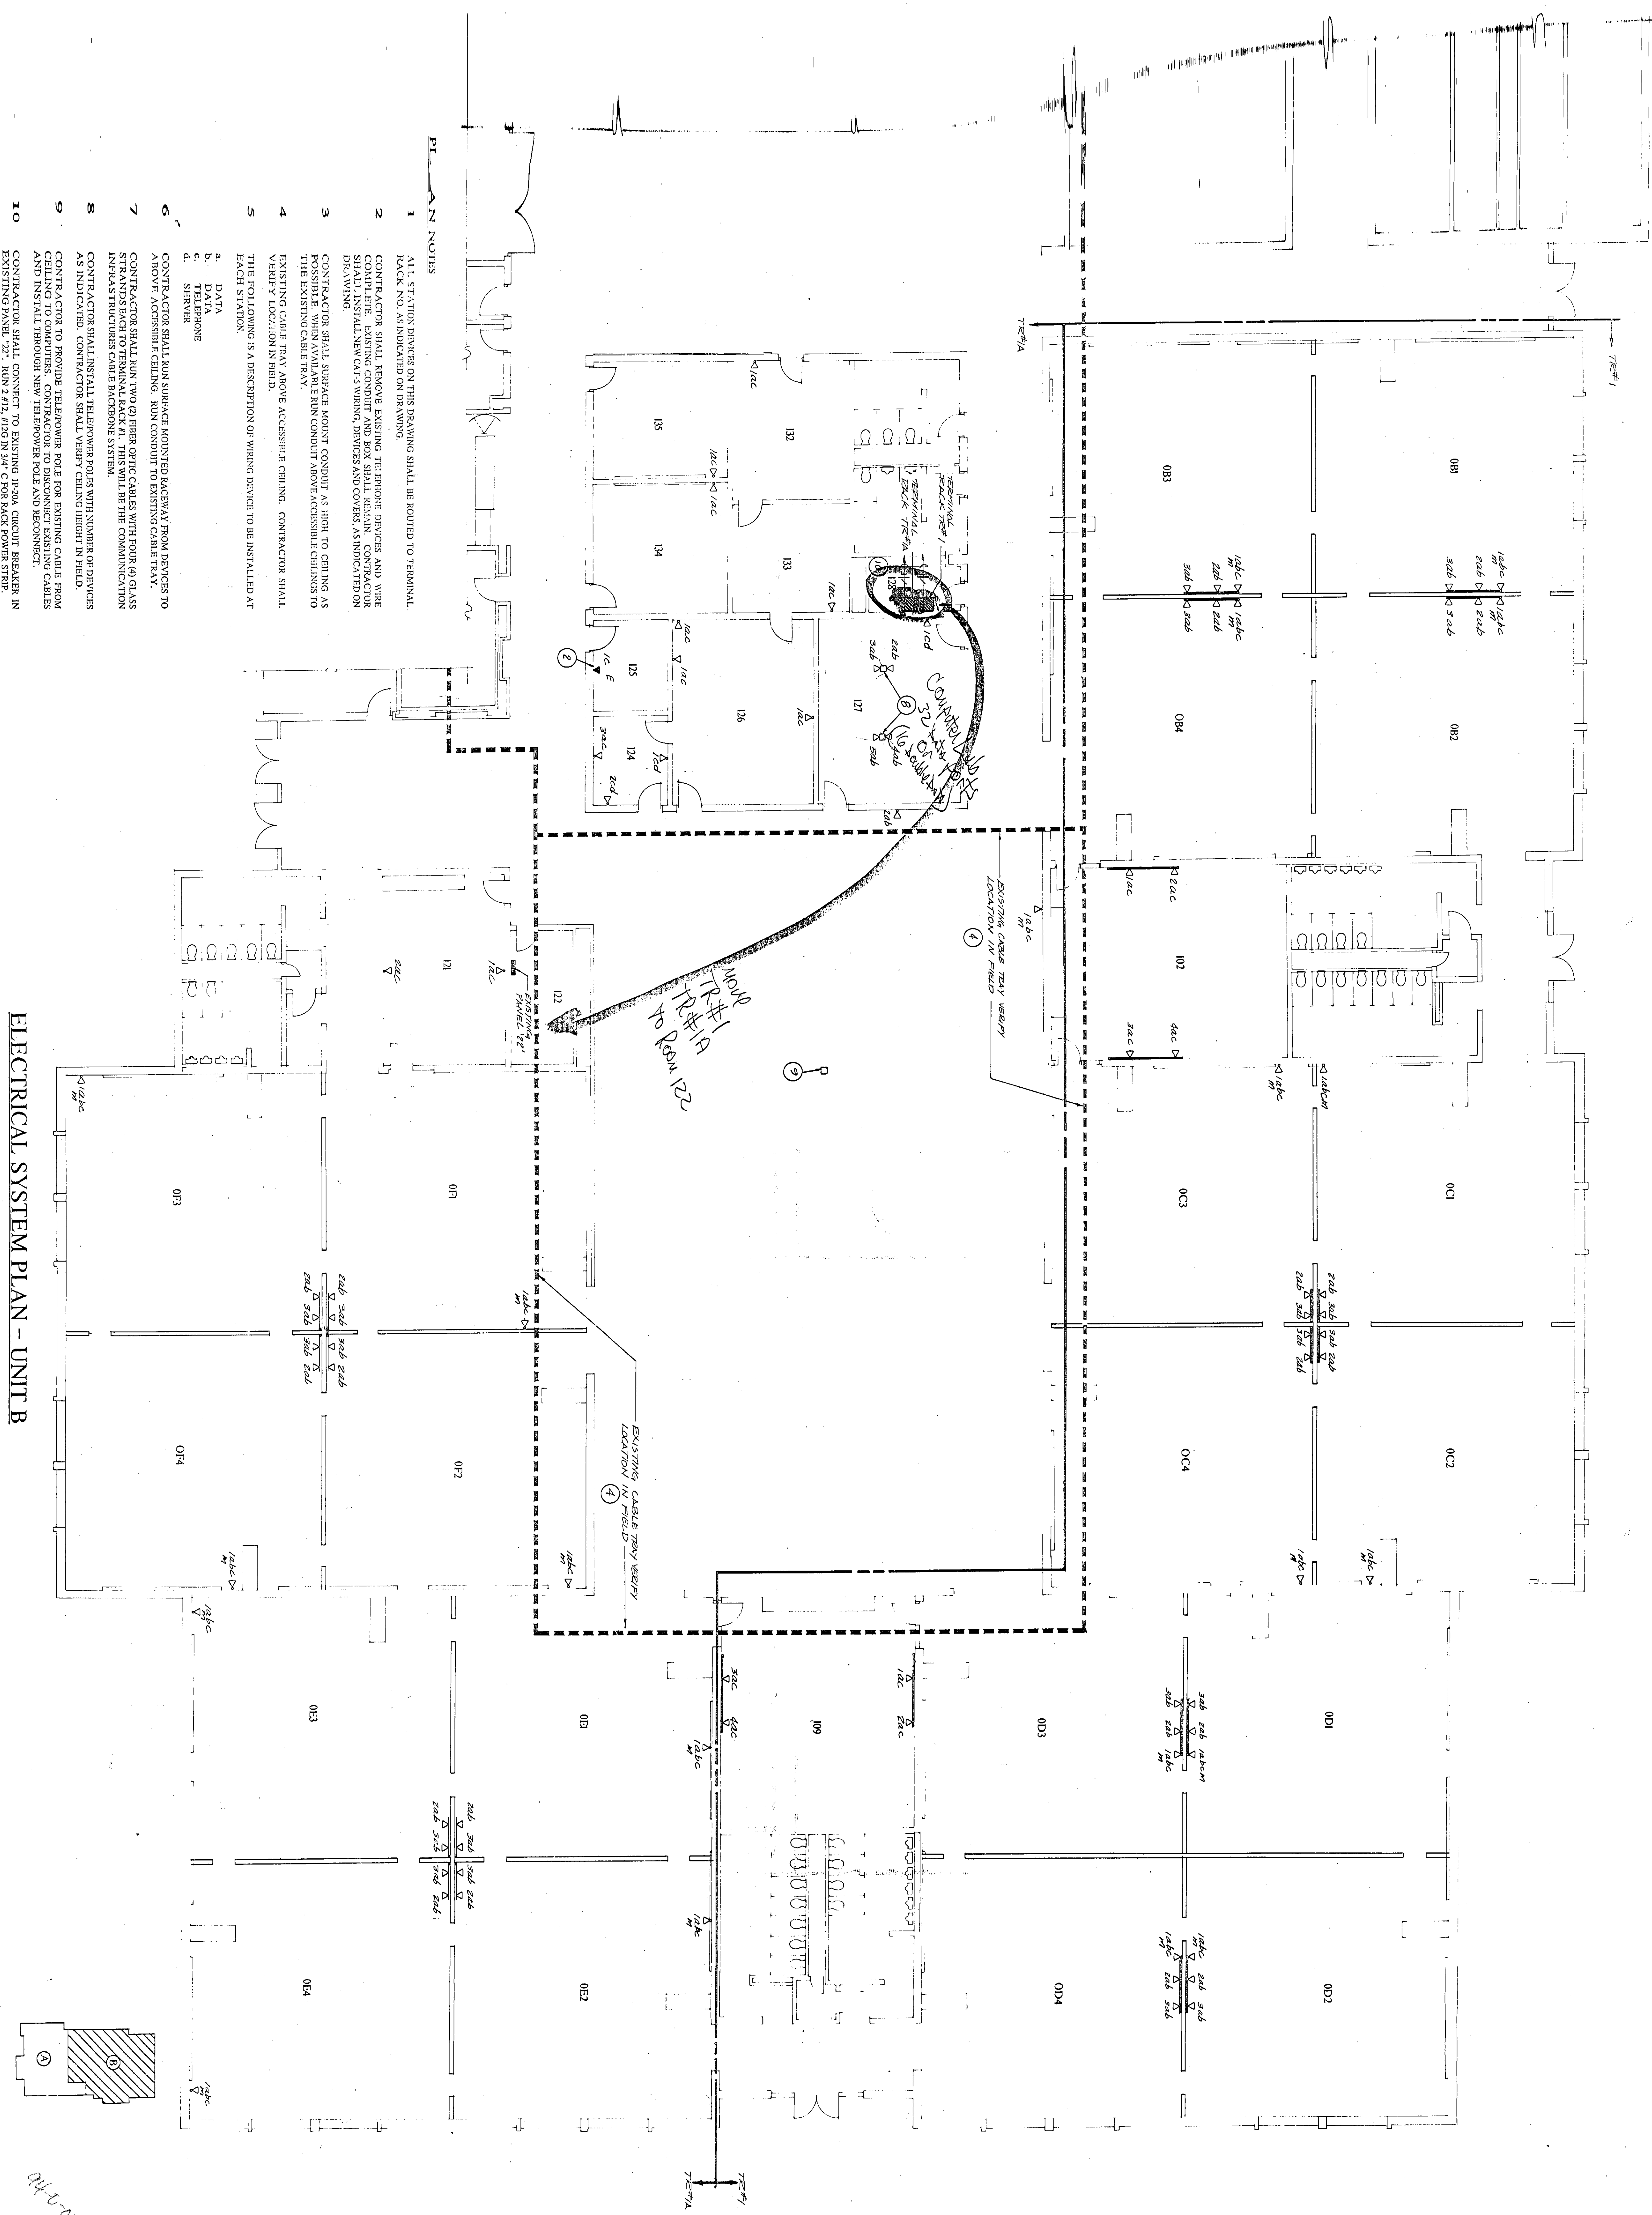

KEY PLAN

