



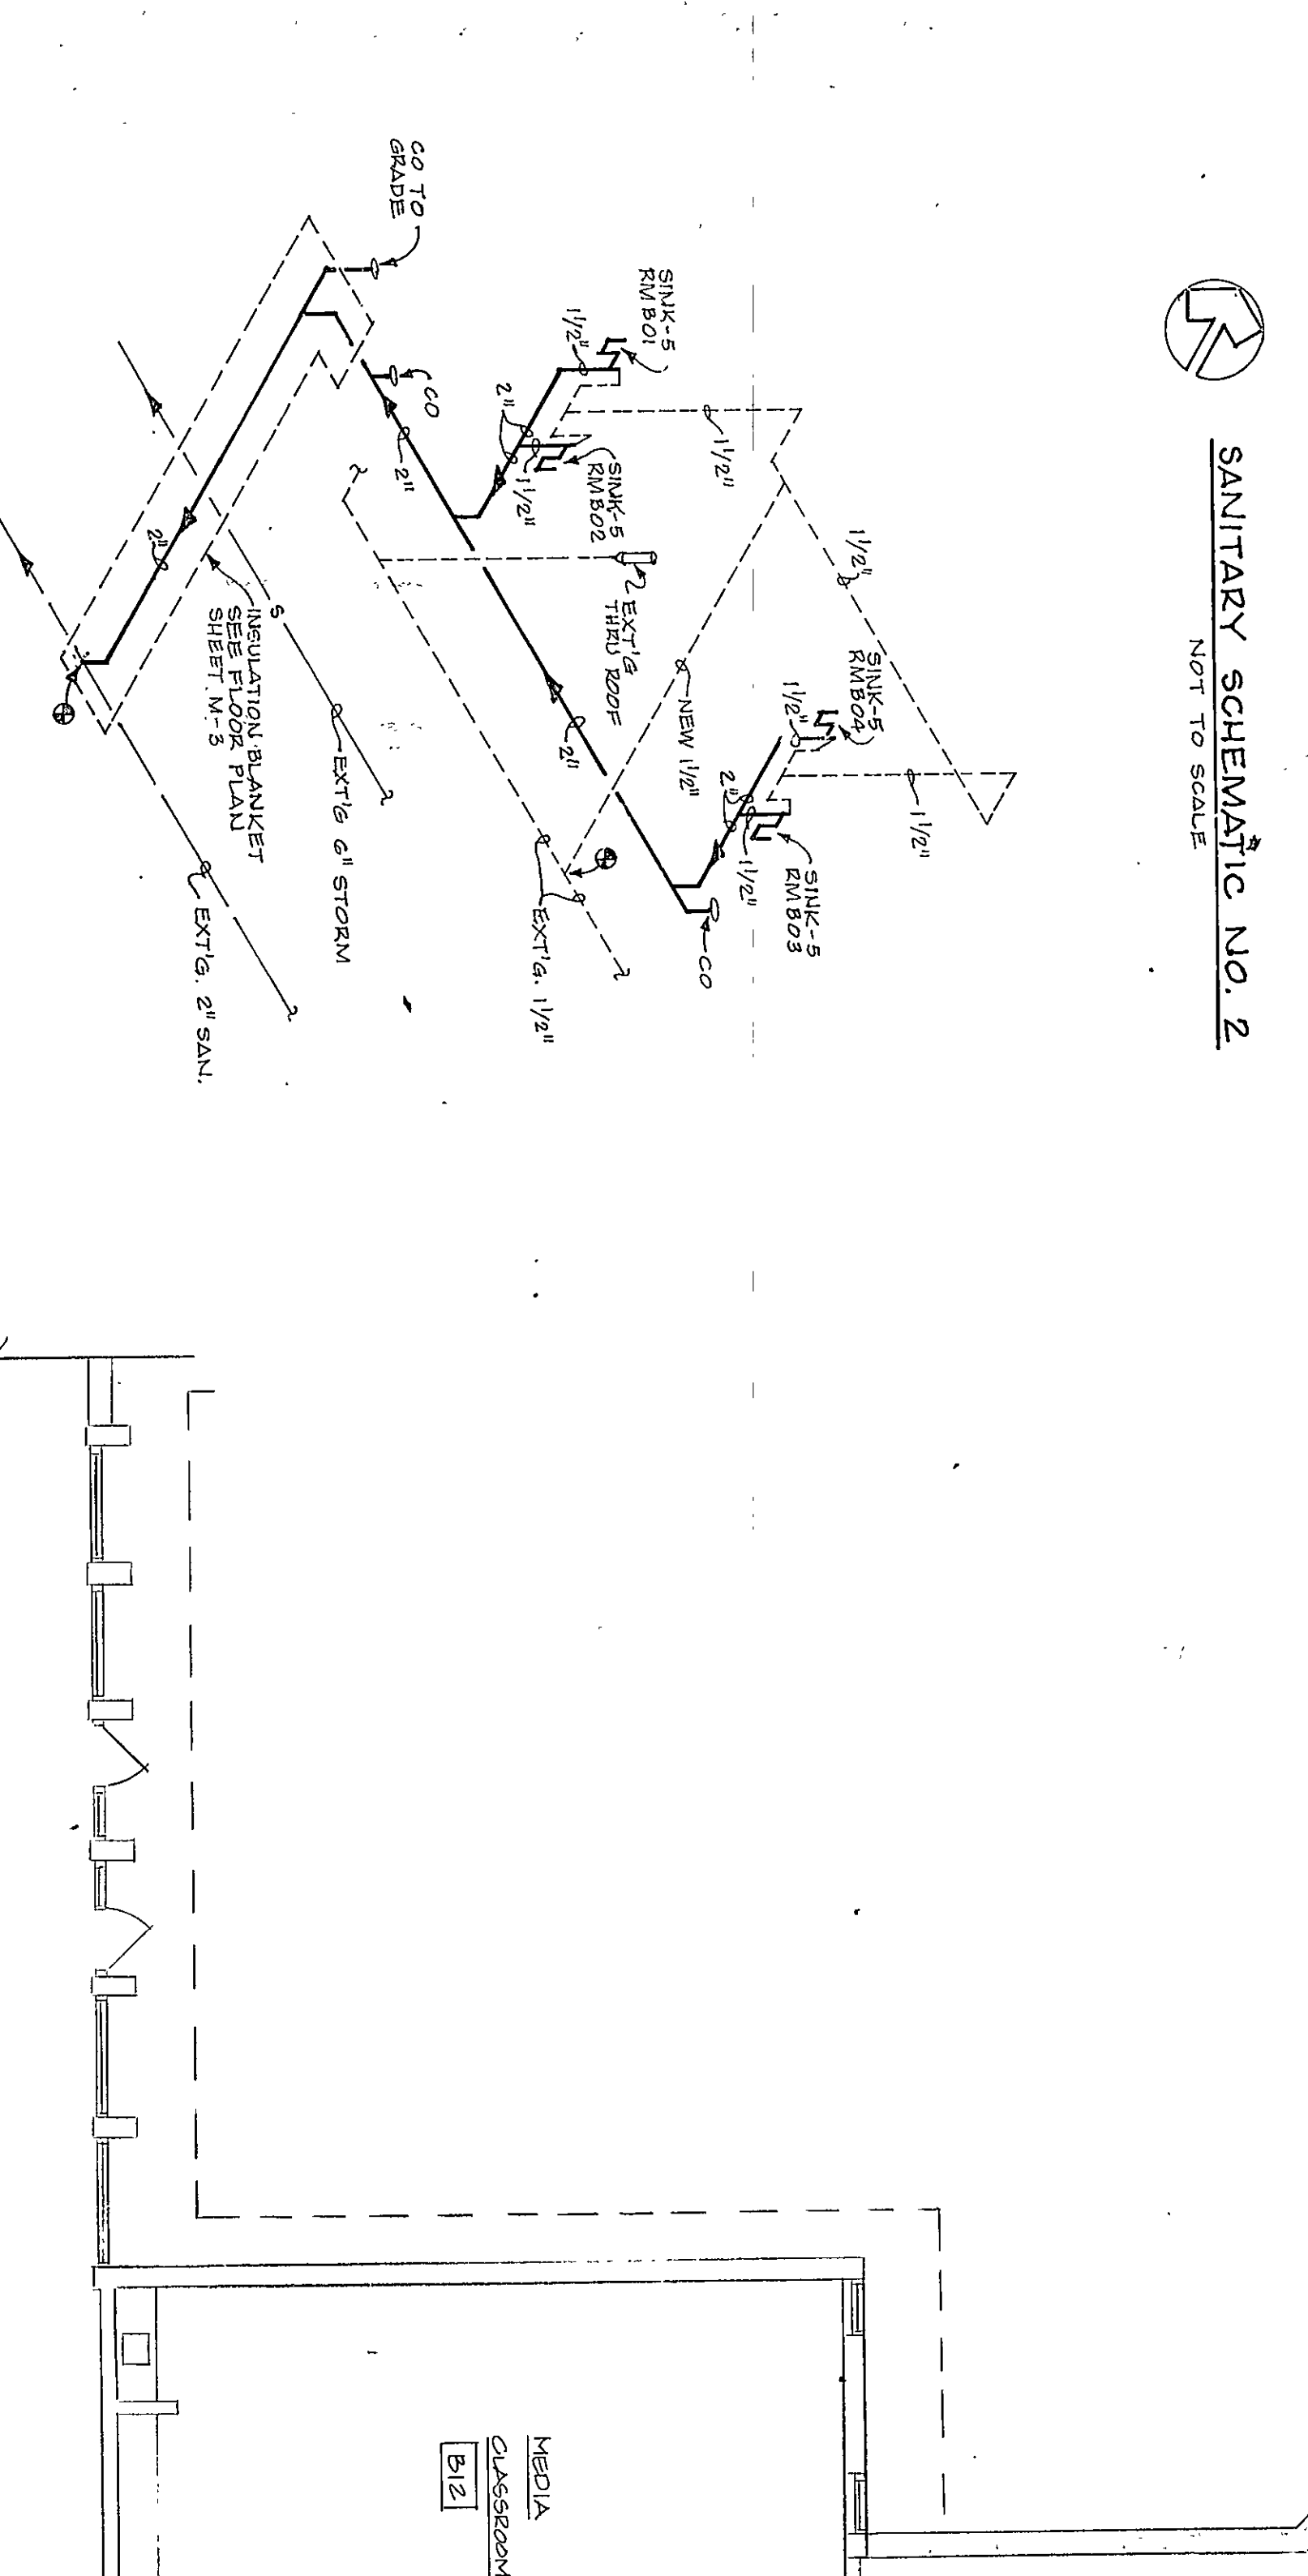


SANITARY SCHEMATIC NO. 1
NOT TO SCALE

SANITARY SCHEMATIC NO. 2
NOT TO SCALE

SANITARY SCHEMATIC NO. 3
NOT TO SCALE

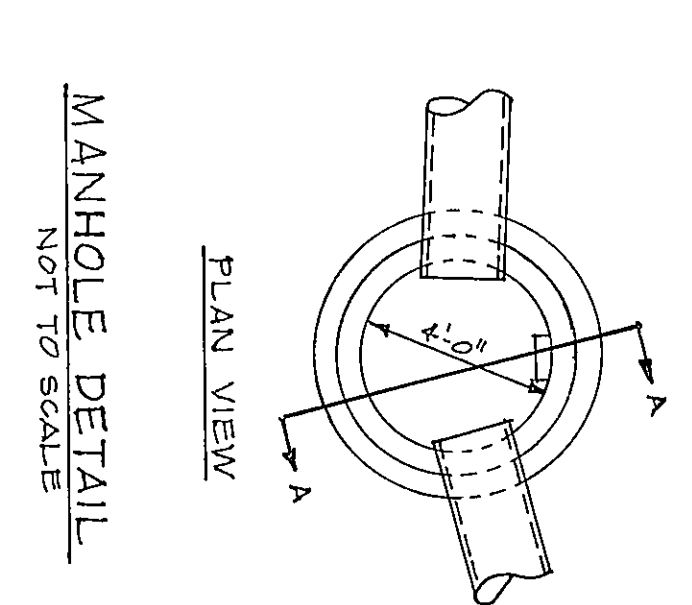


MANHOLE DETAIL
NOT TO SCALE

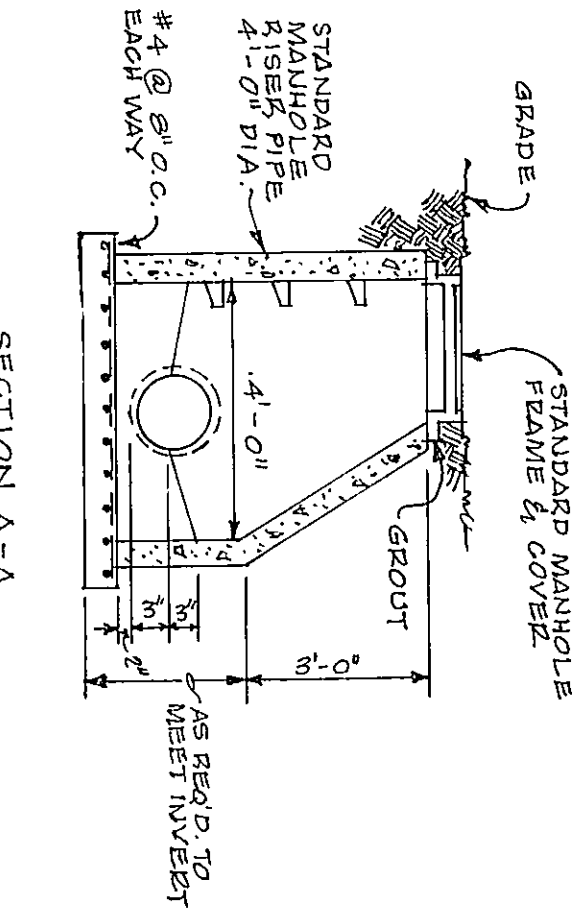


CLASSROOM SINK-5
NOT TO SCALE

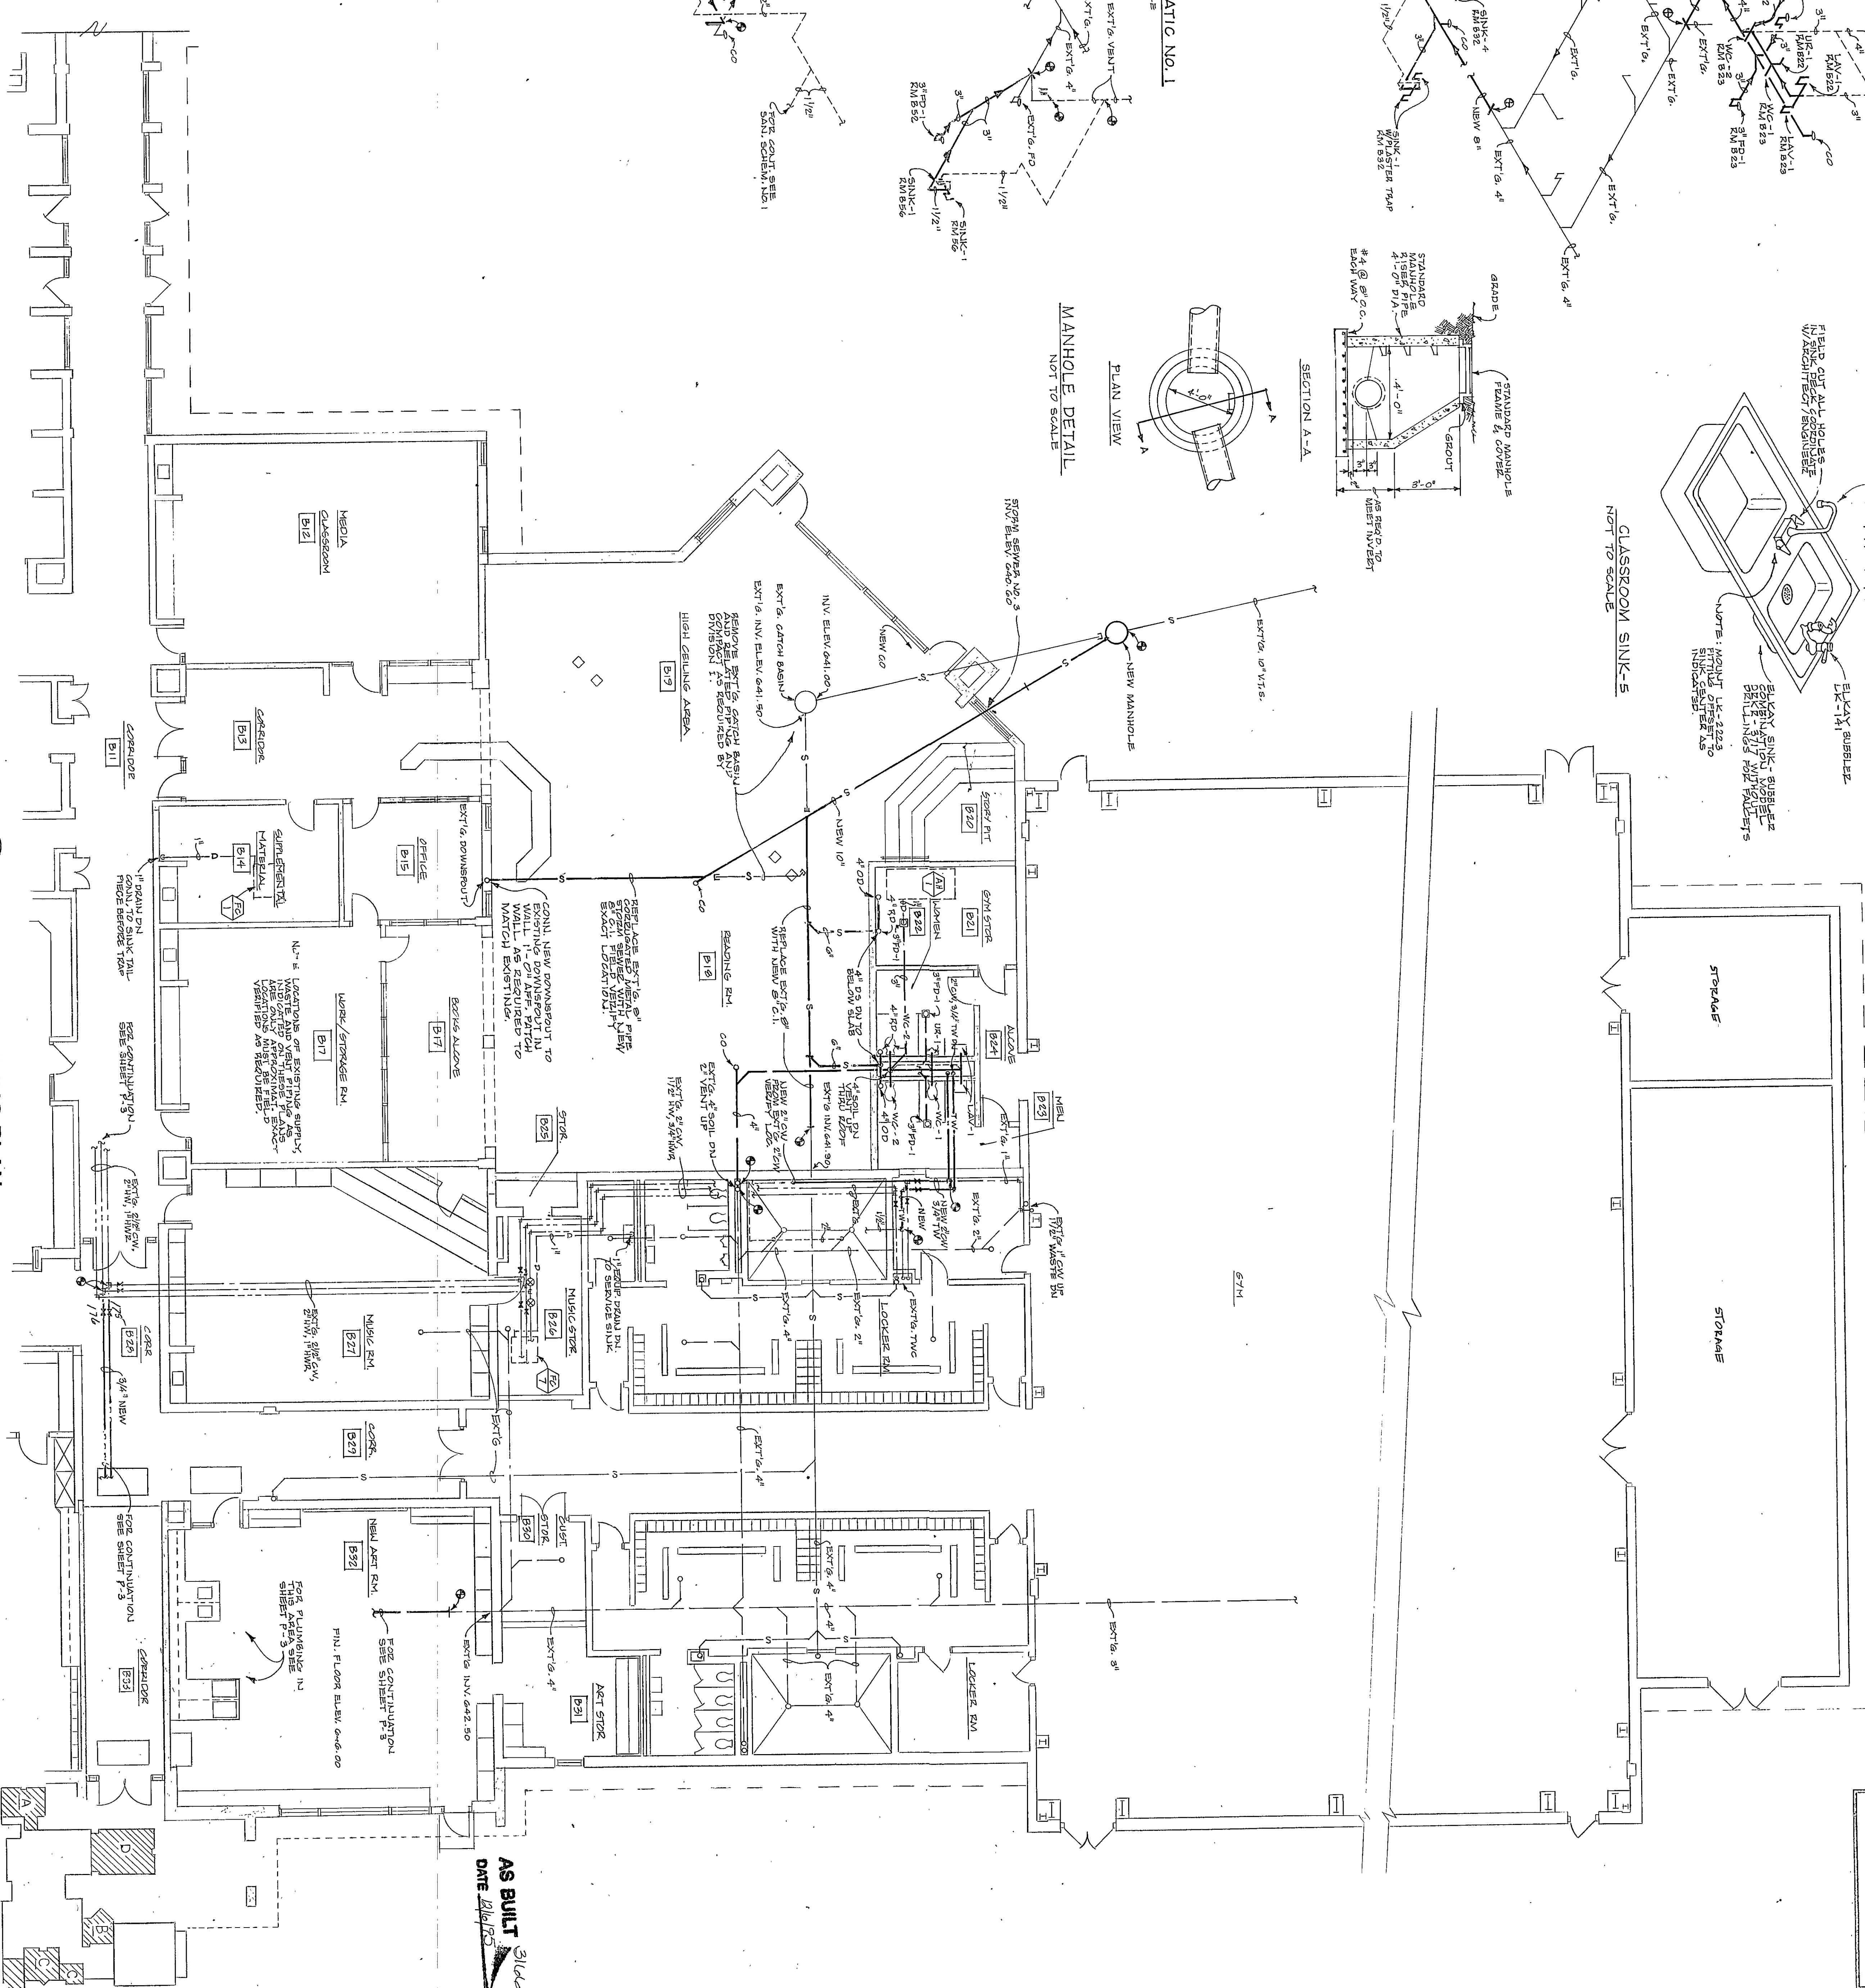

UNIT B - PLUMBING PLAN

M/E DESIGN SERVICES
MECHANICAL/ELECTRICAL CONSULTING ENGINEERS
112 1/2 Lincolnway East
Mishawaka, Indiana 46544
(219) 256-1914

94-P-02

UNIT B PLUMBING PLAN

1994 ADDITIONS & RENOVATION PROJECTS
DUNELAN CORPORATION CHESTERTON, INDIANA

REVISIONS: