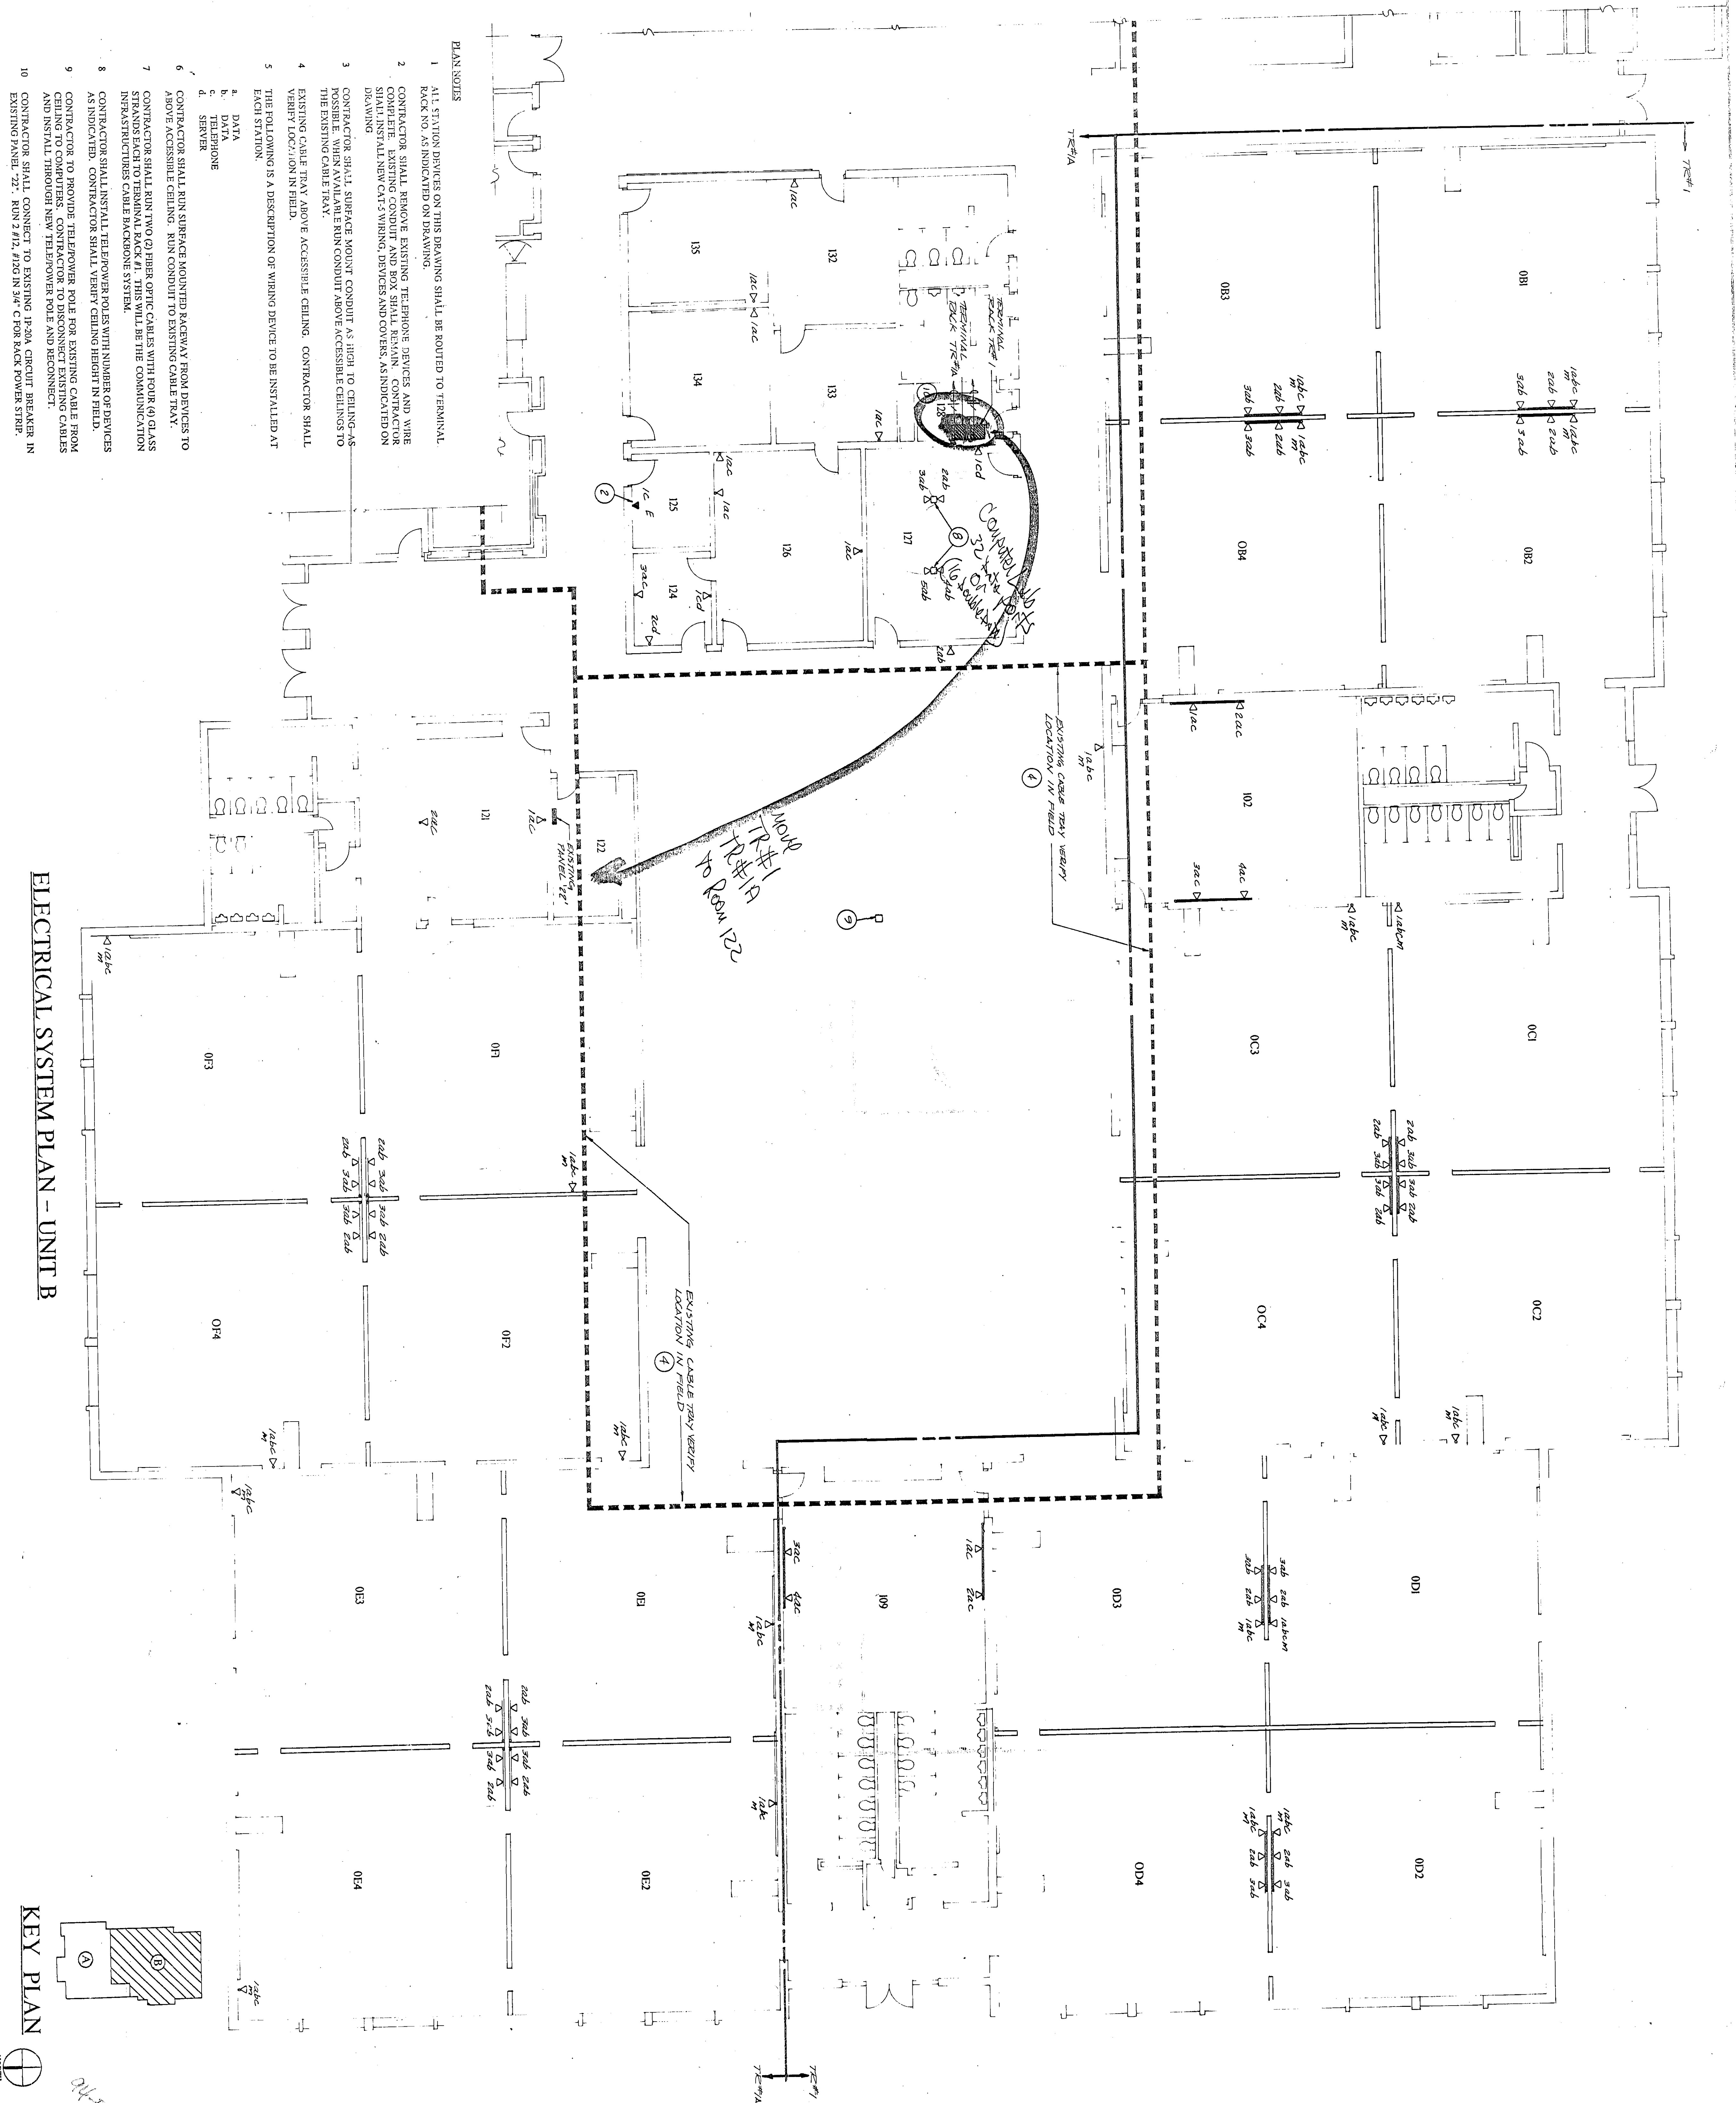


[illegible]

PROJECT ENGINEER

CERTIFIED BY: Timothy T. Moore  
PRINCIPAL  
CERTIFIED BY: \_\_\_\_\_

**MOORE  
ENGINEERS**

A PROFESSIONAL CORPORATION

9245 N. Meridian Street, Suite 105  
Indianapolis, Indiana 46260-1812  
(317) 848-5045 FAX: (317) 848-2765

**COPYRIGHT NOTICE:**  
THIS ENGINEERING DRAWING IS GIVEN IN CONFIDENCE AND SHALL BE USED ONLY IN ACCORDANCE WITH THE AGREEMENT WITH MOORE ENGINEERS, P.C. NO OTHER USE OR REPRODUCTION MAY BE MADE WITHOUT PRIOR WRITTEN CONSENT OF MOORE ENGINEERS, P.C. ALL OTHER COPYRIGHT AND COMMON LAW RIGHTS ARE HEREBY SPECIFICALLY RESERVED.

COMMUNICATIONS  
INFRASTRUCTURE  
FOR DUNELAND  
SCHOOL CORPORATIC

DUNELAND SCHOOL  
CORPORATION  
CHESTERTON, INDIANA

BRUMMITT  
ELEMENTARY  
SCHOOL

|           |              |           |
|-----------|--------------|-----------|
| DATE:     | 12 / 5 / 94  | SHEET NO: |
| SCALE:    | 1/8" = 1'-0" |           |
| COMM. NO: | 94054        |           |
| DRAWN BY: | R.T.C.       |           |

**E2-BT**