



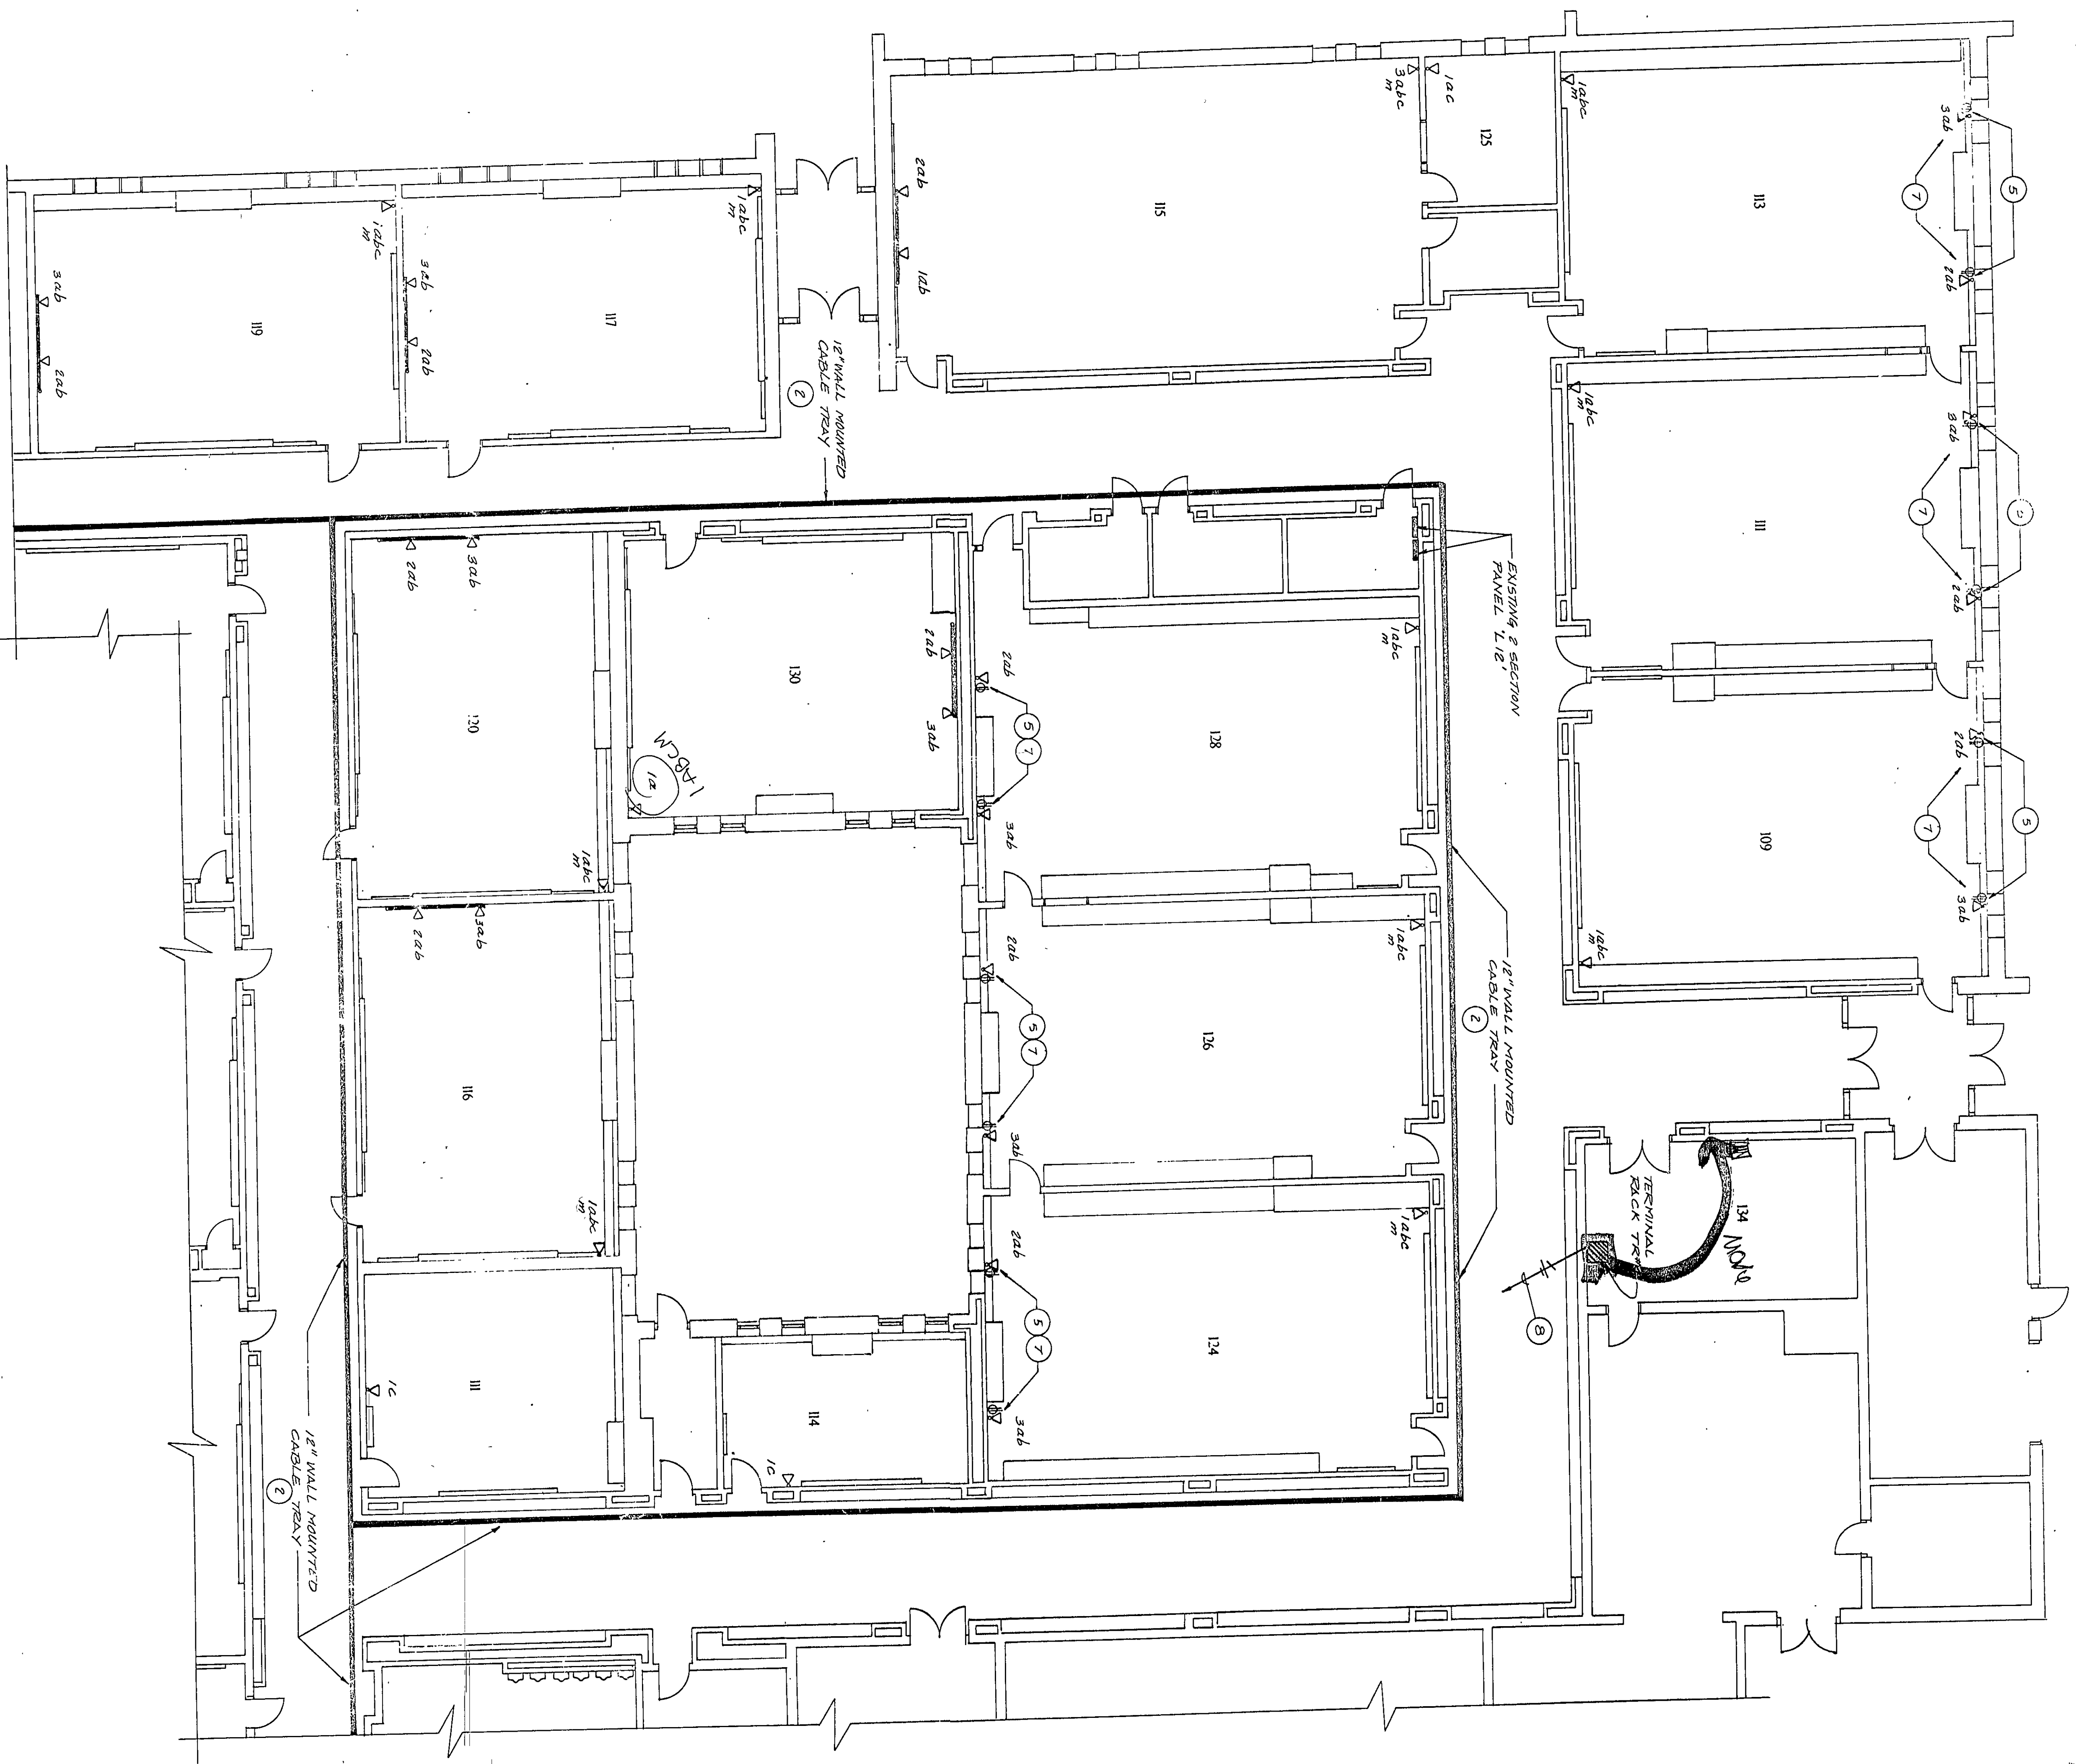

- PLAN NOTES**
1. ALL STATION DEVICES ON THIS DRAWING SHALL BE ROUTED TO TERMINAL RACK NO. 4.
 2. SEE WALL MOUNTED CABLE TRAY DETAIL ON DRAWING E-2 OF THIS SET.
 3. THE FOLLOWING IS A DESCRIPTION OF WIRING DEVICES TO BE INSTALLED AT EACH STATION:
 - a. DATA
 - b. TELEPHONE
 - c. SERVER
 - d. SERVER
 4. CONTRACTOR SHALL RUN SURFACE MOUNTED RACEWAY FROM DEVICES TO ABOVE ACCESSIBLE CEILING. RUN CONDUIT TO WALL MOUNTED CABLE TRAY.
 5. CONTRACTOR SHALL INSTALL SURFACE MOUNTED RACEWAY ON EXISTING WALL. RUN RACEWAY DOWN WALL AND MOUNT DEVICES 6\"/>

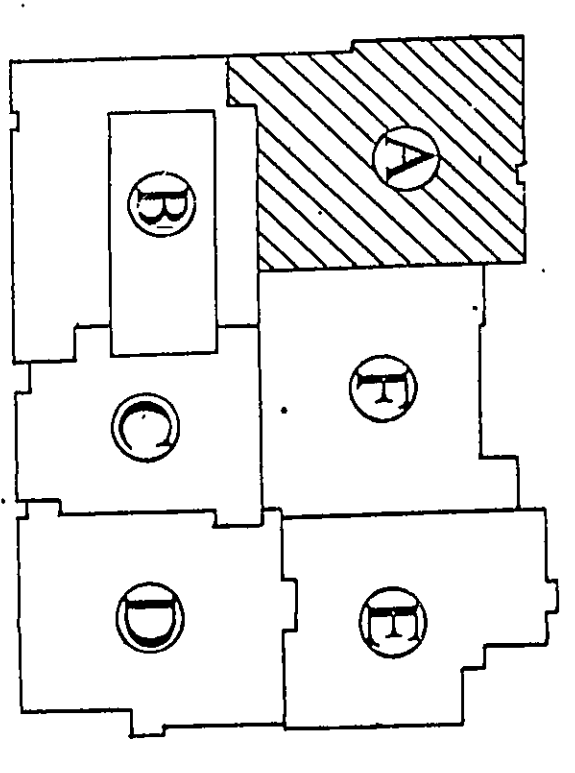

ELECTRICAL SYSTEM PLAN - UNIT A

MOORE ENGINEERS
 13815
 1001 N. Meridian Street, Suite 105
 Indianapolis, Indiana 46204-1812
 (317) 848-5045 FAX: (317) 848-2765

COMMUNICATIONS INFRASTRUCTURE FOR DUNELAND SCHOOL CORPORATION

DUNELAND SCHOOL CORPORATION
 CHESTERTON

KEY PLAN

REVISIONS

MARK	DATE	DESCRIPTION
1		
2		
