



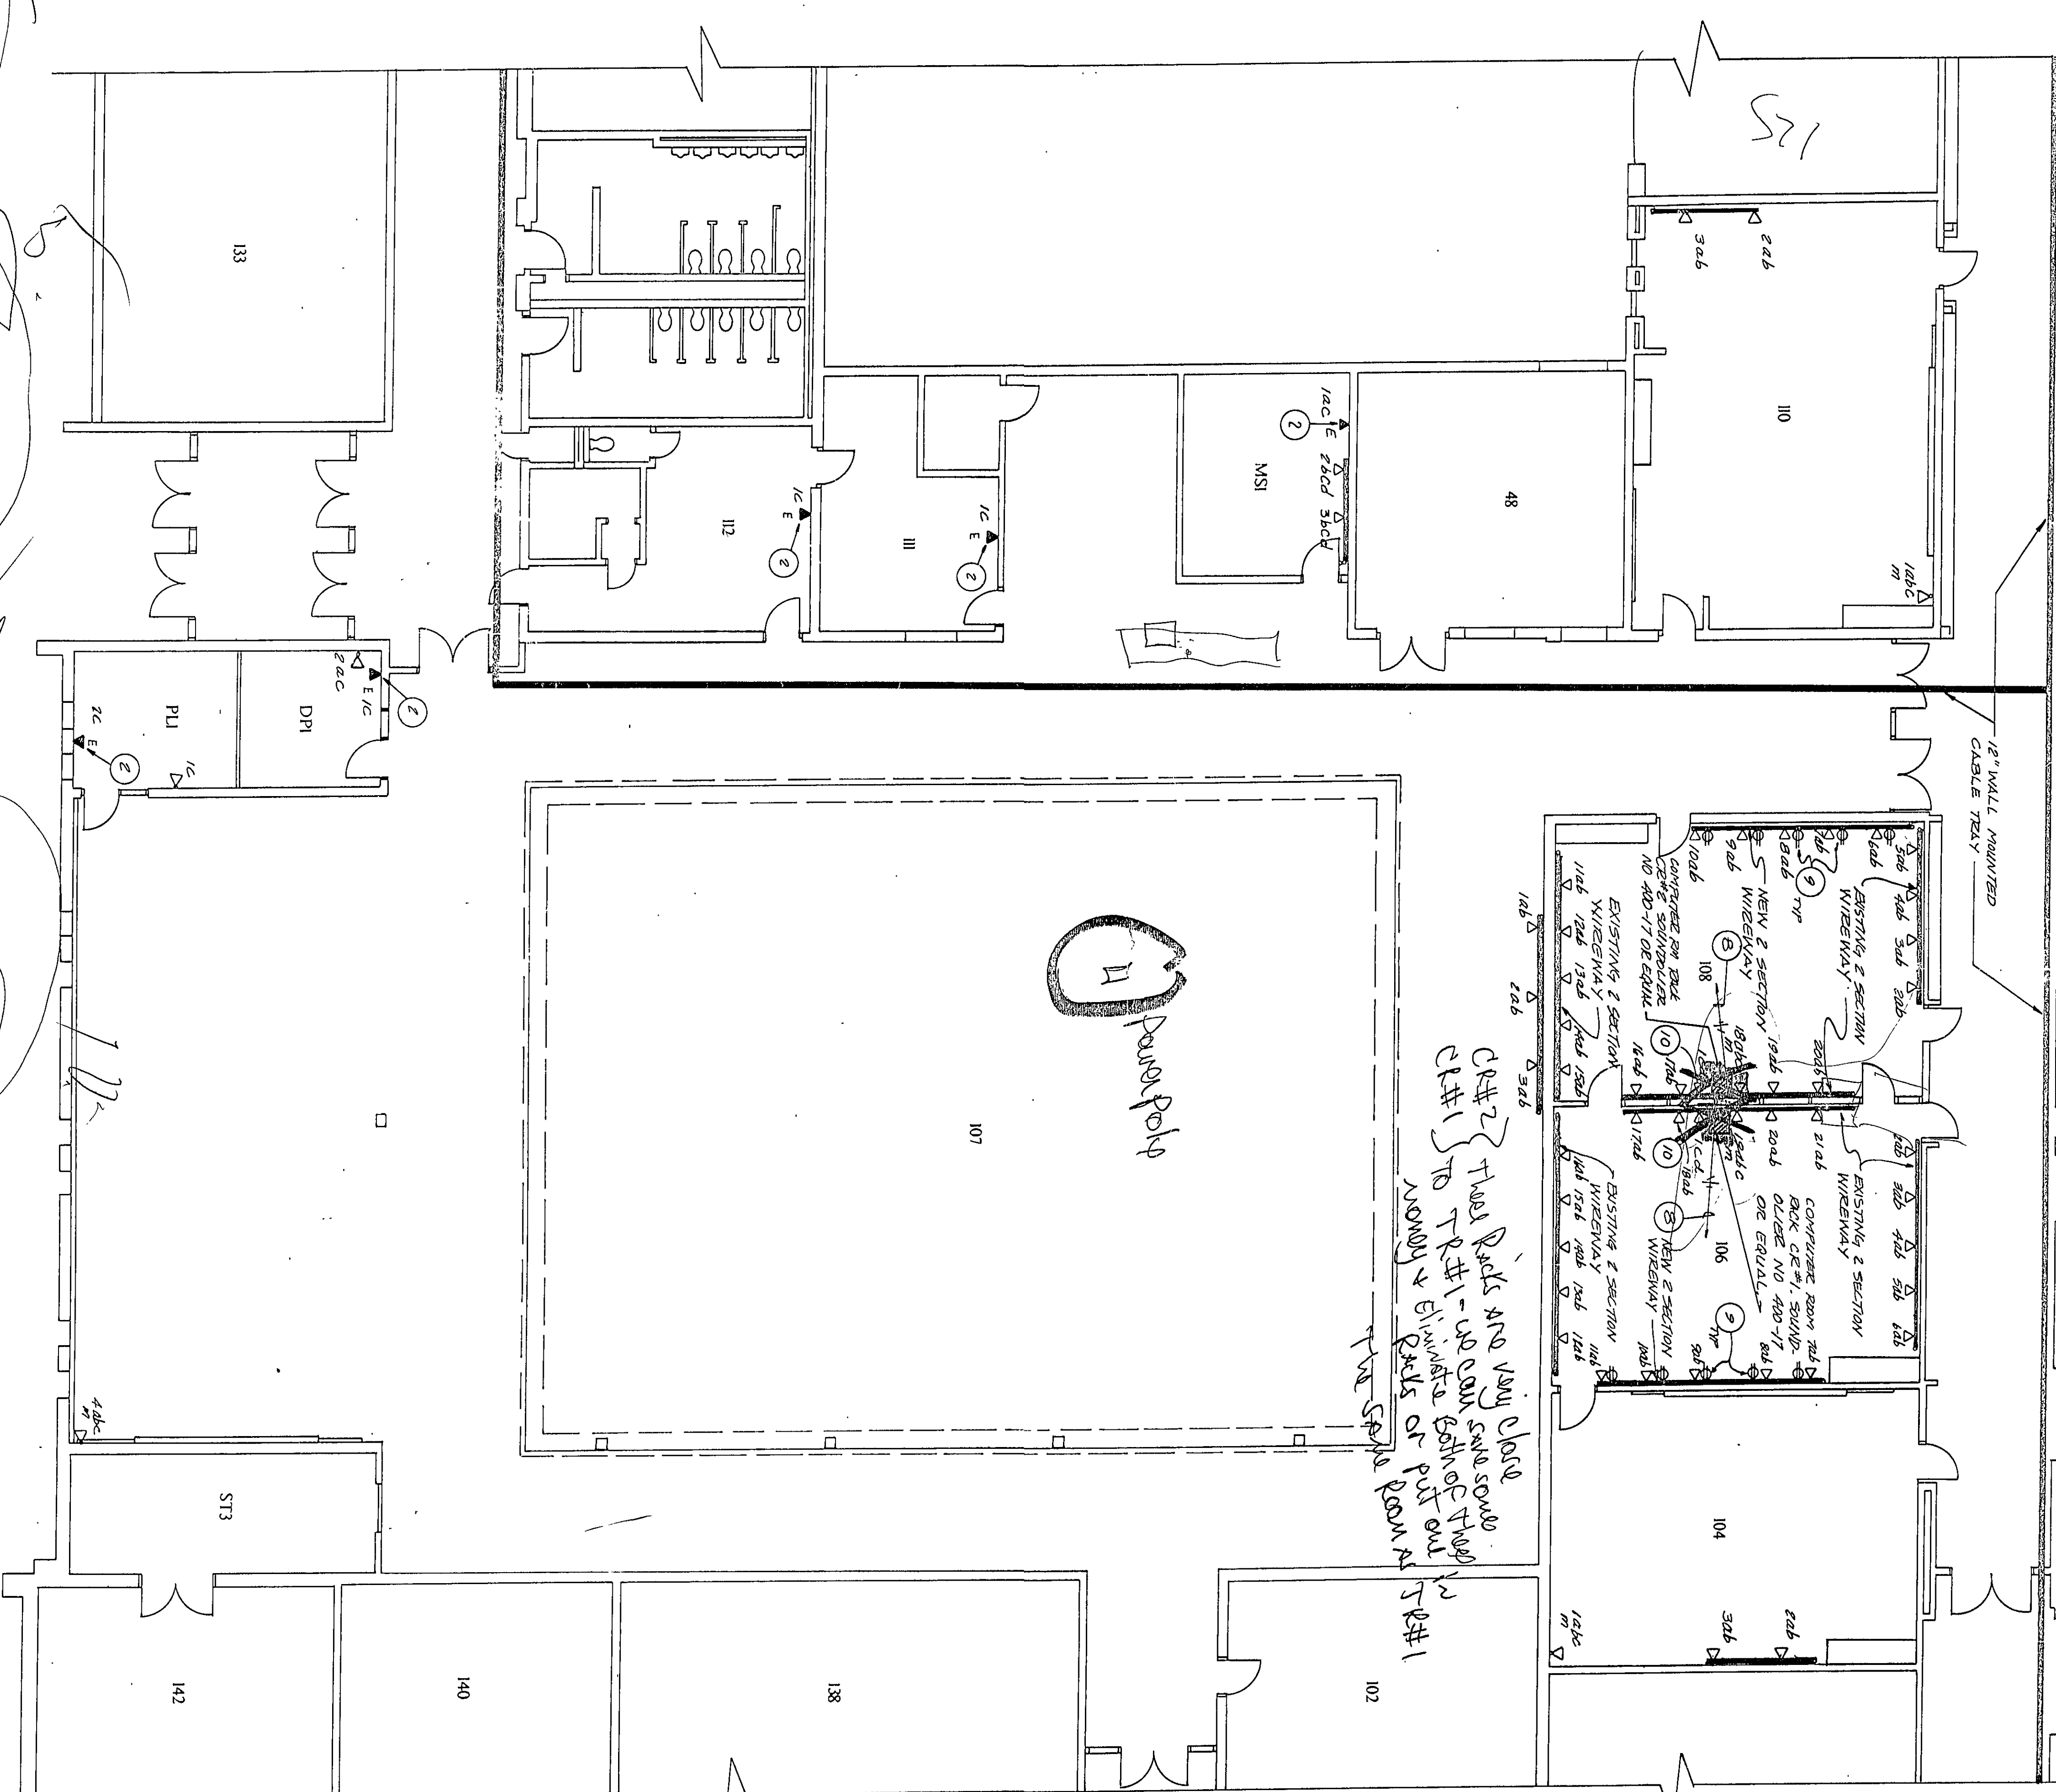

Q 3926
C#2 } These Rads are very close
to T#1 - we can save some
money & eliminate Rads or put out
the same T#1

- PLAN NOTES
- ① ALL STATION DEVICES ON THIS DRAWING SHALL BE ROUTED TO TERMINAL RACK NO. 1.
 - ② CONTRACTOR SHALL REMOVE EXISTING TELEPHONE DEVICES AND WIRE COMPLETE. EXISTING CONDUIT AND BOX SHALL REMAIN. NEW WIRE SHALL INSTALL NEW CAT-5 WIRING, DEVICES AND COVERS, AS INDICATED ON DRAWING.
 - ③ CONTRACTOR SHALL SURFACE MOUNT CONDUIT AS HIGH TO CEILING AS POSSIBLE. WHEN AVAILABLE, RUN CONDUIT ABOVE ACCESSIBLE CEILINGS TO THE NEW CABLE TRAY.
 - ④ SEE WALL MOUNTED CABLE TRAY DETAIL ON DRAWING E-2D OF THIS SET.
 - ⑤ THE FOLLOWING IS A DESCRIPTION OF WIRING DEVICE TO BE INSTALLED AT EACH STATION.
 - a. DATA
 - b. DATA
 - c. TELEPHONE
 - d. SERVER
 - ⑥ CONTRACTOR SHALL RUN SURFACE MOUNTED RACEWAY FROM DEVICES TO ABOVE ACCESSIBLE CEILING. RUN CONDUIT TO SURFACE MOUNTED CABLE TRAY.
 - ⑦ CONTRACTOR SHALL RUN 2 FIBER OPTIC CABLES WITH FOUR (4) GLASS STRANDS EACH TO EACH STATION. THIS SHALL BE THE COMMUNICATION INFRASTRUCTURES CABLE BACKBONE SYSTEM.
 - ⑧ CONTRACTOR SHALL CONNECT EXISTING SPACE CIRCUIT BREAKER IN EXISTING PANEL, 1st R2 2 #12 AND 1 #12G IN 3/4" CONDUIT, FOR RACK POWER STRIP.
 - ⑨ CONTRACTOR SHALL CONNECT EXISTING SPACE CIRCUIT BREAKER IN EXISTING PANEL, 1st TO NEW ELECTRICAL DEVICES IN NEW SURFACE MOUNTED WIREWAY.
 - ⑩ CONTRACTOR SHALL INSTALL NEW SERVER AND TELEPHONE CAT-5 CABLES AND DEVICES PER OWNER'S INSTRUCTIONS.

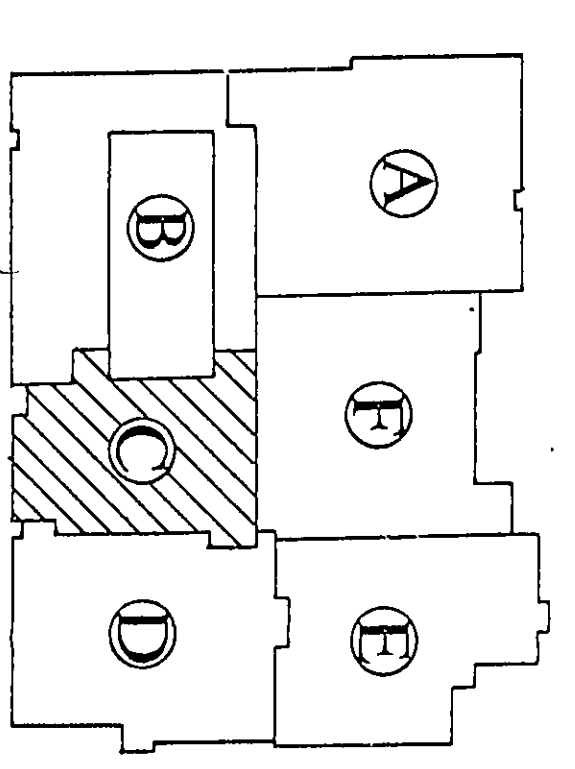

KEY PLAN

DUNELAND SCHOOL
CORPORATION
CHESTERION, INDIANA

COMMUNICATIONS
INFRASTRUCTURE
FOR DUNELAND
SCHOOL CORPORATION

**MOORE
ENGINEERS**

A PROFESSIONAL CORPORATION
9245 N. Meridian Street, Suite 105
Indianapolis, Indiana 46260-1812
(317) 848-5045 FAX: (317) 848-2765

COPYRIGHT NOTICE: THIS ENGINEERING DRAWING IS GIVEN IN CONFIDENCE AND SHALL BE USED ONLY PURSUANT TO THE AGREEMENT WITH MOORE ENGINEERS, PC. NO OTHER USE OR REPRODUCTION MAY BE MADE WITHOUT PRIOR WRITTEN CONSENT OF MOORE ENGINEERS, PC. ALL OTHER COPYRIGHT AND COMMON LAW RIGHTS ARE HEREBY SPECIFICALLY RESERVED.

DATE:	12 / 5 / 94	SHEET NO:
SCALE:	1/8" = 1'-0"	
COMM. NO:	94054	
DRAWN BY:	R.D.	

E3-LM