


Chesterton High School

Section A9-A10

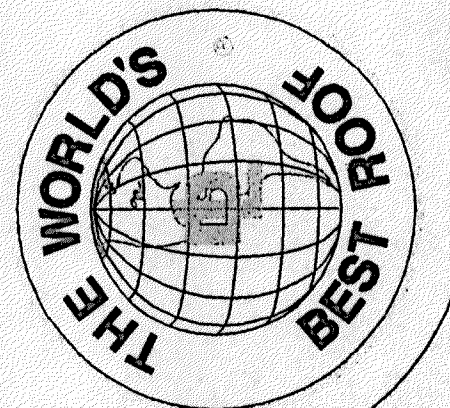

DURO-LAST, INC.
525 MORLEY DRIVE
SAGINAW, MICHIGAN 48601



CHESTERTON HIGH SCHOOL
SECTION A9 - A10
W.R. KELSO

DWG NAME: CHESTERTON
DRAWN BY: KNOX
REV. BY:

SCALE: 1/20" = 1'-0"
DATE: 9/19/97
REV.:

LEGEND
FACTORY WELD
FIELD WELD

Q1-R-02

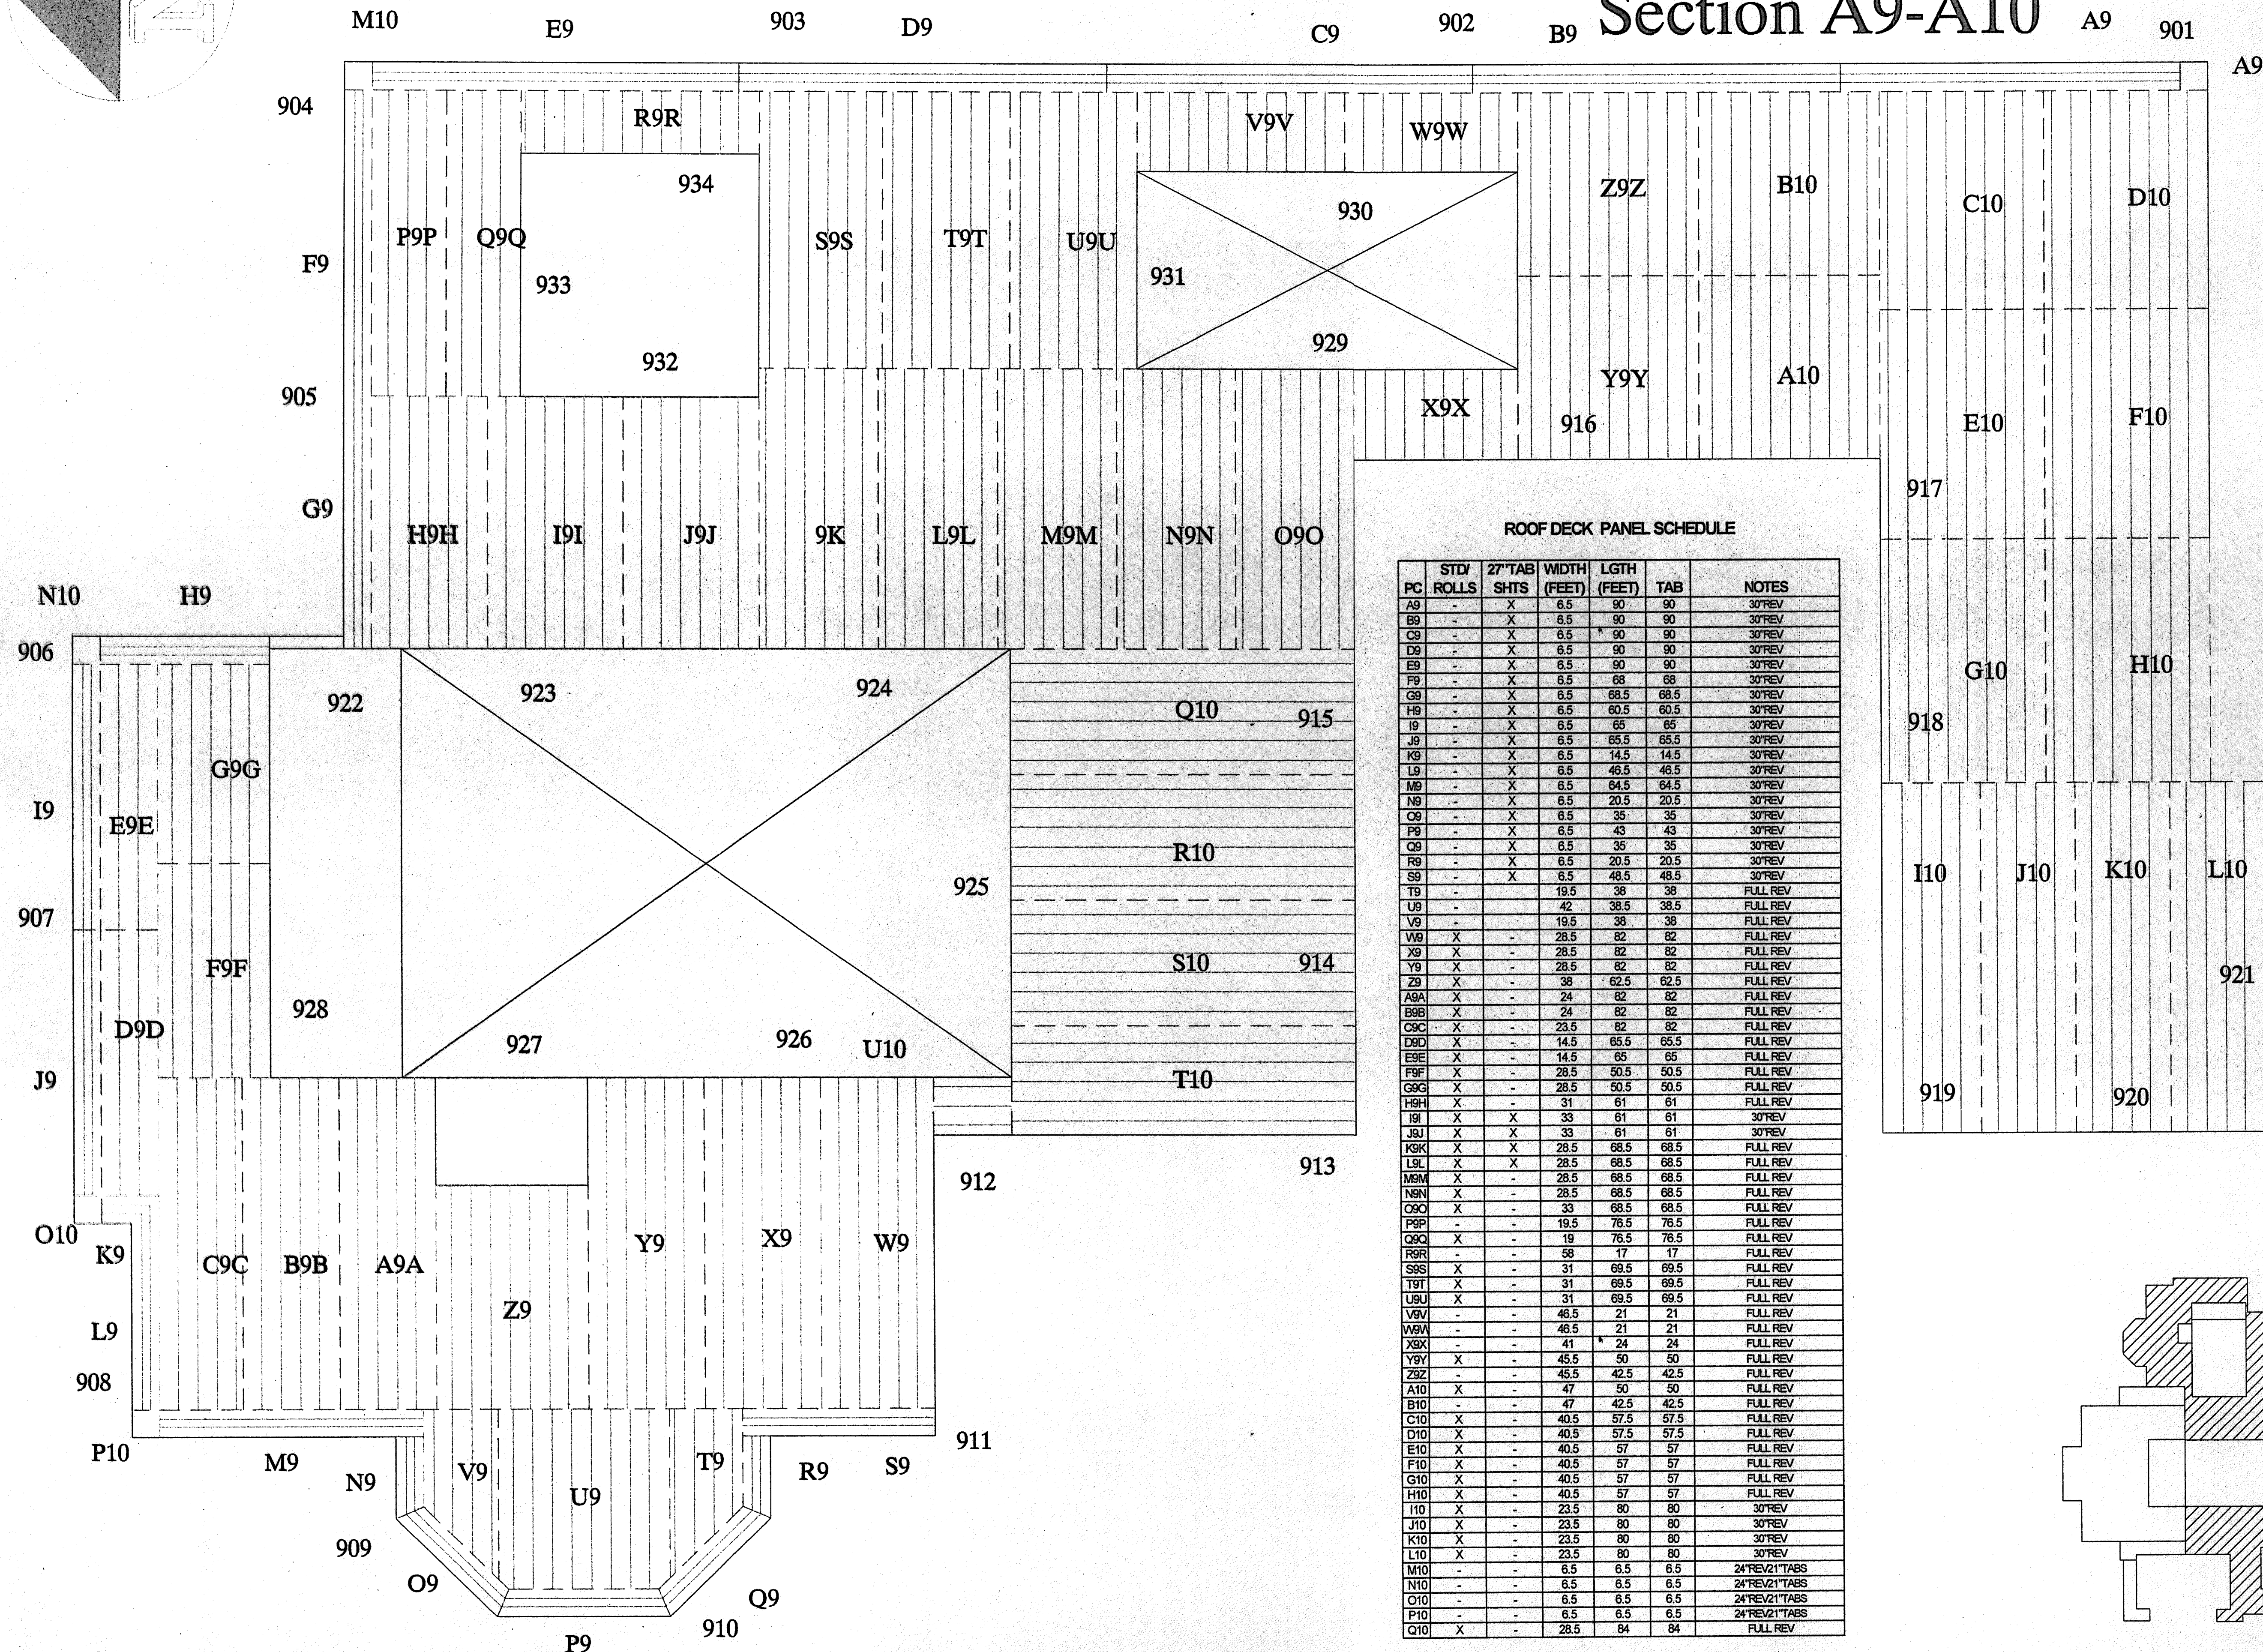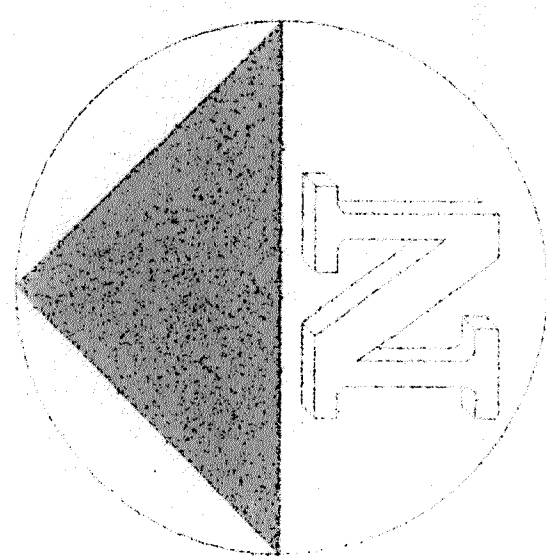

X - CHECKED AND FORWARDED TO A/E
CHECKED AND RESUBMIT
INSUFFICIENT INFORMATION
Checking is only for performance with the information provided.
WPA
12/2/97
CONSTRUCTION CONTROL
FORT WAYNE, INDIANA

