


Chesterton High School

Section A1

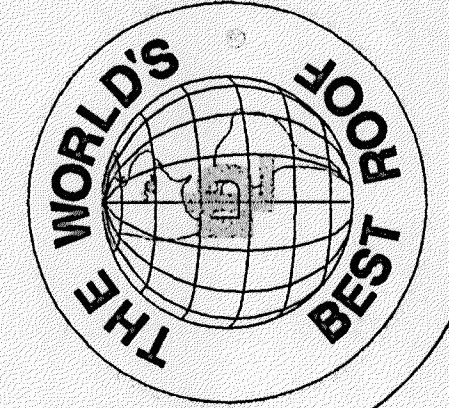

DUROLAST, INC.
525 MORLEY DRIVE
SAGINAW, MICHIGAN 48601

CHESTERTON HIGH SCHOOL
SECTION A1
W.R. KELSO

DWG NAME: CHESTERTON
DRAWN BY: KNOX
REV. BY:

SCALE: 1/16" = 1'-0"
DATE: 9/19/97
REV.:

LEGEND
FACTORY WELD
FIELD WELD

97-k-09

ROOF DECK PANEL SCHEDULE

PC	STD/ROLLS	27" TAB SHTS	WIDTH (FEET)	LGTH (FEET)	TAB	NOTES
A1	-	X	13.5	13.5	13.5	24"REV 21" TABS
B1	-	X	13.5	13.5	13.5	24"REV 21" TABS
C1	-	X	13.5	13.5	13.5	24"REV 21" TABS
D1	-	X	13.5	13.5	13.5	24"REV 21" TABS
E1	-	X	13.5	13.5	13.5	24"REV 21" TABS
F1	-	X	13.5	13.5	13.5	24"REV 21" TABS
G1	-	X	13.5	66.5	66.5	30"REV
H1	-	X	13.5	36.5	36.5	30"REV
I1	-	X	13.5	78	78	30"REV
J1	-	X	13.5	36.5	36.5	30"REV
K1	-	X	13.5	66.5	66.5	30"REV
L1	-	X	13.5	86.5	86.5	30"REV
M1	-	X	13.5	86.5	86.5	30"REV
N1	-	X	13.5	53	53	30"REV
O1	-	X	13.5	53	53	30"REV
P1	-	X	13.5	86.5	86.5	30"REV
Q1	-	X	13.5	86.5	86.5	30"REV
R1	X	-	28.5	57.5	57.5	FULL REV
S1	X	-	26	57.5	57.5	FULL REV
T1	X	-	28.5	57.5	57.5	FULL REV
U1	X	-	26	57.5	57.5	FULL REV
V1	X	-	28.5	58	58	FULL REV
W1	X	-	26	58	58	FULL REV
X1	X	-	33	57.5	57.5	30"REV
Y1	X	-	33	57.5	57.5	30"REV
Z1	X	-	33.5	57.5	57.5	FULL REV
A1A	X	-	33.5	58	58	FULL REV
B1B	X	-	33.5	58	58	FULL REV
C1C	X	-	33.5	57.5	57.5	FULL REV
D1D	X	-	31	57.5	57.5	FULL REV
E1E	X	-	31	58	58	FULL REV
F1F	X	-	28.5	57.5	57.5	FULL REV
G1G	X	-	28.5	57.5	57.5	FULL REV
H1H	X	-	28.5	58	58	FULL REV
I1I	X	-	26	57.5	57.5	FULL REV
J1J	X	-	26	57.5	57.5	FULL REV
K1K	X	-	26	58	58	FULL REV
L1L	-	-	39	36.5	36.5	FULL REV
M1M	-	-	39.5	36.5	36.5	FULL REV

☒ CHECKED AND FORWARDED TO A/E
☐ REVISE AND RESUBMIT
☐ INSUFFICIENT INFORMATION

Checking is only for conformance and compliance with the information provided in the Contract Documents. Contractor is responsible for verifying the accuracy of the information and for obtaining all necessary permits and approvals for construction and for coordination of the work of all trades.

BY: MPA
DATE: 12/2/97
CONSTRUCTION CONTROL
FORT WAYNE, INDIANA

