


ALL HORIZONTAL DIMENSIONS
FROM THIS FACE OF PROSCENIUM

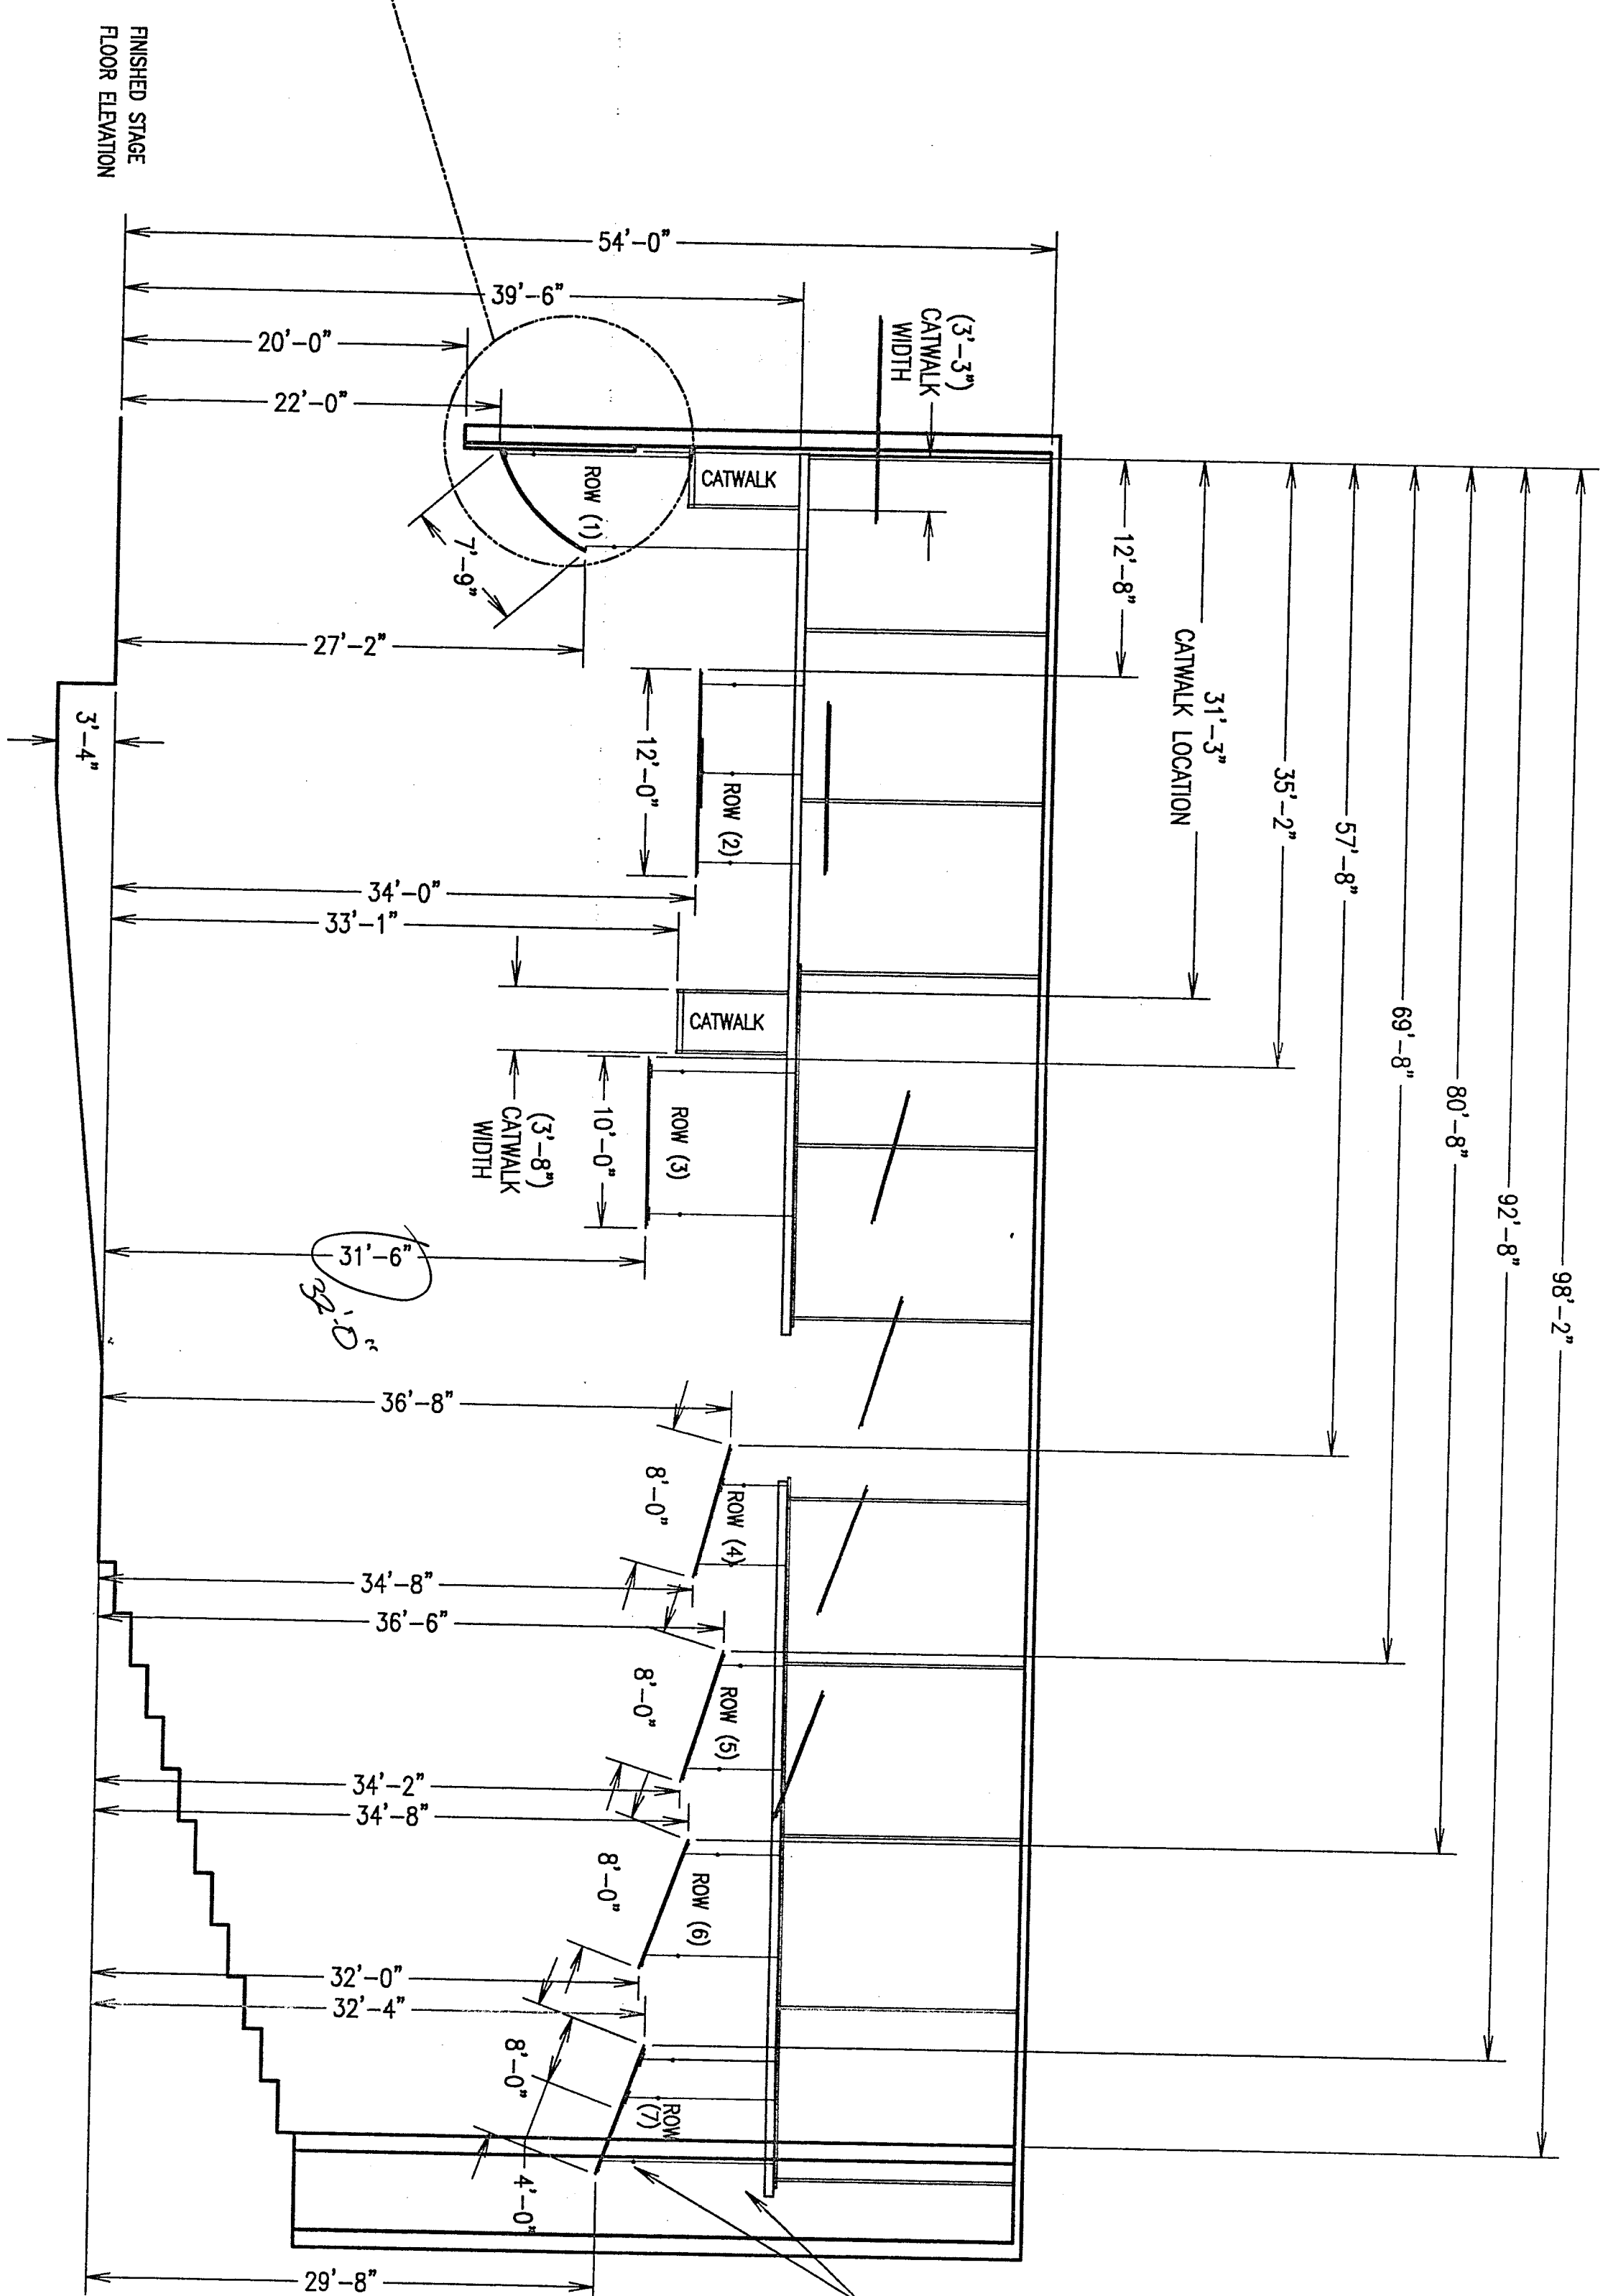

INDICATES 1 1/2" SCHEDULE 40 PIPE BATTENS
SUSPENDED BY 3/16" BLACK CHAIN AND 3/16" SCREW
PIN SHACKLES. SUPPLIED AND INSTALLED BY WENGER

SECTION THRU AUDITORIUM

PREPARED FOR:

CHESTERON HIGH SCHOOL NORTH
CHESTERON, INDIANA

This drawing and specification

contains information
Proprietary. Any reproduction,
disclosure, or use thereof is
expressly prohibited without the
written permission of Wenger
Corporation.

1000

SCALE: 1/8"=1'-0"

L.M. NO.

TITLE: ACOUSTICAL CLOUD PANEL - SECTION

92-A-22

Warner

OWATONNA, MN - TELEPHONE: 507-455-4100

DWG. NO.	SHEET 2 OF 7	REV.
----------	--------------	------

A-1059-1D