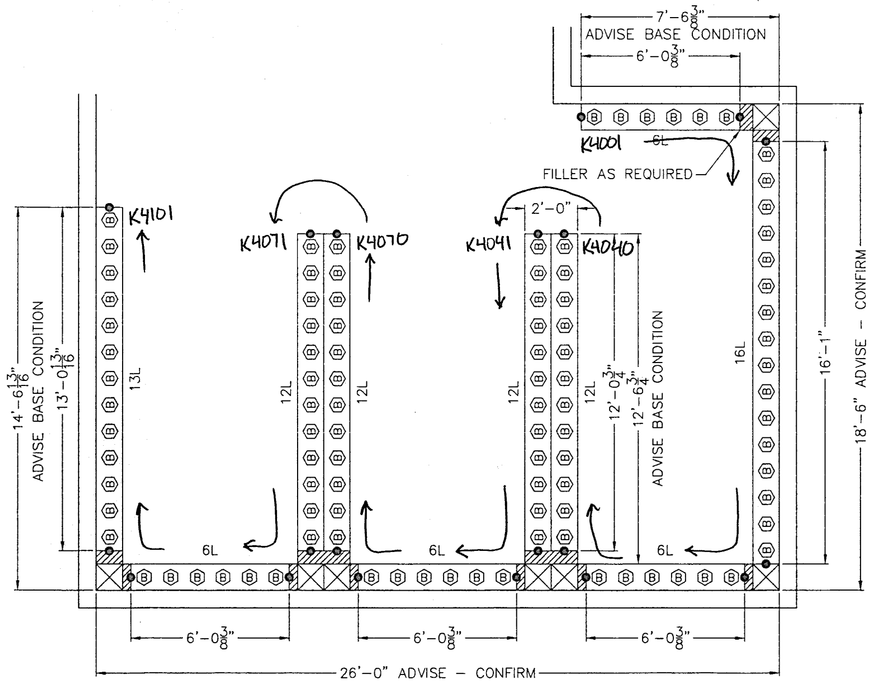

LOCKER ROOM Q127

B 101 – 12" x 12 " x 60" SINGLE TIER INVINCIBLE II WELDED FRAMES
● – SOLID END, ALL OTHER SIDES ARE DIAMOND PERFORATED

NOTE:
ADVISE ▶ NUMBERING: See plan
ADVISE ▶ FINISH COLOR: J66 BRANDY WINE

LOCKER ROOM Q115

B 93 – 12" x 12 " x 60" SINGLE TIER INVINCIBLE II WELDED FRAMES
● – SOLID END, ALL OTHER SIDES ARE DIAMOND PERFORATED

NOTE:
ADVISE ▶ NUMBERING: See plan
ADVISE ▶ FINISH COLOR: J66 BRANDY WINE

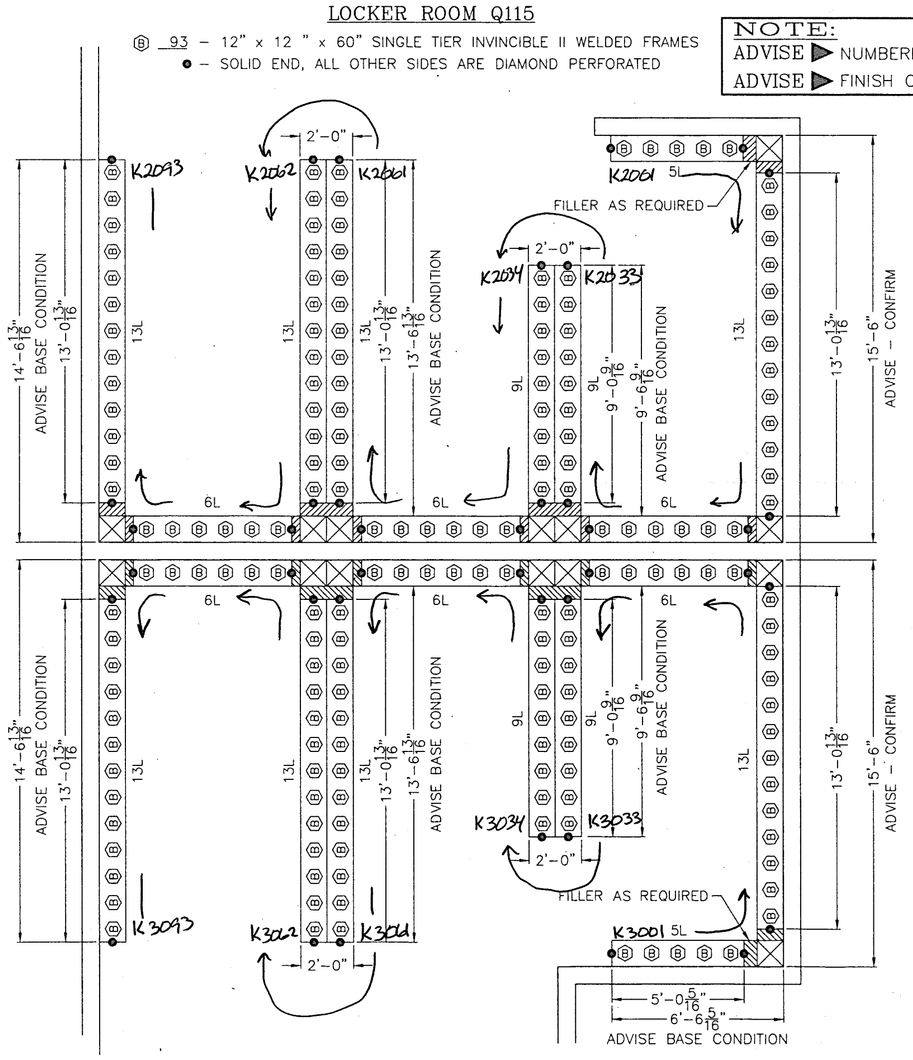

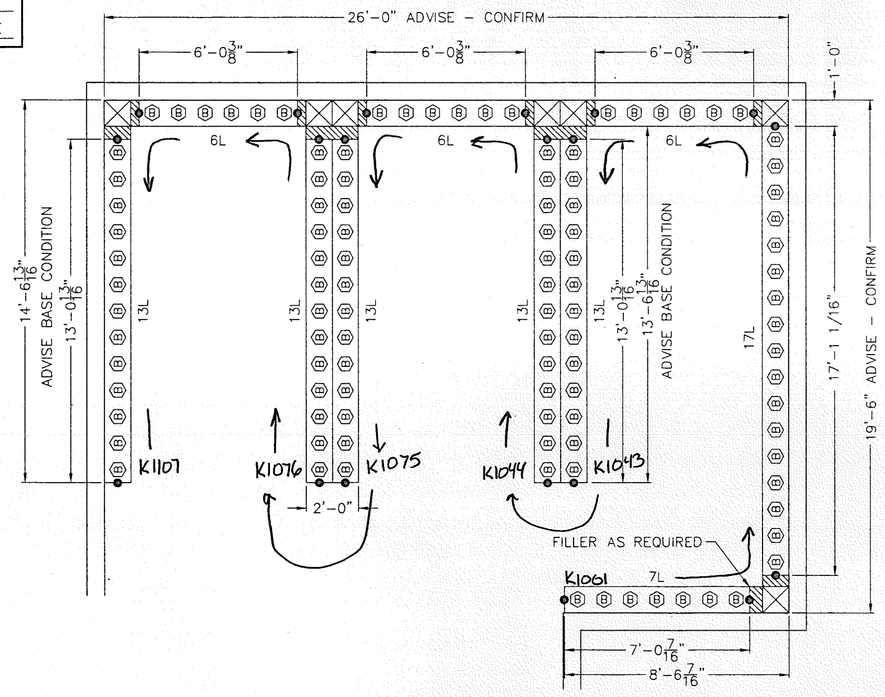

LOCKER ROOM Q109

B 107 – 12" x 12 " x 60" SINGLE TIER INVINCIBLE II WELDED FRAMES
● – SOLID END, ALL OTHER SIDES ARE DIAMOND PERFORATED

NOTE:
ADVISE ▶ NUMBERING: See plan
ADVISE ▶ FINISH COLOR: 012 TAWNY TAN

LOCKER ROOM Q120

B 93 – 12" x 12 " x 60" SINGLE TIER INVINCIBLE II WELDED FRAMES
● – SOLID END, ALL OTHER SIDES ARE DIAMOND PERFORATED

NOTE:
ADVISE ▶ NUMBERING: See plan
ADVISE ▶ FINISH COLOR: 012 TAWNY TAN

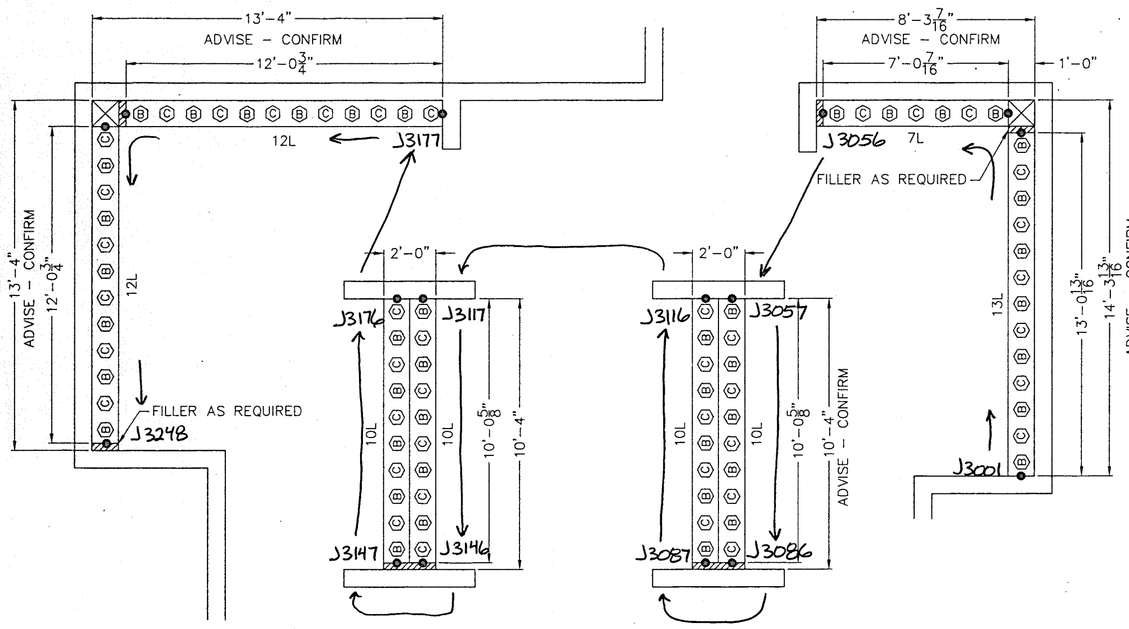

LOCKER ROOM P106

B 43 – 12" x 12 " x 60" SINGLE TIER INVINCIBLE II WELDED FRAMES
C 41 – 12" x 12 " x 60" FIVE TIER INVINCIBLE II WELDED FRAMES
205 – TOTAL 12" FIVE TIER OPENINGS
● – SOLID END, ALL OTHER SIDES ARE DIAMOND PERFORATED

NOTE:
ADVISE ▶ NUMBERING: See plan
ADVISE ▶ FINISH COLOR: 012 TAWNY TAN

Note: Locker "C" to be numbered top to Bottom.

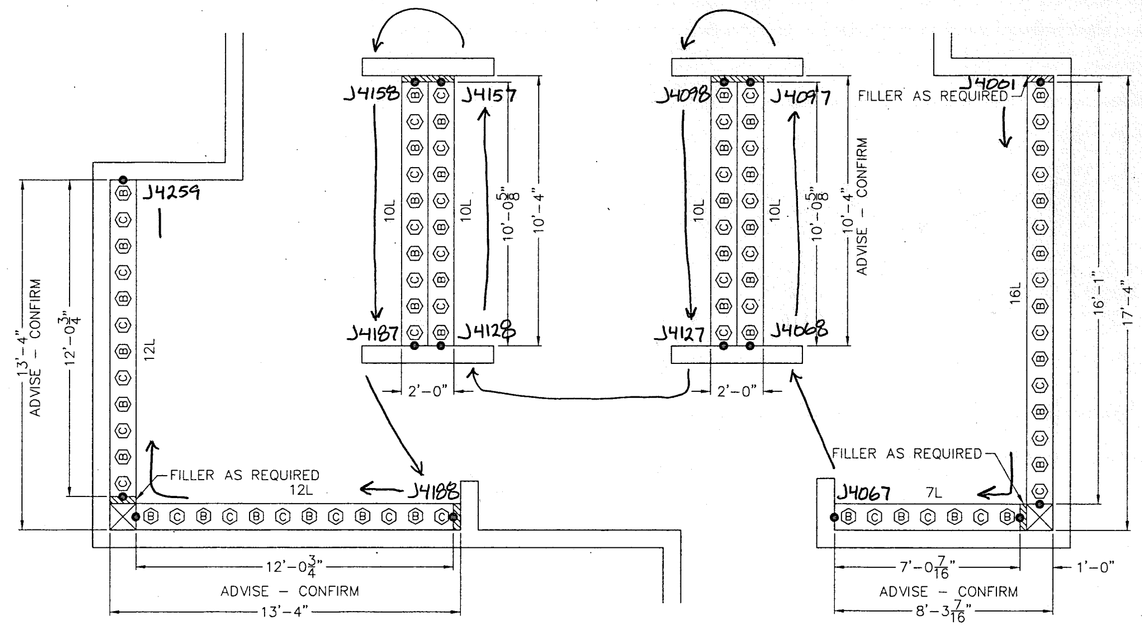

LOCKER ROOM P113

B 44 – 12" x 12 " x 60" SINGLE TIER INVINCIBLE II WELDED FRAMES
C 43 – 12" x 12 " x 60" FIVE TIER INVINCIBLE II WELDED FRAMES
215 – TOTAL 12" FIVE TIER OPENINGS
● – SOLID END, ALL OTHER SIDES ARE DIAMOND PERFORATED

NOTE:
ADVISE ▶ NUMBERING: See plan
ADVISE ▶ FINISH COLOR: J66 BRANDY WINE

97L-A02

REQUIRED

FIELD CHECK:

TITLE: WELDED LOCKER FLOOR PLANS

PENCO

PENCO PRODUCTS ● OAKS, PENNSYLVANIA

PROJECT: CHESTERTON HIGH SCHOOL
LOCATION: CHESTERTON, INDIANA
ARCHITECT:
CONTRACTOR: R.A. SNEIMIS CONSTRUCTION CO.
DRAWN BY: KEN McCARRON DATE: 7/30/98
CHECKED BY: DATE:
SCALE: NOT TO SCALE SH: 2 OF: 7
ORDER NO: C98M26829-31 DWG. NO: 26829-31

REV	REMARKS	BY	DATE
1	MAKE REVISIONS AS REQUIRED	KMcC	1/28/99