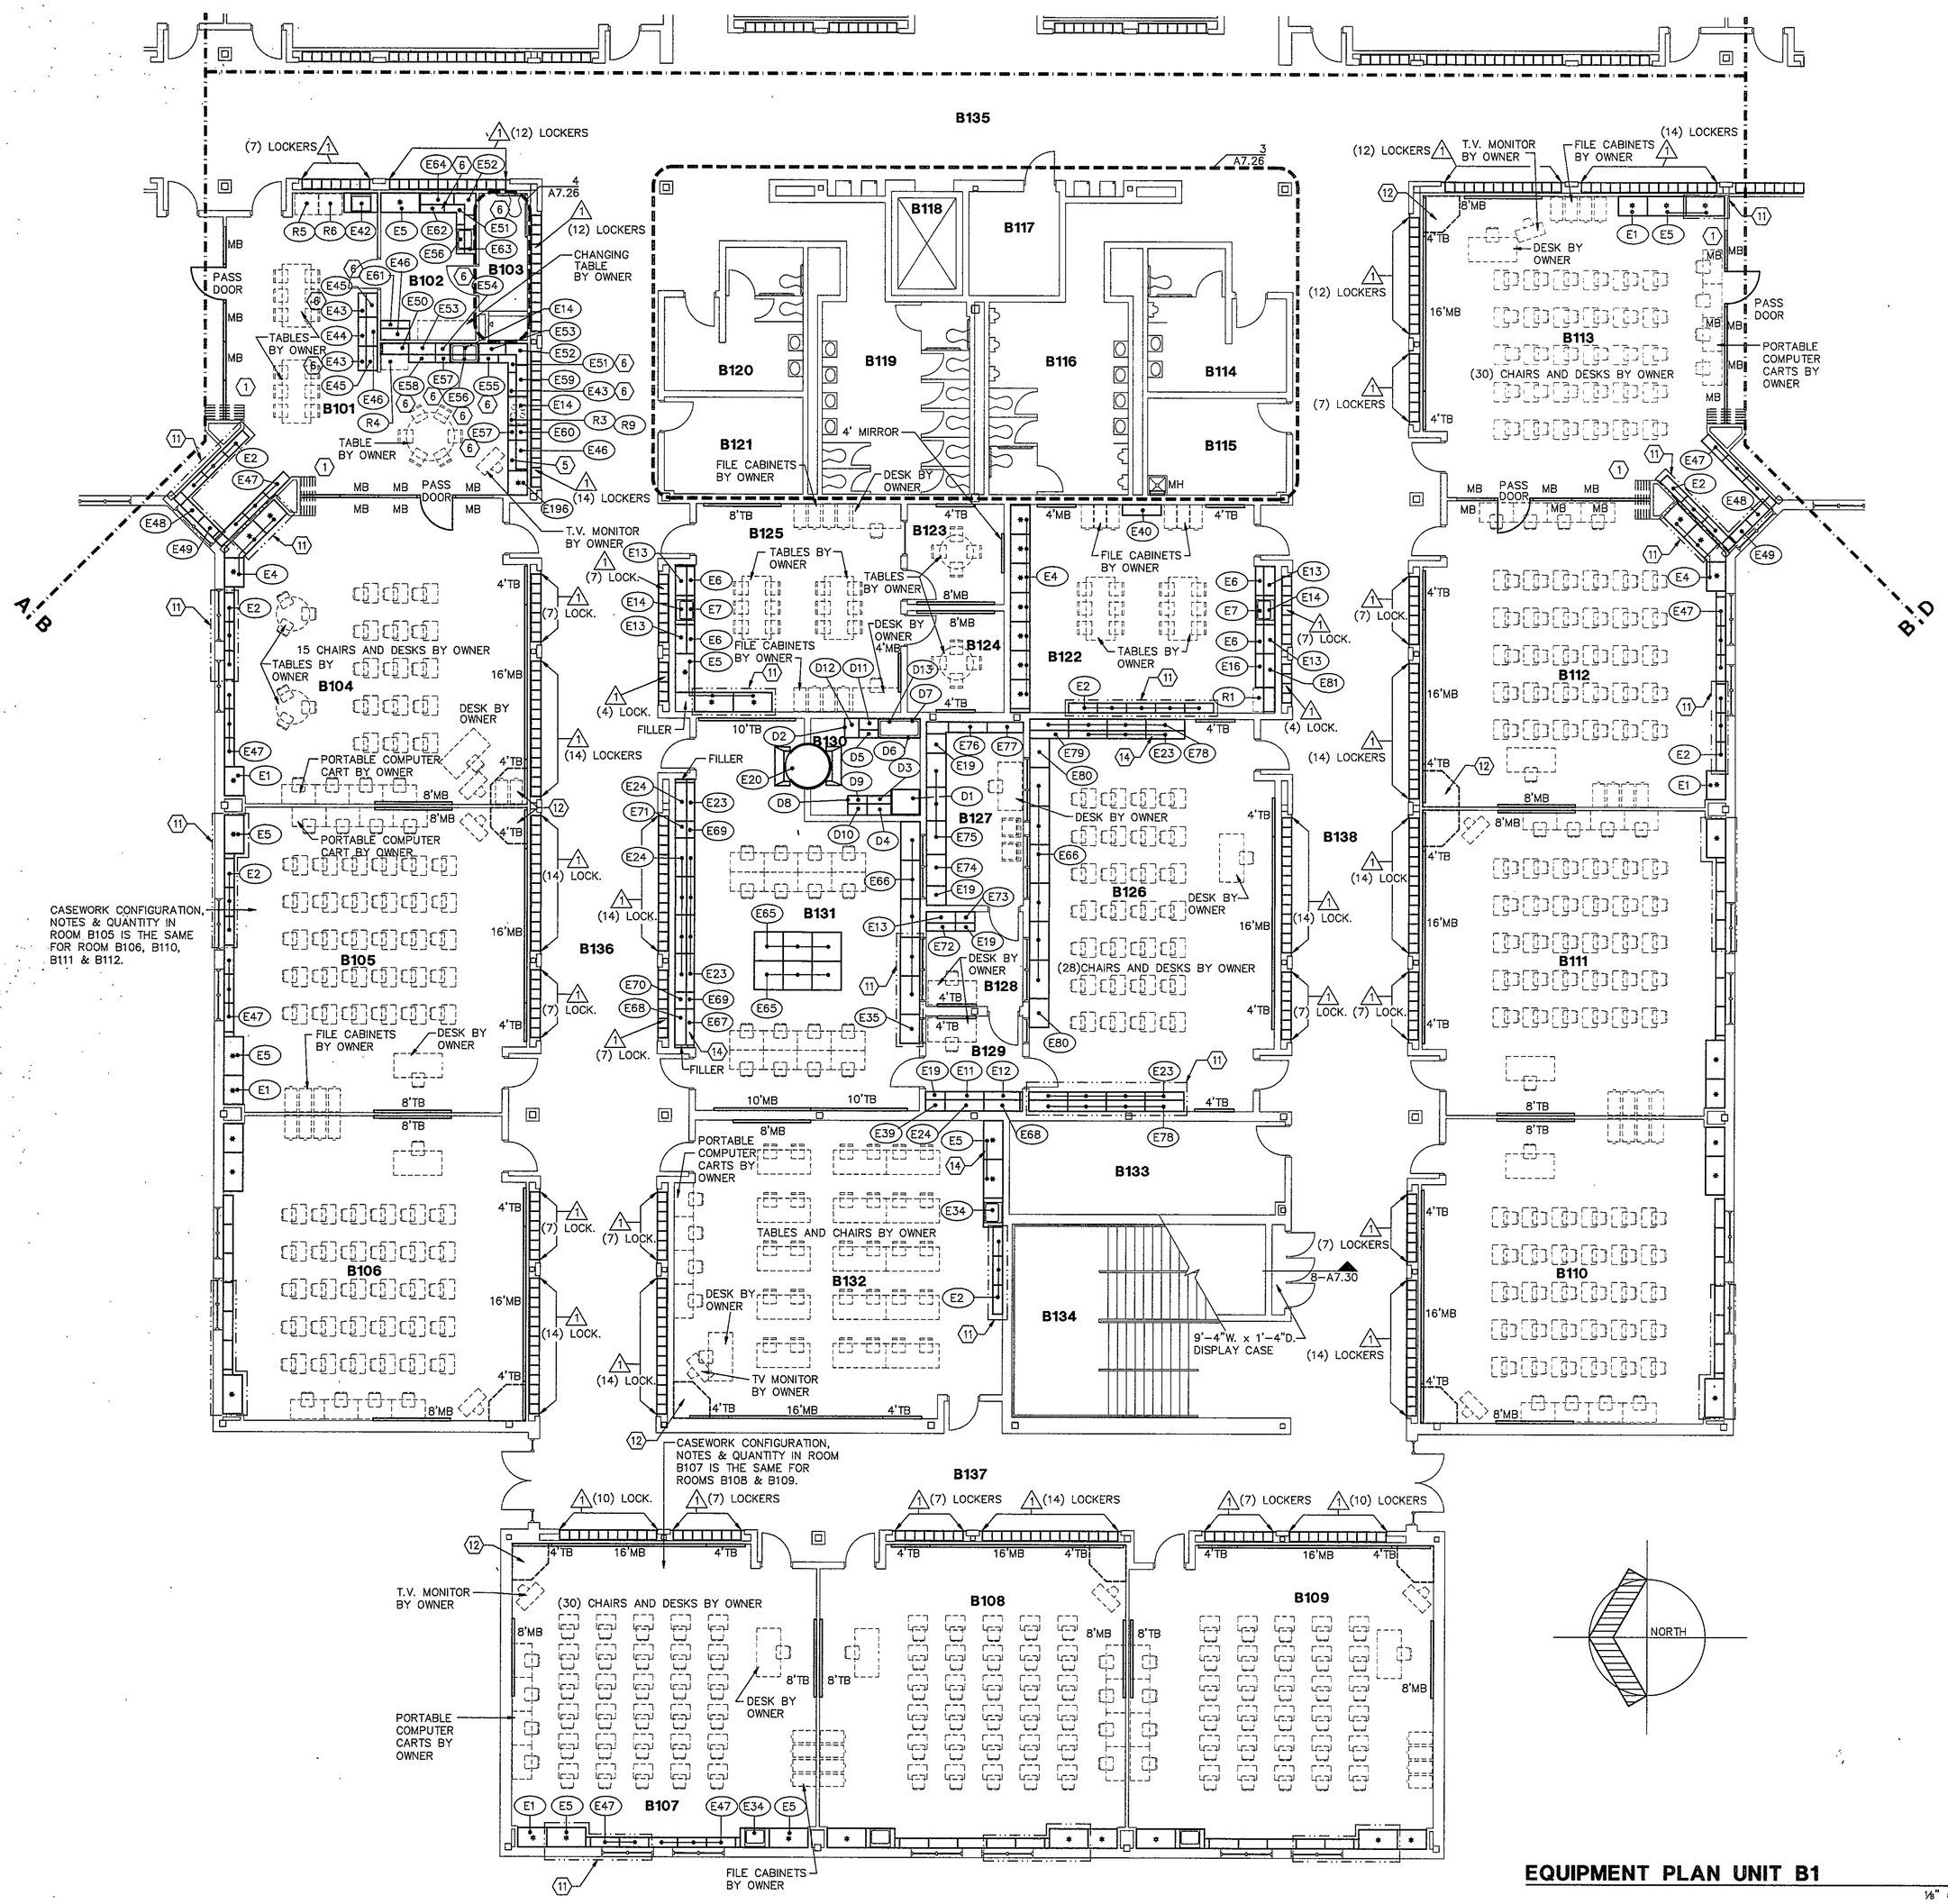

EQUIPMENT PLAN UNIT B1

1/8" = 1'-0"

ROOM LEGEND "B1"

ROOM NO.	ROOM NAME	AREA S.F.	CEILING HEIGHT
B101	LIFE SKILLS	753	9'-4"
B102	HEALTH MAINTANENCE	149	9'-4"
B103	HEALTH TOILET	73	9'-4"
B104	CLASSROOM	959	VAIRES
B105	CLASSROOM	972	VARIES
B106	CLASSROOM	967	VARIES
B107	CLASSROOM	967	VARIES
B108	CLASSROOM	972	VARIES
B109	CLASSROOM	967	VARIES
B110	CLASSROOM	967	VARIES
B111	CLASSROOM	972	VARIES
B112	CLASSROOM	959	VARIES
B113	CLASSROOM	996	11'-8"
B114	FACULTY TOILET	177	9'-4"
B115	JANITOR CLOSET	143	9'-4"
B116	BOYS TOILET	355	9'-4"
B117	ELEVATOR EQUIPMENT	100	9'-4"
B118	ELEVATOR	79	---
B119	GIRLS TOILET	375	9'-4"
B120	FACULTY TOILET	178	9'-4"
B121	ELECTRICAL CLOSET	143	---
B122	DEPARTMENTAL PLANNING	574	9'-4"
B123	CONFERENCE ROOM	103	9'-4"
B124	CONFERENCE ROOM	105	9'-4"
B125	DEPARTMENTAL PLANNING	488	9'-4"
B126	JOURNALISM	1002	VARIES
B127	OFFICE	190	9'-4"
B128	OFFICE	100	9'-4"
B129	OFFICE	100	9'-4"
B130	DARKROOM	113	9'-4"
B131	PRODUCTION	874	9'-4"
B132	ISL	1017	VARIES
B133	STORAGE	274	9'-4"
B134	STAIR	543	---
B135	CORRIDOR	2459	10'-0"
B136	CORRIDOR	1803	10'-0"
B137	CORRIDOR	978	10'-0"
B138	CORRIDOR	1803	10'-0"

EQUIPMENT PLAN GENERAL NOTES

1. (R__) INDICATES SCHEDULED RESIDENTIAL AND SPECIALTY CASEWORK. REFER TO SPECIFICATION SECTION 11450 FOR SCHEDULE.
2. (D__) INDICATES SCHEDULED DARKROOM CASEWORK. REFER TO SPECIFICATION SECTION 11470 FOR SCHEDULE.
3. (P__) INDICATES SCHEDULED PHYSICAL EDUCATION CASEWORK. REFER TO SPECIFICATION SECTION 11480 FOR SCHEDULE.
4. (L__) INDICATES SCHEDULED MEDIA CENTER CASEWORK. REFER TO SPECIFICATION SECTION 12315 FOR SCHEDULE.
5. (E__) INDICATES SCHEDULED EDUCATIONAL CASEWORK. REFER TO SPECIFICATION SECTION 12324 FOR SCHEDULE.
6. (S__) INDICATES SCHEDULED SCIENCE CASEWORK. REFER TO SPECIFICATION SECTION 12345 FOR SCHEDULE.
7. (M__) INDICATES SCHEDULED MUSIC CASEWORK. REFER TO SPECIFICATION SECTION 12324 FOR SCHEDULE.
8. COUNTERTOPS SHALL BE PROVIDED WITH A 4" HIGH BACKSPLASH AND ENDSPLASH EXCEPT WHEN DETAILED OTHERWISE.
9. PROVIDE FILLERS AS REQUIRED BETWEEN CASEWORK UNITS AND OTHER WALL UNITS AND WALL.
10. PROVIDE CONTINUOUS COUNTERTOPS.
11. ALL EXPOSED ENDS AND BACKS SHALL BE FINISHED.
12. THE CABINET INSTALLER SHALL CAULK BETWEEN COUNTERTOPS AND BACKSPLASHES, ENDSPLASHES AND WALLS.
13. THE CABINET INSTALLER SHALL CUT CASEWORK UNITS AS REQUIRED FOR PLUMBING/ELECTRICAL LINES AND CABINET-INSTALLED EQUIPMENT.
14. ALL WALL-MOUNTED CASEWORK SHALL BE MOUNTED WITH THE TOP @ 7'-0" A.F.F. UNLESS NOTED OTHERWISE.
15. SEE SHEET A7.26 FOR MOUNTING HEIGHTS.
16. ALL CASEWORK DOORS AND DRAWERS SHALL BE LOCKABLE - KEYED PER ROOM UNLESS NOTED OTHERWISE.
17. CABINETS INDICATED TO RECEIVE SINKS SHALL BE CONSTRUCTED TOO ALLOW FOR INSTALLATION OF SINKS FOR SIZES INDICATED. COORDINATE WITH DIVISON 15 FOR SINK SIZES.
18. PROVIDE A FINISHED TOP ON ALL CABINETS THAT DO NOT HAVE A BULKHEAD ABOVE THEM.
19. PROVIDE ABOVE ALL WALL CABINETS BELOW BULKHEADS CLOSURE PIECE. REFER TO DETAIL 3-A7.29.
20. REFER TO DETAIL 4-A7.29 FOR WALL CABINET CONSTRUCTION.
21. VERIFY LOCATION OF T.V. MONITOR IN CLASSROOMS IF ALTERNATIVE FOR THE SLOPED PROJECTION SCREEN IS NOT ACCEPTED.

LOCKER LEGEND

1. 12" X 12" X 60" STANDARD LOCKERS REFER TO DETAIL 9-A7.29 & SPEC. SECT. 10500.
2. 12" X 12" X 72" STANDARD LOCKERS WITH SLOPED TOPS - REFER TO DETL 3-A7.30 & SPEC. SECT. 10500
3. 12" X 12" X 60" ATHLETIC LOCKERS WITH SLOPED TOPS - REFER TO DETAILS 1-A7.30 & 2-A7.30 AND SPEC. SECTION 10505
4. 12" X 12" X 12" 5 TIER HIGH ATHLETIC LOCKERS WITH SLOPED TOPS - REFER TO DETAILS 1-A7.30 AND 2-A7.30 AND SPEC. SECTION 10505
5. 24" X 18" X 72" ATHLETIC LOCKERS WITH SLOPED TOPS - REFER TO DETAIL 1-A7.30 & SPEC. SECT. 10505
6. 24" X 21" X 72" ATHLETIC LOCKERS WITH SLOPED TOPS - REFER TO DETAIL 3-A7.30 & SPEC. SECT. 10505

PROVIDE LOCKERS FOR THE PHYSICALLY CHALLENGED PER SPEC. SECTION 10500.

CASEWORK NOTES

1. OPERABLE WALL, MODEL 932 - REFER TO SPEC. SECT. 10650. REFER TO ROOMS B101, B104, B112, AND B113.
3. PROVIDE (1) COAT HOOK ON WALL BEHIND DOOR IN THE FOLLOWING ROOMS, B127 - B129. REFER TO SPEC. SECTION 10900.
5. ADJUSTABLE COUNTERTOP - PROVIDE ADJUSTMENT FOR (4) DIFFERENT HEIGHTS AT 28"H., 30"H., 32"H. AND 34"H.
6. UNIT HEIGHT HAS BEEN ADJUSTED TO 34" TO MEET AMERICANS WITH DISABILITIES ACT (ADA) PER SPEC. SECT. 12324 ARTICLE 1.08.1.
11. PROVIDE THIS CASEWORK AS AN ALTERNATE. REFER TO ALTERNATIVES.
12. PROVIDE MONITOR CABINET (DETAIL 16-A7.29) IN CLASSROOM, WHERE INDICATED. ADJUST VISUAL DISPLAY BOARDS ACCORDINGLY. REFER TO ALTERNATIVES.
14. REFER TO ELECTRICAL DRAWINGS FOR LOCATION OF COMPUTER HUB. MODIFY CASEWORK ACCORDINGLY.

97-A-107

COPYRIGHT 1997 BY FANNING/HOWEY ASSOCIATES, INC.

DOUGLAS M. WICZER REGISTERED NO. 10009 STATE OF INDIANA ARCHITECT

LEE BROCKMAN REGISTERED NO. 10866 STATE OF INDIANA ARCHITECT

THE NEW
CHESTERTON HIGH SCHOOL
FOR THE
DUNELAND SCHOOL CORPORATION
CHESTERTON, INDIANA

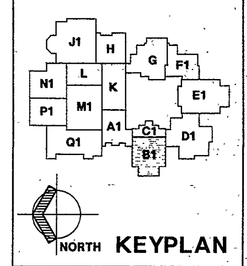

KEYPLAN

Fanning/Howey Associates, Inc.
Architects Engineers Consultants

EQUIPMENT PLAN UNIT B1

DRAWN BY: LEC/MIC
CHECKED BY: MJJ
COMM. NO.: 95067.00
DATE: APRIL 21, 1997

REVISIONS NO. DATE

A7.3

CHESTERTON HIGH SCHOOL
95067.00