
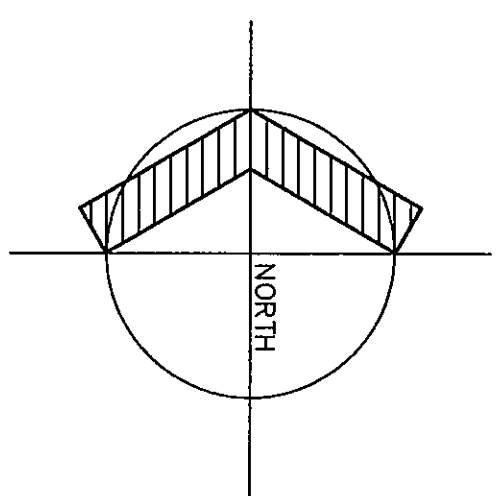


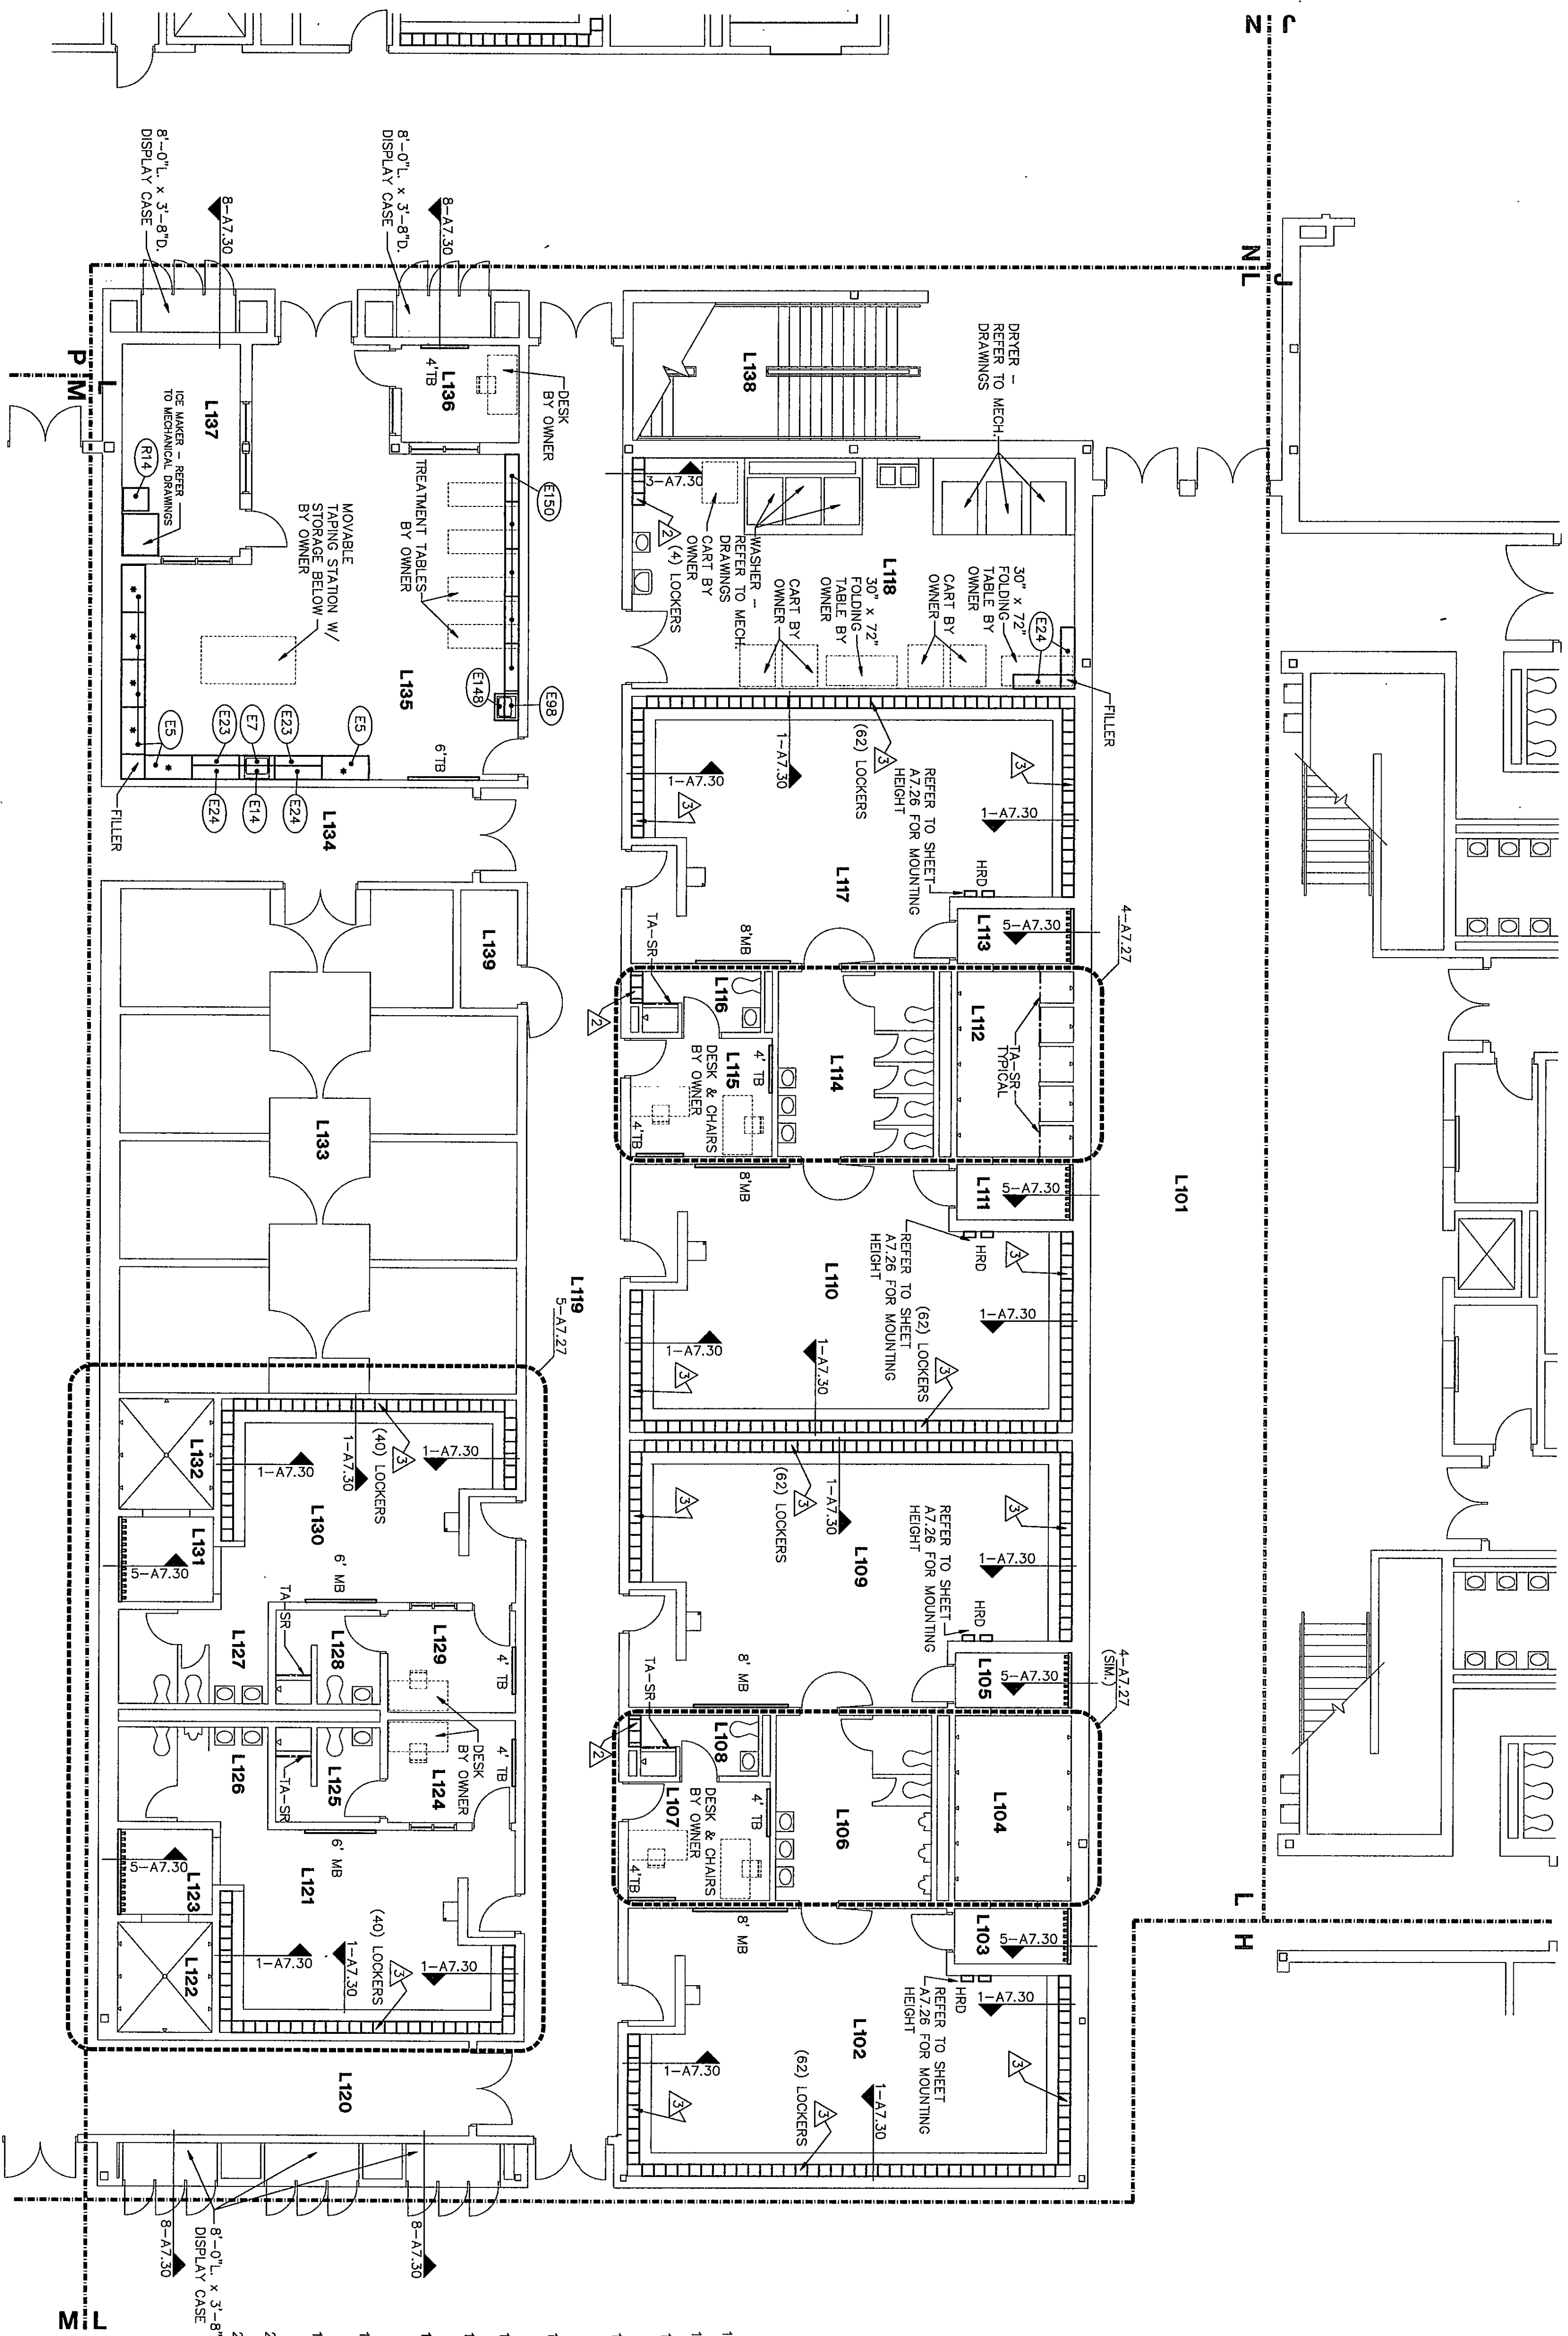

EQUIPMENT PLAN UNIT L

1/8" = 1'-0"

EQUIPMENT PLAN GENERAL NOTES

- INDICATES SCHEDULED RESIDENTIAL AND SPECIALTY CASEWORK. REFER TO SPECIFICATION SECTION 11450 FOR SCHEDULE.
- INDICATES SCHEDULED DARKROOM CASEWORK. REFER TO SPECIFICATION SECTION 11740 FOR SCHEDULE.
- INDICATES SCHEDULED PHYSICAL EDUCATION CASEWORK. REFER TO SPECIFICATION SECTION 11480 FOR SCHEDULE.
- INDICATES SCHEDULED MEDIA CENTER CASEWORK. REFER TO SPECIFICATION SECTION 12315 FOR SCHEDULE.
- INDICATES SCHEDULED EDUCATIONAL CASEWORK. REFER TO SPECIFICATION SECTION 12324 FOR SCHEDULE.
- INDICATES SCHEDULED SERVICE CASEWORK. REFER TO SPECIFICATION SECTION 12345 FOR SCHEDULE.
- INDICATES SCHEDULED MUSIC CASEWORK. REFER TO SPECIFICATION SECTION 12324 FOR SCHEDULE.
- COUNTERTOPS SHALL BE REMOVED WITH A 4" HIGH BACKPLASH AND ENDS/FLASH EXCEPT WHEN DETAILED OTHERWISE.
- PROVIDE FILTERS AS REQUIRED BETWEEN CASEWORK UNITS AND OTHER WALL UNITS AND WALL.
- PROVIDE CONTINUOUS COUNTERTOPS.
- ALL EXPOSED ENDS AND BACKS SHALL BE FINISHED.
- THE CABINET INSTALLER SHALL GAULK BETWEEN COUNTERTOPS AND BACKS/FLASHES, ENDS/FLASHES AND WALLS.
- THE CABINET INSTALLER SHALL CUT CASEWORK UNITS AS REQUIRED FOR PLUMBING/ELECTRICAL LINES AND CABINET-INSTALLED EQUIPMENT.
- ALL WALL-MOUNTED CASEWORK SHALL BE MOUNTED WITH THE TOP 9'-0" A.F.F. UNLESS NOTED OTHERWISE.
- SEE SHEET A726 FOR MOUNTING HEIGHTS.
- ALL CASEWORK DOORS AND DRAWERS SHALL BE LOCKABLE - KEYS PER ROOM UNLESS NOTED OTHERWISE.
- CABINETS INDICATED TO RECEIVE SINKS SHALL BE CONSTRUCTED COORDINATE WITH DIVISION 15 FOR SINK SIZES.
- PROVIDE A FINISHED TOP ON ALL CABINETS THAT DO NOT HAVE A BULKHEAD ABOVE THEM.
- PROVIDE ABOVE ALL WALL CABINETS BELOW BULKHEADS CLOSURE PIECE. REFER TO DETAIL 3-A723.
- REFER TO DETAIL 4-A729 FOR WALL CABINET CONSTRUCTION.
- VERIFY LOCATION OF T.V. MONITOR IN CLASSROOMS IF ALTERNATIVE FOR THE SLOPED PROJECTION SCREEN IS NOT ACCEPTED.

LOCKER LEGEND

- 12' X 12' X 60" STANDARD LOCKERS
SECT. 10900
- 12' X 12' X 72" STANDARD LOCKERS
WITH SLOPED TOPS - REFER TO DETAIL 3-A723 AND SPEC. SECT. 10900
- 12' X 12' X 60" ATHLETIC LOCKERS
WITH SLOPED TOPS - REFER TO DETAILS 1-A720 AND 2-A720 AND SPEC. SECTION 10905
- 12' X 12' X 12' X 8' TIER HIGH ATHLETIC LOCKERS
WITH SLOPED TOPS - REFER TO DETAIL 1-A720 AND SPEC. SECT. 10905
- 24' X 12' X 72" ATHLETIC LOCKERS
WITH SLOPED TOPS - REFER TO DETAIL 3-A723 AND SPEC. SECT. 10905
- PROVIDE LOCKERS FOR THE PHYSICALLY CHALLENGED PER SPEC. SECTION 10900.

THE NEW
CHESTERTON HIGH SCHOOL
FOR THE
DUNELAND SCHOOL CORPORATION
CHESTERTON, INDIANA

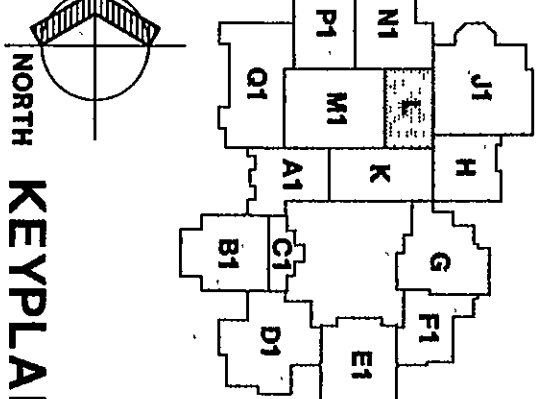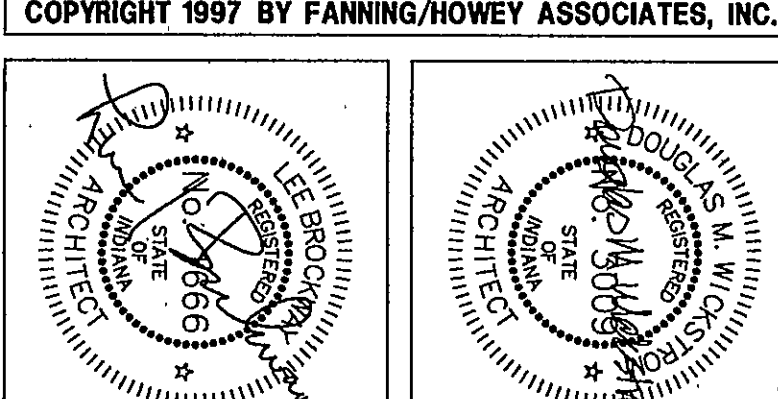

Fanning/Howey Associates, Inc.
Architects Engineers Consultants

EQUIPMENT PLAN UNIT L
DRAWN BY: LEC/SB COMM. NO.: 95067.00
CHECKED BY: JHH DATE: APRIL 21, 1997
A7.17
REVISIONS NO. DATE

CHESTERTON HIGH SCHOOL
05/08/97