


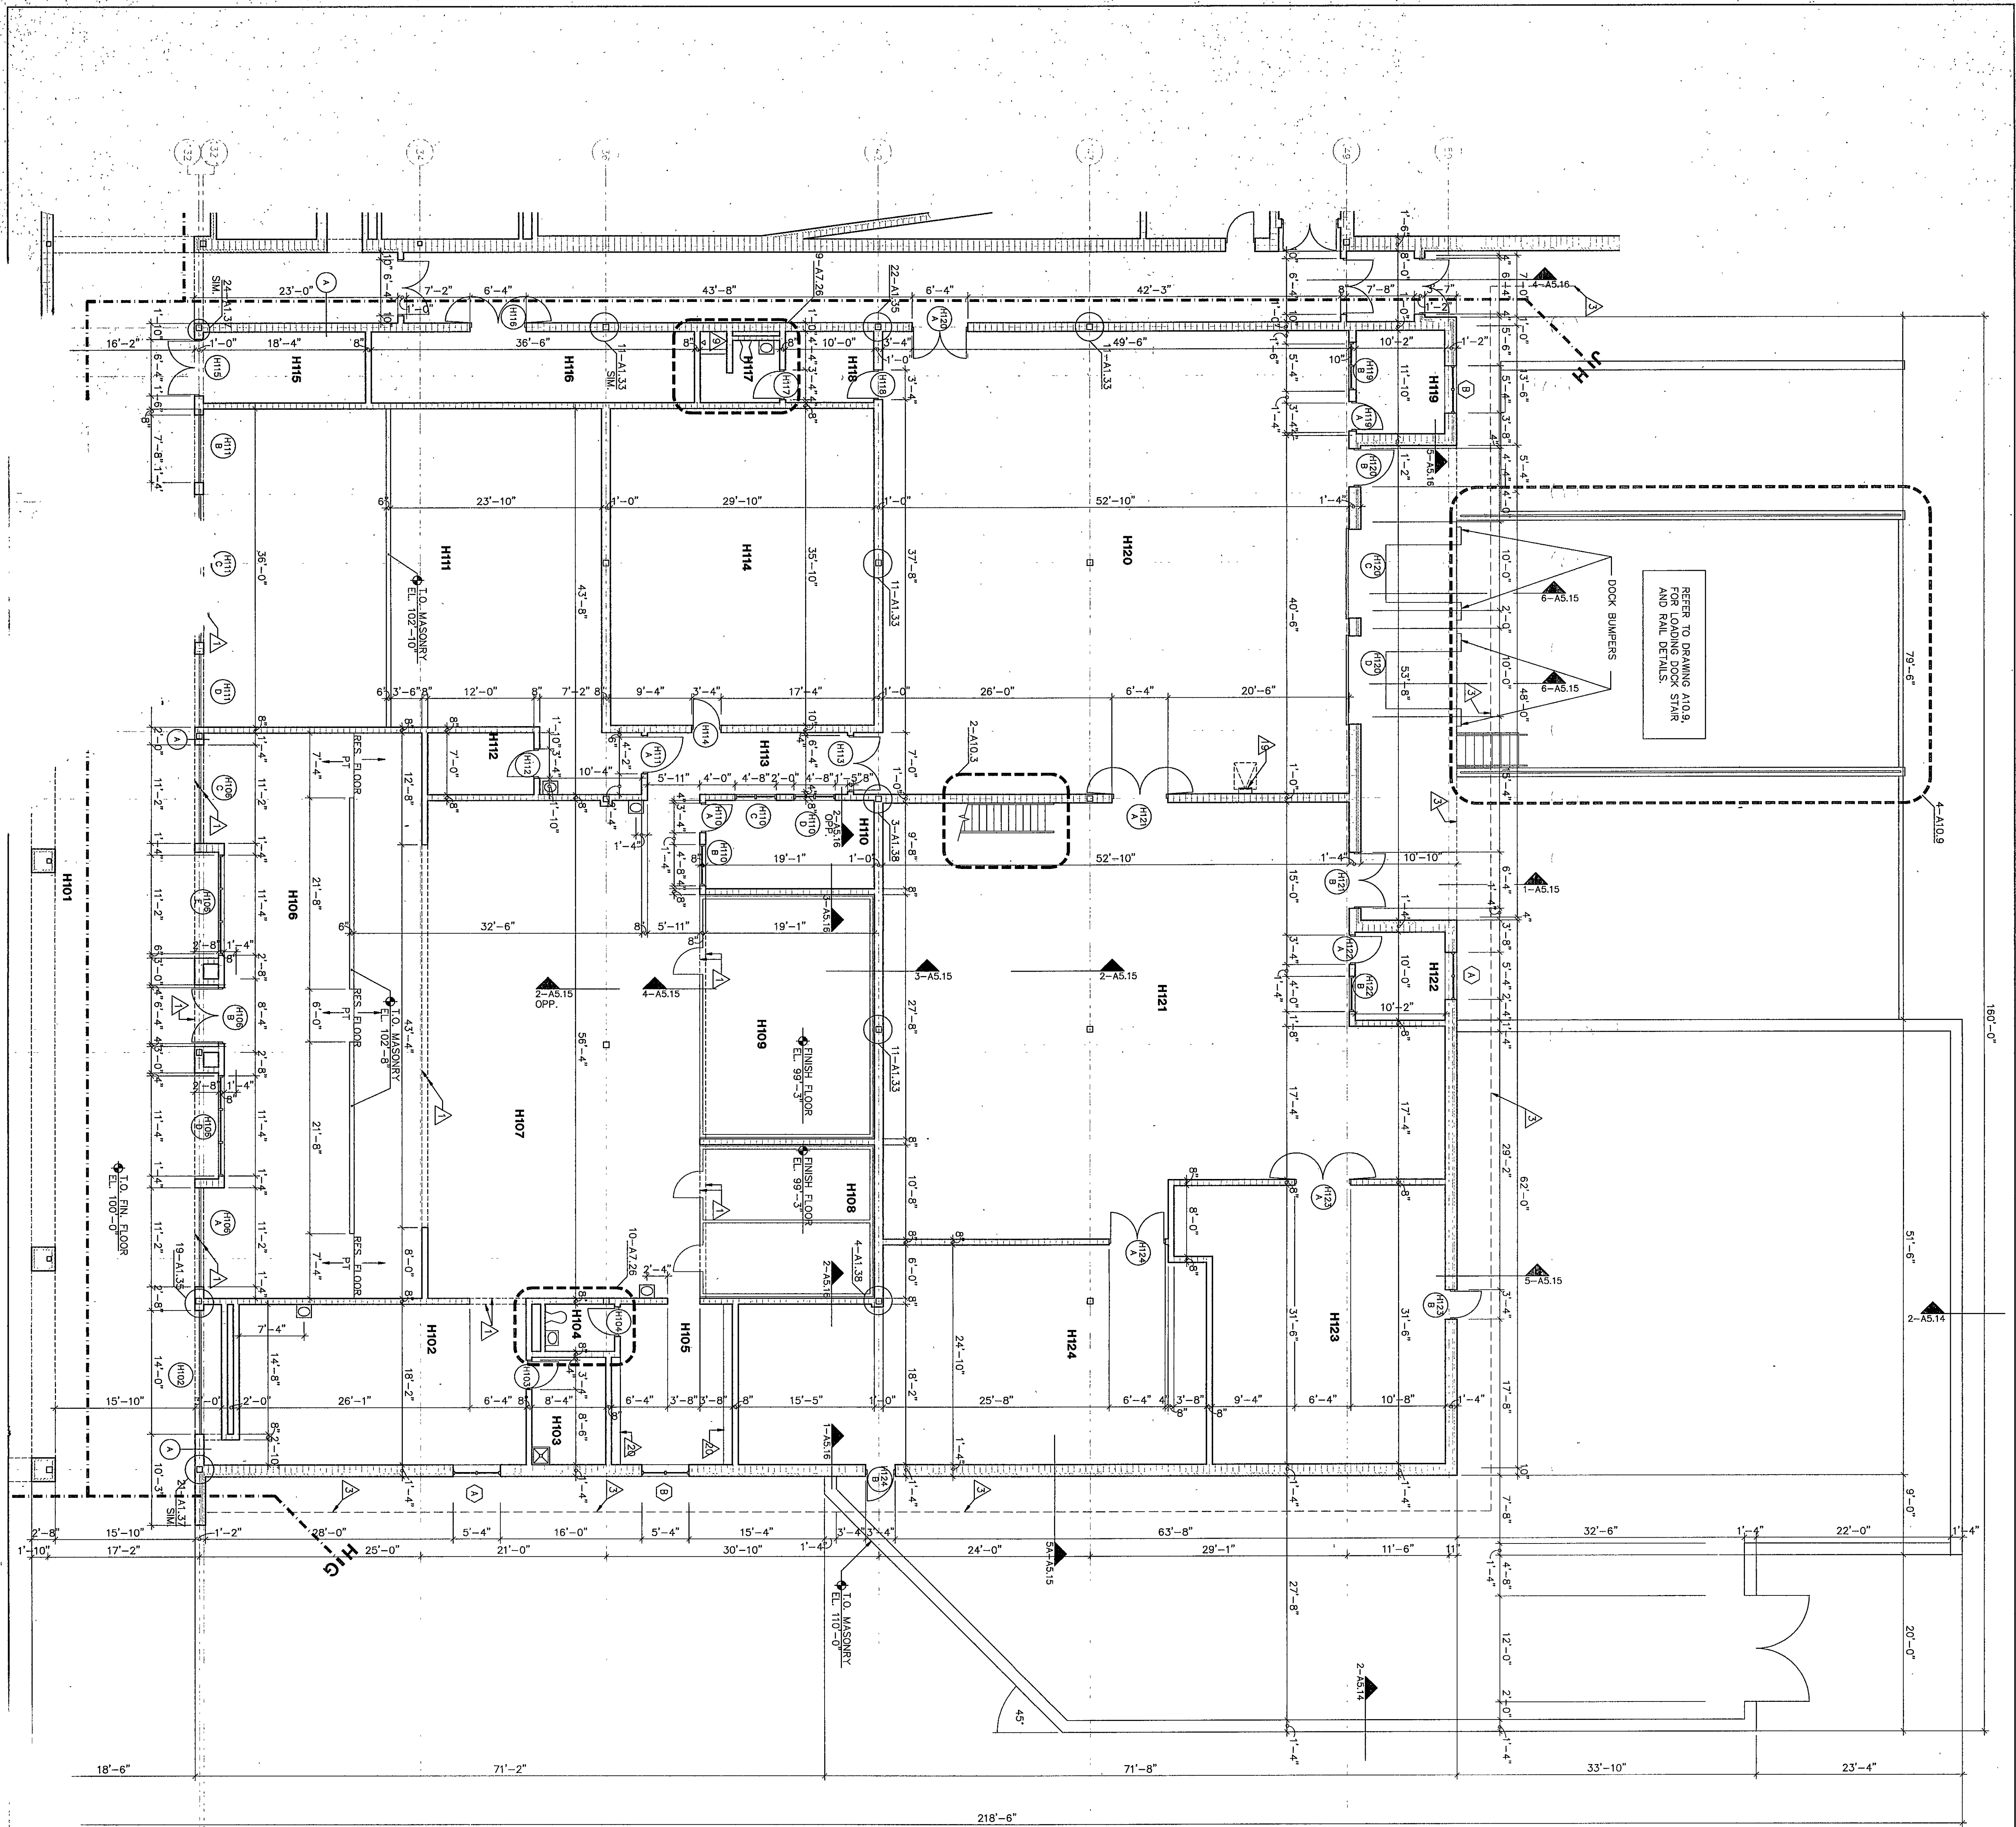

**ROOM LEGEND "H"**


| ROOM NO. | ROOM NAME         | AREA S.F. | CEILING HEIGHT |
|----------|-------------------|-----------|----------------|
| H101     | CORRIDOR          | 2240      | 10'-0"         |
| H102     | WASHING           | 600       | 9'-4"          |
| H103     | TOLLETS/LAUNDRY   | 401       | 9'-4"          |
| H104     | LOCKER/BREAK ROOM | 242       | 9'-4"          |
| H105     | COOKING/BAKING    | 2252      | 9'-4"          |
**KEY NOTES**

1. INDICATES BLUEHED LINE ABOVE-- REFER TO INDICATED SECTIONS, DETAILS, REFLECTED CEILING PLANS, AND INTERIOR ELEVATIONS.
2. LOCKER BASE - SEE SECTION 5-A7.29
3. INDICATES ROOF OVERHANG - SEE SECTIONS AND DETAILS
4. TYPE I OPERABLE WALL - REFER TO SPEC. SECTION 10650. REFER TO EQUIP. PLANS FOR LOCATIONS OF WRITING SURFACE
5. TYPE II OPERABLE WALL - REFER TO SPEC. SECTION 10650. REFER TO EQUIP. PLANS FOR LOCATIONS OF WRITING SURFACE
6. APPLY PLASTER SKIN COAT OVER CONC. MASONRY UNITS WHERE INDICATED PER SPEC. SEC. 05500.
7. METAL STUDS @ 1'-4" O.C. WITH 1/2" W/5/8" GYPSUM BOARD TO FACE OF STUD. ARE NOMINAL AND TO FACE OF STUD. (I.E. 4-3/8" METAL STUDS)
8. INDICATES CORNER GUARD - REFER TO INDICATED SECTIONS AND DETAILS
9. INDICATES ADA COMPLIANT SHOWER CURB. REFER TO SECTIONS AND DETAILS 12-A7.28.
10. LOCKER BENCH BASE - REFER TO DETAIL 1-A7.20 AND 2-A7.20.
11. INDICATES FLOOR TRENCH PER DETAIL 11-54.5 AND CASEWORK.
12. INDICATES POSTER CASE - REFER TO EQUIPMENT DRAWINGS
13. METAL STUDS @ 1'-4" O.C. W/5/8" GYPSUM BOARD ON EXPOSED FACE ONLY - REFER TO SPEC. SECTION 05500. NOTE 7 ABOVE REGARDING NOMINAL DIMENSIONS.
14. METAL STUDS @ 1'-4" O.C. W/5/8" GYPSUM BOARD ON EXPOSED FACE, ALSO SEE WALL SECTION 1-A5.4.
15. BUILT-IN BENCH, REFER TO DETAIL 18-A7.28.
16. INDICATES BUILDING EXPANSION JOINT, REFER TO INDICATED SECTIONS.
17. WIRE MESH PARTITIONS-REFER TO SPEC. SEC. 10605.
18. INDICATES LADDER-REFER TO SPEC. SEC. 05500.
19. LOCKER BASE - SEE SECTION 5-A7.20

**FLOOR PLAN NOTES**

1. WHERE DIFFERENT FLOOR MATERIALS MEET, THEY SHALL MEET UNDER THE CENTERLINE OF THE DOOR, UNLESS NOTED OTHERWISE.
2. WALLS THAT DO NOT LAY OUT IN FULL OR HALF INCHES SHALL BE NOTED AS SUCH. WALLS NOT TO HAVE RECES LESS THAN 4" EXPOSED.
3. INTERIOR MASONRY WALLS THAT RUN UP TO THE CEILING SHALL BE NOTED AS SUCH. WALLS NOT TO HAVE RECES LESS THAN 4" EXPOSED.
4. SEE DETAILS ON SHEET A1.31 FOR TYPICAL MASONRY CONTROL JOINTS AND EXPANSION JOINTS.
5. SINGLE WYTHE MASONRY WALLS ARE INDICATED AT NOMINAL DIMENSIONS.
6. EXPOSED CONCRETE MASONRY UNITS (CMU) CORNERS ARE TO BE CONSTRUCTED USING UNITS WITH A 1" RADIUS TO LOCKERS. USE BUILDING CORNER UP TO UNDERSIDE OF CEILING OR BULKHEAD PLANE, ABOVE THIS PLANE USE CMU W/O BULKHEAD CORNER.
7. FINISH FLOOR ELEVATION INDICATED FOR THE BUILDING IS 100'-0". REFER TO THE SITE PLAN FOR CORRELATION TO USGS DATUM.
8. SEE SHEET A7.28 FOR MOUNTING HEIGHTS.
9. INTERIOR AND EXTERIOR CMU WALLS ARE TO BE CONSTRUCTED USING UNITS WITH A 1" RADIUS TO LOCKERS. USE BUILDING CORNER UP TO UNDERSIDE OF CEILING OR BULKHEAD PLANE, ABOVE THIS PLANE USE CMU W/O BULKHEAD CORNER.
10. ALL DIMENSIONS INDICATED ARE NOMINAL. METAL STUD WALLS ARE DIMENSIONED TO FACE OF STUD. REFER TO INDICATED PLAN DETAILS OR SECTIONS FOR ACTUAL DIMENSIONS, WHERE INDICATED.
11. UNLESS OTHERWISE NOTED, THE WALL LENGTH FROM SIDE OF DOOR FRAMES TO THE REARFACE INTERSECTING WALL IS TO BE FOUR INCHES (4").
12. REFER TO SHEET A1.3 FOR WALL TYPES.
13. GENERAL NOTE: BUILDING DIMENSIONS ARE TO FACE OF BRICK.
14. GENERAL NOTE: FINISH FLOOR ELEVATION = 100'-0" FOR THE FIRST FLOOR AND 114'-6" FOR THE SECOND FLOOR UNLESS OTHERWISE NOTED.

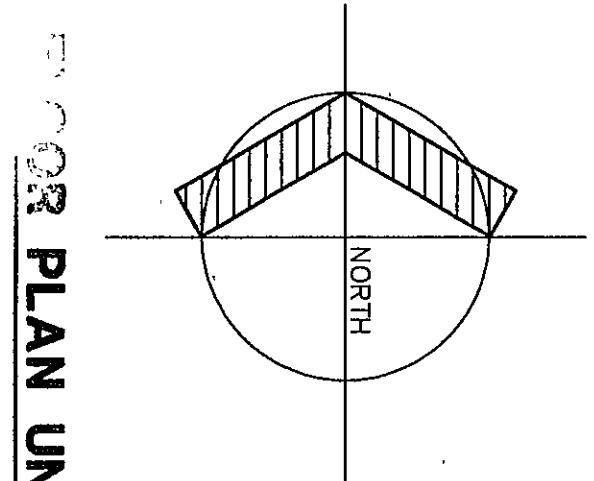

**FLOOR PLAN UNIT H**

1/8" = 1'-0"

97-A-17


CHESTERTON HIGH SCHOOL  
55807.00

**FLOOR PLAN UNIT H**


DRAWN BY: LEC COMM. NO: 95067.00  
CHECKED BY: JHJ DATE: APRIL 21, 1997

**A1.15**

REVISIONS NO. DATE

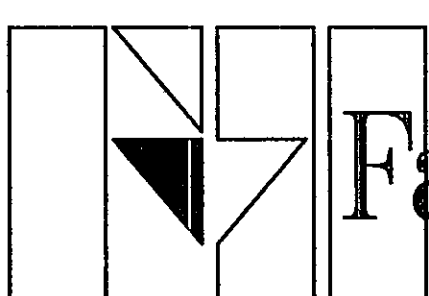

**Fanning/Howey Associates, Inc.**  
Architects Engineers Consultants

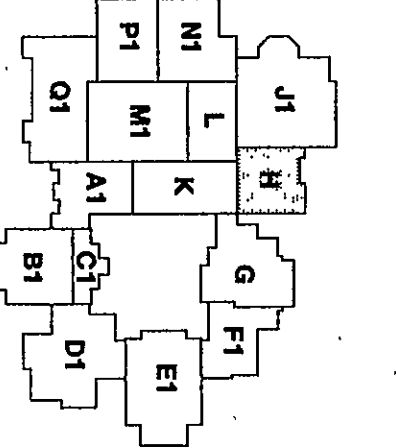

**THE NEW CHESTERTON HIGH SCHOOL FOR THE DUNELAND SCHOOL CORPORATION CHESTERTON, INDIANA**

COPYRIGHT 1997 BY FANNING/HOWEY ASSOCIATES, INC.

