
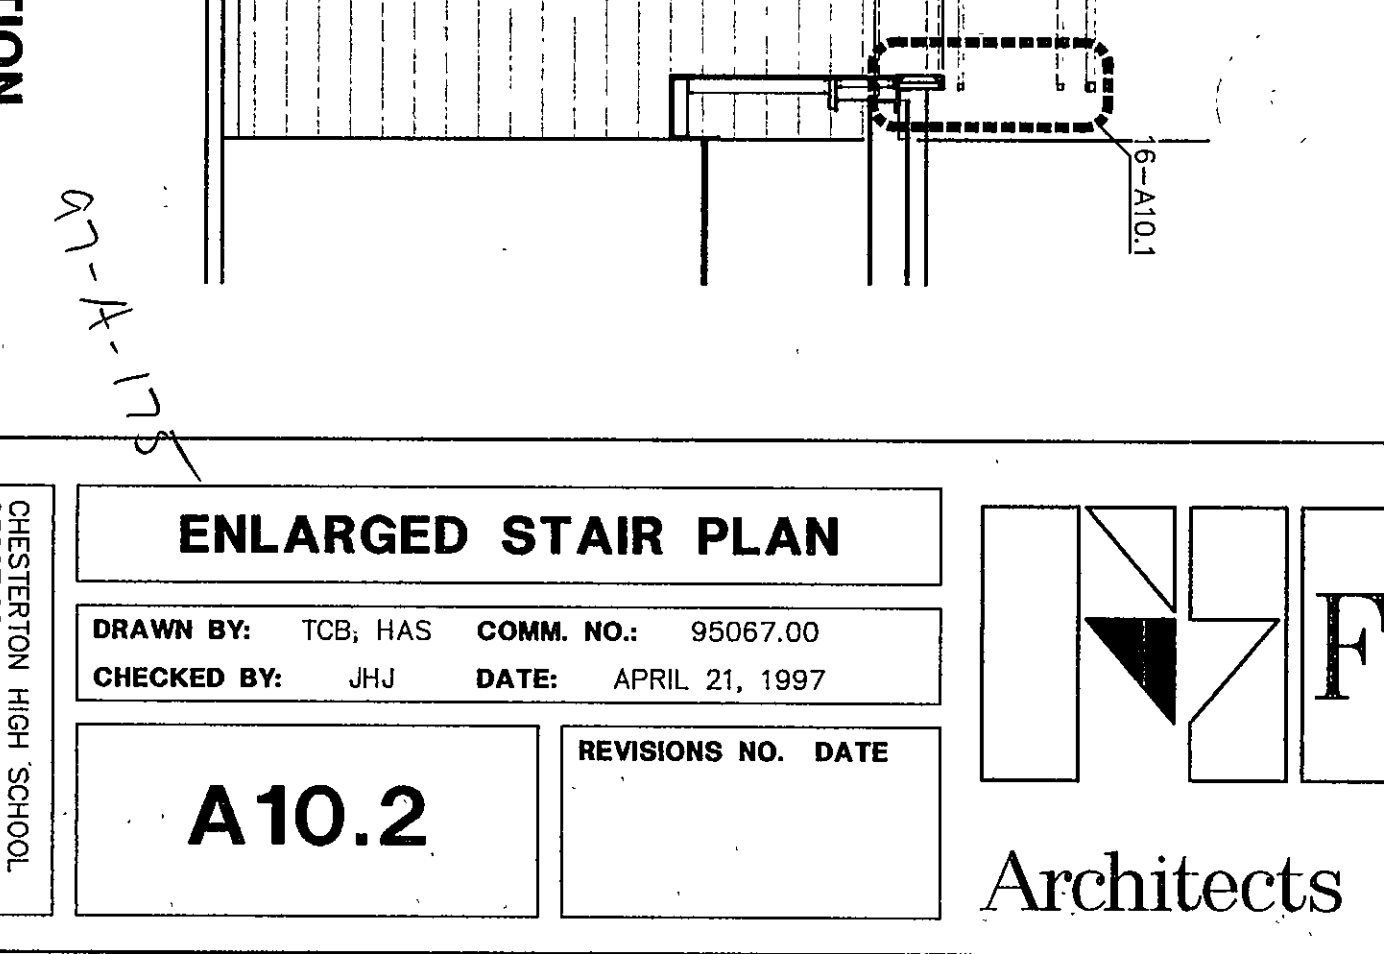
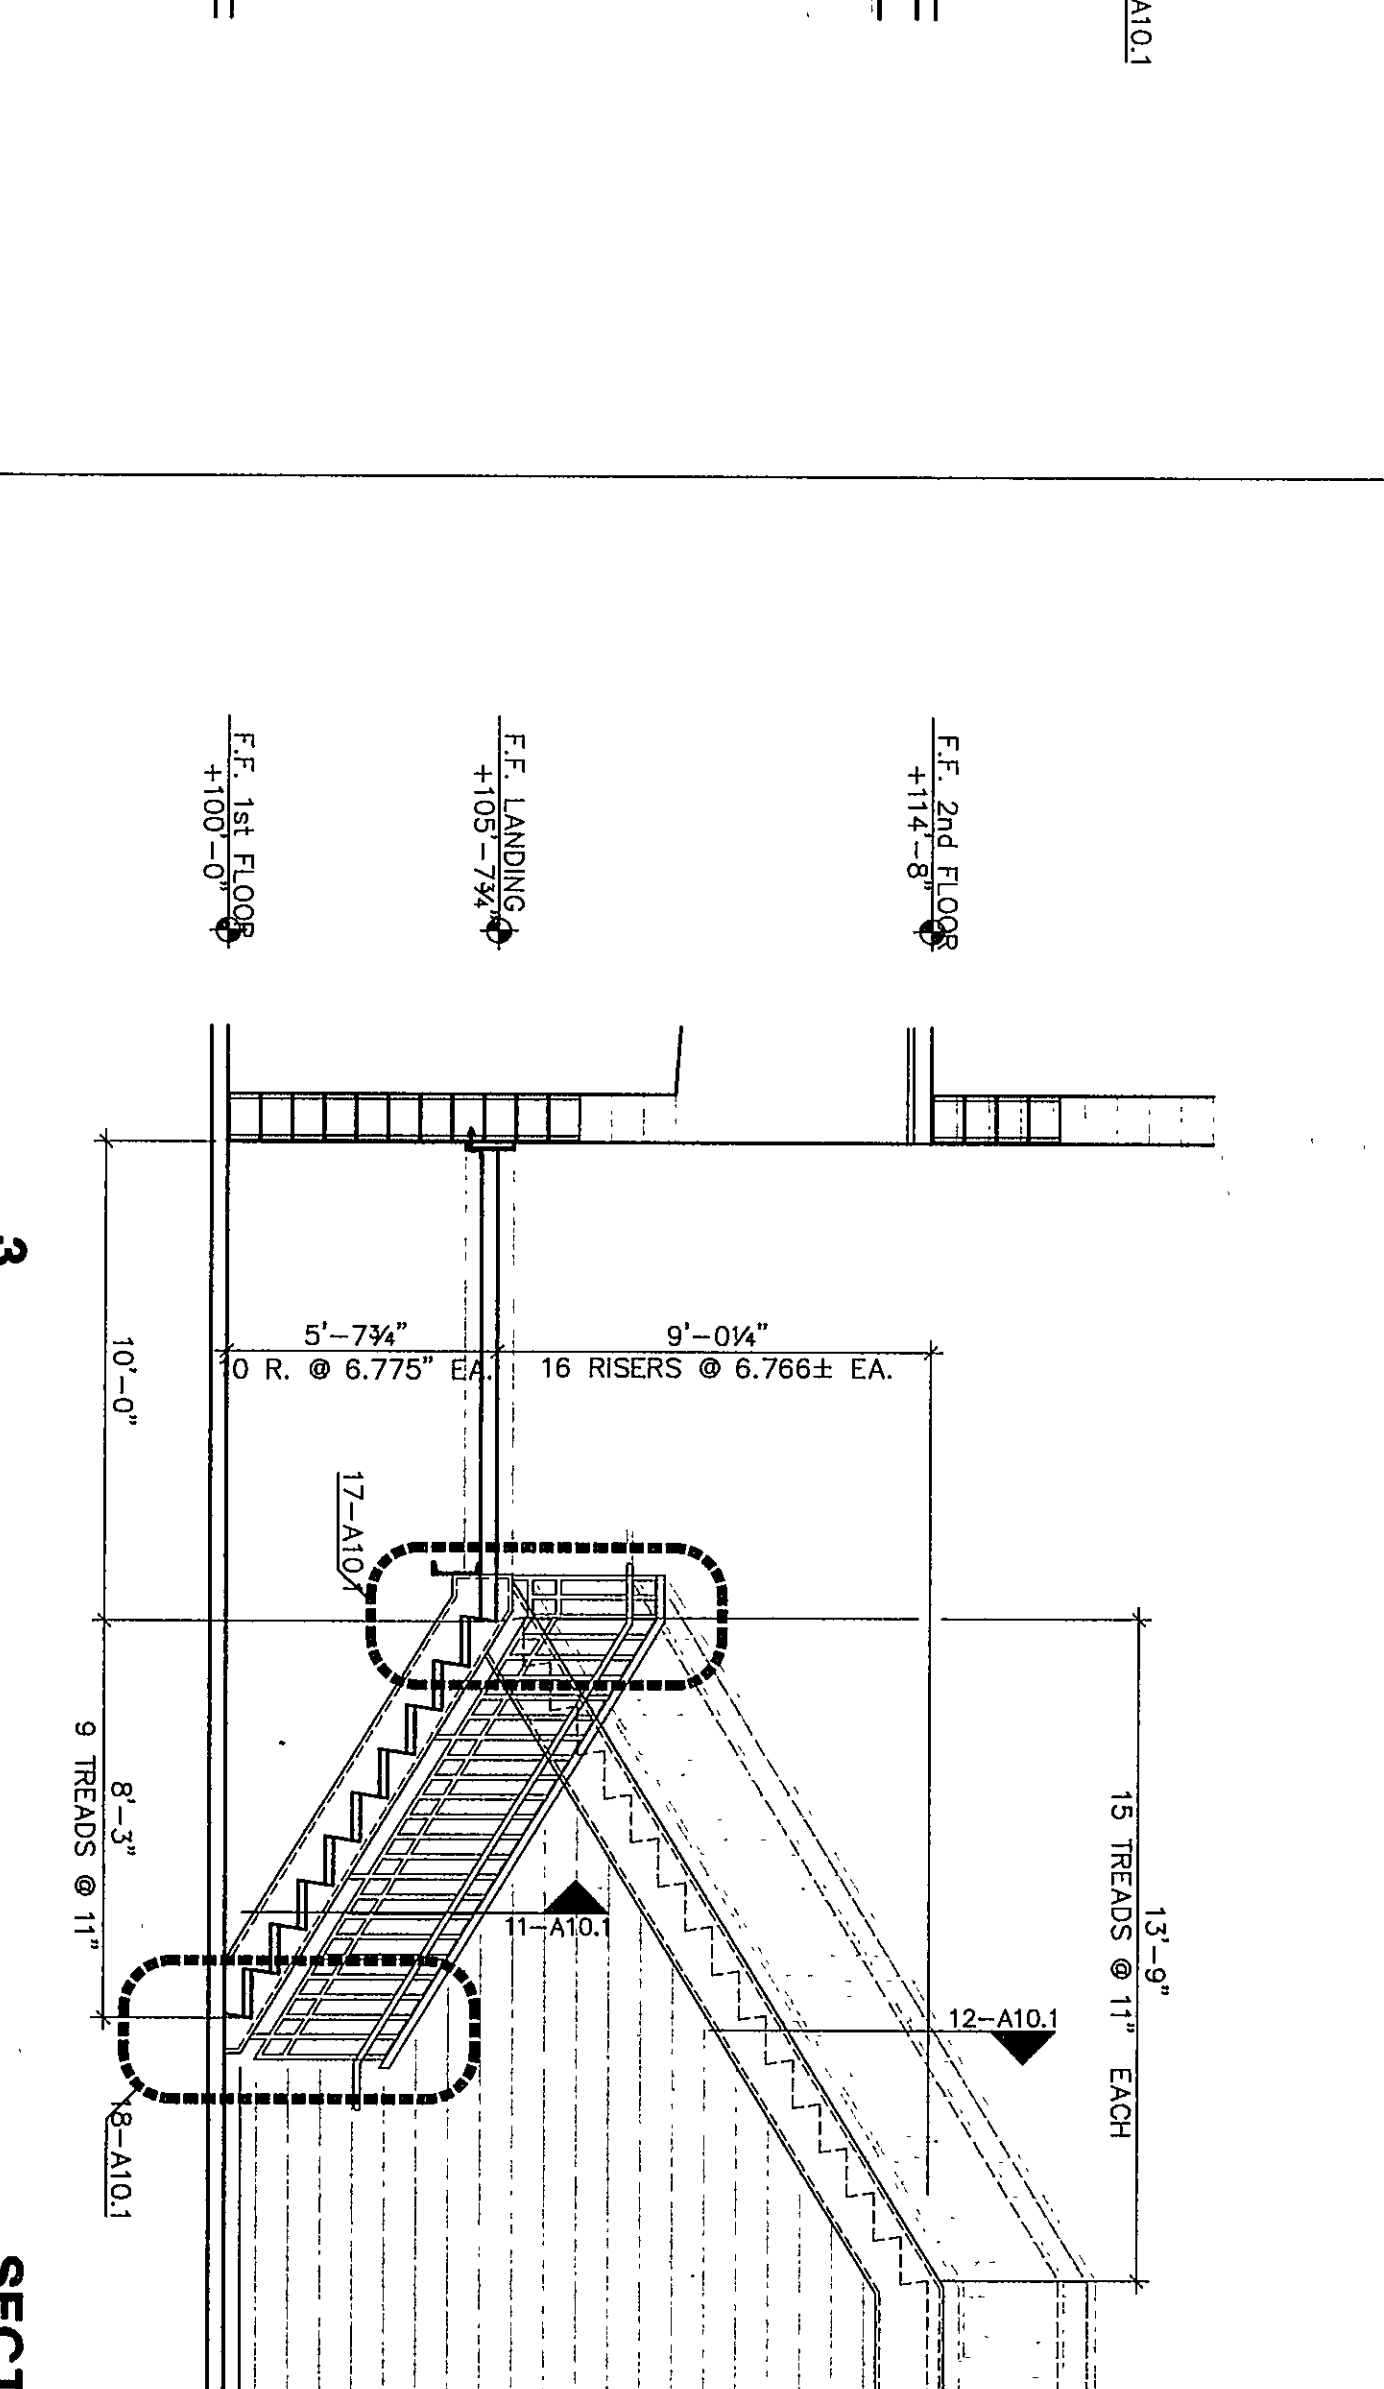
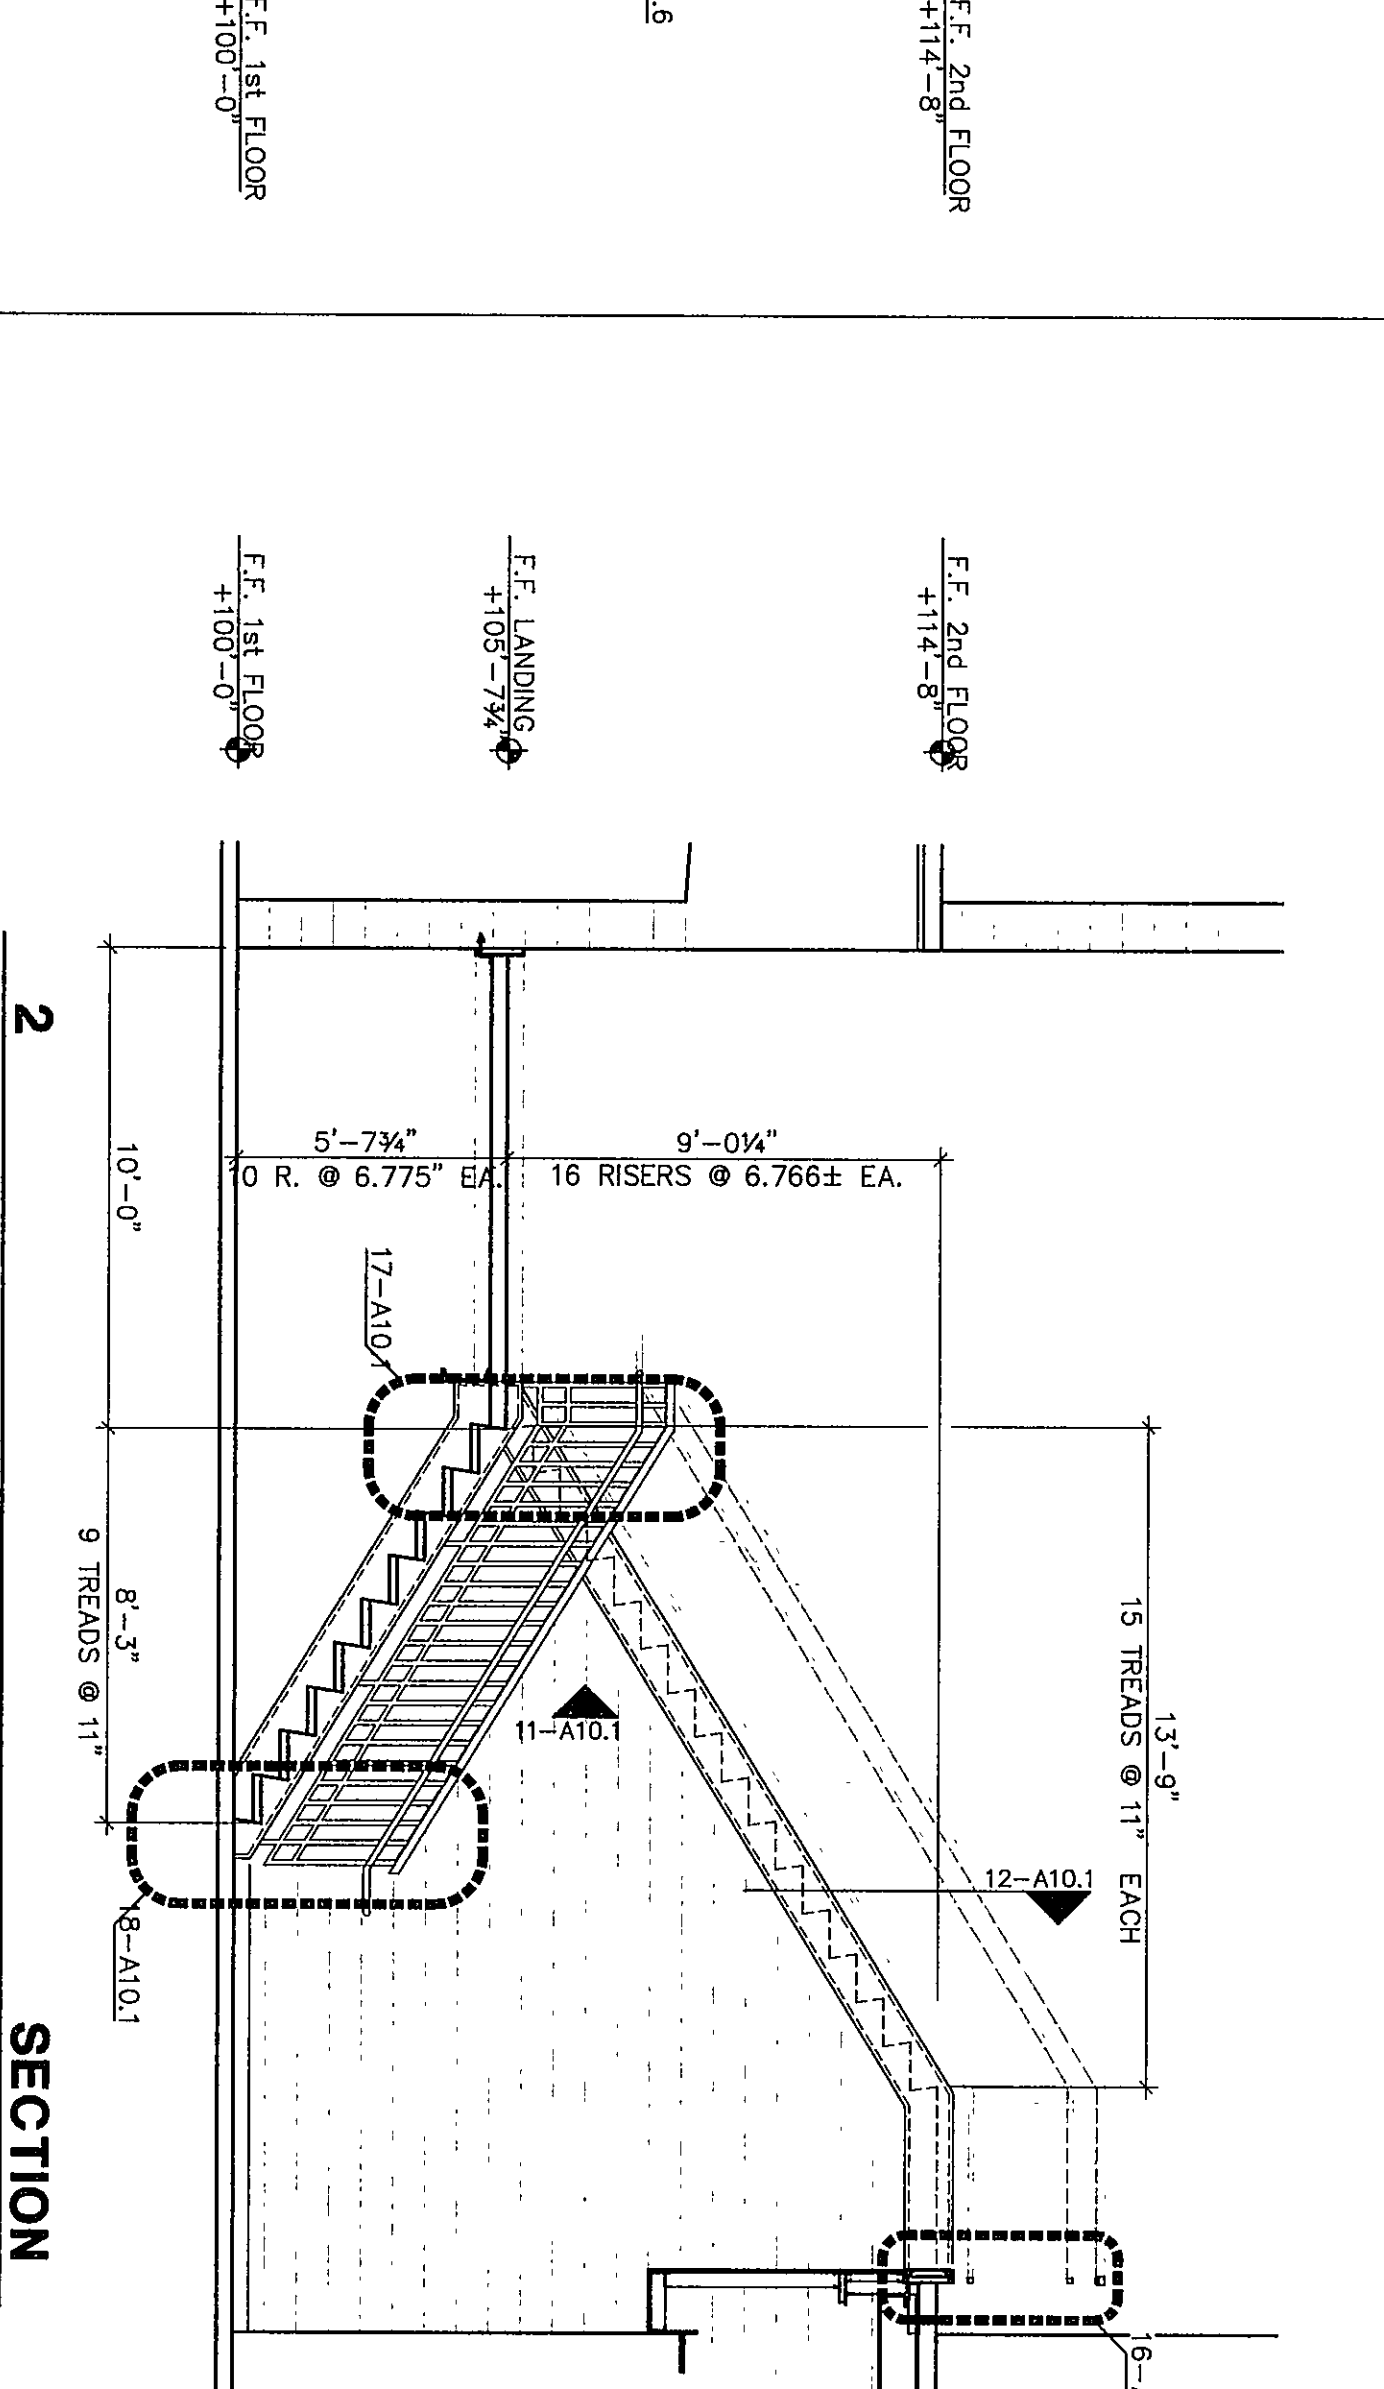
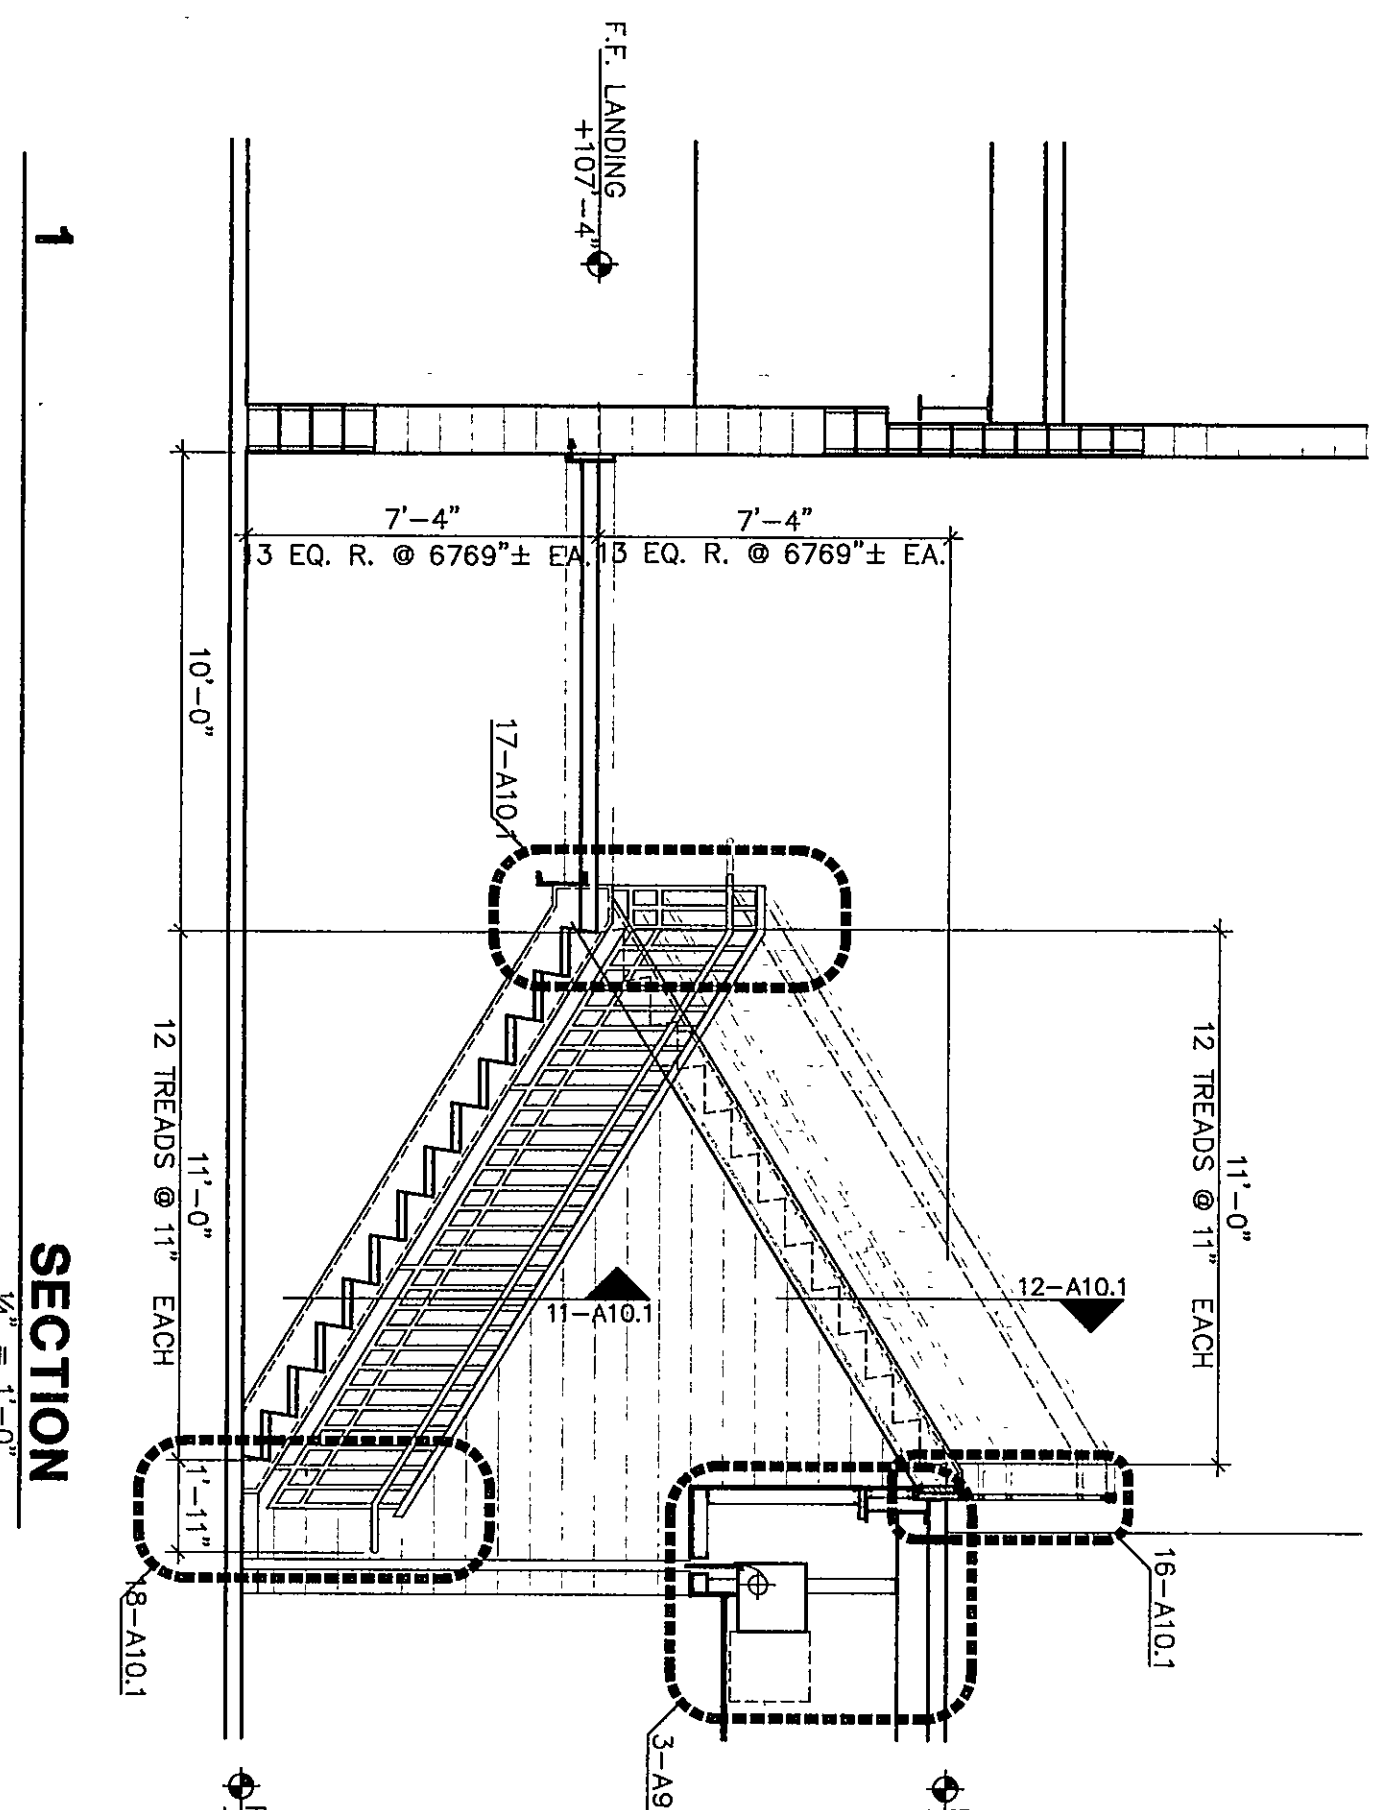
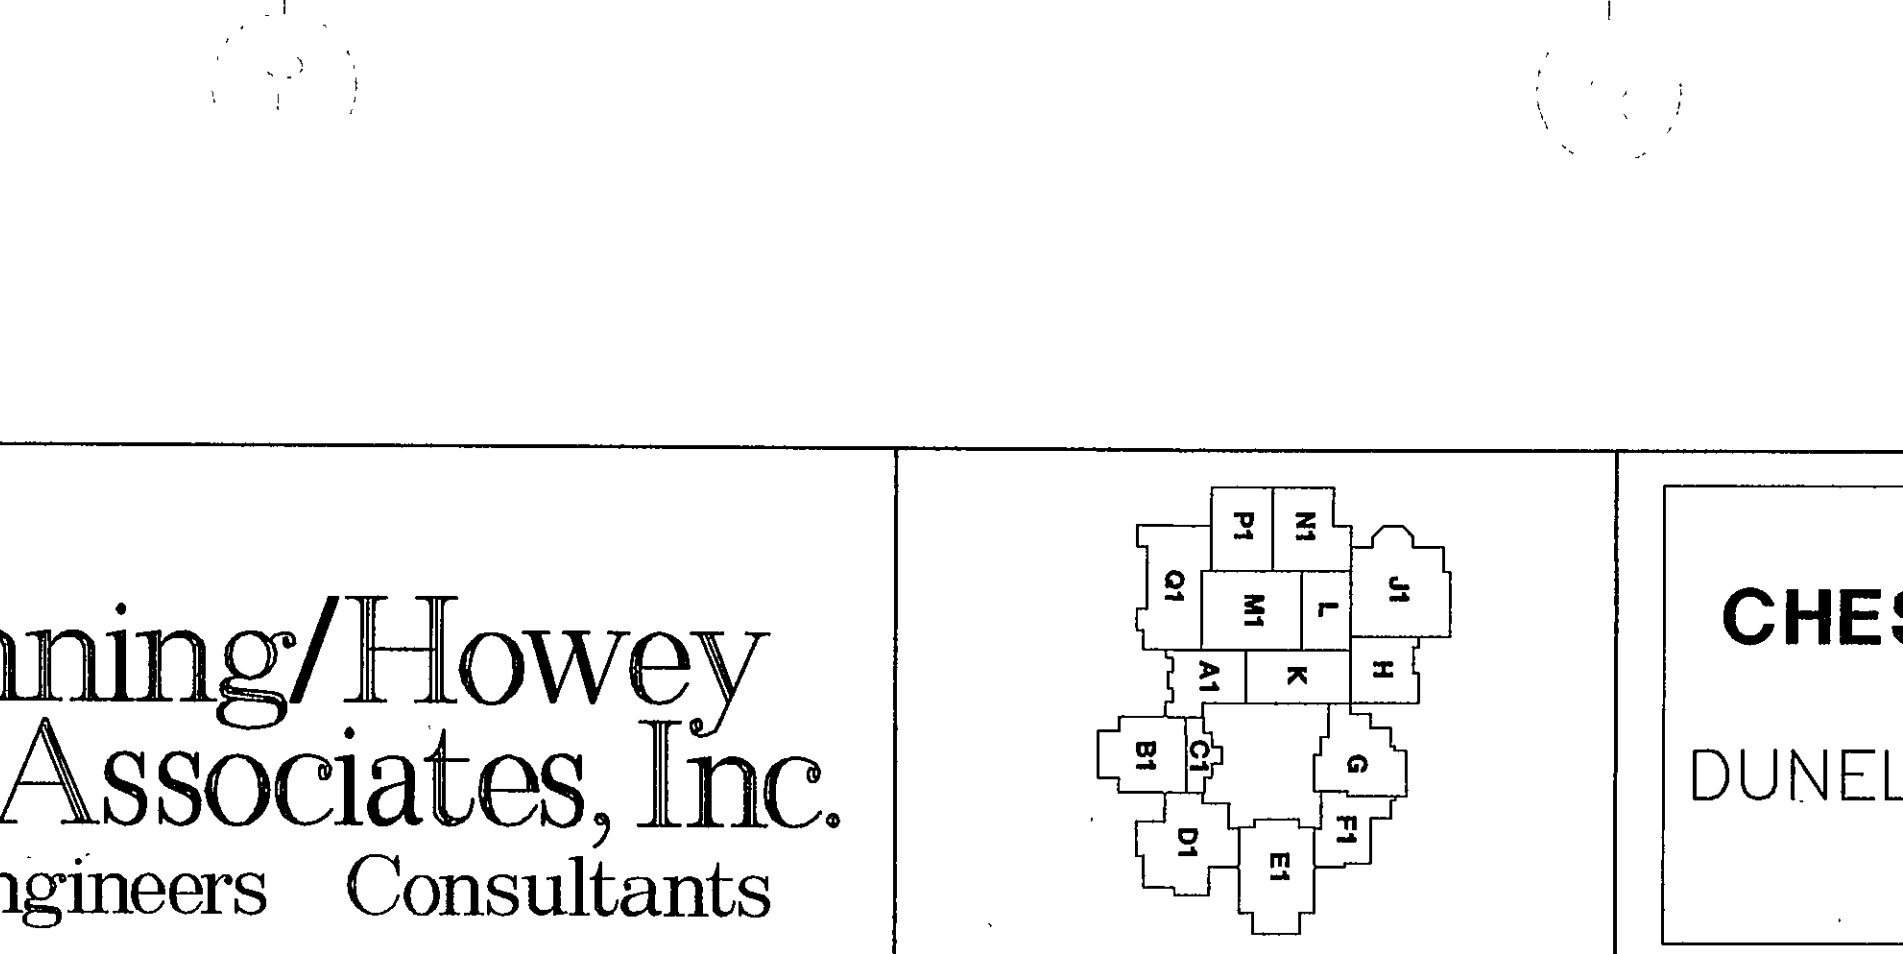
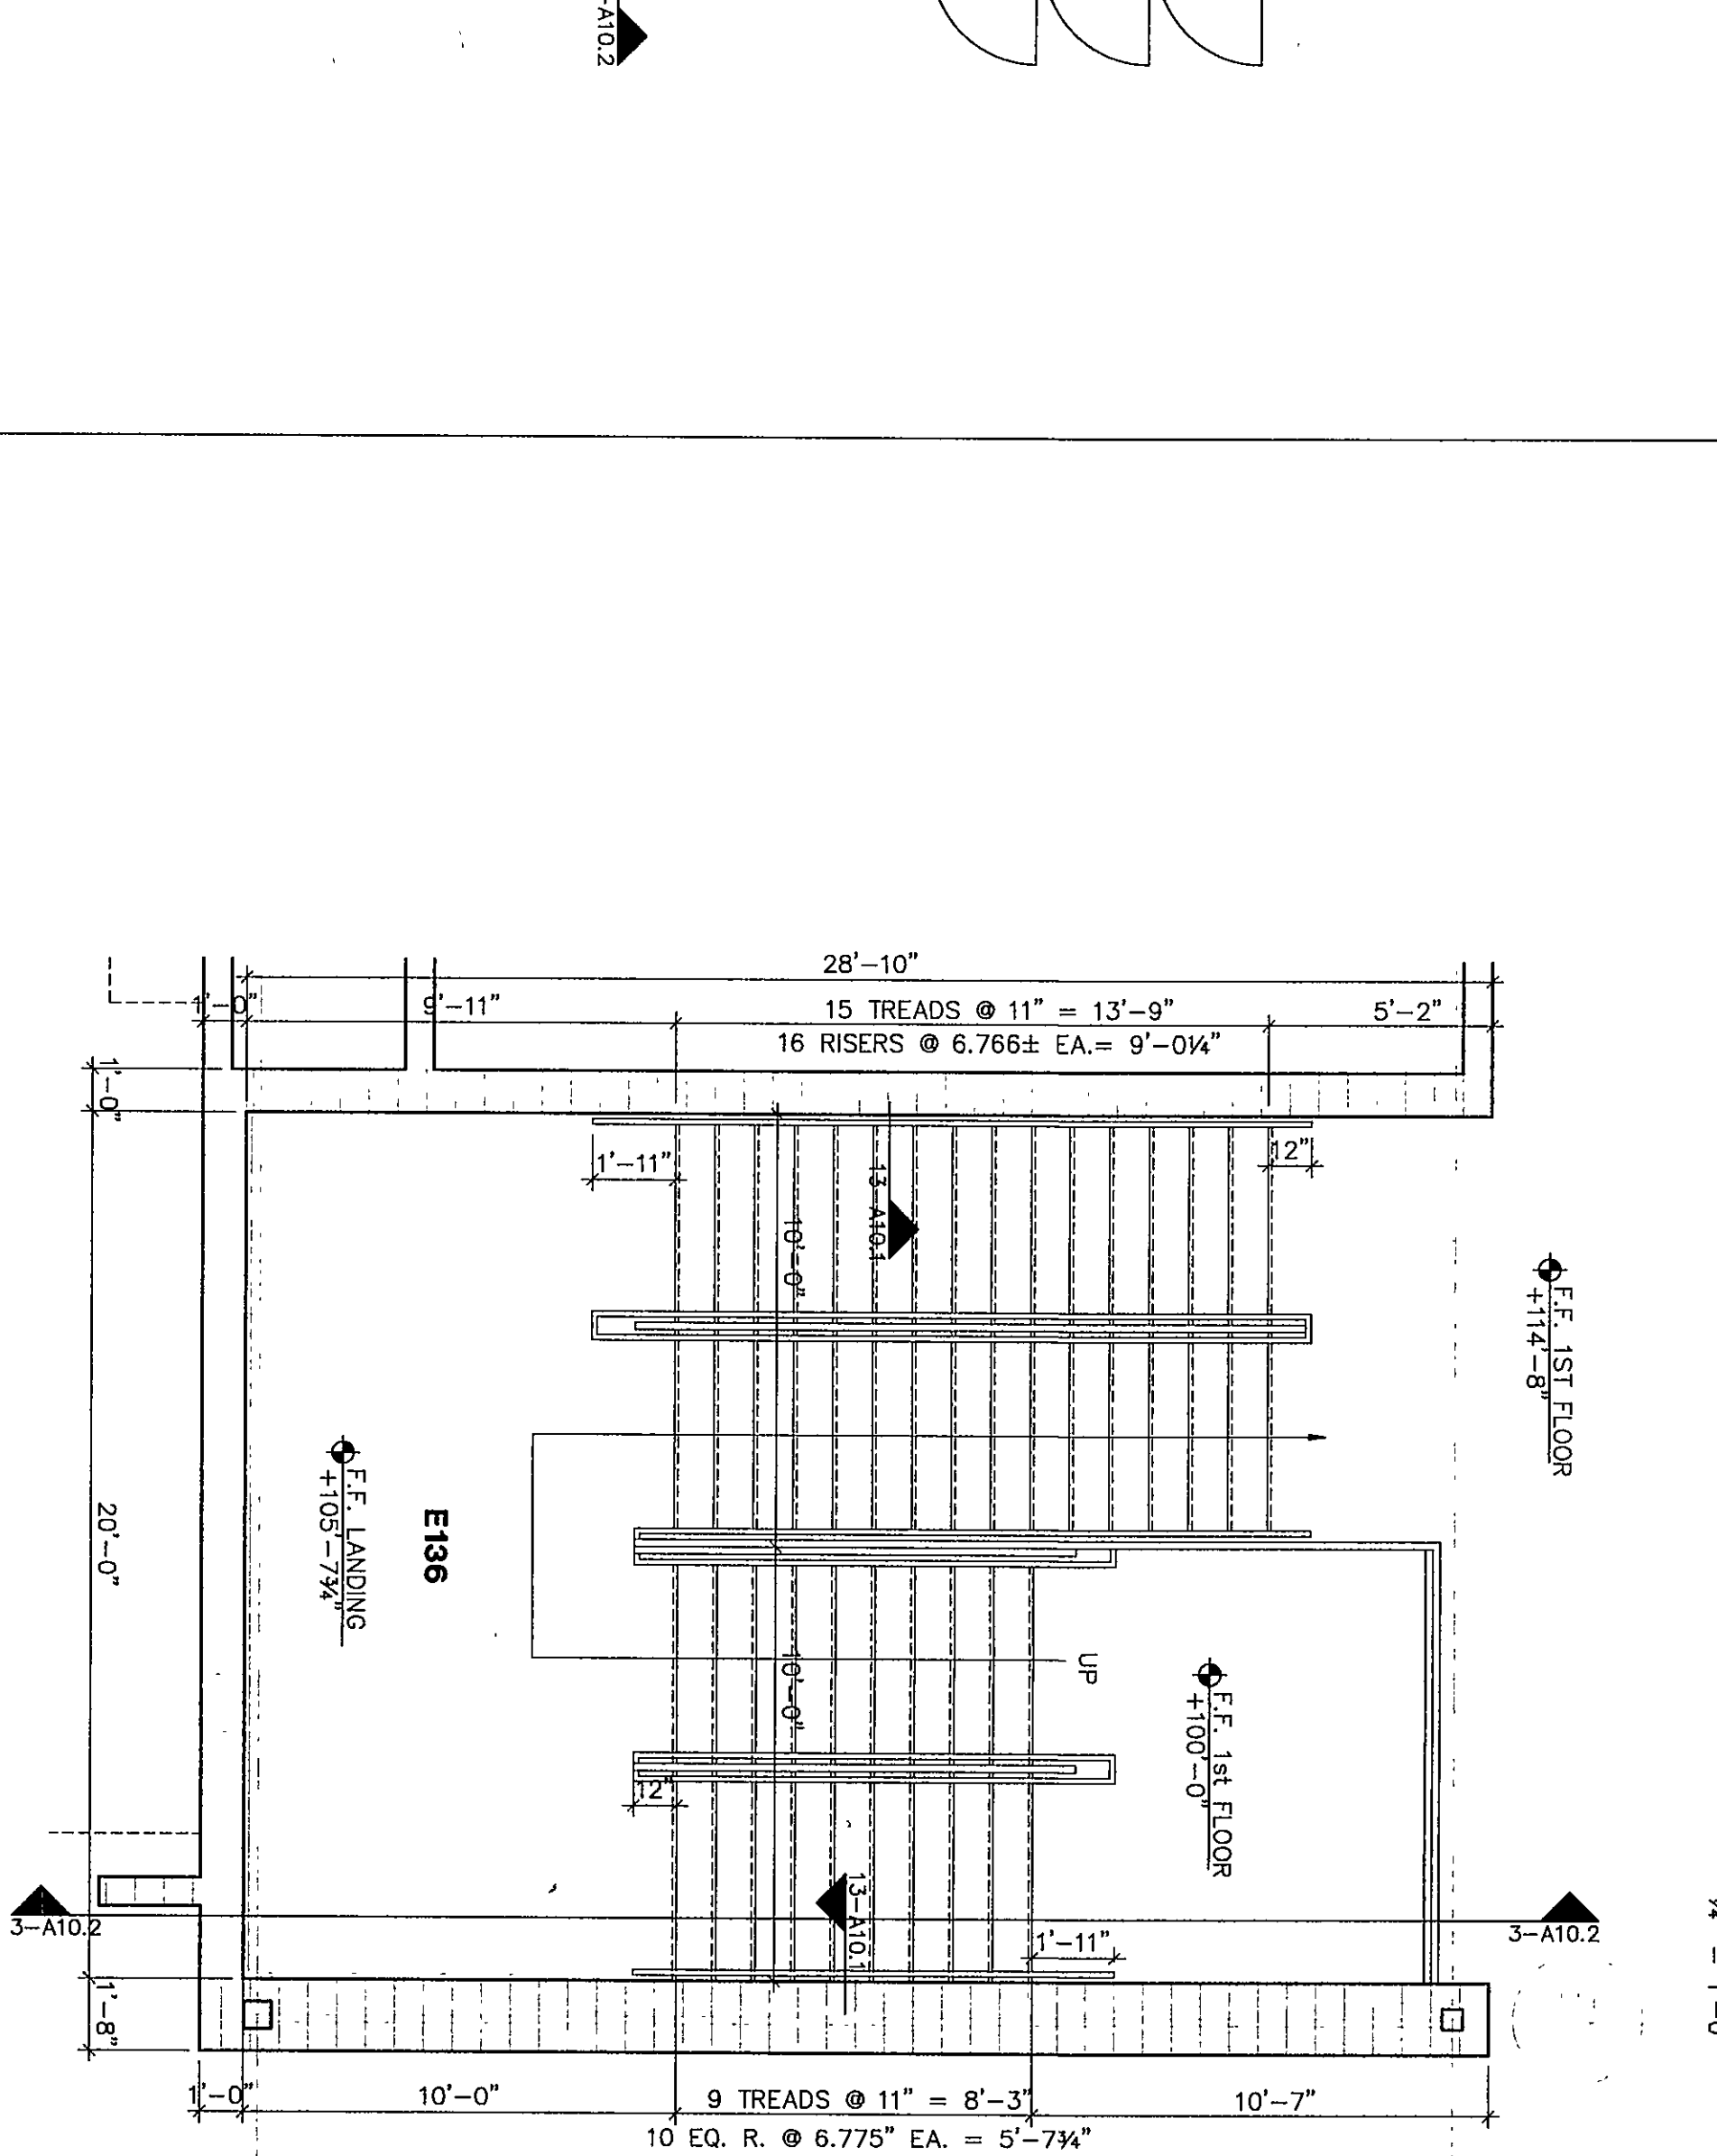
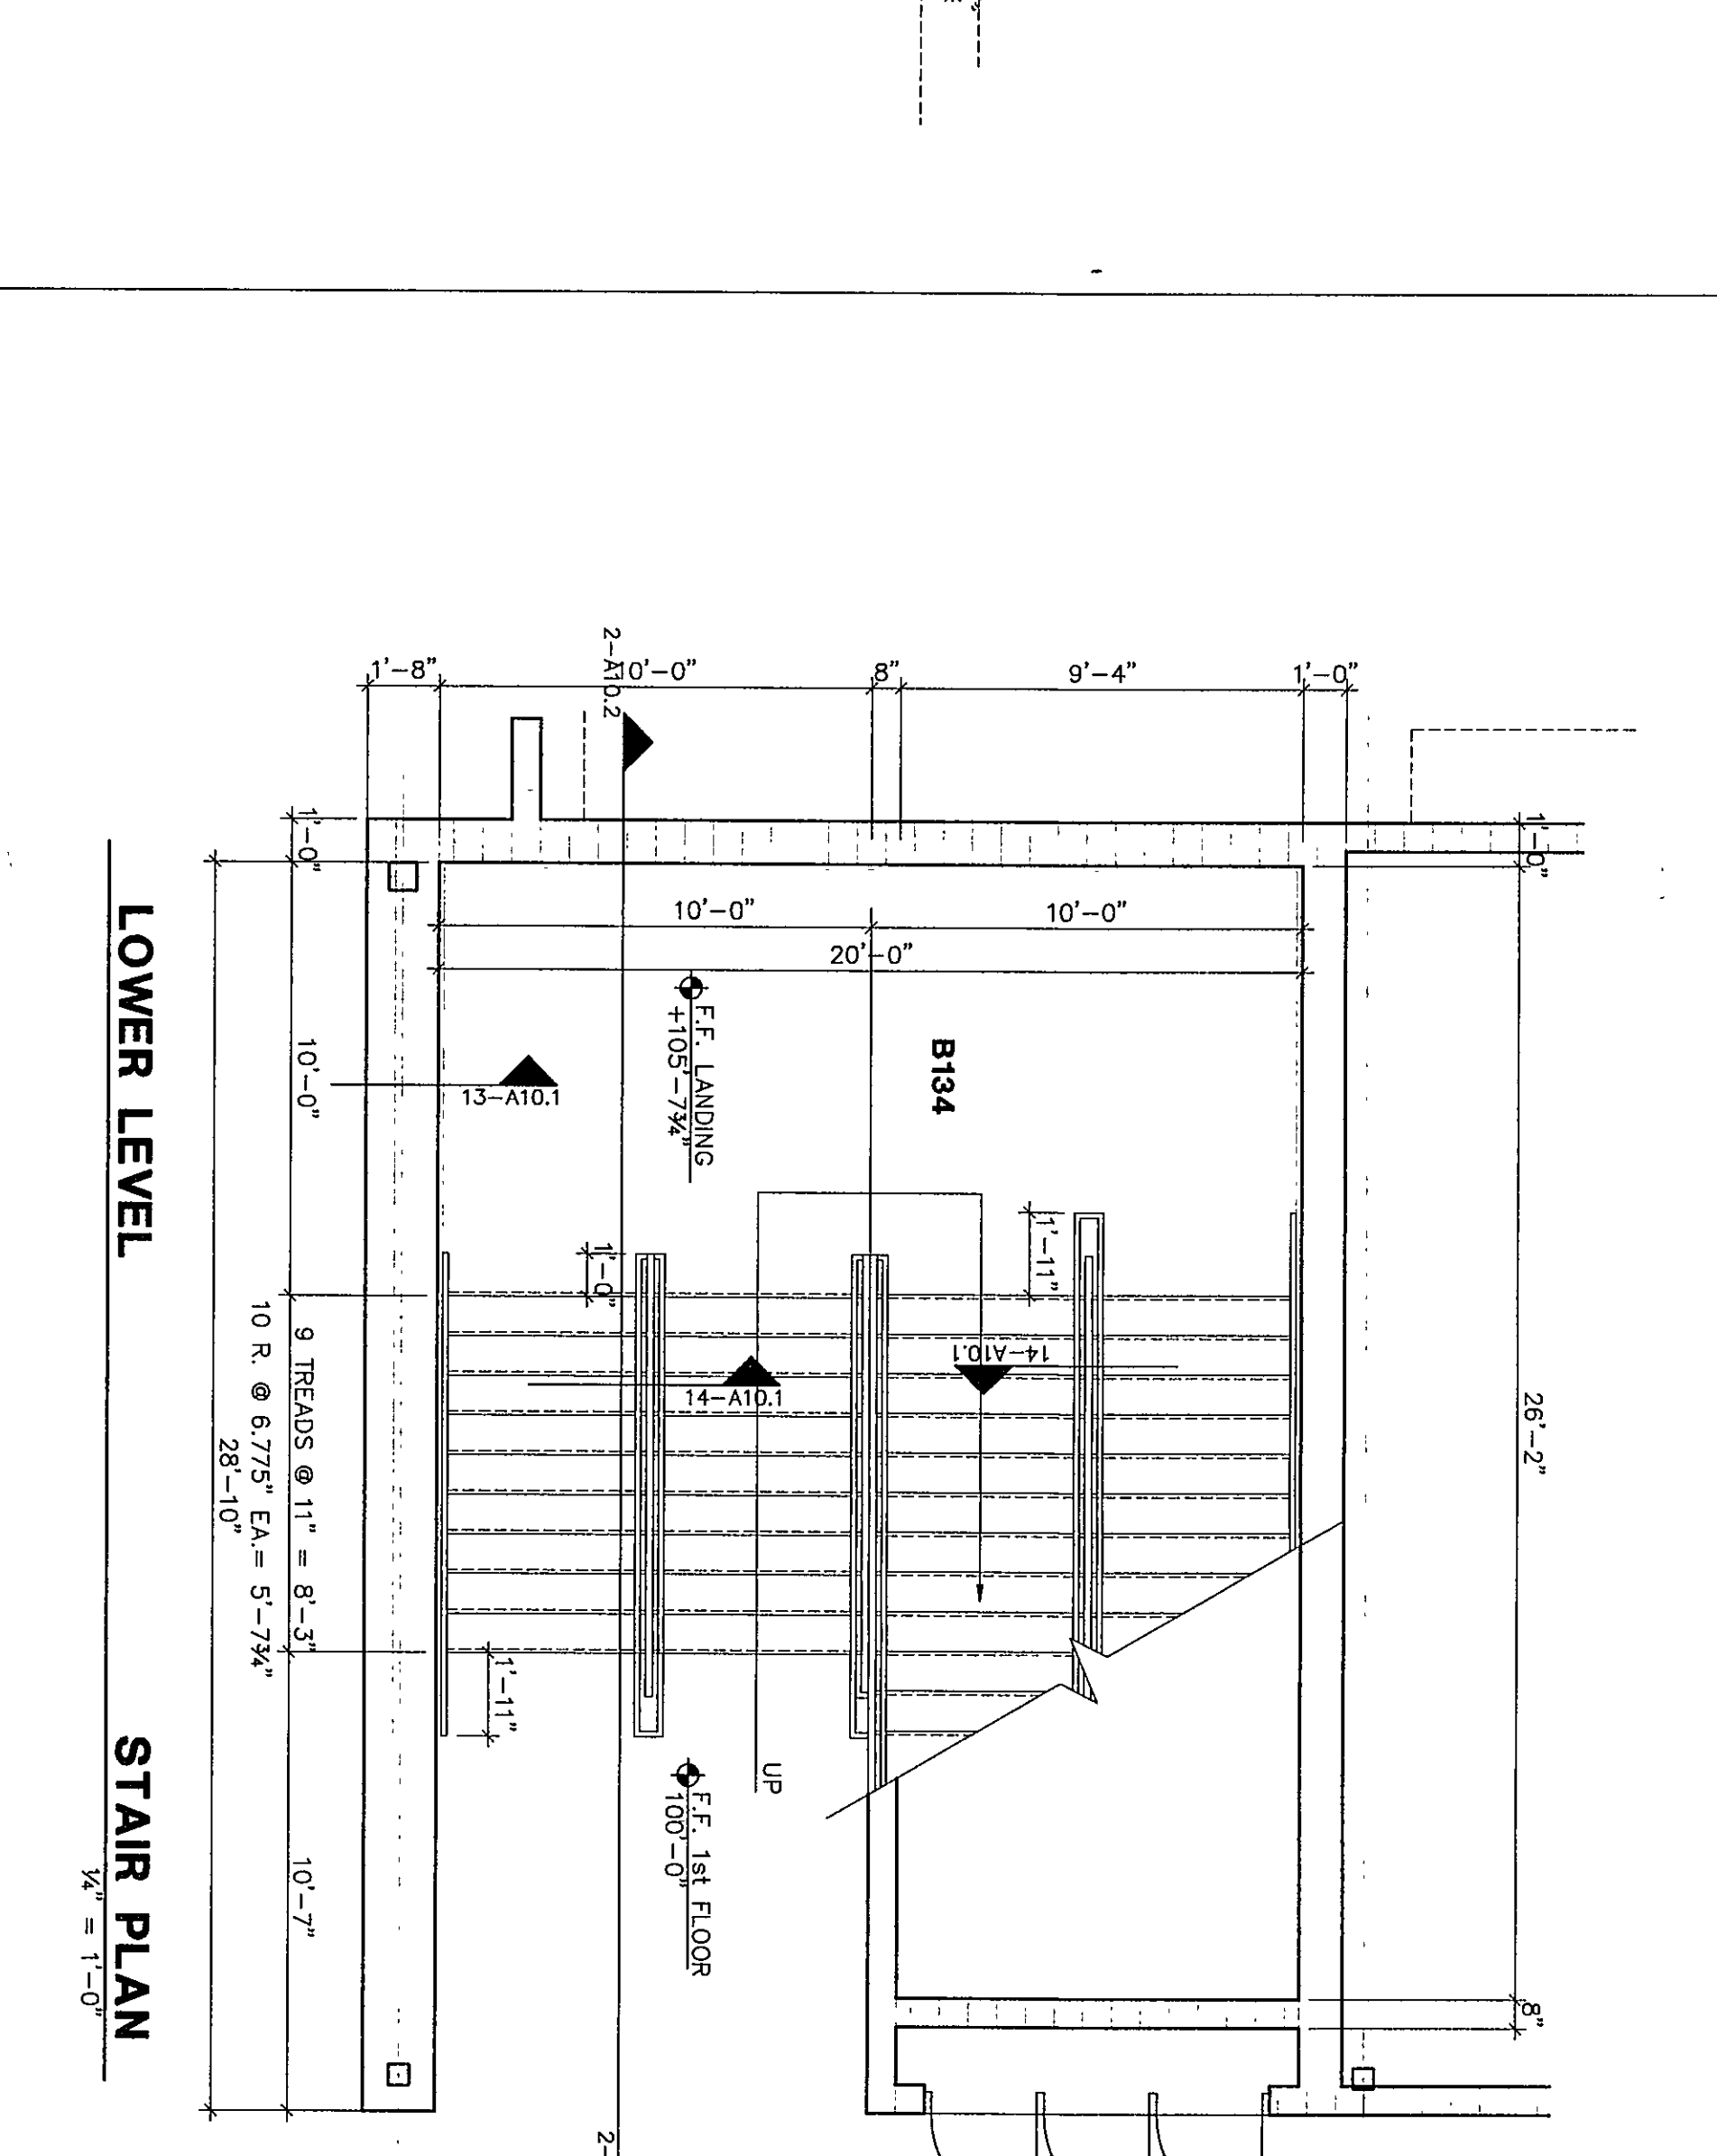
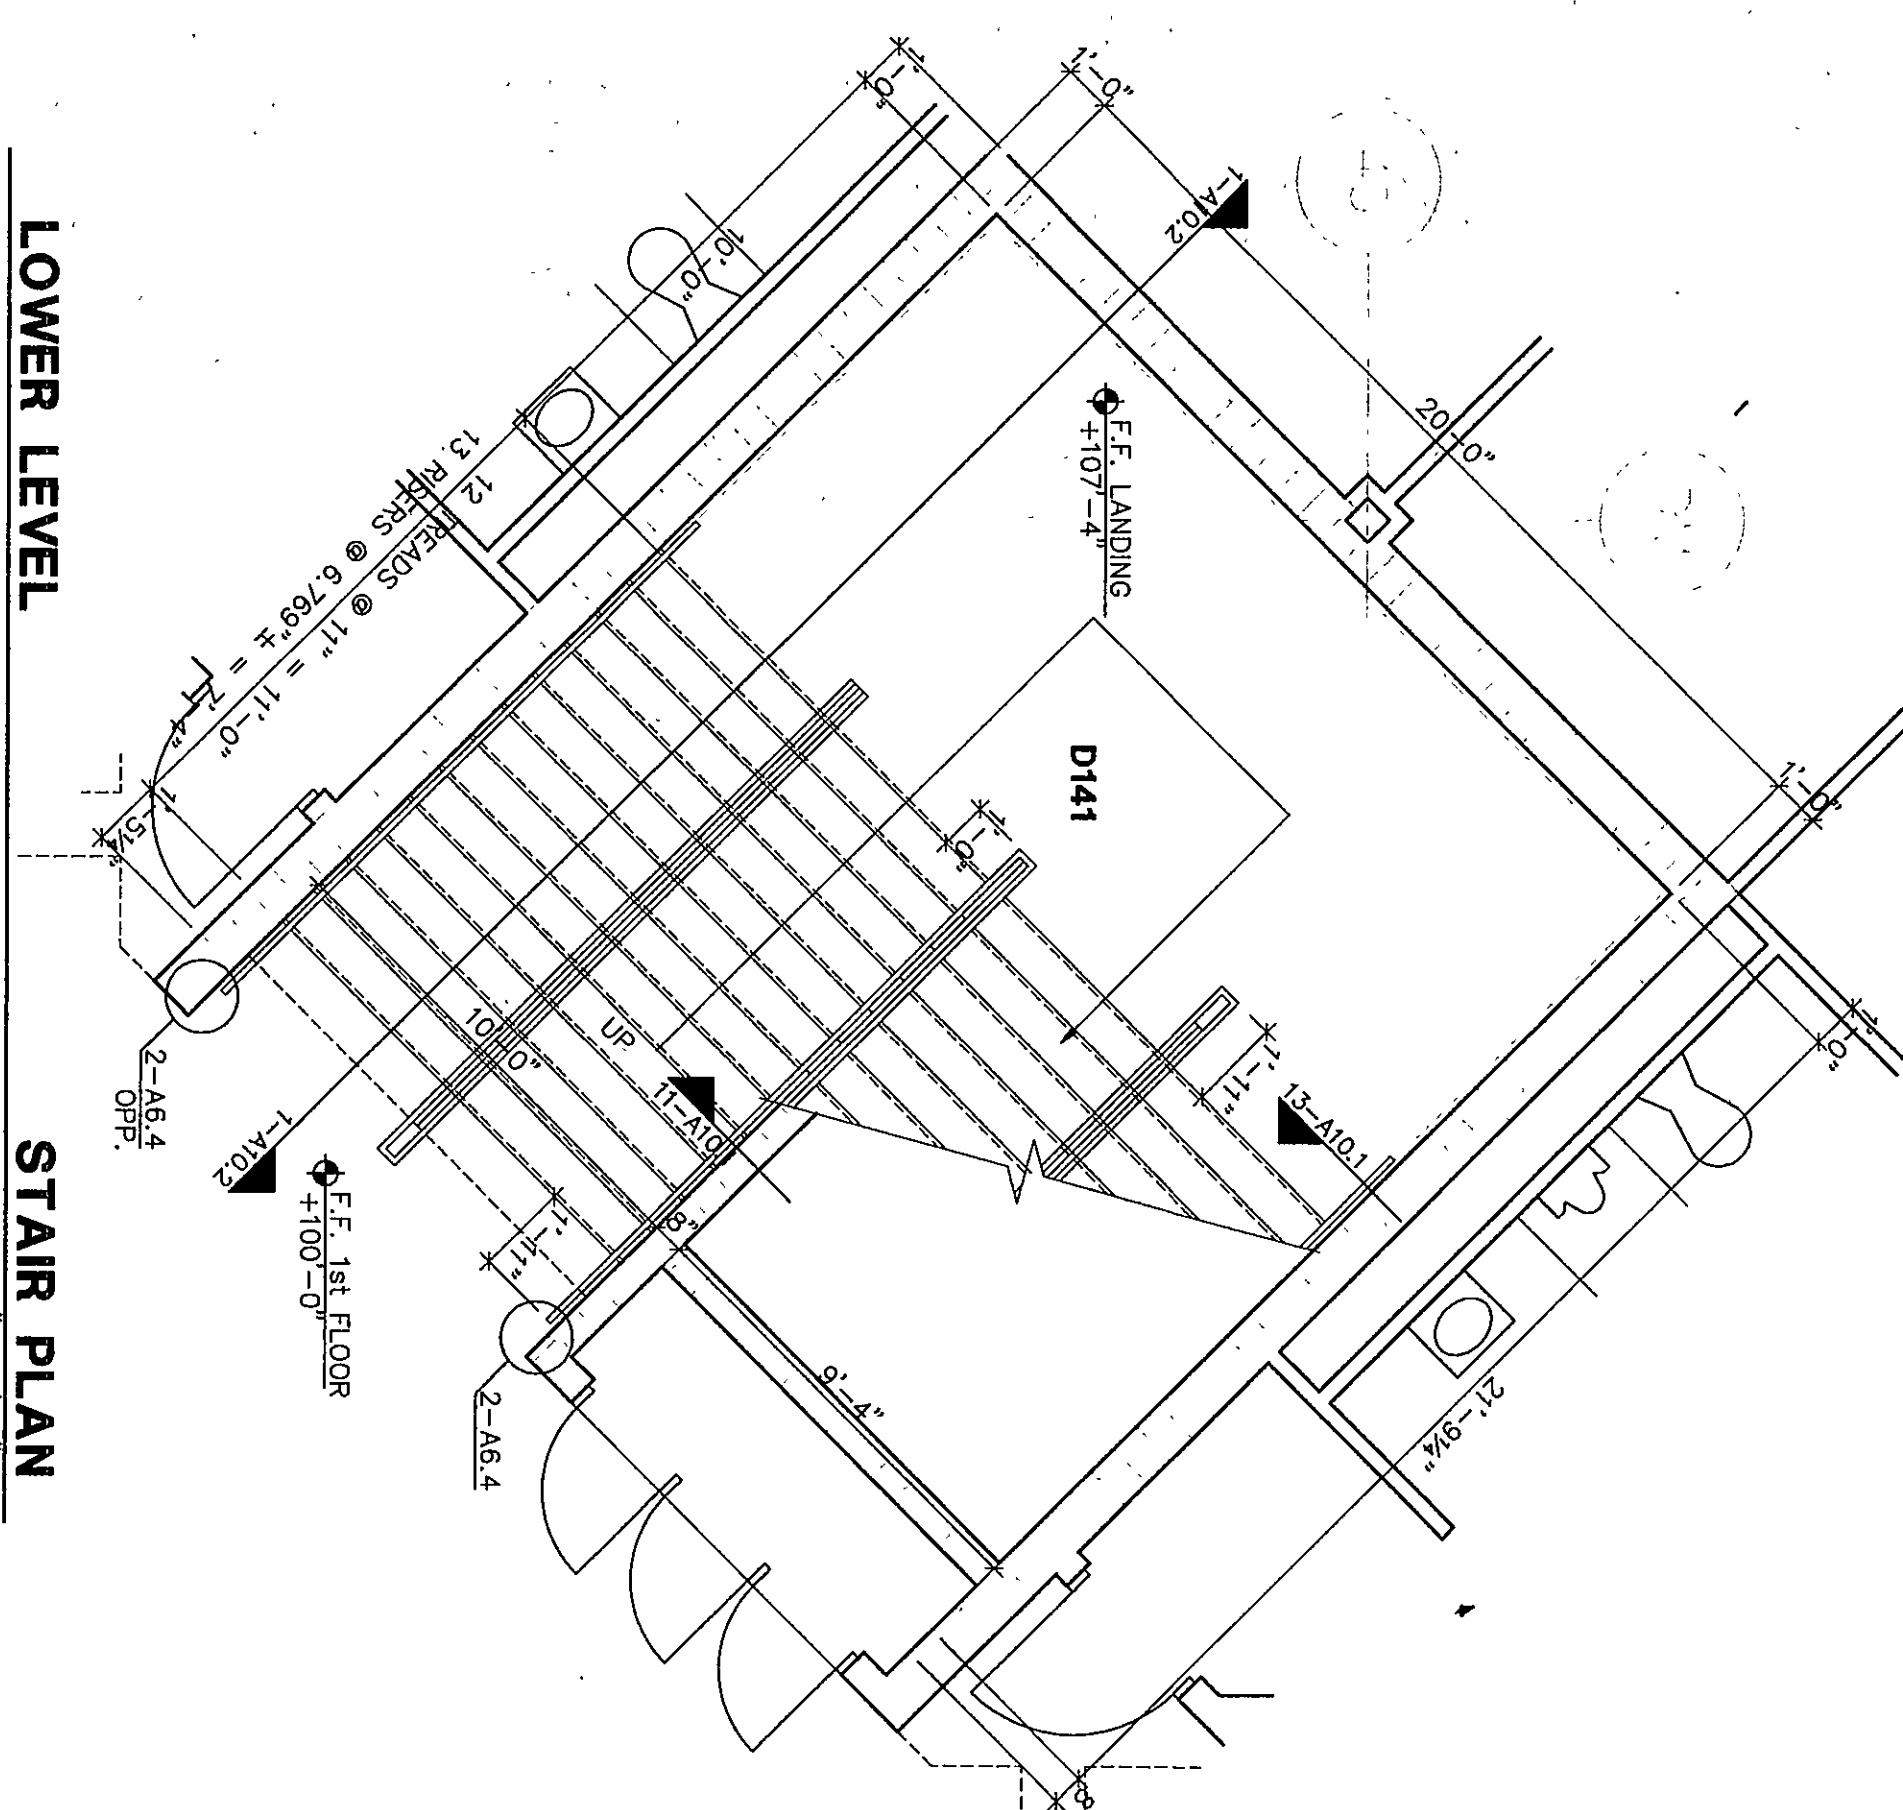
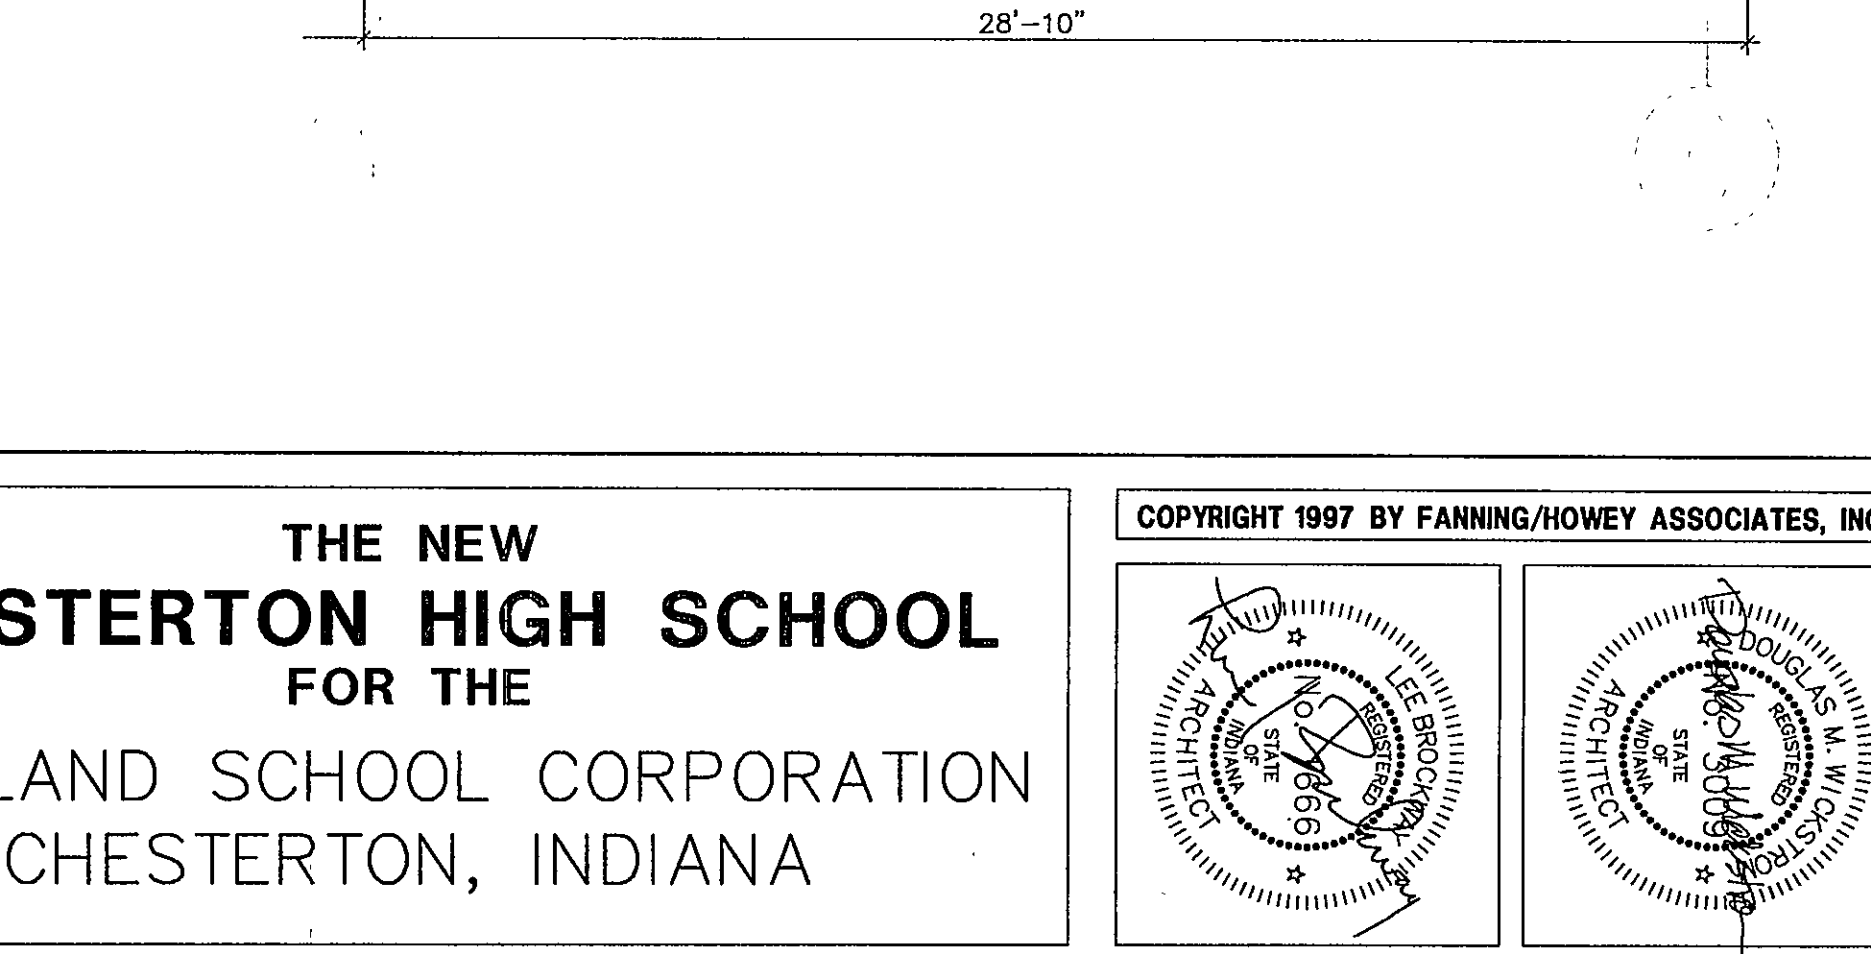
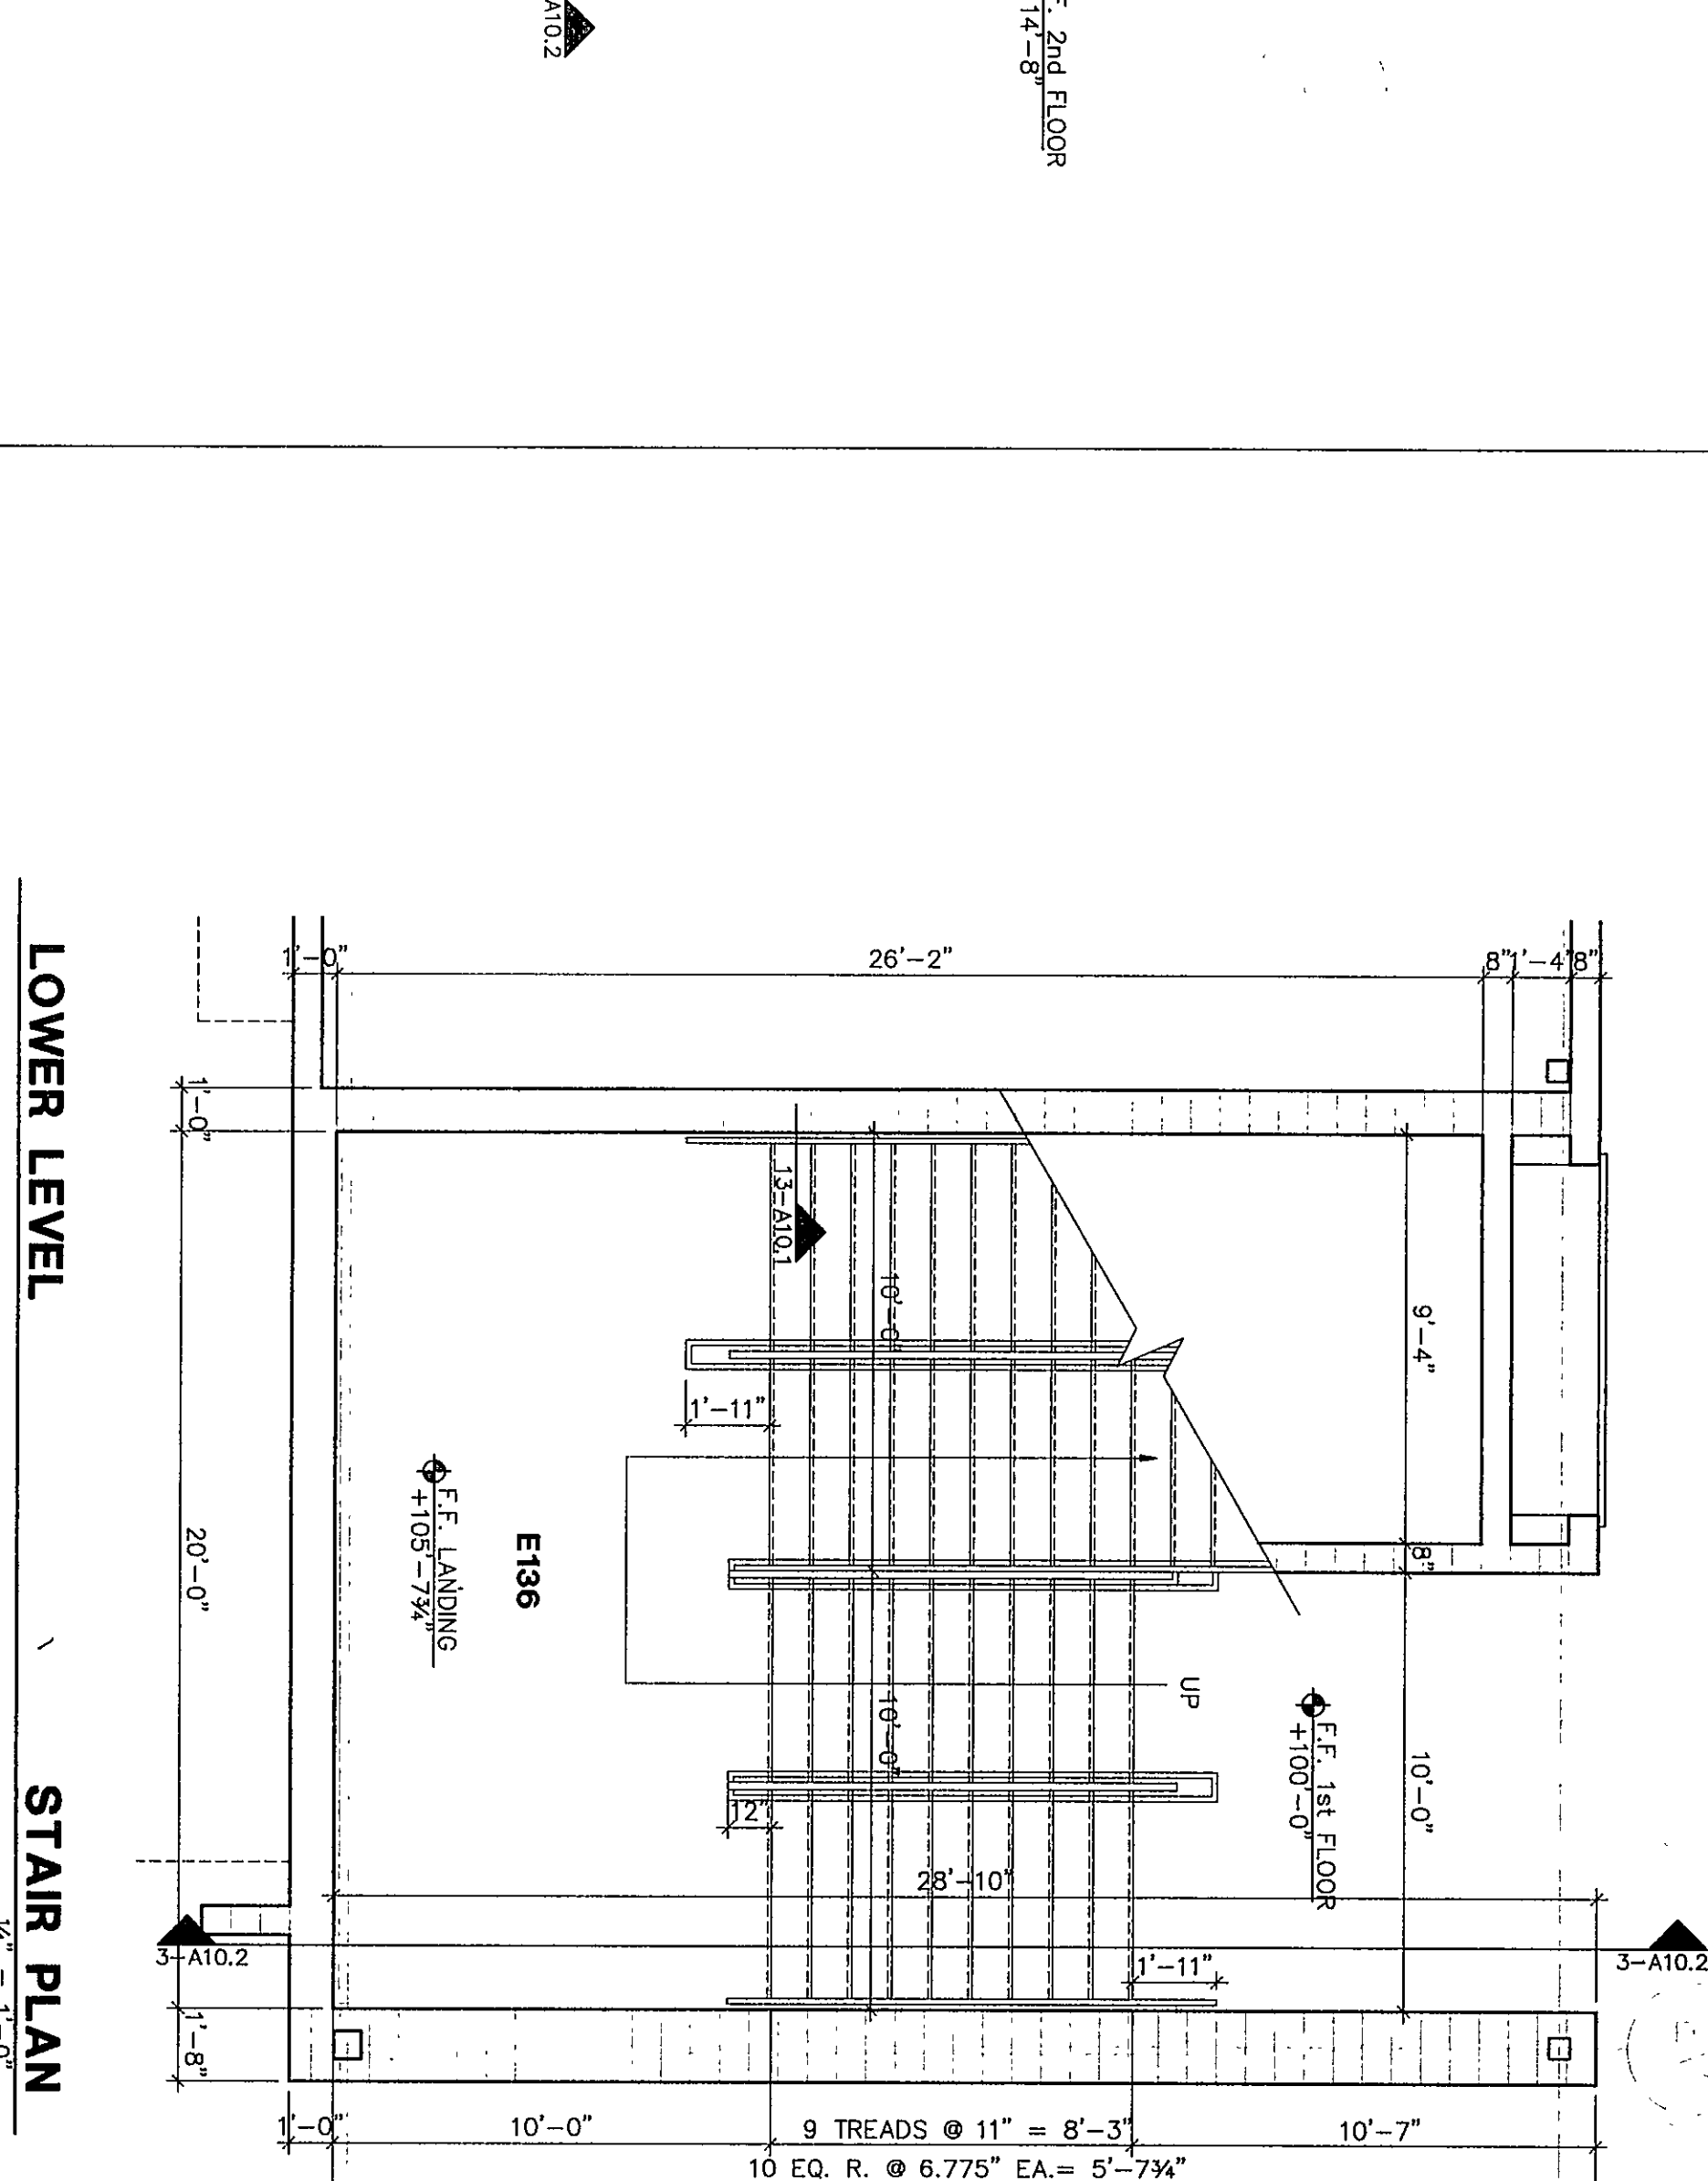
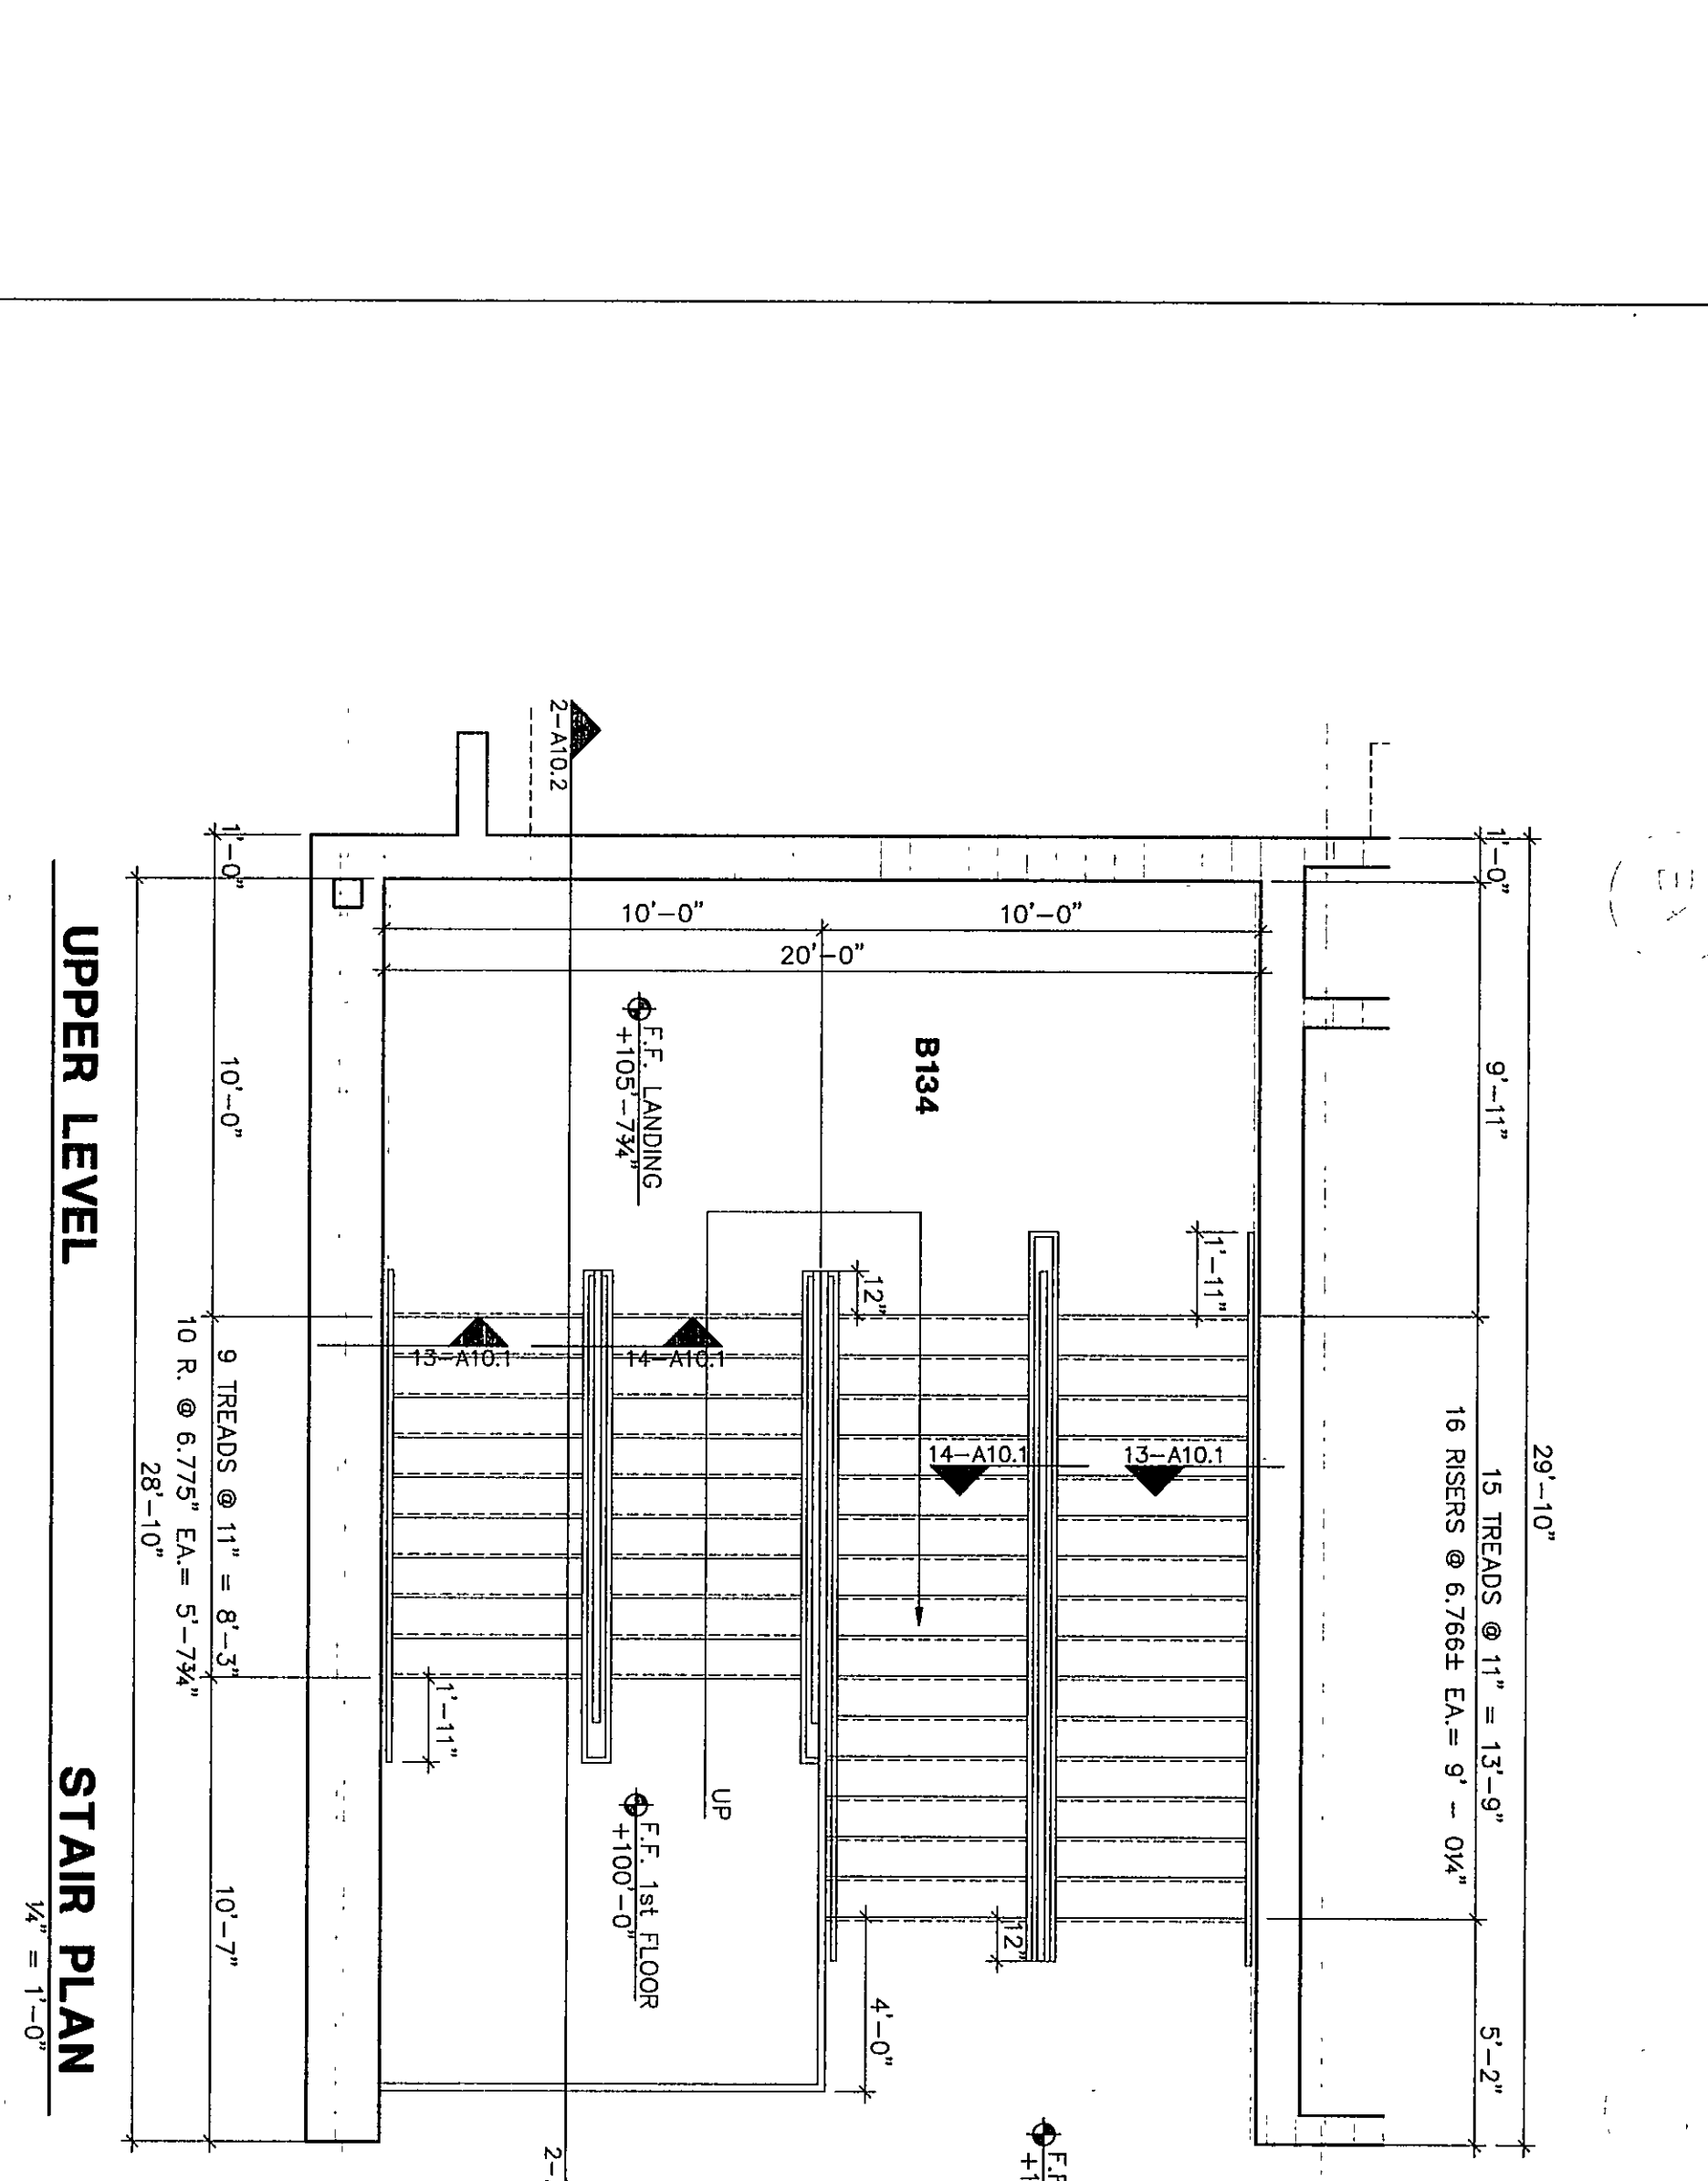


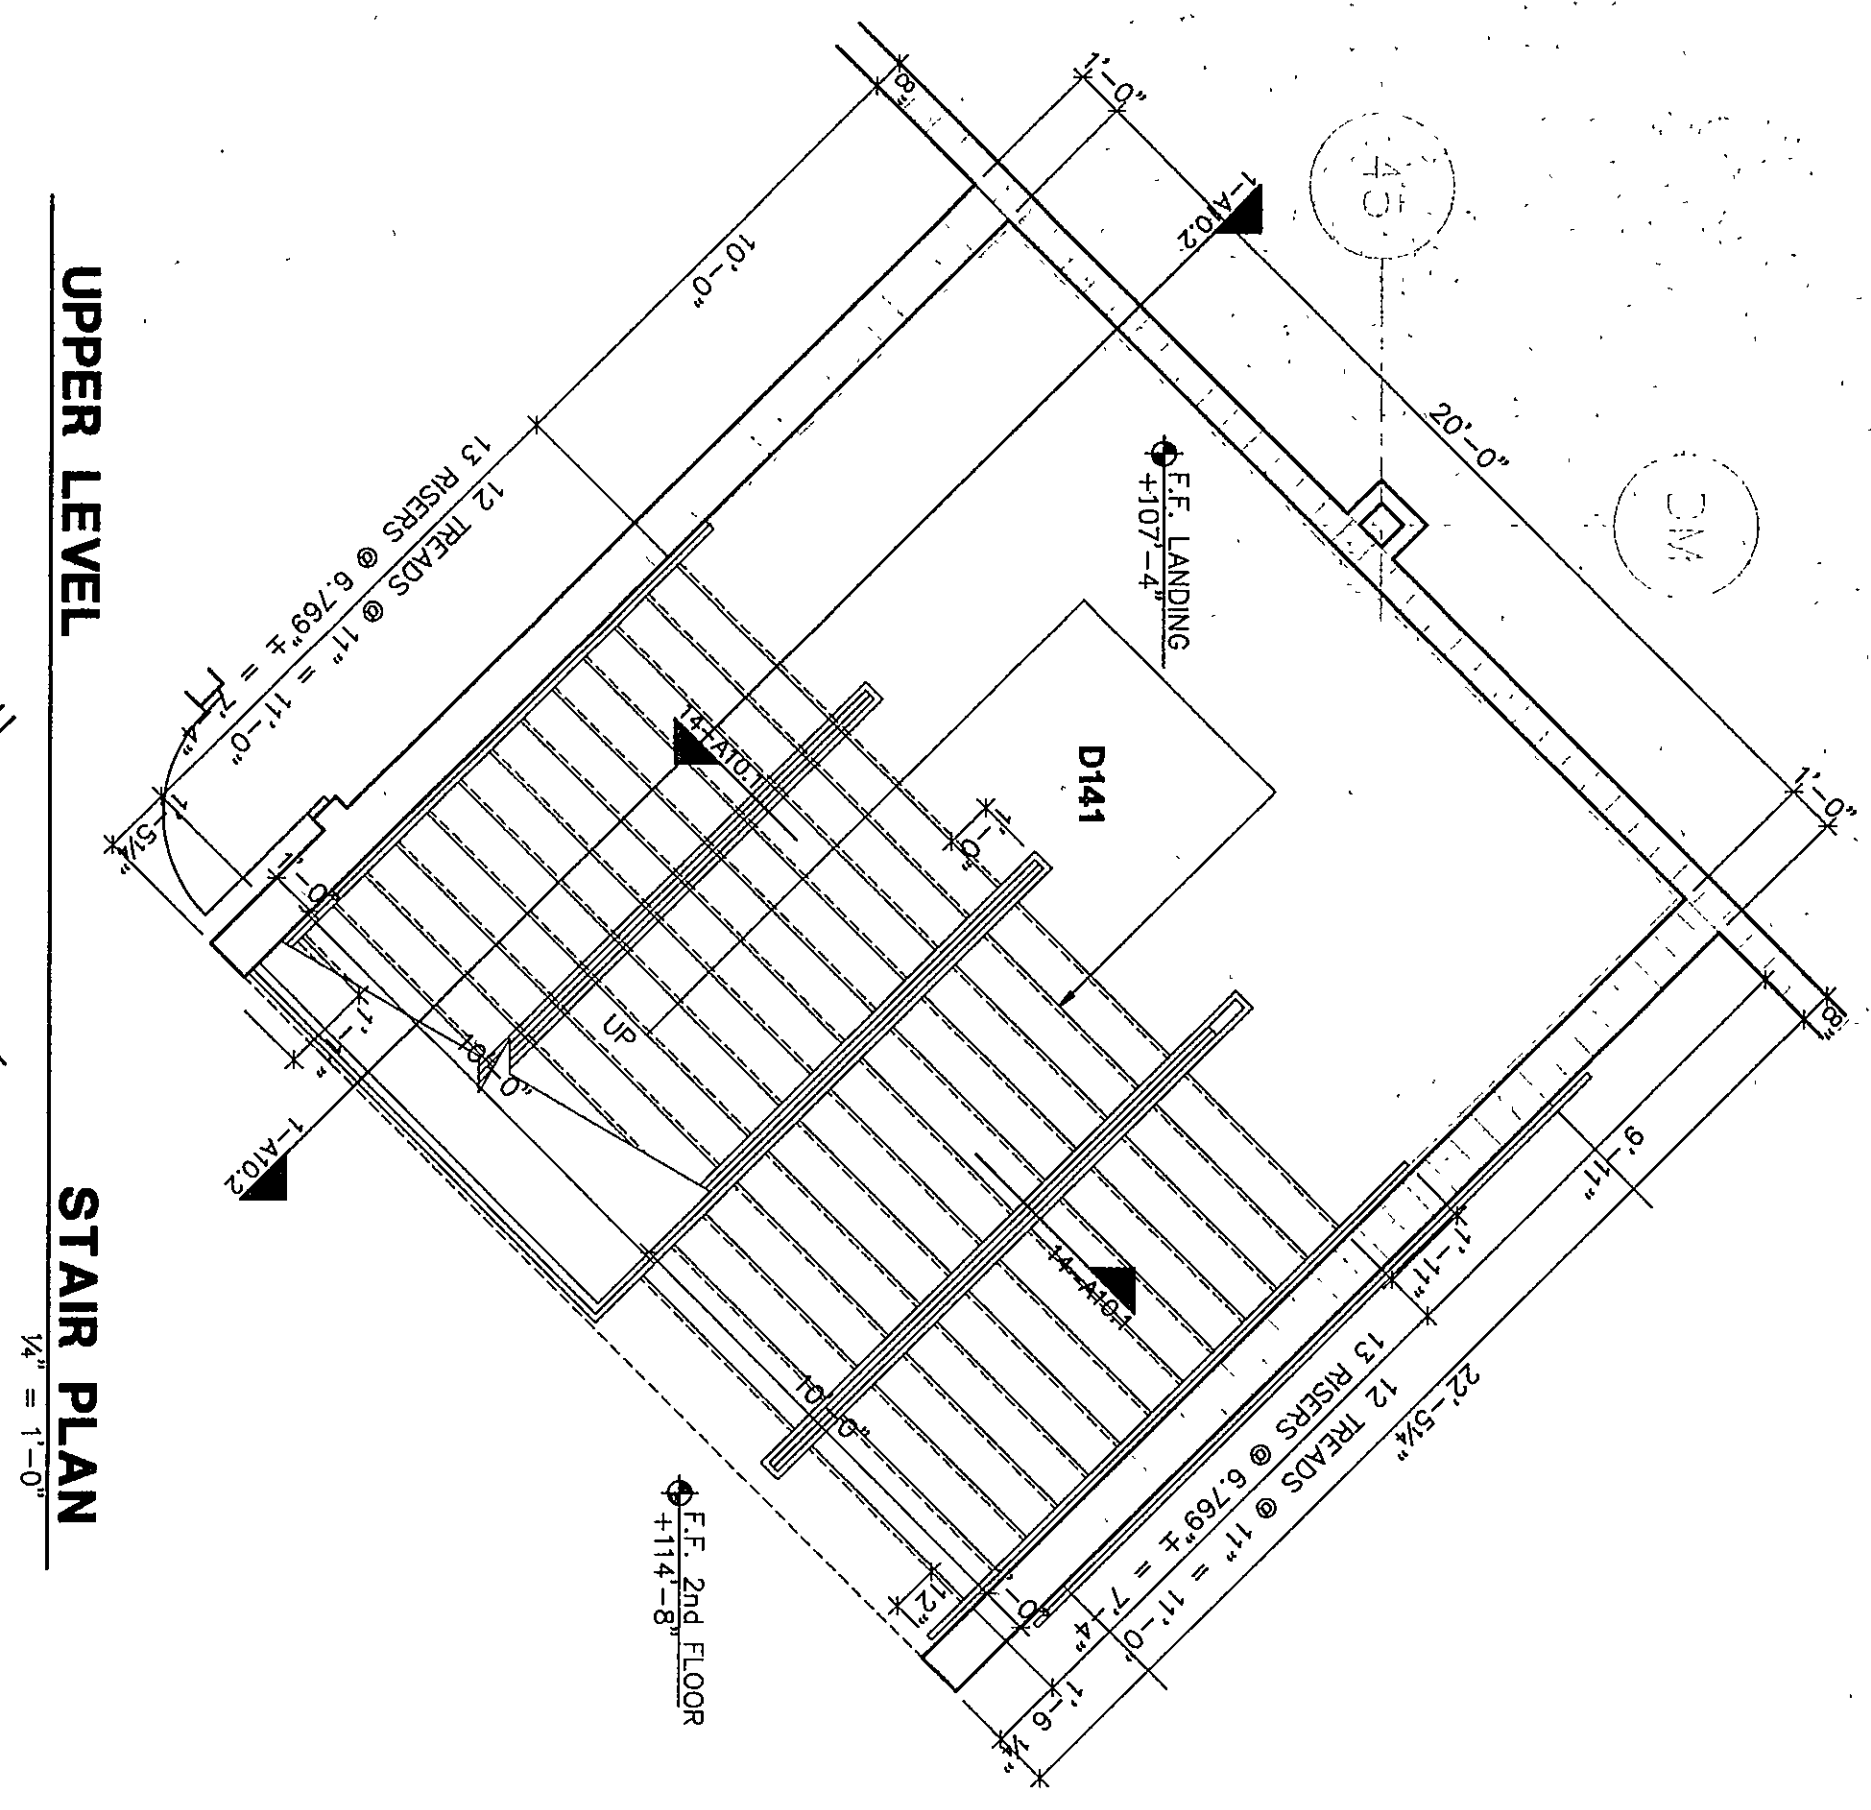


ENLARGED STAIR PLAN


DRAWN BY: TCB, HAS COMM. NO.: 95067.00
 CHECKED BY: JHJ DATE: APRIL 21, 1997

A10.2

REVISIONS NO. DATE

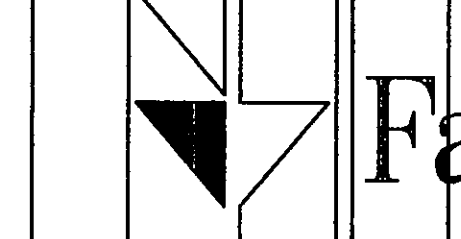

Fanning/Howey
 Associates, Inc.
 Architects Engineers Consultants

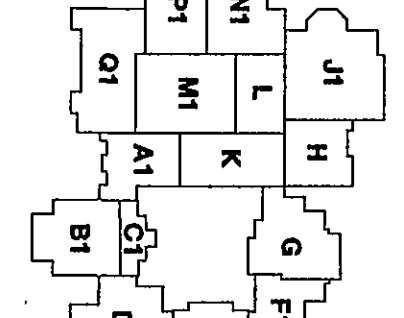

THE NEW
CHESTERTON HIGH SCHOOL
 FOR THE
 DUNELAND SCHOOL CORPORATION
 CHESTERTON, INDIANA

COPYRIGHT 1997 BY FANNING/HOWEY ASSOCIATES, INC.

